#### **ADDENDUM NUMBER 1**

**DATE: April 25, 2018** 

### **TO: Prospective Bidders**

This Addendum forms a part of the previously issued documents and modifies the Bidding Documents dated **April 9, 2018**, with amendments and additions noted below. Where addendum items below modify a portion of the Bidding Documents, the remainder of the Bidding Document remains unchanged.

ACKNOWLEDGE RECEIPT OF THIS ADDENDUM IN THE SPACE PROVIDED IN THE BID FORM. FAILURE TO DO SO MAY DISQUALIFY THE BIDDER.

This addendum consists of **20** page(s), in addition to the following document(s):

#### A. SPECIFICATIONS

08 71 00 DOOR HARDWARE

08 71 01 DOOR SCHEDULE

09 51 13 ACOUSTICAL PANEL CEILINGS

09 68 00 CARPETING

10 28 14 HAND DRYERS

11 13 19 STATIONARY LOADING DOCK EQUIPMENT

### **B. SKETCHES**

SKH-01 – PARTIAL BASEMENT ABATEMENT PLAN – ADDENDUM #1

SKH-02 – PARTIAL FIRST FLOOR ABATEMENT PLAN – ADDENDUM #1

SKA-01 – ADA SINKS

SKA-02 - PARTIAL 1ST AND 2ND FLOOR LIFE SAFETY PLANS

SKA-03 - AREAWAY ELEVATION AND DETAILS

SKA-04 –2<sup>ND</sup> FLOOR ROOM 209 WALL RATING CHANGE

SKA-05 -PARTIAL FIRST FLOOR FINISH PLAN

SKA-06 -PARTIAL SECOND FLOOR FINISH PLAN

SKM-01 - PARTIAL BASEMENT DUCTWORK PLAN - HVAC

## C. DRAWINGS (24x36 format)

C-101 SITE & PLANTING PLAN

S-102.1 – FIRST FLOOR FRAMING PLAN

S-103.1 - SECOND FLOOR FRAMING PLAN

S-104.1 - ROOF FRAMING PLAN

S-303 - FRAMING SECTIONS

S-304 - FRAMING SECTIONS

S-401 - SCHEDULES

S-500 - TYPICAL DETAILS

S-502 - TYPICAL DETAILS

D-611 - TYPICAL DEMOLITION DETAILS AND ELEVATIONS

A-401 – BASEMENT- REFLECTED CEILING PLAN

A-402 - FIRST FLOOR REFLECTED CEILING PLAN

A-403 - SECOND FLOOR REFLECTED CEILING PLAN

A-501 - WALL SECTIONS

A-502 - WALL SECTIONS

A-601 - TYPICAL KINDERGARTEN ROOM & J. PERKINS MEM. RM.

PLANS & ELEVATIONS

A-602 - MAKERSPACE CLASSROOM PLANS AND ELEVATIONS

A-603 - OT/PT & NURSES SUITE PLANS AND SECTIONS

A-620 - CORRIDOR ELEVATIONS

A-621 - CORRIDOR ELEVATIONS

A-622 - CORRIDOR ELEVATION

QF-102 BASEMENT ENLARGED PLAN & LIST

QF-105 MEP SCHEDULE

QF-203 BASEMENT- MECH. & PLBG. CONN. POINTS

QF-204 BASEMENT ELEC. CONN. POINTS

P-000 - PLUMBING NOTES AND SYMBOLS

PD-100.1 - PLUMBING PARTIAL DEMOLITION UNDERSLAB PLAN

PD-100.2 - PLUMBING PARTIAL DEMOLITION UNDERSLAB PLAN

PD-101.1 - PLUMBING PARTIAL DEMOLITION BASEMENT PLAN

PD-101.2 - PLUMBING PARTIAL DEMOLITION BASEMENT PLAN

PD-102.1 - PLUMBING PARTIAL DEMOLITION FIRST FLOOR PLAN

PD-103.1 - PLUMBING PARTIAL DEMOLITION SECOND FLOOR PLAN

PD-103.2 - PLUMBING PARTIAL DEMOLITION SECOND FLOOR PLAN

P-100.1 - UNDERSLAB PLUMBING PARTIAL FLOOR PLAN

P-100.2 - UNDERSLAB PLUMBING PARTIAL FLOOR PLAN

P-101.1 - BASEMENT PLUMBING PARTIAL FLOOR PLAN

P-102.2 - FIRST FLOOR PLUMBING PARTIAL FLOOR PLAN

P-103.1 - SECOND FLOOR PLUMBING PARTIAL FLOOR PLAN

P-103.2 - SECOND FLOOR PLUMBING PARTIAL FLOOR PLAN

P-104 - ROOF PLUMBING PARTIAL PLAN

P-301 - ENLARGED BATHROOM PLAN - WEST

P-302 - ENLARGED BATHROOM PLAN - EAST

P-401 - DETAILS

FP-100.1 - BASEMENT FIRE PROTECTION PARTIAL PLAN

FP-400 - SCHEDULES AND DETAILS

ED-102.2- FIRST FLOOR DEMOLITION PLAN- LIGHTING

E-001 - SITE PLAN - ELECTRICAL

E-002 - BUILDING MOUNTED LIGHTING

E-101.1 - BASEMENT PLAN A/B - LIGHTING

E-101.2- BASEMENT PLAN C- LIGHTING

E-102.1 - FIRST FLOOR PLAN A/B - LIGHTING

E-102.2- FIRST FLOOR PLAN C- LIGHTING

E-103.1 - SECOND FLOOR PLAN A/B - LIGHTING

E-103.2- SECOND FLOOR PLAN C- LIGHTING

E-202.1- FIRST FLOOR POWER PLAN A/B- POWER AND SS

E-203.1- SECOND FLOOR PLAN A/B- POWER AND SS

E-302 - FIRST FLOOR PLAN - SECURITY

E-303 - SECOND FLOOR PLAN - SECURITY

T201.1- BASEMENT FLOOR PLAN A/B-DWT

T201.2- BASEMENT FLOOR PLAN C-DWT

T202.1- FIRST FLOOR PLAN A/B-DWT

T202.2- FIRST FLOOR PLAN C -DWT

T203.1- SECOND FLOOR PLAN A/B-DWT T203.2- SECOND FLOOR PLAN C-DWT

#### **CHANGES TO THE PROJECT MANUAL**

### SECTION 03 30 00 CAST-IN-PLACE CONCRETE

- a. Paragraph 2.5 Concrete Materials; add subparagraph D. Lightweight Aggregate: ASTM C 330, 3/4-inch maximum aggregate size.
- b. Paragraph 2.11 Concrete Mixtures for Building Elements; replace with the following:
  - a. Interior Elevated Slabs: Light-weight concrete (107-113 concrete unit weight pcf).
    - 1) Specified compressive strength f'(c) (ASTM C 39): 3,000 psi at 28 days.
    - 2) Maximum water cement ratio by weight: 0.45.
    - 3) Maximum slump: 4 inches.
    - 4) Coarse aggregate gradation: Size 67, ASTM C 33.
  - b. All Other Interior Concrete: Normal-weight concrete.
    - 1) Specified compressive strength f'(c) (ASTM C 39): 4,500 psi at 28 days.
    - 2) Maximum water cement ratio by weight: 0.45.
    - 3) Maximum slump: 4 inches.
    - 4) Coarse aggregate gradation: Size 57, ASTM C 33.
  - c. Exterior Concrete: Normal-weight concrete.
    - 1) Specified compressive strength f'(c) (ASTM C 39): 5,000 psi at 28 days.
    - 2) Maximum water cement ratio by weight: 0.45.
    - 3) Maximum slump: 4 inches.
    - 4) Coarse aggregate gradation: Size 57, ASTM C 33.

### SECTION 03 45 00 PRECAST ARCHITECTURAL CONCRETE

- a. Delete Section in its entirety; comply with 04 72 00 CAST STONE MASONRY SECTION 06 40 23 INTERIOR ARCHITECTURAL WOODWORK
  - a. Delete section in it's entirety.

## SECTION 07 42 13.13 FORMED METAL WALL PANELS

- a. Replace paragraph 2.2, subparagraph B. with the following:
  - "B. Deep Profile, Concealed-Fastener Metal Wall Panels: Formed with asymmetrical ribs with interlocking joints.
    - 1. Basis of Design product: 'HWP' Panel by "Peterson Aluminum Corp. Pac Clad", or approved equal.
    - 2. Aluminum Sheet: Coil-coated sheet, ASTM B 209 alloy as standard with manufacturer, with temper as required to suit forming operations and structural performance required.
      - a. Thickness: 0.040 inch
      - b. Surface: Ribbed
      - c. Exterior Finish: Two-coat fluoropolymer.
      - d. Orientation: Horizontal or Vertical.
      - e. Color: To be selected by architect from full range of manufacturer's available colors.
    - 3. Panel width: 12" inches 4. Panel height: 7/8 inch."

## SECTION 07 53 23 ETHYLENE-PROPYLENE-DIENE-MONOMER (EPDM) ROOFING

a. Add paragraph

#### **"1.9 WARRANTY**

- A. Provide manufacturer's 20 or 30 year Total System Warranty covering both labor and material with no dollar limitation. Provide a 40 year non-prorated membrane material warranty on the .090 field membrane. (Available with 30 YR warranty only) The maximum wind speed coverage shall be peak gusts of 90 mph measured at 10 meters above ground level. Certification is required with submittals indicating the manufacturer has reviewed and agreed to such wind coverage. All products including substrate boards, vapor retarders, insulation, fasteners, fastening plates and edgings must be manufactured and/or supplied by the roofing system manufacturer and covered by the warranty.
  - B. Pro-rated Warranties shall not be accepted.
- C. Evidence of the manufacturer's warranty reserve shall be included as part of the project submittals for the specifier's approval."
- b. Paragraph 2.2 ETHYLENE-PROPYLENE-DIENE-TERPOLYMER (EPDM) ROOFING, sub paragraph 3. Exposed face color add "black"
- c. Paragraph 2.3 AUXILIARY ROOFING MATERIALS add sub paragraph
  - "I. Insulation & Overlayment board adhesive: Insulation adhesive must be V.O.C. free) Insulation adhesive must have a nominal free-rise core density of 2.2 pound per cubic foot, and be a 2 part low rise foam adhesive with 100% adhesion. (Ribbon method adhesives are acceptable. Bead spacing shall be 4 inches on center in the field, perimeters and corners.)"
- d. Add paragraph

### "2.4 SUBSTRATE BOARD/ COVER BOARD

- A. Products: Subject to compliance with requirements, available products that may be incorporated into the Work include the following:
  - 1. Substrate Board: 5/8" inch thick (For metal deck areas only)
  - 2. Coverboard: 1/2 inch Thick
  - a. Georgia-Pacific Building Products; Dens Deck Prime.
  - b. USG Corporation; Securock Gypsum-Fiber Roof Board."
- e. paragraph 2.5 shall read:
- "INSULATION Roof Insulation: Minimum 2" thick flat and tapered (1/4" per foot) (See email note for rehab area) polyisocyanurate board roof insulation conforming to ASTM C1289 faced with proper facing to allow membrane to be

adhered to it without delamination. Roof insulation must have an LTTR R-Value of 5.7/inch at 75 deg. F. when tested in accordance with ASTM C1289.

1. Manufacturer of roofing system must approve use of insulation in writing in advance."

### f. Add paragraphs

#### **"2.6 VAPOR BARRIER**

A. Vapor retarder is a minimum 40 mil composite sheet consisting of a self-adhering rubberized asphalt membrane. The underlayment board shall be primed with primer in accordance with manufacturer's specifications. Vapor retarder must have a perm rating of 0.05 or less as per ASTM E90. Vapor retarder must be rated by the manufacturer as a temporary roof with an allowable exposure to the elements for 90 days.

## 2.7 WALKWAY PADS

A. Protective surfacing for roof traffic shall be 30" x 30" molded black rubber with factory rounded corners adhered to the EPDM membrane roof with Splice Tape."

## g. Add paragraphs

### " 3.4 UNDERLAYMENT BOARD ATTACHMENT

A. Mechanically attach the 5/8" substrate board in accordance with FM1-60 standards, but no less than one fastener per 2 square feet in the field and perimeter of the roof system and 1 per 1 square foot in the corners.

### 3.5 VAPOR BARRIER APPLICATION

A. Prime only areas to be waterproofed the same day. Reprime if area becomes dirty. Apply Air and Vapor Barrier from low to high point, in a shingle fashion, so that laps will shed water. Overlap all edges at lease 2-1/2 inches. End laps shall be staggered. Place membrane carefully so as to avoid wrinkles and fishmouths. Immediately after installation, roll with a 100-150 pound weighted steel roller. There shall be no gaps in the vapor barrier application.

## 3.6 INSTALLATION OF INSULATION AND COVER BOARD

A. Secure all insulation, staggering all joints, to the Vapor Retarder with the adhesive in accordance with the manufacturer's specifications and application procedures. Insulation adhesive must have a nominal free-rise core density of 2.2 pound per cubic foot and be a 2 part low rise foam adhesive with 100% adhesion. Apply the overlayment board with the same adhesive application requirements. (Ribbon method adhesives are acceptable. Bead spacing shall be 4 inches on center in the field, perimeters and corners.) Strict care must be taken to make sure that all insulation and cover boards lay flat and are in an even plane with adjacent

boards. Walk the boards into the adhesive and roll using a 30" wide, 150 pound weighted steel roller to ensure full embedment."

### h. add paragraph

### "3.8 WALKWAY PAD INSTALLATION

A. Install walkways at all traffic concentration points (such as roof hatches, access doors, rooftop ladders, etc.) and all locations as identified on the specifier's drawing.

B. Adhere walkways pads to the EPDM membrane in accordance with the manufacturer's specifications."

## SECTION 08 11 16 SIMULATED WOOD GRAIN HOLLOW METAL DOORS

a. Delete entire Section

### SECTION 08 71 00 HARDWARE

a. Replace entire section

### SECTION 08 71 01 DOOR SCHEDULE

a. Replace in it's entirety

## SECTION 08 33 21 OVERHEAD COILING DOORS

- a. Paragraph 2.1 replace subparagraph A with
  - "A. Provide "CESD20" by 'Clopay' or approved equal."

### SECTION 08 36 13 SECTIONAL DOORS

- a. Replace Paragraph 2.3 Door Assembly with the following:
  - "2.3 Door Assembly Product Manufacturer: Basis-of-design.
    - 1. Premium Duty Steel Sectional Overhead Door model 520 by 'Clopay' or approved equal.
    - A. Steel sectional Door: Sectional door formed with hinged sections and fabricated according to DASMA 102.
    - B. Operation cycles: Door components capable of 50,000 cycles. One operation cycle is complete when a door is opened from the closed position to the fully opened position and returned to the closed position.
    - C.. Steel Sections: 2 inches (52 mm) thick roll formed commercial quality steel panel sections 1. Steel thickness: Minimum 0.034 inch.
    - D. Track configurations: As indicated on drawings.
    - E. Roller Wheel Material: Case-hardened Steel.
    - F. Locking Devices: Provide locking device assembly.

George M Forbes 6 ADDENDUM NUMBER 1

- 1. Locking Device Assembly: Cremone type, both jamb sides, locking bars, operable from inside with thumb turn and outside with keyed cylinder.
- H. Counterbalance type: torsion Spring
- I. Weather Seals: Fitted to bottom of door
- J. Finish: Exterior 1 mil (.025 mm) coating; color as selected by architect from manufacturer's full line of color choices.
  - A. Delete Paragraph 2.4
  - B. Delete Paragraph 2.10

## SECTION 09 05 61.13 MOISTURE VAPOR EMISSION CONTROL

- a. Delete section in its entirety. Comply with section 09 61 00 Water Vapor Reduction
- b. System

### SECTION 09 51 13 ACOUSTIC PANEL CEILINGS

a. section replaced in its entirety

### SECTION 09 66 23 TERRAZZO FLOORING

a. Paragraph 2.4 PRECAST TERRAZZO replace first sentence of sub-paragraph A with "A. Precast terrazzo Base Units: Minimum 3/8-inch-thick reinforced epoxy terrazzo units, cast in maximum length possible, but not less than 36 inches."

### SECTION 09 68 00 CARPETING

a. Section added

### SECTION 09 68 13 TILE CARPETING

a. Delete section in its entirety

#### SECTION 09 93 00 STAINING AND TRANSPARENT FINISHING

a. Delete Paragraph 2.3 sub paragraph A in its entirety.

### SECTION 10 28 00 TOILET LAUNDRY AND BATH ACCESSORIES

- a. Paragraph 2.3 PUBLIC WASHROOM ACCESSORIES, Add
  - "H. Baby Changing Station.
    - 1. Basis of Design Product. a. Koala Kare Products Model#KB110-SSRE b. Description: Horizontal recessed mounted stainless-steel baby changing station.
  - I. Sanitary Napkin Dispenser.
    - 1. Basis of Design Product: a. Bobrick B3706 b. Description: Wall mounted, Stainless steel product dispenser with ADA compliant push button operation. Mechanical operation no electric or batteries required.

- J. Coat Hook.
  - 1. Basis of Design Product:
    - a. Bobrick B-6717
    - b. Description: Single Robe Hook Satin Finish Stainless Steel with concealed wall plate."

### SECTION 10 28 14 HAND DRYERS

a. add section in entirety

### SECTION 11 13 19 STATIONARY LOADING DOCK EQUIPMENT

a. Replace section in entirety

### SECTION 11 30 13 RESIDENTIAL APPLIANCES

- a. Paragraph 2.3 Appliances, replace sub-paragraph C. with "C. GE GDF520P."
- b. Paragraph 2.3 Appliances, replace sub-paragraph E with "E. GE JS760."
- c.Paragraph 2.4 General Finish Requirements, Add sub-paragraph "C. Finish and color of appliances to be selected by architect from options of model specified, unless otherwise noted."

### SECTION 11 40 00 FOOD SERVICE EQUIPMENT

- a. Add sub paragraph 1.2 Quality Assurance with "1.2 QUALITY ASSURANCE,
  - I. Regulatory Requirements:
    - "6. "U.S Safe Drinking Water Act": Amended legislation (2011) .25% allowable lead content
    - 7. Senate Bill 3874: The national bill that passes as "The Reduction of Lead in Drinking Water Act"
      - b. AJ. & AK: Item No. 1.004 Hand Sink & Item No. 1.005 Mop Sink
         Note All faucets to meet "The Reduction on Lead in Drinking Water Act.": and the amended "Safe Drinking Water Act" (2011).025% allowable lead content.
      - c. AY. Item No. 1.034 Stainless Steel Table

        CLARIFICATION: Change the size of the table to: 7'-0" x 30" x

        34" working height
      - d. AZ. Item No. 1.035 Stainless steel Table

        CLARIFICATION: Change the size of the table to: 8'-4" x 30" x

        34" working height
      - e. BB. Item No. 1.037 Stainless Steel Work Table with Sink

CLARIFICATION: Change the size of the table to: 8'-0" x 36" x 34" working height

f. BH. Item No. 1.045 Stacked Washer / Dryer

DELETE written specifications replace with the following:

Quantity - One (1)

Manufacturer - Speed Queen

Model No. - ATEE9AGP173TWo

Size - 26-7/8" x 27-3/4" x 78-3/16" high

Construction- Stacked Washer / Dryer

- 3.42 Cu. Ft Washer and 7.0 Cu. Ft. Dryer

- White on White

Accessories - Installation per manufacturer

## requirements

- Flexible water disconnects per specific conditions
- Dryer Cord

Services - (by respective trades)

- 120v/1ph, 15.0 amps Washer
- 240v/1ph, 30.0 amps Dryer
- 3/4" CW, 3/4" HW
- 1-1/2" Indirect Waste

## SECTION 12 35 53 PREMANUFACTURED CASEWORK

a. Delete Section in its entirety

### SECTION 12 36 00 COUNTERTOPS

a. Delete Section in its entirety

### SECTION 21 13 13 WET-PIPE SPRINKLER SYSTEMS

a. Paragraph 2.7 Sprinklers, add "(for Dry-Type Heads, use Tyco DS-1 or equivalent)"

### SECTION 22 42 13 COMMERCIAL URINALS

- a. Replace Paragraph 2.2 Urinal Flushometer Valves
- B. Hard-Wired, Manual Override, Solenoid-Actuator, Piston Flushometer Valves:
  - Manufacturers: Subject to compliance with requirements, provide products by one of the following:
    - a. Gerber Plumbing Fixtures LLC.
    - b. <u>Moen Incorporated</u>.
    - c. Sloan Valve Company.
  - 2. Standard: ASSE 1037.
  - 3. Minimum Pressure Rating: 125 psig (860 kPa).
  - 4. Features: Include integral check stop and backflow-prevention device.
  - 5. Material: Brass body with corrosion-resistant components.
  - 6. Exposed Flushometer-Valve Finish: Chrome plated.
  - 7. Panel Finish: Chrome plated or stainless steel.
  - 8. Style: Exposed.

DWT SED # 26-16-00-01-7-999-020

- Actuator: Solenoid complying with UL 1951; listed and labeled as defined in NFPA 70, by a qualified testing agency; and marked for intended location and application.
- 10. Trip Mechanism: Hard-wired electronic sensor complying with UL 1951; listed and labeled as defined in NFPA 70, by a qualified testing agency; and marked for intended location and application.
- 11. Consumption: 0.5 gal. per flush.
- 12. Minimum Inlet: NPS 3/4.
- 13. Minimum Outlet: NPS 1-1/4.

### SECTION 22 42 14 COMMERCIAL WATER CLOSETS

- a. Replace Paragraph 2.3 Flushometer Valves
- C. Hard-Wired, Manual Override, Solenoid-Actuator, Piston Flushometer Valves:
  - 1. Manufacturers: Subject to compliance with requirements, provide products by one of the following:
    - a. Gerber Plumbing Fixtures LLC.
    - b. Moen Incorporated.
    - c. Sloan Valve Company.
  - 2. Standard: ASSE 1037.
  - Minimum Pressure Rating: 125 psig.
  - 4. Features: Include integral check stop and backflow-prevention device.
  - 5. Material: Brass body with corrosion-resistant components.
  - 6. Exposed Flushometer-Valve Finish: Chrome plated.
  - 7. Panel Finish: Chrome plated or stainless steel.
  - 8. Style: Exposed.
  - 9. Actuator: Solenoid complying with UL 1951, and listed and labeled as defined in NFPA 70, by a qualified testing agency, and marked for intended location and application.
  - Trip Mechanism: Hard-wired electronic sensor complying with UL 1951, and listed and labeled as defined in NFPA 70, by a qualified testing agency, and marked for intended location and application.
  - 11. Consumption: 1.28 gal. per flush.
  - 12. Minimum Inlet: NPS 1.
  - 13. Minimum Outlet: NPS 1-1/4.

## **CHANGES TO THE DRAWINGS**

#### H-101.2 BASEMENT ABATEMENT PLAN

 a. Within Cafeteria Room 35: One (1) location of Keyed Mold Removal Note (circle) #2 was deleted and replaced with one (1) same location of Keyed Mold Removal Note (circle) #3. Reference Issued for Bid H-101.1, and refer to Addendum #1 sketch SKH-01

### H-102.2 FIRST FLOOR ABATEMENT PLAN

- a. Labeled the location of Storage 101-G per sketch SKH-03.
- Added one (1) additional location of Keyed Asbestos Removal Note (Rectangle) #12 per sketch SKH-02

### S-102.1 – FIRST FLOOR FRAMING PLAN

Rochester Schools Modernization Program – Phase 2c (School #04) George M. Forbes- Renovation, Alterations and Addition SED # 26-16-00-01-0-004-024 DWT SED # 26-16-00-01-7-999-020

CJS Architects Project #1711.00 4/25/2018

a. Revised per drawing

## S-103.1 - SECOND FLOOR FRAMING PLAN

a. Revised per drawing

### S-104.1 - ROOF FRAMING PLAN

a. Revised per drawing

### S-303 - FRAMING SECTIONS

a. Revised per drawing

#### S-304 - FRAMING SECTIONS

a. Revised per drawing

#### S-401 - SCHEDULES

a. Revised per drawing

### S-500 - TYPICAL DETAILS

a. Revised per drawing

#### S-502 - TYPICAL DETAILS

a. Revised per drawing

### C-101- SITE AND PLANTING PLAN

a. Revised per drawing

## LS-102 - FIRST LEVEL LIFE SAFETY PLAN

a. Revised per attached sketch

#### LS-103 - SECOND LEVEL LIFE SAFETY PLAN

a. Revised per attached sketch

## D-101.1 - BASEMENT DEMOLITION PLAN

a. Add keynote: 'W13' "REMOVE EXISTING COVE BASE AT EXISTING WALLS TO REMAIN. REFER TO D611 FOR MORE INFORMATION." To the following rooms: CAFETERIA RM RM 35

### D-101.2 - BASEMENT DEMOLITION PLAN

- a. Add keynote: 'W13' "REMOVE EXISTING COVE BASE AT EXISTING WALLS TO REMAIN. REFER TO D611 FOR MORE INFORMATION." To the following rooms:
  - 1. Computer Room RM 1
  - 2. 7th Grade Classroom RM 2

### D-102.1 - FIRST FLOOR DEMOLITION PLAN

- a. Add keynote: 'W13' "REMOVE EXISTING COVE BASE AT EXISTING WALLS TO REMAIN. REFER TO D611 FOR MORE INFORMATION." To the following rooms:
  - 1. Storage RM 118-B

- 2. Office RM 118-A
- 3. Conference/Work Room RM 129
- 4. Toilet RM 125
- 5. Nurse RM 117
- 6. Psych RM 117-B
- 7. Toilet RM 117-C
- 8. Storage RM 117-D
- 9. Nurse RM 117-4

#### D-103.2 - SECOND FLOOR DEMOLITION PLAN

- a. Add keynote: 'W13' "REMOVE EXISTING COVE BASE AT EXISTING WALLS TO REMAIN. REFER TO D611 FOR MORE INFORMATION." To the following rooms:
  - 1. Copier Room
  - 2. Office

### D-611 - TYPICAL DEMOLITION DETAILS AND ELEVATIONS

a. Revised per drawing

## A-101.1- BASEMENT PLAN

- a. Partition type "U3" added at all column enclosures in room CAFETERIA RM 8, typical of all 9 column enclosure locations.
- b. All CMU walls of STORAGE ROOM 15A are partition type "M3\*".
- c. All CMU walls of ELEV. EQUIP. ROOM 15 are partition type "M3\*"

### A-101.2- BASEMENT PLAN

- a. Door label "6" added to door in BOYS TOILET RM 6.
- b. Partition type "U3" added at all column enclosures in room CAFETERIA RM 8, typical of all 9 column enclosure locations.

### A-102.1- FIRST FLOOR PLAN

- a. Partition tag "U4" deleted and replaced with tag "A3" at demising wall between RM 111 and RM112.
- b. Partition type "U3" added at all column enclosures in room CAFETERIA RM 8, typical of all 9 column enclosure locations.

## A-103.1 - SECOND FLOOR PLAN

a. Delete cross corridor door 'COR-H.3' per attached sketch

#### A-103.2- SECOND FLOOR PLAN

a. Revised per sketch

## A-200- BUILDING ELEVATIONS

- a. Add 3 building lights to north elevation (1/A-200), refer to electrical drawing (7 building lights total)
- b. Add 4 building lights to west elevation (2/A-200), refer to electrical drawings (5 building lights total)

George M Forbes 12 ADDENDUM NUMBER 1

Rochester Schools Modernization Program – Phase 2c (School #04) George M. Forbes- Renovation, Alterations and Addition SED # 26-16-00-01-0-004-024 DWT SED # 26-16-00-01-7-999-020 CJS Architects Project #1711.00 4/25/2018

c. Add 2 period style entrance lights to existing exterior façade near door, refer to electrical drawings.

## A-401- BASEMENT REFLECTED CEILING PLAN

a. Revised per drawing

## A-402- FIRST FLOOR- REFLECTED CEILING PLAN

a. Revised per drawing

#### A-403- SECOND FLOOR REFLECTED CEILING PLAN

a. Revised per drawing

#### A-710- MILLWORK DETAILS

a. Revised per sketch

#### I-102- FIRST FLOOR FINISH PLAN

a. Revised per sketch

#### I-103- SECOND FLOOR FINISH PLAN

a. Revised per sketch

#### QF-102 BASEMENT ENLARGED PLAN & LIST

a. Revised per drawing

#### **QF-105 MEP SCHEDULE**

a. Revised per drawing

## QF-203 BASEMENT- MECH. & PLBG. CONN. POINTS

a. Revised per drawing

### QF-204 BASEMENT ELEC. CONN. POINTS

a. Revised per drawing

### P-000 - PLUMBING NOTES AND SYMBOLS

a. Revised per drawing

#### PD-100.1 - PLUMBING PARTIAL DEMOLITION UNDERSLAB PLAN

a. Revised per drawing

## PD-100.2 - PLUMBING PARTIAL DEMOLITION UNDERSLAB PLAN

a. Revised per drawing

#### PD-101.1 - PLUMBING PARTIAL DEMOLITION BASEMENT PLAN

a. Revised per drawing

## PD-101.2 - PLUMBING PARTIAL DEMOLITION BASEMENT PLAN

a. Revised per drawing

- PD-102.1 PLUMBING PARTIAL DEMOLITION FIRST FLOOR PLAN a. Revised per drawing
- PD-103.1 PLUMBING PARTIAL DEMOLITION SECOND FLOOR PLAN
  a. Revised per drawing
- PD-103.2 PLUMBING PARTIAL DEMOLITION SECOND FLOOR PLAN a. Revised per drawing
- P-100.1 UNDERSLAB PLUMBING PARTIAL FLOOR PLAN a. Revised per drawing
- P-100.2 UNDERSLAB PLUMBING PARTIAL FLOOR PLAN a. Revised per drawing
- P-101.1 BASEMENT PLUMBING PARTIAL FLOOR PLAN
  a. Revised per drawing
- P-102.2 FIRST FLOOR PLUMBING PARTIAL FLOOR PLAN
  a. Revised per drawing
- P-103.1 SECOND FLOOR PLUMBING PARTIAL FLOOR PLAN a. Revised per drawing
- P-103.2 SECOND FLOOR PLUMBING PARTIAL FLOOR PLAN a. Revised per drawing
- P-104 ROOF PLUMBING PARTIAL PLAN

  a. Revised per drawing
- P-301 ENLARGED BATHROOM PLAN WEST a. Revised per drawing
- P-302 ENLARGED BATHROOM PLAN EAST a. Revised per drawing
- P-401 DETAILS

  a. Revised per drawing
- FP-100.1 BASEMENT FIRE PROTECTION PARTIAL PLAN
  a. Revised per drawing
- FP-400 SCHEDULES AND DETAILS

a. Revised per drawing

#### MD-102.1 - PARTIAL FIRST FLOOR DEMOLITION PLAN - HVAC

a. Revise text note reading (E) Exhaust Duct Up/Dn in Librarian 127 to read: (E) EXHAUST UP.

#### MD-102.2 - PARTIAL FIRST FLOOR DEMOLITION PLAN - HVAC

- a. Add demolition note callout "4" associated with text note (E)24x10 pointing to return grille within 5th-7th Grade SP. ED. 8:1:2.
- b. Revise text note reading (E)Exhaust Up associated with exhaust duct riser in Boys Toilet 105 to read: (E)EXHAUST UP/DN.

#### MD-103.1 - PARTIAL SECOND FLOOR DEMOLITION PLAN - HVAC

a. Revise demolition note callouts associated with convectors located in Mens Toilet XXX and Office XXX from "2" to read as "6". Typical of two callout notes total. Rooms are across from 7th-8th Grade SP. ED. 12:1:1 for reference.

### MD-103.2 - PARTIAL SECOND FLOOR DEMOLITION PLAN - HVAC

- a. Add demolition note callout "6" associated with text note (E)10x10 Up to Roof pointing to duct riser in FCS 217B.
- b. Add demolition note callout "4" associated with text note (E)8x8 Dn pointing to exhaust duct in FCS 217B.
- c. Add demolition note 14 to note block to read: EXISTING SUPPLY AIR DUCTWORK SERVING GYMATORIUM TO REMAIN FOR REUSE FROM POINT INDICATED. CLEAN SYSTEM COMPLETELY.

#### MD-104.1 - PARTIAL ROOF DEMOLITION PLAN - HVAC

- Add demolition note 10 to note block to read: REMOVE REFRIGERANT PIPING DOWN TO EQUIPMENT ROOM 33 AND ASSOCIATED COOLING UNIT COMPLETELY.
- Add demolition note callout "10" associated with text note (E)Air Cooled Condensing Unit located on Boiler Room Low-Roof. Add note callout adjacent to demo note 3 callout.

### M-101.2 - PARTIAL BASEMENT DUCTWORK PLAN - HVAC

a. Revise per attached sketch SKM-01.

#### M-501 - DETAILS - HVAC

a. Detail 8 - Concrete Equipment Base Detail: Revise height of concrete pad from 6" to read as "REFER TO PLANS".

### M-502 - DETAILS - HVAC

a. Detail 5 - Floor Mounted Pump Piping Detail - End Suction: Delete 6" reference to height of concrete pad. Associated text note to read "CONCRETE PAD 6" LARGER ON ALL SIDES OF PUMP BASE. BOLT PUMP BASE TO PAD".

George M Forbes 15 ADDENDUM NUMBER 1

- b. Detail 6 Floor Mounted Pump Piping Detail End Suction with Inertia Pad:
   Delete 6" reference to height of concrete pad. Associated text note to read
   "CONCRETE PAD 6" LARGER ON ALL SIDES OF PUMP BASE. BOLT PUMP
   BASE TO INERTIA BASE".
- c. Detail 8 Floor Mounted Pump Piping Detail Vertical Inline with Inertia Pad: Delete 6" reference to height of concrete pad. Associated text note to read "CONCRETE PAD 6" LARGER ON ALL SIDES OF PUMP BASE".

#### M-504 - DETAILS - HVAC

a. Detail 4 - Flue Gas Venting System Detail: Revise height of flue vent cap dimension from 8'-0" to read as "REFER TO PLANS".

#### E-000 - GENERAL NOTES AND SYMBOLS LIST

a. Revise general note UU. To read as follows: "G.C. shall be responsible for all exterior building patching to match."

### ED-102.2- FIRST FLOOR DEMOLITION PLAN- LIGHTING

- a. To indicate additional removal of fixtures in 100 suite.
- b. Replace drawing in its entirety.

### ED-101.3- BASEMENT DEMOLITION PLAN A/B- POWER AND SS

a. Revise demolition note 1 to read as follows: "Disconnect and remove all electrical devices, systems and associated wiring in its entirety; unless noted otherwise. This shall include, but is not limited to branch circuiting, surface raceway (Wire-Mold), conduit and all associated wiring. NOTE: NOT ALL ELECTRICAL DEVICES, SYSTEMS, BRANCH CIRCUITING NOTED ABOVE IS INDICATED. Field verification is required by this contractor. Maintain all systems noted in general note B. and C. noted on drawing."

#### ED-101.4- BASEMENT DEMOLITION PLAN C- POWER AND SS

a. Revise demolition note 1 to read as follows: "Disconnect and remove all electrical devices, systems and associated wiring in its entirety; unless noted otherwise. This shall include, but is not limited to branch circuiting, surface raceway (Wire-Mold), conduit and all associated wiring. NOTE: NOT ALL ELECTRICAL DEVICES, SYSTEMS, BRANCH CIRCUITING NOTED ABOVE IS INDICATED. Field verification is required by this contractor. Maintain all systems noted in general note B. and C. noted on drawing."

#### ED-102.3- FIRST FLOOR DEMOLITION PLAN A/B- POWER AND SS

a. Revise demolition note 1 to read as follows: "Disconnect and remove all electrical devices, systems and associated wiring in its entirety; unless noted otherwise. This shall include, but is not limited to branch circuiting, surface raceway (Wire-Mold), conduit and all associated wiring. NOTE: NOT ALL ELECTRICAL DEVICES, SYSTEMS, BRANCH CIRCUITING NOTED ABOVE IS INDICATED. Field verification is required by this contractor. Maintain all systems noted in general note B. and C. noted on drawing."

#### ED-102.4- FIRST FLOOR DEMOLITION PLAN C- POWER AND SS

George M Forbes 16 ADDENDUM NUMBER 1

a. Revise demolition note 1 to read as follows: "Disconnect and remove all electrical devices, systems and associated wiring in its entirety; unless noted otherwise. This shall include, but is not limited to branch circuiting, surface raceway (Wire-Mold), conduit and all associated wiring. NOTE: NOT ALL ELECTRICAL DEVICES, SYSTEMS, BRANCH CIRCUITING NOTED ABOVE IS INDICATED. Field verification is required by this contractor. Maintain all systems noted in general note B. and C. noted on drawing."

#### ED-103.3- SECOND FLOOR DEMOLITION PLAN A/B- POWER AND SS

- a. Revise demolition note 1 to read as follows: "Disconnect and remove all electrical devices, systems and associated wiring in its entirety; unless noted otherwise. This shall include, but is not limited to branch circuiting, surface raceway (Wire-Mold), conduit and all associated wiring. NOTE: NOT ALL ELECTRICAL DEVICES, SYSTEMS, BRANCH CIRCUITING NOTED ABOVE IS INDICATED. Field verification is required by this contractor. Maintain all systems noted in general note B. and C. noted on drawing."
- b. Stair 4: Disconnect and remove door holder inside stairwell tower.
- c. Room 207: Disconnect and remove two (2) range receptacles and associated branch circuiting.

### ED-103.4- SECOND FLOOR DEMOLITION PLAN C- POWER AND SS

- a. Revise demolition note 1 to read as follows: "Disconnect and remove all electrical devices, systems and associated wiring in its entirety; unless noted otherwise. This shall include, but is not limited to branch circuiting, surface raceway (Wire-Mold), conduit and all associated wiring. NOTE: NOT ALL ELECTRICAL DEVICES, SYSTEMS, BRANCH CIRCUITING NOTED ABOVE IS INDICATED. Field verification is required by this contractor. Maintain all systems noted in general note B. and C. noted on drawing."
- b. Room 204: Disconnect and remove two (2) range receptacles and associated branch circuiting.

#### E-001 - SITE PLAN - ELECTRICAL

a. Revise the location of the transformer to miss underground gas and water lines. Replace drawing in its entirety.

#### E-002 - BUILDING MOUNTED LIGHTING

- a. Revise and add various building mounted lighting.
- b. Replace drawing in its entirety.

#### E-101.1 - BASEMENT PLAN A/B - LIGHTING

- a. Revise lighting to match RCP.
- b. Replace drawing in its entirety.

## E-101.2- BASEMENT PLAN C- LIGHTING

- a. Revise lighting to match RCP.
- b. Replace drawing in its entirety.

#### E-102.1 - FIRST FLOOR PLAN A/B - LIGHTING

a. Revise lighting to match RCP.

b. Replace drawing in its entirety.

#### E-102.2- FIRST FLOOR PLAN C- LIGHTING

- a. Revise lighting to match RCP.
- b. Replace drawing in its entirety.

## E-103.1 - SECOND FLOOR PLAN A/B - LIGHTING

- a. Revise lighting to match RCP.
- b. Replace drawing in its entirety.

### E-103.2- SECOND FLOOR PLAN C- LIGHTING

- a. Revise lighting to match RCP.
- b. Replace drawing in its entirety.

#### E-202.1- FIRST FLOOR PLAN A/B- POWER AND SS

a. Replace drawing in its entirety to show additional ceiling fans and revised locations.

#### E-203.1- SECOND FLOOR PLAN A/B- POWER AND SS

- a. Toilet room 208: Add door holder at door nearest corridor.
- b. Replace drawing in its entirety to show additional ceiling fans and revised locations.

### E-302 - FIRST FLOOR PLAN - SECURITY

- a. Revise ADA door work at various doors.
- b. Replace drawing in its entirety.

### E-303 - SECOND FLOOR PLAN - SECURITY

a. Revise ADA door work at various doors. Replace drawing in its entirety.

### E802- SCHEDULES - ELECTRICAL

a. Revise Elevator: ELEV-2, horsepower to be 40: Revise circuit breaker to be 110A, Revise power wiring from panel to control unit and power wiring from control unit to equipment sizes to be 3-#4, 1#6EG., 1"C.

#### E803- SCHEDULES - ELECTRICAL

a. At Panel HNMDP: Add one (1) active 110A/3P shunt trip circuit breaker.

#### T201.1- BASEMENT FLOOR PLAN A/B-DWT

- a. GENERAL: Added VOIP handsets in various offices and drawing note 5.
- b. GENERAL: Added additional WAP's in various offices.
- c. Replace drawing in its entirety.

## T201.2- BASEMENT FLOOR PLAN C-DWT

- a. GENERAL: Added VOIP handsets in various offices and drawing note 5.
- b. GENERAL: Added additional WAP's in various offices.
- c. Replace drawing in its entirety.

#### T202.1- FIRST FLOOR PLAN A/B-DWT

George M Forbes 18 ADDENDUM NUMBER 1

- a. GENERAL: Added VOIP handsets in various offices and drawing note 5.
- b. GENERAL: Added additional WAP's in various offices.
- c. Replace drawing in its entirety

#### T202.2- FIRST FLOOR PLAN C -DWT

- a. Library 129: Add four (4) ceiling mounted sound field speakers and complete sound field system with drawing note 1.
- b. Library 129: Add drawing note 2 next to 'WAP' device.
- c. Library 129: Add IWB and all video wiring with drawing note 3.
- d. Library 129: Add All in one component device with drawing note 4.
- e. Library 129: Add VOIP handset with drawing note 5.
- f. Library 129: Add drawing notes 6, 7, 8, 9 and 10 for equipment noted above.
- g. Gym and Stage: Add drawing note 2 and "WG" next to WAP devices.
- h. Suite 130: Add telecommunications devices in all offices, refer to E202.2 for quantities and locations.
- i. Suite 130: Add VOIP handsets in all offices and drawing note 5.
- j. Suite 130: Add additional WAP's in all offices
- k. Office spaces: Add additional WAP's in offices as indicated.
- I. Replace drawing in its entirety.
- m. GENERAL: Add drawing note 5 next to all "ip" devices.
- n. Replace drawing in its entirety.

#### T203.1- SECOND FLOOR PLAN A/B-DWT

- a. Maker space 221: Add four (4) wall mounted type sound field speakers and connect to sound field system with drawing note 1.
- b. Maker space 221: Add "WAP" devices next to the drawing note 2.
- c. Room 222 and room next to 221: Add "WAP" devices next to the drawing note 2.
- d. Room 221, 222, room next to 221, 224, 213, 227, 212, 211 and 210. Add four (4) ceiling mounted type sound field speakers and connect to sound field system with drawing note 1.
- e. Office spaces: Add additional WAP's in offices as indicated.
- f. GENERAL: Add drawing note 5 next to all "ip" devices.
- g. Replace drawing in its entirety.

#### T203.2- SECOND FLOOR PLAN C-DWT

- a. Room 231, 232, 233, 201, 202 and 203. Add four (4) ceiling mounted type sound field speakers and connect to sound field system with drawing note 1.
- b. Room 200: Add four (4) ceiling mounted sound field speakers and complete sound field system with drawing note 1.
- c. Room 200: Add drawing note 2 next to 'WAP' device.
- d. Room 200: Add IWB and all video wiring with drawing note 3.
- e. Room 200: Add All in one component device with drawing note 4.
- f. Room 200: Add VOIP handset with drawing note 5.
- g. Room 200: Add drawing notes 6, 7, 8, 9 and 10 for equipment noted above.
- h. GENERAL: Add drawing note 5 next to all "ip" devices.
- i. Replace drawing in its entirety.

Rochester Schools Modernization Program – Phase 2c (School #04) George M. Forbes- Renovation, Alterations and Addition SED # 26-16-00-01-0-004-024 DWT SED # 26-16-00-01-7-999-020 CJS Architects Project #1711.00 4/25/2018

**ADDITIONAL CLARIFICATIONS** 

None noted.

**END OF ADDENDUM NUMBER 1** 

# 08 71 00 DOOR HARDWARE

## PART 1 – GENERAL

#### 1.01 RELATED DOCUMENTS

 Drawings and general provisions of Contract, including General and Supplemental and Division 1 Specification sections, apply to the Work of this section.

### 1.02 DESCRIPTION OF WORK

- 1. "Hardware" includes items known commercially as builder's hardware which are required for swing, sliding and folding doors except special types of unique and non-matching hardware specified in the same section as the door and door frame.
- 2. All hardware furnished in connection with doors bearing Underwriters' Labels or where necessary to meet building codes, federal guidelines for non-discrimination on the basis of disabilities (ADA), and special requirements will be in strict accordance with conditions established by the authority having jurisdiction and subject to approval of that authority.
- 3. Locking and latching devices on doors from classrooms and all other rooms accessible to students shall be of a type that will always allow free and unobstructed exit from that space by a familiar means such as a lever or exit device.
- 4. All building exits and any door which is a required means of egress from an area having an occupant load of 50 persons or more may be provided with a latch or lock device only if it is an approved exit device, U.L. labeled for "ACCIDENT HAZARD"

### 1.03 SCOPE OF WORK

1. The hardware supplier shall furnish and delivery to the project all items or architectural hardware hereinafter specified in the plans and specifications, or where necessary to assure the proper operation of

all doors and wherever hardware is scheduled. Items not specifically mentioned but necessary to complete the work shall be furnished, matching in quality and finish the items described or specified. Supplier is responsible for proper coordination of all finish hardware with related sections to insure compatibility of products.

2. Items included in this section are as follows:

All Door Hardware Thresholds Weatherstripping Key Cabinet

3. Fire-Rated Assemblies inspection

#### 1.04 RELATED WORK IN OTHER SECTIONS

1. The following items are specified in other Divisions of the Specifications:

Cabinet Hardware
Steel/Expansion Joint Covers/Sill Plates
Window Hardware
Toilet Partition Hardware
Identifying Devices
Marble Thresholds

### 1.05 QUALITY ASSURANCE

- 1. Obtain each kind of hardware (latch and locksets, hinges, etc.) from only one manufacturer, although several may be indicated as offering products complying with requirements.
- 2. Supplier: A recognized builders hardware supplier who has been furnishing hardware in the project vicinity for a period of not less than 2 years, and shall have in his employ or at his disposal a qualified Architectural Hardware Consultant certified by an independent organization such as the Door and Hardware Institute or the Society of Architectural Hardware Consultants. The hardware consultant shall be available to meet with the architect and/or

General Contractor upon reasonable notice to: 1) review the hardware schedule submittal, 2) coordinate with other trades,

- The contractor shall make final adjustments to closers and exit devices and assist electrician with final testing of electric locking devices.
- 4. Pre-installation Conference: Conduct conference at Project site to comply with requirements in Division 1 Section "Project Meetings." The hardware manufacturers are to supply the pre-installation conference as well as a post-installation walk-thru. This is to insure proper installation and provide for any adjustments or replacements of hardware as required. Review methods and procedures related to electrified door hardware including, but not limited to, the following:
  - a. Inspect and discuss electrical roughing-in and other preparatory work performed by other trades.
  - b. Review and finalize construction schedule and verify availability of materials, Installer's personnel, equipment, and facilities needed to make progress and avoid delays.
  - c. Review required testing, inspecting, and certifying procedures.
  - d. Review sequence of operation or each type of electrified door hardware.

### 1.06 REGULATORY REQUIREMENTS

- Comply with accessibility requirements, comply with Americans with Disabilities Act (ADA), "Accessibility Guidelines for Buildings and Facilities (ADAAG)," ANSI A117.1, FED-STD-795, "Uniform Federal Accessibility Standards."
- 2. Fire Rated Openings: Provide hardware for fire rated openings in compliance with NFPA Standard No. 80 and local building code requirements. Provide only hardware which has been tested and

listed by UL or an approved testing agency for types and sizes of doors required and complies with requirements of door and door frame labels.

3. Fire-Rated Assemblies Inspection: Upon completion of the installation, all fire door assemblies shall be tested to confirm proper operation of the closing device and that it meets all criteria of a fire door assembly as per NFPA 80 2007 Edition. At completion of the project, written record shall be furnished by the door hardware supplier and given to the owner to be made available to the Authority Having Jurisdiction, "AHJ". The record shall show all fire rated openings, door number and location, along with hardware supplied and installed for the opening. The inspection of the fire doors that are swinging doors with builders hardware type to be performed by individuals with knowledge and understanding of the operating components of the type of door being subjected to testing as required by the AHJ.

### 1.07 SUBMITTALS

- Submit manufacturers technical information for each item of hardware. Include whatever information may be necessary to show compliance with requirements, and include instructions for installation and for maintenance of operating parts and finish. Transmit copy of applicable data to Installer.
- 2. The hardware schedule shall consist of the actual product series numbers. Bidders are required to follow manufacturer's catalog requirements for actual size of door closers, brackets and holders. All door sizes are to be noted on the hardware schedule and all hardware shall be in strict accordance with height, width, and thickness requirements. Where closers or overhead door stops are scheduled, the hardware schedule shall indicate the degree of opening for each door affected.
- 3. The hardware supplier shall submit to the architect for approval the complete hardware schedule within fifteen (15) days after award of the contract. No hardware shall be delivered until the hardware schedule has been approved by the architect.

4. The schedule shall follow requirements of the specification and shall indicate type, manufacturer's name, catalog number, location and finish of each item to be furnished, all in accordance with the Door & Hardware Institute "Architectural Hardware Scheduling Sequence and Format". "Vertical" scheduling format only. "Horizontal" schedules will be returned "Not Approved." Preface sheet listing category only and manufacturer's names of items being furnished as follows:

### 1.08 SUBSTITUTIONS AND SAMPLES

- 1. Preferred Products: Due to successful performance, durability and maintainability, the Plant Maintenance Department of the Rochester City School District stocks parts, is trained to repair, and uses the specified preferred products listed as the basis of design, in the Hardware Sets.
- 2. Equivalents: In regards to the "OR EQUAL CLAUSE" of the General Conditions of this contract, equivalents of equal or better quality may be made if approved by the District's Design Group. If the Bidder intends to use an equivalent on this project, the equivalent must be submitted to the District's Design Group for approval prior to the award of the Contract. Such request for equivalents by the Bidder shall be accompanied by physical samples of those items he proposes to substitute. Bidder shall include letter indicating which specific product feature(s) called for in the specification which the proposed substitution does not provide. Thereafter, if no requests for equivalents are presented prior to award of the Contract, the District must assume that the Bidder has intended in his bid to use these specified products.
- 3. Sample Request: Any request by the architect for samples shall be furnished by the hardware supplier no later than ten (10) days after said request is received.

## 1.09 MARKING, PACKING, DELIVERY AND STORAGE

1. All locks, exit devices, door closers, overhead door holders, hinges, kickplates, pulls and push plates, threshold and other similar items shall be individually packed in separate, suitable original containers as furnished by the hardware manufacturers. Each container shall

be clearly marked with items numbers, article numbers and names, corresponding to that listed in the hardware schedule.

- 2. Small miscellaneous items, such as door stops, coat and hat hooks and door silencers that would not require specific location identifications, may be quantity packed if properly labeled with item numbers, etc.
- 3. The Contractor shall check the hardware upon delivery with the aid of a representative of the hardware supplier's firm. The Contractor shall be responsible for the proper storage of all hardware until ready for application.

#### 1.10 JOB CONDITIONS

- 1. Coordinate hardware with other work. Tag each item or package separately, with identification related to the final hardware schedule, and include basic installation instructions in the package. Furnish hardware items of proper design for use on doors and frames of the thicknesses, profile, swing, security and similar requirements indicated, as necessary for proper installation and function. Deliver individually packaged hardware items at the proper times to the proper locations (shop or project site) for installation.
- 2. Furnish hardware templates to each fabricator of doors, frames and other work to be factory-prepared for the installation of hardware. Check the shop drawings of such other work, to confirm that adequate provisions are made for the proper installation of hardware. All template information shall be in accordance with the DHI handbook, "Recommended Procedure for Processing Hardware Schedules and Templates".

### PART 2 - PRODUCTS

## 2.01 MATERIALS AND FABRICATION

1. The drawings show the direction of slide, swing or hand of each door leaf. Furnish each item of hardware for proper installation and operation of the door movement as shown.

- 2. Produce hardware units of the basic metal and forming method indicated, using the manufacturer's standard metal alloy, composition, temper and hardness, but in no case of lesser (commercially recognized) quality than specified for the applicable hardware units by FS-H-I06, FS FF-G-III, FS FF-H-II6 and FS FF-H-I2I. Do not furnish "optional" materials or forming methods for those indicated, except as otherwise specified.
- 3. Manufacture hardware to conform to published templates, generally prepared for machine screw installation. Do not provide hardware which has been prepared for self-tapping sheet metal screws, except as specifically indicated.
- 4. Furnish screws for installation, with each hardware item. Provide Phillips flat-head screws except as otherwise indicated. Finish exposed (exposed under any condition) screws to match the hardware finish or, if exposed in surfaces of other work, to match the finish of such other work as closely as possible, including "prepared for paint" in surfaces to receive painted finish.
- 5. Provide concealed fasteners for hardware units, which are exposed when the door is closed, except to the extent no standard units of the type specified are available with concealed fasteners. All surface mounted hardware on wood doors shall be installed with thru bolts.
- 6. Furnish a complete set of specialized tools as needed for Owner's continued adjustment, maintenance, and removal and replacement of builder's hardware.
- 7. The Contractor shall check the hardware upon delivery with the aid of a representative of the hardware supplier's firm. The Contractor shall be responsible for the proper storage of all hardware until ready for application.

## 2.02 MANUFACTURERS

1. Requirements for design, grade, function, finish, size and other distinctive qualities of each type of finish hardware are indicated in the Hardware Schedule at the end of this section. Products are identified by using hardware designation numbers of the following.

2. Manufacturer's Product Designations:

Butt Hinges: Ives
Continuous Hinges: Ives
Locksets: Schlage
Exit Devices: Von Duprin
Push Bars: Von Duprin
Door Pulls: Von Duprin, Ives

Closers: LCN Automatic Door Operators LCN

Overhead Stop & Holders: Glynn-Johnson

Kickplates: Ives Silencers: Ives Floor/Wall Stops: Ives

Threshold, Seals & Weatherstrip Zero International

Cast Aluminum Thresholds Wooster

### 2.03 FINISH

- 1. Finish of hardware shall be:
  - .1 Hinges US26D @ all wood and hollow metal doors. US28/US26D @ all aluminum doors.
  - .2 Closers clear aluminum powder coat, equal to LCN 689 finish.
  - .3 Trim (push, pull, kickplates) US32D.
  - 4 Exit Devices

US26D lock and end stile cases

US26D trim

US32D Touchpad

Anodized finish on devices mounted on aluminum doors shall match door and frame finish.

- .5 Weather and sound seals; clear anodized.
- .6 Thresholds; Abrasive cast, or mill finish Aluminum, as noted.
- .7 Silencers; Grey

### 2.04 KEYING

1. Keys and Locking System

- .1 All keys, cores and cylinders to be Everest 29 restricted "T" family, as manufactured by Schlage Lock Company (owners existing system).
- .5 All cylinders must be keyed to the great grand master system following the specific instructions of the school district or its appointed liason.
- .6 All codes must be generated at the lock manufacturer mastery department and copyrighted.
- .7 All keying shall be done at the factory or by a qualified locksmith with factory bitting under the direction of a certified Architectural Hardware Consultant (AHC).
- .8 All locks and lock cylinders must accept large format interchangeable core as well as standard core cylinders where applicable.
- .9 Provide interchangeable core cylinders at all exterior doors, and interior doors with exit devices, standard core cylinders on all other interior doors.
- .10 Provide 3 change keys per lock, 5 master keys for each master system and 5 grandmasters for each grandmaster system. Furnish one extra key blank per lock.

# 2. Keying Schematic and Layout

- .1 Lock manufacturer shall successfully conduct keying meetings to ensure proper keying of all locks and cylinders.
- .2 The keying schematic shall conform to district keying system requirements in regard to proper lock manufacturer, keyway, code generation and master key order placement.
- .3 Hardware supplier shall submit keying schedule for approval prior to placing an order for the locks. Furnish a bitting list to the school district before installation of permanent cylinders.

# 3. Locks and Cylinders

- .1 Any lock manufacturer used must make housings for standard core cylinders as well as large format cores.
- .2 Lock manufacturer's representative must assist in keying locks and code generation in such a way that it will conform to all above specifications.

- .3 Lock manufacturer's housing must be able to accept Schlage Everest UL437 listed cylinder.
- .4 Mortise locksets shall be used on all new doors and for retrofit of existing doors with old mortise lock cutouts.
- .5 Mortise locksets shall be L9000 series as manufactured by Schlage Lock Co. Trim design shall be 17 lever with L style escutcheon unless specified otherwise. Trim design to be verified on a per job basis.
- 6 ND series cylindrical locksets as manufactured by Schlage Lock Co. shall be used when retrofitting existing doors with cylindrical lock cutouts.
- .7 Furnish a key cabinet system where projects have fifty new doors or involve rekeying the entire building, Telkee or equal.
- 8. Furnish temporary cylinders, or keying for the construction period. Coordinate all permanent cylinder, keys and keying requirements with Roddy Johnson, Locksmith / Plant Maintenance Division (585)-336-4126.
- 2.05 MATERIALS As listed below, unless indicated otherwise in Hardware Sets
  - 1. Hinges Ives, (Stanley, McKinney, Hager)
    - .1 All 3CB (EXCEPT as noted)
    - .2 (3) hinges up to and including 90" door height
    - .3 (4) hinges for doors over 90"
    - .4 Width of hinge =  $4\frac{1}{2}$ " except as noted, furnish wide throw hinges where trim conditions require.
    - .5 Height of hinge =  $4\frac{1}{2}$ "up to 38" door width 5" on doors over 38"
    - .6 ALL hinges on corridor doors shall be NRP (non-removeable pin)
  - 2. Continuous Hinges Ives, (Select Products, Roton)
    - .1 Hinge shall be a pinless assembly of three interlocking extrusions applied to the full height of the door and frame without mortising. The door leaf and jamb leaf shall be geared together for the entire length of the hinge and joined by a channel. Hinge knuckle shall be monolithic in appearance.

Continuous hinges with visible knuckle separations are not acceptable. Vertical door loads shall be carried on minimum 3/4" acetyl bearings through a full 180 degrees. All (HD) heavyduty hinges shall have a minimum of (32) acetyl bearings supplied on a (84") tall continuous hinge.

- 2. Screw hole locations on door leaf and jamb leaf to be templated.
- 3. Locksets- Schlage L Series, (Corbin Russwin ML2000VR Series, Best 45H)
  - .1 Locksets shall be Schlage L9000 series mortise type and must have the following features:
  - .2 Hand of lock can be changed without disassembly of lock case.
  - .3 Lever support springs are replaceable without disassembly of lock case.
  - .4 Outside spindles on locking functions on sets with lever handle trim shall be of a type which is separate from the inside spindle. Threaded swivel connection between outside and inside lever trim is unacceptable.
  - .5 Trim to be applied by threaded bushing. Exposed fasteners shall not be acceptable.
  - .6 Manufacturer shall provide universal lock chassis, one lock case for knobs or levers.

### 4. Lock Trim

- .1 Locksets shall be furnished with lever handle trim (Trim design to be determined on a per job basis). Levers shall be solid in construction, 4-3/4" minimum length. Escutcheons shall be cold forged. Roses shall be heavy wrought, 2-1/8" maximum diameter.
- .2 All locks to be furnished with (6) pin cylinders as specified above. Cylinder cams shall match the lock manufacturer's template.
- 5. Deadlocks Yale 300 Series (Accurate, Corbin/Russwin, Schlage)
- Exit Devices Von Duprin, (Stanley/Precision 2000 Apex, Sargent 80)
   .1 99 Series except as noted

- .2 Keyed removable mullions on pairs of doors.
- .3 Furnish glass bead kits at fire doors wherever the glass area falls below 42" above finish floor.
- .4 All devices shall incorporate fluid damper or similar device, which will slow down the touchbar return, thereby eliminating the noise commonly, associated with panic bars.
- .5 Strikes at pullman type latches shall be roller type.
- .6 The latchbolt shall be molly coated, a self-lubricating coating, which reduces friction and wear. Latchbolt shall have a deadlocking feature.
- .7 Center Case: Shall be interchangeable with all functions.
- .8 All internal parts shall be zinc dichromate coated.
- .9 Strikes: Shall be roller type and come complete with a locking plate to prevent movement.
- .12 Trim: Shall be heavy-duty type and fastened by means of concealed welded lugs and thru bolts from the inside. Lever trim shall be cast, or forged brass with a minimum average thickness on the escutcheon of (.130). Plate on pull trim shall be minimum average thickness (.090) and have forged pulls.
- .13 Lever trim shall incorporate two heavy duty compression springs and have breakaway feature.
- 7. Closers LCN 4000 Series, (Sargent 281 Series less PRV)
  - .1 Furnish LCN with standard metal cover, EXCEPT as noted.
  - .2 Indicate degree of opening for mounting closer for each door on hardware schedule.
  - .3 Furnish with each closer a full size screw location template for correct type of mounting and degree of opening.

- .4 Furnish thru-bolts and ceal nuts (NOT GROMMETS) at all wood fire doors and as may be required by carpenter for correct fastening.
- .5 Metal cover shall be fastened to closer body with tamper resistant screws, installed through holes in cover. Slotted covers are not acceptable. Closer arm shall be fastened to frame with tamper resistant screws.
- .6 All closers shall meet or exceed the ANSI 117 standards.
- .7 Furnish all adapter plates, brackets, and related closer accessories required by manufacturer for mounting closers on the doors and frames as detailed.
- .8 All manual door closers shall be certified to exceed ten million (10,000,000) full load operating cycles by a recognized independent testing laboratory.
- .9 All manual closers shall carry a manufacturers minimum ten (10) year warranty.
- .10 All closer with electrical or pneumatic components shall carry a manufacturers two (2) year warranty.
- .11 Fully hydraulic, rack and pinion action with high strength cast iron cylinders and one piece forged steel pistons.
- .12 Hydraulic fluid of a type requiring no seasonal adjustments for temperatures from 120° F (49° C) to -30° F (-35° C).
- .13 Pinion shaft minimum diameter of 11/16".
- .14 Hydraulic regulation controlled by tamper-proof, non-critical screw valves, adjustable with a hex wrench. Separate adjustments for backcheck, general speed, and latch speed. Backcheck shall be properly located for protection of the door, frame, and applied hardware.

- .15 Forged steel main arms. Forged steel main and forearms at PA application. Arms at PA location shall be vandal proof design. Any PA arm that can be taken apart in the field shall not be acceptable.
- 8. Push/Pull Plates Ives (Rocwood Mfg., Baldwin) Except As Indicated In Hardware Types Furnish:
  - .1 Push Plate #8200 3-1/2" x 15"
  - .2 Pull Plate #8305-8 3-1/2" x 15"
- 9. Kickplates Ives 8400 Series (Rockwood Mfg., Baldwin)
  - .1 (.051") thick.
  - .2 8" high except as noted.
  - .3 Width of door less 2" on push side.
  - .4 Width of door less ½" on pull side.
  - .5 Width of door less 6" on doors with surface vertical rods.
- 10. Stops Ives, (Rockwood Mfg.)
  - .1 FS436 floor stops at all doors EXCEPT: WS407CVX where knob contacts wall or Glynn-Johnson (Rixson) 90/450 series OH Stop where floor and wall stops are impractical.
- 11. Overhead Door Holders Glynn Johnson 90/450 Series (Rixson)
- 12. Thresholds Wooster, Zero (National Guard, Reese)
  - .1 Furnish #115-4" Alumogrit notched for stops except as noted or detailed otherwise.
  - .2 Furnish stainless steel screws and lead anchors for fastening.
- 13. Sweepstrips Zero (National Guard C607, Reese 964)
  - .1 Nylon Brush type 8192 x width of door
  - .2 Polypropylene UNACCEPTABLE
- 14. Weatherstripping Zero, (National Guard A625, Reese 961)

- .1 Nylon brush type 8305 head & jamb, except as noted
- .2 Polypropylene UNACCEPTABLE
- 15. Soundproof Gasketing Zero (National Guard, Reese)
  - .1 Wherever soundproofing is shown or listed in the specifications or drawings, furnish:
    - .1 170 adjustable gasketing mitered at head and jambs
    - .2 361 automatic door bottom
- 16. Manual Flush Bolts Ives (Door Controls, Rockwood Mfg.) FB458
- 17. Automatic Flush Bolts Ives (Door Controls, Rockwood Mfg.)
  - .1 FB30 (metal doors) FB40 (wood doors)
  - .2 Furnish DP2 dustproof strike at bottom bolt
- 18. Self-Latching Bolts Ives (Door Controls, Rockwood Mfg.) FB50 (metal doors), FB60 (wood doors)
  - .1 Furnish DP2 dustproof strike at bottom bolt
- 19. Coordinators Ives (Door Controls, Rockwood Mfg.)
  - .1 Furnish C O R Series with required brackets and CB-1 carry bar, unless otherwise noted.
- 20. Electromagnetic Stops & Holder LCN SEM Series, (Rixson, Dorma)
- 21. Astragals Zero (National Guard, Reese)
  - .1 8194 at meeting stiles at fire rated wood doors
- 22. Smoke Gasketing Zero (National Guard, Reese)
  - .1 188S stick on silicone head & Jamb

#### Hardware Set No. 01

#### Each To Have:

1	EΑ	CONT. HINGE	224HD	628	IVE
1	EA	CLASSROOM	L9071T 17L	626	SCH
		SECURITY			
2	EΑ	FSIC CORE	23-030 EV29 T	626	SCH
1	EΑ	SURFACE CLOSER	4111 EDA MC TBTRX	689	LCN
1	EΑ	KICK PLATE	8400 8" X 1 1/2" LDW B-CS	630	IVE

Rochester Schools Modernization Program – Phase 2c (School #04) George M. Forbes- Renovation, Alterations and Addition SED # 26-16-00-01-0-004-024 DWT SED # 26-16-00-01-7-999-020 CJS Architects Project #1711.00 4/9/2018

1 EA 1 EA	WALL STOP GASKETING	WS406/407CVX 188FSBK PSA	630 BK	IVE ZER				
Hardware Set No. 02								
Each To Have:								
2 EA 1 SET	CONT. HINGE CONST LATCHING BOLT	224HD FB61P	628 630	IVE IVE				
1 EA 1 EA	DUST PROOF STRIKE CLASSROOM SECURITY	DP2 L9071T 17L	626 626	IVE SCH				
1 EA 2 EA 2 EA 2 EA 2 EA 1 EA	FSIC CORE SURFACE CLOSER KICK PLATE WALL STOP MEETING STILE GASKETING	23-030 EV29 T 4111 EDA MC TBTRX 8400 8" X 1" LDW B-CS WS406/407CVX 8194AA 188FSBK PSA	626 689 630 630 AA BK	SCH LCN IVE IVE ZER ZER				
Hardware Set No. 03								
Each To Have	):							
6 EA 2 EA 1 EA 1 EA 2 EA 2 EA	HINGE MANUAL FLUSH BOLT DUST PROOF STRIKE CLASSROOM LOCK FSIC CORE WALL STOP SILENCER	5BB1 4.5 X 4.5 NRP FB458 12" DP2 L9070T 17L 23-030 EV29 T WS406/407CVX SR64	652 626 626 626 626 630 GRY	IVE IVE SCH SCH IVE IVE				
Hardware Set No. 04								
Each To Have:								
3 EA 1 EA 1 EA 1 EA 1 EA 1 EA	HINGE FACULTY RESTROOM FSIC CORE SURFACE CLOSER KICK PLATE WALL STOP GASKETING	5BB1 4.5 X 4.5 L9485T 06A L583-363 L283-722 23-030 EV29 T 4011 MC TBTRX 8400 8" X 1 1/2" LDW B-CS WS406/407CVX 188FSBK PSA	652 626 626 689 630 630 BK	IVE SCH SCH LCN IVE IVE ZER				

Hardware Set No. 05

### Each To Have:

3	EA	HINGE	5BB1 4.5 X 4.5	652	IVE
1	EA	STOREROOM LOCK	L9080T 17L	626	SCH
1	EA	FSIC CORE	23-030 EV29 T	626	SCH
1	EA	SURFACE CLOSER	4011 MC TBTRX	689	LCN
1	EA	KICK PLATE	8400 8" X 1 1/2" LDW B-CS	630	IVE
1	EA	WALL STOP	WS406/407CVX	630	IVE
1	EA	GASKETING	188FSBK PSA	BK	ZER

### Hardware Set No. 06

### Each To Have:

2	EA	CONT. HINGE	224HD	628	IVE
1	EΑ	FIRE RATED	KR9954	689	VON
		REMOVABLE MULLION			
2	EΑ	FIRE EXIT HARDWARE	99-L-F-17	626	VON
2	EA	RIM CYLINDER	20-057 ICX	626	SCH
3	EΑ	FSIC CORE	23-030 EV29 T	626	SCH
1	EA	MORTISE CYLINDER	26-091 ICX	626	SCH
2	EA	SURFACE CLOSER	4111 CUSH MC TBTRX	689	LCN
2	EΑ	KICK PLATE	8400 8" X 1" LDW B-CS	630	IVE
1	EΑ	GASKETING	188FSBK PSA	BK	ZER

# Hardware Set No. 07

### Each To Have:

3	EΑ	HINGE	5BB1 4.5 X 4.5 NRP	652	IVE
1	EΑ	CLASSROOM LOCK	L9070T 17L	626	SCH
1	EΑ	FSIC CORE	23-030 EV29 T	626	SCH
1	EΑ	SURFACE CLOSER	4111 EDA MC TBTRX	689	LCN
1	EΑ	KICK PLATE	8400 8" X 1 1/2" LDW B-CS	630	IVE
1	EΑ	FIRE/LIFE WALL MAG	SEM7830	689	LCN
1	EΑ	GASKETING	188FSBK PSA	BK	ZER

Doors held open by wall magnets. Automatic release upon smoke/fire alarm activation.

Hardware Set	Hardware Set No. 08			
Each To Have 3 EA 1 EA 1 EA 1 EA 1 EA 3 EA	HINGE STOREROOM LOCK FSIC CORE SURFACE CLOSER KICK PLATE SILENCER	5BB1HW 5 X 4.5 NRP L9080T 17L 23-030 EV29 T 4111 CUSH MC TBTRX 8400 8" X 1 1/2" LDW B-CS SR64	652 626 626 689 630 GRY	IVE SCH SCH LCN IVE IVE
Hardware Set	No. 09			
Each To Have 3 EA 1 EA 1 EA 1 EA 1 EA 1 EA	HINGE PRIVACY LOCK SURFACE CLOSER KICK PLATE WALL STOP GASKETING	5BB1 4.5 X 4.5 L9040 17N L583-363 L283-722 4011 MC TBTRX 8400 8" X 1 1/2" LDW B-CS WS406/407CVX 188FSBK PSA	652 626 689 630 630 BK	IVE SCH LCN IVE IVE ZER
Hardware Set	No. 10			
Each To Have 3 EA 1 EA 1 EA 1 EA 1 EA 1 EA	HINGE FIRE EXIT HARDWARE RIM CYLINDER SURFACE CLOSER KICK PLATE GASKETING	5BB1 4.5 X 4.5 99-NL-F 20-057 ICX 4111 CUSH MC TBTRX 8400 8" X 1 1/2" LDW B-CS 188FSBK PSA	652 626 626 689 630 BK	IVE VON SCH LCN IVE ZER
Hardware Set	No. 11			
Each To Have 6 EA 1 EA 1 EA 1 EA 2 EA 2 EA 1 EA	HINGE STOREROOM LOCK FSIC CORE COORDINATOR OH STOP SURFACE CLOSER KICK PLATE WALL STOP	5BB1 4.5 X 4.5 L9080T 17L 23-030 EV29 T COR7G 90S 4011 MC TBTRX 8400 8" X 1" LDW B-CS WS406/407CVX	652 626 626 626 630 689 630 630	IVE SCH SCH IVE GLY LCN IVE IVE

1 EA	GASKETING	188FSBK PSA	ВК	ZER
Hardware Se	t No. 12			
Each To Have	e:			
6 EA 1 SET	HINGE CONST LATCHING BOLT	5BB1 4.5 X 4.5 NRP FB51P	652 630	IVE IVE
1 EA 1 EA 1 EA 2 EA 1 EA	DUST PROOF STRIKE STOREROOM LOCK FSIC CORE SURFACE CLOSER GASKETING	DP2 L9080T 17L 23-030 EV29 T 4111 CUSH MC TBTRX 188FSBK PSA	626 626 626 689 BK	IVE SCH SCH LCN ZER
Hardware Se	t No. 13			
Each To Have	e:			
3 EA 1 EA 1 EA 1 EA 1 EA 1 EA 1 EA	HINGE FIRE EXIT HARDWARE RIM CYLINDER FSIC CORE SURFACE CLOSER KICK PLATE WALL STOP GASKETING	5BB1 4.5 X 4.5 99-NL-F 20-057 ICX 23-030 EV29 T 4111 EDA MC TBTRX 8400 8" X 1 1/2" LDW B-CS WS406/407CVX 188FSBK PSA	652 626 626 626 689 630 630 BK	IVE VON SCH SCH LCN IVE IVE ZER
Hardware Se	t No. 14			
Each To Have	e:			
3 EA 1 EA 1 EA 3 EA	HINGE PRIVACY LOCK WALL STOP SILENCER	5BB1 4.5 X 4.5 L9040 17N L583-363 L283-722 WS406/407CVX SR64	652 626 630 GRY	IVE SCH IVE IVE
Hardware Se	t No. 15			
Each To Have				
3 EA	HINGE	5BB1 4.5 X 4.5	652	IVE

Rochester Schools Modernization Program - Phase 2c (School #04)
George M. Forbes- Renovation, Alterations and Addition
SED # 26-16-00-01-0-004-024
DWT SED # 26-16-00-01-7-999-020

1 EA 1 EA 1 EA 3 EA	CLASSROOM LOCK FSIC CORE WALL STOP SILENCER	L9070T 17L 23-030 EV29 T WS406/407CVX SR64	626 626 630 GRY	SCH SCH IVE IVE
Hardware Se	t No. 16			
Each To Have	e:			
3 EA 1 EA 1 EA 1 EA 1 EA 1 EA	HINGE PASSAGE SET SURFACE CLOSER KICK PLATE WALL STOP GASKETING	5BB1 4.5 X 4.5 L9010 17L 4011 MC TBTRX 8400 8" X 1 1/2" LDW B-CS WS406/407CVX 188FSBK PSA	652 626 689 630 630 BK	IVE SCH LCN IVE IVE ZER
Hardware Se	t No. 17			
Each To Have				
3 EA 1 EA 1 EA 1 EA 1 EA 1 EA	HINGE STOREROOM LOCK FSIC CORE OH STOP SURFACE CLOSER KICK PLATE GASKETING	5BB1 4.5 X 4.5 L9080T 17L 23-030 EV29 T 90S 4011 MC TBTRX 8400 8" X 1 1/2" LDW B-CS 188FSBK PSA	652 626 626 630 689 630 BK	IVE SCH SCH GLY LCN IVE ZER
Hardware Se	t No. 18			
Each To Have			050	I) /=
6 EA 1 SET	HINGE CONST LATCHING	5BB1 4.5 X 4.5 FB61P	652 630	IVE IVE
1 EA 1 EA 1 EA 2 EA 2 EA 2 EA 2 EA 1 EA	BOLT DUST PROOF STRIKE STOREROOM LOCK FSIC CORE OH STOP SURFACE CLOSER KICK PLATE MEETING STILE GASKETING	DP2 L9080T 17L 23-030 EV29 T 90S 4011 MC TBTRX 8400 8" X 1" LDW B-CS 8194AA 188FSBK PSA	626 626 626 630 689 630 AA BK	IVE SCH SCH GLY LCN IVE ZER ZER

# Hardware Set No. 19

Fach	$T \cap$	Have:	

3	EΑ	HINGE	5BB1 4.5 X 4.5 NRP	652	IVE
1	EA	STOREROOM LOCK	L9080T 17L	626	SCH
1	EA	FSIC CORE	23-030 EV29 T	626	SCH
1	EA	SURFACE CLOSER	4111 CUSH MC TBTRX	689	LCN
1	EA	KICK PLATE	8400 8" X 1 1/2" LDW B-CS	630	IVE
1	EA	GASKETING	188FSBK PSA	BK	ZER

#### Hardware Set No. 20

### Each To Have:

6	EA	HINGE	5BB1 4.5 X 4.5	652	IVE
6	EA	HINGE	5BB1 4.5 X 4.5 NRP	652	IVE
1	SET	CONST LATCHING BOLT	FB51P	630	IVE
1	EA	DUST PROOF STRIKE	DP2	626	IVE
1	EA	STOREROOM LOCK	L9080T 17L	626	SCH
1	EA	FSIC CORE	23-030 EV29 T	626	SCH
2	EA	OH STOP	90S	630	GLY
2	EA	SURFACE CLOSER	4011 MC TBTRX	689	LCN
2	EA	KICK PLATE	8400 8" X 1" LDW B-CS	630	IVE
1	EΑ	GASKETING	188FSBK PSA	BK	ZER

# Hardware Set No. 21

6	EΑ	HINGE	5BB1 4.5 X 4.5 NRP	652	IVE
1	SET	CONST LATCHING	FB51P	630	IVE
		BOLT			
1	EA	DUST PROOF STRIKE	DP2	626	IVE
1	EΑ	STOREROOM LOCK	L9080T 17L	626	SCH
1	EΑ	FSIC CORE	23-030 EV29 T	626	SCH
2	EA	SURFACE CLOSER	4111 EDA MC TBTRX	689	LCN
2	EΑ	WALL STOP	WS406/407CVX	630	IVE
1	EΑ	GASKETING	188FSBK PSA	BK	ZER

Hardware Set No.	. 22			
2 EA D 2 EA O 1 EA C	PIVOT SET POOR PULL, 3/4" RND PH STOP & HOLDER PABINET HARDWARE PILENCER	7226 SET 8102HD 8" STD 450F CL21A SR65	626 630 630 626 GRY	IVE IVE GLY IVE IVE
Hardware Set No.	. 23			
1 EA C 1 EA F3 1 EA O	IINGE ELASSROOM LOCK SIC CORE DH STOP & HOLDER ILENCER	5BB1 4.5 X 4.5 NRP L9070T 17L 23-030 EV29 T 450F SR64	652 626 626 630 GRY	IVE SCH SCH GLY IVE
Hardware Set No.	. 24			
1 SET C B 1 EA D 1 EA C 1 EA C 1 EA C 2 EA M	CONT. HINGE CONST LATCHING OLT OUST PROOF STRIKE CLASSROOM LOCK SIC CORE COORDINATOR	224HD FB61P DP2 L9070T 17L 23-030 EV29 T COR X FL MB	628 630 626 626 626 628 689	IVE IVE IVE SCH SCH IVE IVE
1 EA SI 2 EA KI 1 EA W	URFACE CLOSER URFACE CLOSER ICK PLATE VALL STOP BASKETING	4111 CUSH MC TBTRX 4111 EDA MC TBTRX 8400 8" X 1" LDW B-CS WS406/407CVX 188FSBK PSA	689 689 630 630 BK	LCN LCN IVE IVE ZER
Hardware Set No.	. 25			
1 EA O	IINGE PFFICE/ENTRY LOCK SIC CORE	5BB1 4.5 X 4.5 L9050T 17L L583-363 23-030 EV29 T	652 626 626	IVE SCH SCH

CJS Architects Project #1711.00 4/9/2018

1 EA 1 EA 1 EA 1 EA	SURFACE CLOSER KICK PLATE WALL STOP GASKETING	4011 MC TBTRX 8400 8" X 1 1/2" LDW B-CS WS406/407CVX 188FSBK PSA	689 630 630 BK	LCN IVE IVE ZER			
Hardware Set No. 26							
Each To Have	<b>.</b>						
1 EA 1 EA 1 EA 1 EA 1 EA 1 EA	CONT. HINGE STOREROOM LOCK FSIC CORE SURFACE CLOSER KICK PLATE GASKETING	224HD L9080T 17L 23-030 EV29 T 4111 CUSH MC TBTRX 8400 8" X 1 1/2" LDW B-CS 188FSBK PSA	628 626 626 689 630 BK	IVE SCH SCH LCN IVE ZER			
Hardware Set	: No. 27						
Each To Have 1 EA	CONT. HINGE CLASSROOM LOCK FSIC CORE SURFACE CLOSER KICK PLATE WALL STOP GASKETING	224HD L9070T 17L 23-030 EV29 T 4011T BUMP MC TBTRX 8400 8" X 1 1/2" LDW B-CS WS406/407CVX 188FSBK PSA	628 626 626 689 630 630 BK	IVE SCH SCH LCN IVE IVE ZER			
Hardware Set No. 28							
Each To Have  3 EA  1 EA	HINGE STOREROOM LOCK FSIC CORE SURFACE CLOSER KICK PLATE WALL STOP GASKETING	5BB1 4.5 X 4.5 NRP L9080T 17L 23-030 EV29 T 4111 EDA MC TBTRX 8400 8" X 1 1/2" LDW B-CS WS406/407CVX 188FSBK PSA	652 626 626 689 630 630 BK	IVE SCH SCH LCN IVE IVE ZER			

Hardware Set No. 29

Each To Have 3 EA 1 EA 1 EA 1 EA 3 EA	e: HINGE CLASSROOM LOCK FSIC CORE WALL STOP SILENCER	5BB1 4.5 X 4.5 NRP L9070T 17L 23-030 EV29 T WS406/407CVX SR64	652 626 626 630 GRY	IVE SCH SCH IVE IVE
Hardware Se	t No. 30			
Each To Have	e:			
3 EA 1 EA 1 EA 1 EA 1 EA 1 EA	HINGE CLASSROOM LOCK FSIC CORE SURFACE CLOSER KICK PLATE GASKETING	5BB1 4.5 X 4.5 L9070T 17L 23-030 EV29 T 4111 CUSH MC TBTRX 8400 8" X 1 1/2" LDW B-CS 188FSBK PSA	652 626 626 689 630 BK	IVE SCH SCH LCN IVE ZER
Hardware Se	t No. 31			
Each To Have 3 EA 1 EA 1 EA 3 EA	e: HINGE PASSAGE SET WALL STOP SILENCER	5BB1 4.5 X 4.5 L9010 17L WS406/407CVX SR64	652 626 630 GRY	IVE SCH IVE IVE
Hardware Se	t No. 32			
Each To Have 1 EA 1 EA	e: CONT. HINGE CLASSROOM SECURITY	224HD L9071T 17L	628 626	IVE SCH
2 EA 1 EA 1 EA 1 EA 1 EA 1 EA	FSIC CORE SURFACE CLOSER KICK PLATE WALL STOP GASKETING DOOR BOTTOM MOUNTING BRACKET	23-030 EV29 T 4111 EDA MC TBTRX 8400 8" X 1 1/2" LDW B-CS WS406/407CVX 870AA-S 360AA 870SPB	626 689 630 630 AA AA	SCH LCN IVE IVE ZER ZER ZER

Hardware Set No. 33						
Each To Have	e:					
2 EA 1 SET	CONT. HINGE CONST LATCHING BOLT	224HD FB61P	628 630	IVE IVE		
1 EA 1 EA	DUST PROOF STRIKE CLASSROOM SECURITY	DP2 L9071T 17L	626 626	IVE SCH		
2 EA 2 EA 2 EA 2 EA 1 EA 2 EA 2 EA	FSIC CORE SURFACE CLOSER KICK PLATE WALL STOP MEETING STILE GASKETING DOOR BOTTOM MOUNTING BRACKET	23-030 EV29 T 4111 EDA MC TBTRX 8400 8" X 1" LDW B-CS WS406/407CVX 328AA-S 870AA-S 360AA 870SPB	626 689 630 630 AA AA AA	SCH LCN IVE IVE ZER ZER ZER ZER		
Hardware Set	No. 34					
Each To Have	<b>e</b> :					
1 EA 1 EA	CONT. HINGE CLASSROOM SECURITY	224HD L9071T 17L	628 626	IVE SCH		
2 EA 1 EA 1 EA 1 EA	FSIC CORE SURFACE CLOSER KICK PLATE GASKETING	23-030 EV29 T 4111 CUSH MC TBTRX 8400 8" X 1 1/2" LDW B-CS 188FSBK PSA	626 689 630 BK	SCH LCN IVE ZER		
Hardware Set No. 35						
Each To Have	<b>:</b> :					
1 EA 1 EA	CONT. HINGE CLASSROOM SECURITY	224HD L9071T 17L	628 626	IVE SCH		
2 EA 1 EA 1 EA 1 EA 1 EA	FSIC CORE OH STOP SURFACE CLOSER KICK PLATE GASKETING	23-030 EV29 T 90S 4011 MC TBTRX 8400 8" X 1 1/2" LDW B-CS 188FSBK PSA	626 630 689 630 BK	SCH GLY LCN IVE ZER		

Hardware Set No. 36						
Each To Have 3 EA 1 EA 1 EA 3 EA	e: HINGE PASSAGE SET OH STOP SILENCER	5BB1 4.5 X 4.5 L9010 17L 450S SR64	652 626 630 GRY	IVE SCH GLY IVE		
Hardware Set	No. 37					
Each To Have 3 EA 1 EA	HINGE STOREROOM LOCK FSIC CORE SURFACE CLOSER KICK PLATE WALL STOP GASKETING	5BB1 4.5 X 4.5 L9080T 17L 23-030 EV29 T 4011 MC TBTRX 8400 8" X 1 1/2" LDW B-CS WS406/407CVX 188FSBK PSA	652 626 626 689 630 630 BK	IVE SCH SCH LCN IVE IVE ZER		
Hardware Set	No. 38					
Each To Have	<b>:</b> :					
2 EA 1 EA 1 SET	CONT. HINGE POWER TRANSFER CONST LATCHING	224HD EPT10 FB61P	628 689 630	IVE VON IVE		

Card reader, power supply, REX and door contact by Owner.

DUST PROOF STRIKE

STOREROOM LOCK

ELECTRIC STRIKE

SURFACE CLOSER

COORDINATOR

MEETING STILE

**GASKETING** 

Theory of operation: From Corridor, Doors normally latched and locked. Proper credential to reader energizes electric strike allowing active (RHR) leaf to be opened.

DP2

L9080T 17L

6223 FSE

COR7G

8194AA

23-030 EV29 T

4011 MC TBTRX

188FSBK PSA

Free egress from Receiving at all times.

**BOLT** 

**FSIC CORE** 

1

1

2

1

EΑ

EΑ

Hardware Set No. 39

IVE

SCH

SCH

VON

IVE

LCN

ZER

ZER

626

626

626

630

626

689

AA

BK

CJS Architects Project #1711.00 4/9/2018

Each 7	To Have	:			
2	EA	CONT. HINGE	224HD	628	IVE
1	EA	REMOVABLE MULLION	KR4854B	689	VON
1	EA	FIRE EXIT HARDWARE	99-L-F-17	626	VON
			Less Strike		
1	EA	FIRE EXIT HARDWARE	99-L-F-17-499F	626	VON
2	EA	RIM CYLINDER	20-057 ICX	626	SCH
3	EA	FSIC CORE	23-030 EV29 T	626	SCH
1	EA	MORTISE CYLINDER	26-091 ICX	626	SCH
1	EA	ELECTRIC STRIKE	6300 FSE	630	VON
1	EA	SURFACE CLOSER	4111 CUSH MC TBTRX	689	LCN
1	EA	SURFACE CLOSER	4111 EDA MC TBTRX	689	LCN
2	EA	KICK PLATE	8400 8" X 1 1/2" LDW B-CS	630	IVE
1	EΑ	GASKETING	188FSBK PSA	BK	ZER

Card reader, power supply, REX and door contact by Owner.

Theory of operation: From Main Lobby, doors normally latched and locked. Proper credential to reader or remote release from Office energizes electric strike allowing active (RHR) leaf to be pulled open.

Free egress from Corridor at all times.

#### Hardware Set No. 40

### Each To Have:

6	EΑ	HINGE	5BB1 4.5 X 4.5	652	IVE
1	EΑ	STOREROOM LOCK	L9080T 17L	626	SCH
1	EΑ	FSIC CORE	23-030 EV29 T	626	SCH
1	EΑ	COORDINATOR	COR7G	626	IVE
1	EΑ	OH STOP	90S	630	GLY
2	EΑ	SURFACE CLOSER	4011 MC TBTRX	689	LCN
2	EΑ	KICK PLATE	8400 8" X 1" LDW B-CS	630	IVE
1	EΑ	WALL STOP	WS406/407CVX	630	IVE
2	EΑ	MEETING STILE	8194AA	AA	ZER
1	EΑ	GASKETING	188FSBK PSA	BK	ZER

#### Hardware Set No. 41

3	EA	HINGE	5BB1 4.5 X 4.5	652	IVE
1	EA	CLASSROOM	L9071T 17L	626	SCH
		SECURITY			
2	EA	FSIC CORE	23-030 EV29 T	626	SCH
1	EA	SURFACE CLOSER	4011 MC TBTRX	689	LCN
1	EΑ	KICK PLATE	8400 8" X 1 1/2" LDW B-CS	630	IVE

Rochester Schools Modernization Program – Phase 2c (School #04)
George M. Forbes- Renovation, Alterations and Addition
SED # 26-16-00-01-0-004-024
DWT SED # 26-16-00-01-7-999-020

1 EA 1 EA	WALL STOP GASKETING	WS406/407CVX 188FSBK PSA	630 BK	IVE ZER		
Hardware Se	t No. 43					
Each To Have	e:					
3 EA 1 EA 1 EA 3 EA	HINGE PRIVACY LOCK WALL STOP SILENCER	5BB1 4.5 X 4.5 L9040 17L WS406/407CVX SR64	652 626 630 GRY	IVE SCH IVE IVE		
Hardware Set No. 44						
Each To Have	e:					
3 EA 1 EA 1 EA 1 EA 3 EA	HINGE OFFICE/ENTRY LOCK FSIC CORE WALL STOP SILENCER	5BB1 4.5 X 4.5 L9050T 17L L583-363 23-030 EV29 T WS406/407CVX SR64	652 626 626 630 GRY	IVE SCH SCH IVE IVE		
Hardware Se	t No. 45					
Each To Have						
3 EA 1 EA 1 EA 1 EA 1 EA 1 EA	HINGE OFFICE/ENTRY LOCK FSIC CORE OH STOP SURFACE CLOSER KICK PLATE GASKETING	5BB1 4.5 X 4.5 L9050T 17L L583-363 23-030 EV29 T 450S 4011 MC TBTRX 8400 8" X 1 1/2" LDW B-CS 188FSBK PSA	652 626 626 630 689 630 BK	IVE SCH SCH GLY LCN IVE ZER		
Hardware Se	t No. 46					
Each To Have						
3 EA 1 EA	HINGE STOREROOM LOCK	5BB1 4.5 X 4.5 L9080T LLL 17L	652 626	IVE SCH		
1 EA	LESS STRIKE FSIC CORE	23-030 EV29 T	626	SCH		

CJS Architects Project #1711.00 4/9/2018

1	EΑ	ELECTRIC STRIKE	6211 FSE	630	VON
1	EΑ	SURFACE CLOSER	4011 MC TBTRX	689	LCN
1	EΑ	KICK PLATE	8400 8" X 1 1/2" LDW B-CS	630	IVE
1	EA	GASKETING	188FSBK PSA	BK	ZER

Card reader, power supply, REX and door contact by Owner.

#### Hardware Set No. 47

### Each To Have:

3	EΑ	HINGE	5BB1 4.5 X 4.5	652	IVE
1	EΑ	CLASSROOM LOCK	L9070T 17L	626	SCH
1	EΑ	FSIC CORE	23-030 EV29 T	626	SCH
1	EA	SURFACE CLOSER	4011 MC TBTRX	689	LCN
1	EΑ	KICK PLATE	8400 8" X 1 1/2" LDW B-CS	630	IVE
1	EΑ	WALL STOP	WS406/407CVX	630	IVE
1	EΑ	GASKETING	188FSBK PSA	BK	ZER

### Hardware Set No. 48

## Each To Have:

2	EA	CONT. HINGE	224HD	628	IVE
2	EA	MANUAL FLUSH BOLT	FB458 12"	626	IVE
1	EΑ	STOREROOM LOCK	L9080T 17L	626	SCH
1	EA	FSIC CORE	23-030 EV29 T	626	SCH
1	EA	OH STOP & HOLDER	90H	630	GLY
1	EΑ	SURFACE CLOSER	4111 HCUSH MC TBWMS	689	LCN
1	EΑ	GASKETING	429AA-S	AA	ZER
2	EA	DOOR SWEEP	8192AA	AA	ZER
1	EA	THRESHOLD	656A-223	Α	ZER

Overlapping astragal by door mfr.

### Hardware Set No. 49

2	EΑ	CONT. HINGE	224HD	628	IVE
2	EΑ	MANUAL FLUSH BOLT	FB458 12"	626	IVE
1	EΑ	DUST PROOF STRIKE	DP2	626	IVE
1	EΑ	CLASSROOM LOCK	L9070T 17L	626	SCH
1	EΑ	FSIC CORE	23-030 EV29 T	626	SCH

CJS Architects Project #1711.00 4/9/2018

1	EA	COORDINATOR	COR7G	626	IVE
2	EΑ	SURFACE CLOSER	4011 MC TBTRX	689	LCN
2	EΑ	KICK PLATE	8400 8" X 1" LDW B-CS	630	IVE
2	EΑ	FLOOR STOP/HOLDER	FS496	626	IVE
2	EΑ	WALL STOP	WS406/407CVX	630	IVE

### Hardware Set No. 50

### Each To Have:

2	EA	CONT. HINGE	224HD	628	IVE
1	SET	CONST LATCHING BOLT	FB61P	630	IVE
1	EΑ	CLASSROOM LOCK	L9070T 17L	626	SCH
1	EA	FSIC CORE	23-030 EV29 T	626	SCH
1	EA	COORDINATOR	COR X FL	628	IVE
2	EΑ	MOUNTING BRACKET	MB	689	IVE
2	EΑ	SURFACE CLOSER	4111 EDA MC TBTRX	689	LCN
2	EA	KICK PLATE	8400 8" X 1" LDW B-CS	630	IVE
2	EΑ	WALL STOP	WS406/407CVX	630	IVE
1	EΑ	GASKETING	188FSBK PSA	BK	ZER

#### Hardware Set No. 51

### Each To Have:

2	EΑ	CONT. HINGE	224HD	628	IVE
1	EA	FIRE EXIT HARDWARE	9927-EO-F-LBR-499F	626	VON
1	EA	FIRE EXIT HARDWARE	9927-L-F-LBR-17-499F	626	VON
1	EA	RIM CYLINDER	20-057 ICX	626	SCH
1	EA	FSIC CORE	23-030 EV29 T	626	SCH
2	EA	SURFACE CLOSER	4111 EDA MC TBTRX	689	LCN
2	EA	KICK PLATE	8400 8" X 1" LDW B-CS	630	IVE
2	EA	FIRE/LIFE WALL MAG	SEM7830	689	LCN
1	EΑ	GASKETING	188FSBK PSA	BK	ZER

Doors held open by wall magnets. Locate at lower portion of door (Dr. COR-C.1 only). Insure contact with door armatures with modification.

Automatic release upon smoke/fire alarm activation.

Hardware Set No. 52

DWT SED # 26-16-00-01-7-999-020

2	EA	CONT. HINGE	224HD	628	IVE
1	EA	POWER TRANSFER	EPT10	689	VON
1	EA	REMOVABLE MULLION	KR4854B	689	VON
1	EA	PANIC HARDWARE	CD-99-EO	626	VON
1	EA	ELEC PANIC	CD-LX-LC-99-NL-OP-110MD	626	VON
		HARDWARE	Less Strike		
1	EA	RIM CYLINDER	20-057 ICX	626	SCH
4	EA	FSIC CORE	23-030 EV29 T	626	SCH
1	EA	MORTISE CYLINDER	26-091 ICX	626	SCH
2	EA	MORTISE CYLINDER	26-091 ICX XQ11-948	626	SCH
1	EA	ELECTRIC STRIKE	6300 FSE	630	VON
1	EA	SURFACE CLOSER	4111 CUSH MC TBTRX	689	LCN
1	EA	SURF. AUTO	4642 WMS	689	LCN
		OPERATOR			
1	EA	ACTUATOR PKG WALL	8310-3860TW	630	LCN
		MT			
1	EA	GASKETING	429AA-S	AA	ZER
1	EΑ	THRESHOLD	656A-223	Α	ZER

Card reader, power supply, REX and door contact by Owner.

Integral flush pull and recessed adjustable door bottom by door mfr.

Theory of operation: From exterior, doors normally latched and locked. Outside actuator disabled.

Proper credential to reader or remote signal from Office energizes electric strike and enables outside actuator. Pressing actuator initiates automatic operation of active (RHR) leaf.

From Stair - When locked, actuator always enabled. pressing actuator energizes electric strike and initiates automatic operation.

When unlocked, latches are held retracted in the dogged position for push-pull operation.

Pressing either actuator initiates automatic operation.

Free egress from Stair at all times.

## Hardware Set No. 53

#### Each To Have:

1	EΑ	CONT. HINGE	224HD	628	IVE
1	EΑ	STOREROOM LOCK	L9080T LLL 17L	626	SCH
		LESS STRIKE			
1	EΑ	FSIC CORE	23-030 EV29 T	626	SCH
1	EΑ	ELECTRIC STRIKE	6211 FSE	630	VON
1	EΑ	LOCK GUARD	LG14	630	IVE
1	EΑ	SURFACE CLOSER	4111 CUSH MC TBTRX	689	LCN
1	EΑ	GASKETING	429AA-S	AA	ZER
1	EΑ	THRESHOLD	656A-223	Α	ZER

Card reader, power supply, REX and door contact by Owner.

Integral flush pull and recessed adjustable door bottom by door mfr.

Theory of operation: Door normally latched and locked. Proper credential to reader or remote

release from Custodian or Main Office energizes electric strike allowing door to be opened. Free egress from Receiving at all times.

# Hardware Set No. 54

Fach	·Τω	Have:
Lau	110	ııavc.

1 EA	FSIC CORE	23-030 EV29 T	626	SCH
1	RIM OR MORTISE	AS REQUIRED	626	SCH
	CYLINDER			

BALANCE OF HARDWARE BY DOOR

MANUFACTURER

### Hardware Set No. 55

#### Each To Have:

1	EΑ	CONT. HINGE	224HD	628	IVE
1	EΑ	DBL CYL STORE W/DB	L9466HD 17A	626	SCH
2	EΑ	FSIC CORE	23-030 EV29 T	626	SCH
1	EΑ	SURFACE CLOSER	4011 MC TBTRX	689	LCN
1	EΑ	WALL STOP	WS406/407CVX	630	IVE
1	EA	GASKETING	429AA-S	AA	ZER
1	EΑ	DOOR SWEEP	8192AA	AA	ZER
1	EA	THRESHOLD	560A-223	Α	ZER

# Hardware Set No. 56

### Each To Have:

1	EΑ	CONT. HINGE	224HD	628	IVE
1	EΑ	STOREROOM	L9480T 17L	626	SCH
		W/DEADBOLT			
1	EΑ	FSIC CORE	23-030 EV29 T	626	SCH
1	EΑ	SURFACE CLOSER	4011 MC TBTRX	689	LCN
1	EΑ	WALL STOP	WS406/407CVX	630	IVE
1	EΑ	GASKETING	429AA-S	AA	ZER
1	EΑ	DOOR SWEEP	8192AA	AA	ZER
1	EΑ	THRESHOLD	656A-223	Α	ZER

Hardware Set No. 57

CJS Architects Project #1711.00 4/9/2018

Eoch 7	Γο Have				
Each	го паче				
3	EA	HINGE	5BB1 4.5 X 4.5	652	IVE
1	EA	STOREROOM LOCK LESS STRIKE	L9080T LLL 17L	626	SCH
1	EA	FSIC CORE	23-030 EV29 T	626	SCH
1	EA	ELECTRIC STRIKE	6211 FSE	630	VON
1	EA	SURF. AUTO OPERATOR	4631 TBTRX	689	LCN
2	EA	ACTUATOR, WALL MOUNT	8310-856T	630	LCN
1	EA	SURFACE MOUNT BOX	8310-868S	689	LCN
1	EA	KICK PLATE	8400 8" X 1 1/2" LDW B-CS	630	IVE
1	EA	GASKETING	188FSBK PSA	BK	ZER

# Card reader by Owner.

Draw power from auto. operator for electric strike.

Theory of operation: Door always locked. Actuator disabled. Proper credential to reader energizes electric strike and enable actuator. Pressing actuator initiates automatic operation.

#### Hardware Set No. 58

#### Each To Have:

2	EA	CONT. HINGE	224HD	628	IVE
2	EΑ	FIRE EXIT HARDWARE	9927-L-F-LBR-17-499F	626	VON
2	EA	RIM CYLINDER	20-057 ICX	626	SCH
2	EA	FSIC CORE	23-030 EV29 T	626	SCH
2	EA	SURFACE CLOSER	4111 EDA MC TBTRX	689	LCN
2	EA	KICK PLATE	8400 8" X 1" LDW B-CS	630	IVE
2	EA	WALL STOP	WS406/407CVX	630	IVE
2	EA	MEETING STILE	328AA-S	AA	ZER
1	EA	GASKETING	429AA-S	AA	ZER
2	EA	DOOR BOTTOM	360AA	AA	ZER
1	EA	GASKETING	188FSBK PSA	BK	ZER

# Hardware Set No. 59

2	EΑ	CONT. HINGE	224HD	628	IVE
2	EΑ	FIRE EXIT HARDWARE	9927-L-F-LBR-17-499F	626	VON
2	EΑ	RIM CYLINDER	20-057 ICX	626	SCH
2	EΑ	FSIC CORE	23-030 EV29 T	626	SCH
2	EΑ	SURFACE CLOSER	4111 CUSH MC TBTRX	689	LCN
2	EΑ	KICK PLATE	8400 8" X 1" LDW B-CS	630	IVE
2	EΑ	MEETING STILE	8194AA	AA	ZER

1 EA	GASKETING	188FSBK PSA	ВК	ZER			
Hardware Set	t No. 60						
Each To Have	e: HINGE	5BB1 4.5 X 4.5	652	IVE			
1 EA	CLASSROOM LOCK	L9070T 17L	626	SCH			
1 EA 1 EA	FSIC CORE SURFACE CLOSER	23-030 EV29 T 4111 EDA MC TBTRX	626 689	SCH LCN			
1 EA 1 EA	KICK PLATE WALL STOP	8400 8" X 1 1/2" LDW B-CS WS406/407CVX	630 630	IVE IVE			
1 EA	GASKETING	188FSBK PSA	ВК	ZER			
Hardware Set	t No. 61						
Each To Have		00.4115	000	D. (=			
1 EA 1 EA	CONT. HINGE FIRE EXIT HARDWARE	224HD 99-L-F-2-17	628 626	VON			
2 EA 2 EA	RIM CYLINDER FSIC CORE	20-057 ICX 23-030 EV29 T	626 626	SCH			
1 EA 1 EA 1 EA	SURFACE CLOSER KICK PLATE	4111 CUSH MC TBTRX 8400 8" X 1 1/2" LDW B-CS	689 630 BK	LCN IVE			
1 EA	GASKETING	188FSBK PSA	DK	ZER			
Hardware Set No. 62							
Each To Have		EDD4 4 5 V 4 5	050	D/E			
3 EA 1 EA	HINGE CLASSROOM X STOREROOM LOCK LESS STRIKE	5BB1 4.5 X 4.5 L9066T LLL 17L XL12-876	652 626	IVE SCH			
2 EA 1 EA	FSIC CORE ELECTRIC STRIKE	23-030 EV29 T 6211 FSE	626 630	SCH VON			
1 EA	SURFACE CLOSER	4011 MC TBTRX 8400 8" X 1 1/2" LDW B-CS	689 630	LCN IVE			
1 EA	KICK PLATE WALL STOP	WS406/407CVX	630	IVE			
1 EA	GASKETING	188FSBK PSA	BK	ZER			

Card reader and power supply by Owner.

Theory of operation: From Corridor - During open hours, door normally unlocked, locked after

hours.Door can be locked, or unlocked with key. From Main Office, door always locked. Proper credential to reader or remote signal energizes electric strike, allowing door to be opened.

### Hardware Set No. 63

1	EA	CONT. HINGE	224HD	628	IVE
1	EA	FIRE EXIT HARDWARE	99-L-F-17	626	VON
1	EA	RIM CYLINDER	20-057 ICX	626	SCH
1	EA	FSIC CORE	23-030 EV29 T	626	SCH
1	EA	SURFACE CLOSER	4011T BUMP MC TBTRX	689	LCN
1	EA	KICK PLATE	8400 8" X 1 1/2" LDW B-CS	630	IVE
1	EA	WALL STOP	WS406/407CVX	630	IVE
1	EΑ	GASKETING	188FSBK PSA	BK	ZER

#### Hardware Set No. 64

#### Each To Have:

1	EΑ	CONT. HINGE	224HD	628	IVE
1	EΑ	FIRE EXIT HARDWARE	99-EO-F	626	VON
1	EΑ	SURFACE CLOSER	4111 CUSH MC TBTRX	689	LCN
1	EA	KICK PLATE	8400 8" X 1 1/2" LDW B-CS	630	IVE
1	EΑ	GASKETING	188FSBK PSA	BK	ZER

# Hardware Set No. 65

1	EΑ	CONT. HINGE	224HD	628	IVE
1	EA	CONT. HINGE	224HD EPT	628	IVE
1	EΑ	POWER TRANSFER	EPT10	689	VON
1	EA	FIRE RATED	KR9954	689	VON
		REMOVABLE MULLION			
1	EΑ	FIRE EXIT HARDWARE	99-EO-F-499F	626	VON
1	EΑ	FIRE EXIT HARDWARE	99-L-F-E996-17-499F-FS	626	VON
1	EΑ	RIM CYLINDER	20-057 ICX	626	SCH
2	EΑ	FSIC CORE	23-030 EV29 T	626	SCH
1	EA	MORTISE CYLINDER	26-091 ICX	626	SCH
2	EΑ	SURFACE CLOSER	4011T MC TBTRX	689	LCN
2	EΑ	KICK PLATE	8400 8" X 1 1/2" LDW B-CS	630	IVE
2	EA	FIRE/LIFE WALL MAG	SEM7830	689	LCN
1	EΑ	GASKETING	188FSBK PSA	BK	ZER

## Power supply by Owner.

Theory of operation: Doors normally held open by wall magnets. When locking required fro Stair side, electronic trim energized. Lever rigid.

Wall magnets automatically release and lever becomes active upon smoke/fire alarm activation. Free egress from Corridor at all times.

#### Hardware Set No. 66

#### Each To Have:

2	EΑ	CONT. HINGE	224HD	628	IVE
1	EA	FIRE RATED	KR9954	689	VON
		REMOVABLE MULLION			
2	EA	FIRE EXIT HARDWARE	99-L-F-17-499F	626	VON
2	EA	RIM CYLINDER	20-057 ICX	626	SCH
3	EA	FSIC CORE	23-030 EV29 T	626	SCH
1	EA	MORTISE CYLINDER	26-091 ICX	626	SCH
2	EA	SURFACE CLOSER	4011T MC TBTRX	689	LCN
2	EA	KICK PLATE	8400 8" X 1 1/2" LDW B-CS	630	IVE
2	EA	WALL STOP	WS406/407CVX	630	IVE
1	EΑ	GASKETING	188FSBK PSA	BK	ZER

### Hardware Set No. 67

### Each To Have:

1	EΑ	CONT. HINGE	224HD	628	IVE
1	EΑ	FIRE EXIT HARDWARE	99-NL-F	626	VON
1	EΑ	RIM CYLINDER	20-057 ICX	626	SCH
1	EΑ	FSIC CORE	23-030 EV29 T	626	SCH
1	EΑ	SURFACE CLOSER	4111 EDA MC TBTRX	689	LCN
1	EΑ	KICK PLATE	8400 8" X 1 1/2" LDW B-CS	630	IVE
1	EΑ	WALL STOP	WS406/407CVX	630	IVE
1	EΑ	GASKETING	188FSBK PSA	BK	ZER

### Hardware Set No. 68

2	EΑ	CONT. HINGE	224HD	628	IVE
1	EA	FIRE RATED	KR9954	689	VON
		REMOVABLE MULLION			
1	FA	FIRE EXIT HARDWARE	99-FO-F-499F	626	VON

CJS Architects Project #1711.00 4/9/2018

1	EΑ	FIRE EXIT HARDWARE	99-L-F-17-499F	626	VON
1	EΑ	RIM CYLINDER	20-057 ICX	626	SCH
2	EA	FSIC CORE	23-030 EV29 T	626	SCH
1	EΑ	MORTISE CYLINDER	26-091 ICX	626	SCH
2	EA	SURFACE CLOSER	4111 EDA MC TBTRX	689	LCN
2	EΑ	KICK PLATE	8400 8" X 1 1/2" LDW B-CS	630	IVE
2	EΑ	FIRE/LIFE WALL MAG	SEM7830	689	LCN
1	EΑ	GASKETING	188FSBK PSA	BK	ZER

Door normally held open by wall magnets.

DWT SED # 26-16-00-01-7-999-020

Automatic release upon smoke/fire alarm activation.

#### Hardware Set No. 69

### Each To Have:

2	EΑ	CONT. HINGE	224HD	628	IVE
1	EΑ	FIRE RATED	KR9954	689	VON
		REMOVABLE MULLION			
1	EA	FIRE EXIT HARDWARE	99-EO-F-499F	626	VON
1	EA	FIRE EXIT HARDWARE	99-L-F-17-499F	626	VON
1	EA	RIM CYLINDER	20-057 ICX	626	SCH
2	EA	FSIC CORE	23-030 EV29 T	626	SCH
1	EA	MORTISE CYLINDER	26-091 ICX	626	SCH
2	EA	SURFACE CLOSER	4111 EDA MC TBTRX	689	LCN
2	EA	KICK PLATE	8400 8" X 1 1/2" LDW B-CS	630	IVE
2	EA	FIRE/LIFE WALL MAG	SEM7850	689	LCN
1	EΑ	GASKETING	188FSBK PSA	BK	ZER

Door normally held open by wall magnets.

Automatic release upon smoke/fire alarm activation.

### Hardware Set No. 70

1	EΑ	CONT. HINGE	224HD	628	IVE
1	EΑ	FIRE EXIT HARDWARE	99-L-F-17	626	VON
1	EΑ	RIM CYLINDER	20-057 ICX	626	SCH
1	EΑ	FSIC CORE	23-030 EV29 T	626	SCH
1	EΑ	SURFACE CLOSER	4111 EDA MC TBTRX	689	LCN
1	EΑ	KICK PLATE	8400 8" X 1 1/2" LDW B-CS	630	IVE
1	EΑ	FIRE/LIFE WALL MAG	SEM7830	689	LCN
1	EΑ	GASKETING	188FSBK PSA	BK	ZER

Door normally held open by wall magnets. Automatic release upon smoke/fire alarm activation.

### Hardware Set No. 72

Each <sup>-</sup>	To Have	<b>:</b> :			
2	EΑ	CONT. HINGE	224HD	628	IVE
2	EA	PANIC HARDWARE	CD-9927-L-06	626	VON
2	EA	RIM CYLINDER	20-057 ICX	626	SCH
4	EA	FSIC CORE	23-030 EV29 T	626	SCH
2	EA	MORTISE CYLINDER	26-091 ICX XQ11-948	626	SCH
2	EA	SURFACE CLOSER	4111 EDA MC TBTRX	689	LCN
2	EA	KICK PLATE	8400 8" X 1" LDW B-CS	630	IVE
2	EΑ	WALL STOP	WS406/407CVX	630	IVE
2	EΑ	MEETING STILE	328AA-S	AA	ZER
1	EΑ	GASKETING	429AA-S	AA	ZER
2	EΑ	DOOR BOTTOM	360AA	AA	ZER
1	EΑ	GASKETING	188FSBK PSA	BK	ZER

### Hardware Set No. 73

# Each To Have:

3	EΑ	HINGE	5BB1 4.5 X 4.5	652	IVE
1	EA	CLASSROOM LOCK	L9070T 17L	626	SCH
1	EA	FSIC CORE	23-030 EV29 T	626	SCH
1	EA	SURFACE CLOSER	4011 MC TBTRX	689	LCN
1	EA	KICK PLATE	8400 8" X 1 1/2" LDW B-CS	630	IVE
1	EA	WALL STOP/HOLDER	FS495	626	IVE
1	EA	WALL STOP	WS406/407CVX	630	IVE
3	EΑ	SILENCER	SR64	GRY	IVE

### Hardware Set No. 74

3	EΑ	HINGE	5BB1 4.5 X 4.5	652	IVE
1	EΑ	STOREROOM LOCK	L9080T 17L LLL	626	SCH
		LESS INSIDE TRIM			
1	EΑ	FSIC CORE	23-030 EV29 T	626	SCH
1	EΑ	SURFACE CLOSER	4011 MC TBTRX	689	LCN
1	EΑ	KICK PLATE	8400 8" X 1 1/2" LDW B-CS	630	IVE
1	EΑ	GASKETING	188FSBK PSA	BK	ZER

Hardware Set No. 75

### Each To Have:

2	EΑ	CONT. HINGE	224HD	628	IVE
2	EΑ	FIRE EXIT HARDWARE	9927-EO-F-LBR-499F	626	VON
1	EΑ	FIRE/LIFE HOLDER	4040SEH	689	LCN
1	EA	SURFACE CLOSER	4111 CUSH MC TBTRX	689	LCN
1	EΑ	SURFACE CLOSER	4111 EDA MC TBTRX	689	LCN
2	EΑ	KICK PLATE	8400 8" X 1" LDW B-CS	630	IVE
1	EΑ	FIRE/LIFE WALL MAG	SEM7830	689	LCN
1	EΑ	GASKETING	188FSBK PSA	BK	ZER

Doors held open by wall magnet at northern leaf and electronic holder on southern leaf. Locate wall magnet to Insure contact with door armatures with modification.

Automatic release upon smoke/fire alarm activation.

**END OF SECTION** 

	DOOR SCHEDULE  DOOR FRAME														
		T			DC	OOR					FRA	AME			Ι
DOOR NO.	ROOM	WIDTH	HEIGHT	SINGLE/PAIR	TYPE	MAT.	FINISH	GLASS	FIRE RATING	TYPE	MAT.	FINISH	GLASS	HARDWARE SET	COMMENTS
BOOK NO.	Neom	***************************************	11210111	,	1112	140 (11		R ROOM		1112		1111311	02/100	<u> </u>	OCH MENTS
SF17	CRAWL SPACE	VIF	VIF	SINGLE	FL	НМ	1		90	ETR	ETR	1		30	
					· <u>-</u>		BASEMEN	IT (536.20')				_			
3	COMPUTER CLASSROOM	3' - 0"	7' - 0"	SINGLE	V	WD	2	С	20	2	НМ	1		1	
4	ART ROOM	5' - 0"	7' - 0"	UN PAIR	UV	WD	2	С	20	2	НМ	1		2	2' INACTIVE LEAF
4A	STORAGE	5' - 0"	7' - 0"	UN PAIR	UF	WD	2		90	2	НМ	1		3	2' INACTIVE LEAF
6	FACULTTY TOILET	3' - 0"	7' - 0"	SINGLE	FL	WD	2		20	2	НМ	1		27	PROVIDE 1" DOOR UNDERCUT
7	JC	3' - 0"	7' - 0"	SINGLE	FL	WD	2		20	2	НМ	1		27	PROVIDE 1" DOOR UNDERCUT
8	CAFETERIA	6' - 0"	7' - 0"	PAIR	DG	НМ	1	С	20	4	НМ	1	В	6	
8A	BOY'S TOILET	3' - 0"	7' - 0"	SINGLE	FL	НМ	1		20	2	НМ	1		5	
8B	GIRLS TOILET	3' - 0"	7' - 0"	SINGLE	FL	HM	1		20	2	НМ	1		4	PROVIDE 1" DOOR UNDERCUT
11.2	ELECTRICAL EQUIPMENT ROOM	3' - 4"	6' - 8"	SINGLE	FL	HM	1		90	2	HM	1		10	
11.3	BOILER RM.	6' - 4"	7' - 0"	PAIR	DF	HM	1		90	2	HM	1		11	
11A.2	ELECTRICAL EQUIPMENT RM.	3' - 0"	7' - 0"	SINGLE	FL	НМ	1		90	2	HM	1		13	
12	KITCHEN SERVERY (JC)	3' - 0"	7' - 0"	SINGLE	FL	HM	1			1	HM	1		29	
12.1	KITCHEN SERVERY	3' - 0"	7' - 0"	SINGLE	V	HM	1	С	90	2	HM	1		7	
12.2	KITCHEN SERVERY	3' - 0"	7' - 0"	SINGLE	V	HM	1	С	90	2	HM	1		7	
12.3	KITCHEN SERVERY	3' - 0"	7' - 0"	SINGLE	V	HM	1	С	90	2	HM	1		7	
12.4	KITCHEN SERVERY	3' - 0"	7' - 0"	SINGLE	V	HM	1	С	90	2	HM	1		7	
12A	OFFICE (KITCHEN)	3' - 0"	7' - 0"	SINGLE	V	HM	1	В		1	HM	1		44	
12B	WOMEN'S (KITCHEN)	3' - 0"	7' - 0"	SINGLE	FL	HM	1			1	HM	1		14	PROVIDE 1" DOOR UNDERCUT
12C	LOCKER RM. (KITCHEN)	3' - 0"	7' - 0"	SINGLE	FL	HM	1			1	HM	1		16	
12D	MENS (KITCHEN)	3' - 0"	7' - 0"	SINGLE	FL	HM	1			1	HM	1		14	PROVIDE 1" DOOR UNDERCUT
13	KITCHEN STORAGE RM.	3' - 0"	7' - 0"	SINGLE	FL	HM	1		90	2	HM	1		17	
14	KITCHEN STORAGE RM.	6' - 4"	7' - 0"	PAIR	DF	HM	1		90	2	HM	1		18	
15	ELEV. EQUIPMENT RM	3' - 0"	7' - 0"	SINGLE	FL	HM	1		60	2	HM	1		19	
15A	STORAGE ROOM	6' - 4"	7' - 0"	PAIR	DF	HM	1		90	2	HM	1		20	
16	STORAGE	6' - 4"	7' - 0"	PAIR	DF	HM	1		90	2	НМ	1		21	
C-B.1	CORRIDOR B	6' - 4"	7' - 0"	PAIR	DV	HM	1	В		2	HM	1		49	
C-B.2	CORRIDOR B	6' - 4"	7' - 0"	PAIR	DF	HM	1		90	2	HM	1		12	
C-B.3	KITCHEN SERVERY	4' - 4"	7' - 0"	UN PAIR	UF	HM	1		90	2	HM	1		50	1'-4" INACTIVE LEAF
C-D.1	CORRIDOR D	VIF	VIF	SINGLE	FL	HM	1		90	2	HM	1		5	
C-D.2	CAFETERIA	3'-4"	6'-8"	SINGLE	FL	HM	1			2	НМ	1		8	
SF1	VAULT STORAGE	VIF	VIF	SINGLE	FL	WD	1		90	ETR	ETR	1		5	
SF1B	MECHANICAL	VIF	VIF	SINGLE	FL	HM	1		90	ETR	ETR	1		19	
SF2	ISS	VIF	VIF	SINGLE	V	WD	2	С	20	ETR	ETR	1		35	
SF5	BOOK STORAGE	VIF	VIF	SINGLE	FL	WD	2		90	ETR	ETR	1		28	
SF9	OFFICE	VIF	VIF	SINGLE	V	HM	2	С	45	ETR	ETR	1		25	
SF10	STORAGE	VIF	VIF	SINGLE	FL	HM	2		90	ETR	ETR	1		28	
SF11.1	BOILER RM.	VIF	VIF	SINGLE	FL	HM	2		90	ETR	ETR	1		37	
ST-2A	STAIR 2	6' - 0"	7' - 0"	PAIR	DG	HM	1	С	60	4	HM	1	С	68	
ST-3A	STAIR 3	6' - 0"	7' - 0"	PAIR	FV	HM	1	С	90	2	HM	1		66	

	DOOR SCHEDULE														
		<u> </u>					JOOK 30	חבטטנ	.C		FD.	A A 4 5		T	
					DC	OOR					FKA	AME		1	
														HARDWARE	
DOOR NO.	ROOM	WIDTH		SINGLE/PAIR	TYPE	MAT.	FINISH	GLASS	FIRE RATING	TYPE	MAT.	FINISH	GLASS		COMMENTS
ST-4A	STAIR 4	3' - 0"	7' - 0"	SINGLE	DG	HM	1	С	60	2	HM	1		63	
ST-7A	STAIR 7	3' - 0"	7' - 0"	SINGLE	DG	HM	1	С	60	2	НМ	1		70	
C1.2	CRAWL SPACE	5' - 8"	2' - 6"	PAIR	FL	HM	1		90	2	HM	1		21	OVERHEAD DOOD W/ CVI LOCK
EX-129	OUTDOOR STORAGE	10' - 0"	10' - 0"	PAIR	OHS		1			MAN.	MAN.	1		× 1	OVERHEAD DOOR W/ CYL. LOCK
EX-129.1	OUTDOOR STORAGE	3' - 0"	7' - 0"	SINGLE	FL	HM	1			2	HM	1			EXTERIOR DOOR
EV 4D	ENTRANCE DOOR (CTAIR A)	CL OII	7' - 0"	DAID		A1 /EDD				2	A1	4			ES/CR AUTO ADA OPENER, PROVIDE SECURITY SCREEN OVER VISON PANEL(S) (EXTERIOR
EX4B ST-4B.1	ENTRANCE DOOR (STAIR 4)	6' - 0" 3' - 0"	7 - 0"	PAIR	HG V	AL/FRP WD	MAN.	А		3	AL HM	1	А	52 67	SIDE)
31-4D.1	TO BASEMENT (STAIR 4)	3 - 0	7 - 0	SINGLE	V		ODIAN MEZZA	NINE LEVEL	 561 90		ПІЛ	1		0/	
108A.2	LOCKER ROOM	3' - 0"	7' - 0"	SINGLE	FL	HM	ODIAN WEZZA		90	2	НМ	1		30	
108A.2	CUSTODIAN'S OFFICE	3' - 0"	7'-0"	SINGLE	V	HM	1		90	2	HM	1		25	
SF108D	TOILET	VIF	VIF	SINGLE	FL	HM	1			ETR	ETR	1			PROVIDE 1" DOOR UNDERCUT
31 1000	TOILET	VII	VII	SIIVGEE		THVI	=	)R- (548.30')		LIIX	LIIK	<u> </u>		73	
ST7B	STAIR 7	3' - 0"	7' - 0"	SINGLE	V	WD	2	C	60	1	НМ	1		64	Τ
EX116.1	RECEIVING	3' - 0"	7' - 0"	SINGLE	V	НМ	1	В		1	HM	1	А	53	EXTERIOR DOOR ES/CR
EX116.2	RECEIVING	8' - 8"	8'-9 5/16"	ОН		MAN.	1			MAN.	НМ	1			OVERHEAD COILING DOOR
100	MAIN LOBBY	VIF	VIF	PAIR	DG	НМ	1	С	45	VIF	HM	1	С	39	ES/CR VERIFY EXISTING R.O.
103.1	1-3 GRADE CLASSROOM/CL	5' - 0"	6' - 0"	PAIR	CL	WD	2			7	WD	2			(2) 2'-6" PIVOT DOOR PANELS WITH WOOD TRIM
103.2	1-3 GRADE CLASSROOM/CL	5' - 0"	6' - 0"	PAIR	DF	WD	2			7	WD	2			(2) 2'-6" PIVOT DOOR PANELS WITH WOOD TRIM
103.3	1-3 GRADE CLASSROOM/CL	5' - 0"	6' - 0"	PAIR	DF	WD	2			7	WD	2		22	(2) 2'-6" PIVOT DOOR PANELS WITH WOOD TRIM
104.1	1-3 GRADE CLASSROOM/CL	5' - 0"	6' - 0"	PAIR	DF	WD	2			7	WD	2		22	(2) 2'-6" PIVOT DOOR PANELS WITH WOOD TRIM
104.2	1-3 GRADE CLASSROOM/CL	5' - 0"	6' - 0"	PAIR	DF	WD	2			7	WD	2		22	(2) 2'-6" PIVOT DOOR PANELS WITH WOOD TRIM
104.3	1-3 GRADE CLASSROOM/CL	5' - 0"	6' - 0"	PAIR	DF	WD	2			7	WD	2		22	(2) 2'-6" PIVOT DOOR PANELS WITH WOOD TRIM
104.4	1-3 GRADE CLASSROOM/CL	2' - 0"	6' - 0"	SINGLE	FL	WD	2			7	WD	2		23	
										_					(1) 3'-0" DOOR PANEL & (1) 1'-6" DOOR PANEL, PROVIDE IMPACT SCREENS AT VISION PANEL(S), PROVIDE ACOUSTICS SOUND
105.5	GYM VESTIBULE	4' - 6"	7' - 0"	UN PAIR	UV	WD	2	С	90	2	HM	1			SEAL(S), 1'-6" INACTIVE LEAF
105B	PE OFFICE	3' - 0"	7' - 0"	SINGLE	V	WD	2	С	90	2	HM	1		25	
105D.2	GYM/AUD STORAGE	3' - 0"	7' - 0"	SINGLE	FL	HM	1		45	1	HM	1		26	
106	BOY'S (TOILET)	3' - 0"	7' - 0"	SINGLE	FL	WD	2		45	2	HM	1			PROVIDE 1" DOOR UNDERCUT
106A	CL.	2' - 6"	6' - 8"	SINGLE	FL	WD	2		45	2	НМ	1		28	(2) 2! 6" DIVOT DOOD DANIELG WITH WOOD
107.1	SPEC. ED (12:1:1)/CL	5' - 0"	6' - 0"	PAIR	CL	WD	2			7	WD	2		22	(2) 2'-6" PIVOT DOOR PANELS WITH WOOD TRIM
107.2	SPEC. ED (12:1:1)/CL	5' - 0"	6' - 0"	PAIR	CL	WD	2			7	WD	2			(2) 2'-6" PIVOT DOOR PANELS WITH WOOD TRIM

	DOOR SCHEDULE														
					DC	OOR					FRA	AME			
DOOR NO.	ROOM	WIDTH	HEIGHT	SINGLE/PAIR	TYPE	MAT.	FINISH	GLASS	FIRE RATING	TYPE	MAT.	FINISH	GLASS	HARDWARE SET	COMMENTS
													<u> </u>	<u> </u>	(2) 2'-6" PIVOT DOOR PANELS WITH WOOD
107.3	SPEC. ED (12:1:1)/CL	5' - 0"	6' - 0"	PAIR	CL	WD	2			7	WD	2		22	TRIM
107.4	SPEC. ED (12:1:1)/CL	2' - 0"	6' - 0"	SINGLE	FL	WD	2			7	WD	2		29	
108	BOILER RM.	3' - 0"	7' - 0"	SINGLE	V	HM	2	С	45	2	HM	2		28	
110A	SPEC. ED (15:1:1)/TOILET	3' - 0"	7' - 0"	SINGLE	FL	WD	2			2	HM	1		31	PROVIDE 1" DOOR UNDERCUT
111	MUSIC CLASSROOM	3' - 0"	7' - 0"	SINGLE	V	WD	2	С	45	3	НМ	1	С		PROVIDE ACOUSTICS SOUND SEAL(S), W16 TRANSOM
112	INSTRUMENTAL MUSIC/ DRAMA CLASSROOM	4' - 4"	7' - 0"	UN PAIR	UV	WD	2	С	45	3	НМ	1	С		(1) 3'-0" DOOR PANEL & (1) 1'-4" DOOR PANEL, PROVIDE ACOUSTICS SOUND SEAL(S), W17 TRANSOM, 1'-4" INACTIVE LEAF
113.1	SPEECH	3' - 0"	7' - 0"	SINGLE	V	WD	2	С	20	2	HM	1		35	PROVIDE ACOUSTICS SOUND SEAL(S)
113.2	SPEECH	3' - 0"	7' - 0"	SINGLE	V	WD	2	В		1	HM	1		31	PROVIDE ACOUSTICS SOUND SEAL(S)
114.1	SPEECH	3' - 0"	7' - 0"	SINGLE	V	WD	2	В		1	нм	1			PROVIDE ACOUSTICS SOUND SEAL(S), W16 TRANSOM, LABLE DOOR LEAF WITH CODE REQIRED "EMERGENCY EGRESS DOOR" ROOM SIDE.
															LABLE DOOR LEAF WITH CODE REQIRED
114.2	READING TEACHER	3' - 0"	7' - 0"	SINGLE	V	WD	2	В		1	HM	1			"EMERGENCY EGRESS DOOR" ROOM SIDE.
															LABLE DOOR LEAF WITH CODE REQIRED
114.3	PRIMARY PROJECT	3' - 0"	7' - 0"	SINGLE	V	WD	2	С	90	2	HM	1			"EMERGENCY EGRESS DOOR" ROOM SIDE.
115	JC	2' - 4"	7' - 0"	SINGLE	FL	WD	2	С	45	2	HM	1		37	50/00
116	RECEIVING	6' - 4"	7' - 0"	PAIR	DV	WD	2	С	45	2	HM	1			ES/CR
117	KINDERGARTEN	3' - 0"	7' - 0"	SINGLE	V	WD	2	C	20	3	HM	1	В		W16 TRANSOM
117A 118	KINDERGARTEN (TOILET) PROPS STORAGE	3' - 0" 6' - 0"	7' - 0" 7' - 0"	SINGLE PAIR	FL DF	WD WD	2		 45	2	HM HM	1		31 40	PROVIDE 1" DOOR UNDERCUT
119	WOMENS TOILET	3' - 0"	7'-0"	SINGLE	FL	WD	2		45	2	HM	1		40	PROVIDE 1" DOOR UNDERCUT
120.1	NURSE SUITE	3' - 0"	7' - 0"	SINGLE	V	WD	2	С	90	2	HM	1		41	PROVIDE 1 BOOK GIVELICOT
120.2			7' - 0"	SINGLE	=	WD	2	C	45	3	HM	1	C		W16 TRANSOM
120A	NURSE SUITE TOILET	3' - 0"	7' - 0"	SINGLE	FL	WD	2			1	HM	1			PROVIDE 1" DOOR UNDERCUT
120A	NURSE SUITE OFFICE	3' - 0"	7' - 0"	SINGLE	V	WD	2	В		2	HM	1		44	. NOTISE I BOOK ONSERROI
121	KINDERGARTEN	3' - 0"	7' - 0"	SINGLE	V	WD	2	С	20	2	HM	1	В	1	
121A	KINDERGARTEN (TOILET)	3' - 0"	7' - 0"	SINGLE	FL	WD	2			2	HM	1			PROVIDE 1" DOOR UNDERCUT
122	PRE-K	3' - 0"	7' - 0"	SINGLE	V	WD	2	С	20	3	HM	1	В		W16 TRANSOM
122A	PRE-K (TOILET)	3' - 0"	7' - 0"	SINGLE	FL	WD	2			2	НМ	1			PROVIDE 1" DOOR UNDERCUT
123	SECURITY OFFICE	3' - 0"	7' - 0"	SINGLE	V	WD	2	С	90	2	НМ	1		45	
124	PRE-K	3' - 0"	7' - 0"	SINGLE	V	WD	2	С	90	3	HM	3	FILL	1	W16 TRANSOM
124A	PRE-K (TOILET)	3' - 0"	7' - 0"	SINGLE	FL	WD	2			2	HM	1		31	PROVIDE 1" DOOR UNDERCUT
125	MEN'S TOILET	3' - 0"	7' - 0"	SINGLE	FL	WD	2		45	1	HM	1		4	PROVIDE 1" DOOR UNDERCUT
126	ESOL	3' - 0"	7' - 0"	SINGLE	V	WD	2	С	45	3	HM	1	С	1	W16 TRANSOM
127	GIRLS TOILET	3' - 0"	7' - 0"	SINGLE	FL	WD	2		45	2	HM	1		27	PROVIDE 1" DOOR UNDERCUT
127A	JAN. CL	2' - 6"	6' - 8"	SINGLE	FL	WD	2		45	2	HM	1		5	

							OOR SO	CHEDUL	E						
		T			DC	OOR			_		FR.	AME		I	
DOOR NO.	ROOM	WIDTH	HEIGHT	SINGLE/PAIR	TYPE	MAT.	FINISH	GLASS	FIRE RATING	TYPE	MAT.	FINISH	GLASS	HARDWARE SET	COMMENTS
															CARD READER ACCESS, REFER TO ELECTRICAL
128	DATA CLOSET	3' - 0"	7' - 0"	SINGLE	FL	WD	2		90	2	НМ	1		46	DRAWINGS
130.1	MAIN OFFICE SUITE	VIF	VIF	SINGLE	FG	HM	1	С	20	VIF	HM	1	В	47	
130.2	MAIN OFFICE SUITE	VIF	VIF	SINGLE	FG	HM	1	С	45	VIF	HM	1	С	62	ES/CR, VERIFY EXISTING R.O.
COR-C.1	CORRIDOR C	6' - 0"	7' - 0"	PAIR	DG	HM	1	С	S	4	HM	1	С	51	
COR-C.2	CORRIDOR F	6' - 0"	7' - 0"	PAIR	DG	MH	1	С	S	4	HM	1	С	51	
COR-D	CORRIDOR D	6' - 0"	7' - 0"	PAIR	DV	HM	1	С	90	1	HM	1		51	
COR-E	CORRIDOR F	6' - 0"	7' - 0"	PAIR	DV	HM	1	С	90	1	HM	1	 ETD	51	CIDE LIGHT AND TRANSONATO REMAIN
SF101 SF102	PARENT/ PTSA  1-3 GRADE CLASSROOM	VIF	VIF VIF	SINGLE SINGLE	V	WD WD	2	C	45 20	ETR ETR	ETR ETR	1	ETR B		SIDE LIGHT AND TRANSOM TO REMAIN W16 TRANSOM
SF102 SF103	1-3 GRADE CLASSROOM  1-3 GRADE CLASSROOM	VIF	VIF	SINGLE	V	WD	2	C	20	ETR	ETR	1	В		W16 TRANSOM W16 TRANSOM
SF103	1-3 GRADE CLASSROOM  1-3 GRADE CLASSROOM	VIF	VIF	SINGLE	V	WD	2	С	20	ETR	ETR	1	В		W16 TRANSOM
SF105.1	GYMATORIUM	VIF	VIF	PAIR	DV	WD	2	С	45	ETR	ETR	1			NEW DOOR IN EXISTING FRAME, SIZE TO BE VERIFIED, PROVIDE ACOUSTIC SOUND SEAL(S), PROVIDE IMPACT SCREENS ON VISION PANEL(S)
SF105.2	GYMATORIUM	VIF	VIF	PAIR	UV	WD	2	С	45	ETR	ETR	1			NEW DOOR IN EXISTING FRAME, SIZE TO BE VERIFIED, SMALLER PANEL TO BE FIXED, PROVIDE ACOUSTICS SOUND SEAL(S), PROVIDE IMPACT SCREENS ON VISION PANEL(S)
SF105.3	GYMATORIUM	VIF	VIF	PAIR	DV	WD	2	С	45	ETR	ETR	1		58	NEW DOOR IN EXISTING FRAME, SIZE TO BE VERIFIED, PROVIDE ACOUSTIC SOUND SEAL(S), PROVIDE IMPACT SCREENS ON VISION PANEL(S)
SF105.4 SF105C	GYM VESTIBULE STAGE	VIF VIF	VIF VIF	PAIR SINGLE	DV FL	WD WD	2	B 	 60	ETR ETR	ETR ETR	1			NEW DOOR IN EXISTING FRAME, SIZE TO BE VERIFIED, PROVIDE ACOUSTIC SOUND SEAL(S), PROVIDE IMPACT SCREENS ON VISION PANEL(S)
SF105D.1	GYM VESTIBULE	VIF	VIF	PAIR	DV	WD	2	С	45	ETR	ETR	1		59	
SF107	SPECIAL ED	VIF	VIF	SINGLE	V	WD	2	С	20	ETR	ETR	1	В	34	W16 TRANSOM
SF108A.1	BOILER RM.	VIF	VIF	SINGLE	FL	НМ	1		90	ETR	ETR	1		16	
SF109 SF110	READING TEACHER  SPEC. ED (15:1:1)	VIF	VIF VIF	SINGLE SINGLE	V	WD WD	2	C C	20	ETR ETR	ETR ETR	1	B B	1	LABLE DOOR LEAF WITH CODE REQIRED "EMERGENCY EGRESS DOOR" ROOM SIDE. W16 TRANSOM
SF129	LIBRARY	VIF	VIF	SINGLE	V	WD	2	С	20	ETR	ETR	1	В		W16 TRANSOM
SFST6B.1	LIBRARY	VIF	VIF	SINGLE	V	WD	2	С	60	ETR	ETR	1	С	63	
ST-1B	STAIR 1	6' - 0"	7' - 0"	PAIR	DG	НМ	1	С	60	4	HM	1	С	69	
ST-2B	STAIR 2	6' - 0"	7' - 0"	PAIR	DG	НМ	1	С	60	4	НМ	1	С	68	
ST-3B	STAIR 3	6' - 0"	7' - 0"	PAIR	DG	НМ	1	С	60	4	HM	1	С	68	
ST-4B.2	STAIR 4	6' - 0"	7' - 0"	PAIR	DG	НМ	1	С	60	3	HM	1	С	69	W16 TRANSOM
ST-4B.3	STAIR 4	3' - 0"	7' - 0"	SINGLE	V	НМ	1	В		2	HM	1		70	

	DOOR SCHEDULE  DOOR FRAME														
Т		l			D(	OOR					FRA	AME		T	
DOOR NO.	ROOM	WIDTH	HEIGHT	SINGLE/PAIR	TYPE	MAT.	FINISH	GLASS	FIRE RATING	TYPE	MAT.	FINISH	GLASS	HARDWARE SET	COMMENTS
		_					SECOND FLO	OOR- (561.88')							-
9C.1	STAIR 9	4' - 8"	7' - 0"	UN PAIR	FL	WD	2		45	1	НМ	1		11	(1) 3'-0" DOOR PANEL & (1) 1'-8" DOOR PANEL, 1'-8" INACTIVE LEAF
201.1	1-3 GRADE CLASSROOM/ CL	5' - 0"	6' - 0"	PAIR	CL	WD	2			7	WD	2		22	(2) 2'-6" PIVOT DOOR PANELS
201.2	1-3 GRADE CLASSROOM/ CL	5' - 0"	6' - 0"	PAIR	CL	WD	2			7	WD	2		22	(2) 2'-6" PIVOT DOOR PANELS
201.3	1-3 GRADE CLASSROOM/ CL	5' - 0"	6' - 0"	PAIR	CL	WD	2			7	WD	2		22	(2) 2'-6" PIVOT DOOR PANELS
202.1	1-3 GRADE CLASSROOM/ CL	5' - 0"	6' - 0"	PAIR	CL	WD	2			7	WD	2		22	(2) 2'-6" PIVOT DOOR PANELS
202.2	1-3 GRADE CLASSROOM/ CL	5' - 0"	6' - 0"	PAIR	CL	WD	2			7	WD	2		22	(2) 2'-6" PIVOT DOOR PANELS
202.3	1-3 GRADE CLASSROOM/ CL	5' - 0"	6' - 0"	PAIR	CL	WD	2			7	WD	2		22	(2) 2'-6" PIVOT DOOR PANELS
203.1	1-3 GRADE CLASSROOM/ CL	5' - 0"	6' - 0"	PAIR	CL	WD	2			7	WD	2		22	(2) 2'-6" PIVOT DOOR PANELS
203.2	1-3 GRADE CLASSROOM/ CL	5' - 0"	6' - 0"	PAIR	CL	WD	2			7	WD	2		22	(2) 2'-6" PIVOT DOOR PANELS
203.3	1-3 GRADE CLASSROOM/ CL	5' - 0"	6' - 0"	PAIR	CL	WD	2			7	WD	2		22	(2) 2'-6" PIVOT DOOR PANELS
203.4	1-3 GRADE CLASSROOM/ CL	2'-0"	6'-0"	SINGLE	FL	WD	2			7	WD	2		23	
204	GIRLS TOILET	3' - 0"	7' - 0"	SINGLE	FL	WD	2		45	2	HM	1		27	PROVIDE 1" DOOR UNDERCUT
204A	CL.	2' - 4"	7' - 0"	SINGLE	FL	WD	2		45	2	HM	1		28	
206.1	RESOURCE ROOM/ CL	5' - 0"	6' - 0"	PAIR	CL	WD	2			7	WD	1		22	(2) 2'-6" PIVOT DOOR PANELS
206.2	RESOURCE ROOM	5' - 0"	6' - 0"	PAIR	CL	WD	2			7	WD	1		22	(2) 2'-6" PIVOT DOOR PANELS
206.3	RESOURCE ROOM	5' - 0"	6' - 0"	PAIR	CL	WD	2			7	WD	1		22	(2) 2'-6" PIVOT DOOR PANELS
206.4	RESOURCE ROOM/ CL	2'-0"	6'-0"	SINGLE	FL	WD	2			7	WD	1		23	
207	SP. ED TOILET/ LAUNDRY AND SHOWER	3' - 0"	7' - 0"	SINGLE	FL	WD	2		45	1	HM	12	-	4	PROVIDE 1" DOOR UNDERCUT
209A	WOMEN'S TOILET	3' - 0"	7' - 0"	SINGLE	FL	WD	2		45	1	НМ	1		73	PROVIDE 1" DOOR UNDERCUT, DOOR IS ADA DOOR OPERATED
SF209	WOMEN'S TOILET	VIF	VIF	SINGLE	FL	WD	2		45	ETR	ETR	1		57	
210A	SPEC. ED (12:1:1)/ TOILET	3' - 0"	7' - 0"	SINGLE	FL	WD	2			2	HM	1		31	PROVIDE 1" DOOR UNDERCUT
211.1	OT/PT	3' - 0"	7' - 0"	SINGLE	٧	WD	2	С	90	2	HM	1		34	
211.2	OT/PT/ CL	5' - 0"	6' - 0"	PAIR	CL	WD	2			7	HM	1		22	(2) 2'-6" PIVOT DOOR PANELS
211.3	OT/PT/ CL	5' - 0"	6' - 0"	PAIR	CL	WD	2			7	HM	1		22	(2) 2'-6" PIVOT DOOR PANELS
211.4	OT/PT/ CL	5' - 0"	6' - 0"	PAIR	CL	WD	2			7	HM	1		22	(2) 2'-6" PIVOT DOOR PANELS
212	4-6 GRADE CLASSROOM	3' - 0"	7' - 0"	SINGLE	V	WD	2	С	90	2	HM	1		1	W16 TRANSOM
213	4-6 GRADE CLASSROOM	3' - 0"	7' - 0"	SINGLE	V	WD	2	С	90	2	HM	1		1	W16 TRANSOM
214	JC	2' - 6"	7' - 0"	SINGLE	FL	WD	2		45	2	HM	1		37	
215	SPEECH	3' - 0"	7' - 0"	SINGLE	V	WD	2	С	45	2	HM	1		25	PROVIDE ACOUSTIC SOUND SEAL(S)
216	4-6 GRADE CLASSROOM	3' - 0"	7' - 0"	SINGLE	V	WD	2	С	20	3	HM	1	В	1	W16 TRANSOM
217	4-6 GRADE FLEX/MAKER CLASSROOM	3' - 0"	7' - 0"	SINGLE	V	WD	2	С	20	3	HM	1	В	1	W16 TRANSOM
218	SPEECH	3' - 0"	7' - 0"	SINGLE	V	WD	2	С	45	2	НМ	1		45	PROVIDE ACOUSTIC SOUND SEAL(S)
219	ESOL OFFICE	3' - 0"	7' - 0"	SINGLE	V	WD	2	С	90	2	HM	1		25	
220	ESOL OFFICE	3' - 0"	7' - 0"	SINGLE	٧	WD	2	С	90	2	HM	1		25	
221	4-6 GRADE FLEX/MAKER CLASSROOM	3' - 0"	7' - 0"	SINGLE	V	WD	2	С	20	3	HM	1	В	1	W16 TRANSOM
222	4-6 GRADE CLASSROOM	3' - 0"	7' - 0"	SINGLE	V	WD	2	С	20	3	HM	1	В	1	W16 TRANSOM
223	SOCIAL WORKER OFFICE	3' - 0"	7' - 0"	SINGLE	V	WD	2	С	20	2	HM	1		25	
224.1	SPEC. ED (8:1:1)	5' - 0"	6' - 0"	PAIR	DF	WD	2			7	WD	1		22	(2) 2'-6" PIVOT DOOR PANELS
224.2	SPEC. ED (8:1:1)	5' - 0"	6' - 0"	PAIR	DF	WD	2			7	WD	1		22	(2) 2'-6" PIVOT DOOR PANELS

	DOOR SCHEDULE  DOOR FRAME														
					DO	OOR					FR	AME	•		
DOOR NO.	ROOM	WIDTH	HEIGHT	SINGLE/PAIR	TYPE	MAT.	FINISH	GLASS	FIRE RATING	TYPE	MAT.	FINISH	GLASS	HARDWARE SET	COMMENTS
224.3	SPEC. ED (8:1:1)	5' - 0"	6' - 0"	PAIR	DF	WD	2			7	WD	1		22	(2) 2'-6" PIVOT DOOR PANELS
225	PSYCH. OFFICE	3' - 0"	7' - 0"	SINGLE	V	WD	2	С	20	2	НМ	1		45	
226.1	SPEC. ED (8:1:1)/ CL	2' - 0"	6' - 0"	SINGLE	FL	WD	2			2	НМ	1		23	
226A	SPEC. ED (8:1:1) TOILET	3' - 0"	7' - 0"	SINGLE	FL	WD	2			2	НМ	1		31	PROVIDE 1" DOOR UNDERCUT
227A	TEACHER CONFERENCE ROOM/ TOILET	2' - 8"	7' - 0"	SINGLE	FL	WD	2			1	НМ	1		43	PROVIDE 1" DOOR UNDERCUT
228	BOYS TOILET	3' - 0"	7' - 0"	SINGLE	FL	WD	2		45	2	НМ	1		27	PROVIDE 1" DOOR UNDERCUT
228A	JAN CL	2' - 6"	6' - 8"	SINGLE	FL	WD	2		45	2	НМ	1		5	
230	DATA CLOSET	3' - 0"	7' - 0"	SINGLE	FL	WD	2		90	1	нм	1		46	CARD READER ACCESS, REFER TO ELECTRICAL DRAWINGS
231.1	SPEC. ED (8:1:1)	5' - 0"	6' - 0"	PAIR	DF	WD	2			7	WD	1		22	(2) 2'-6" PIVOT DOOR PANELS
231.2	SPEC. ED (8:1:1)	5' - 0"	6' - 0"	PAIR	DF	WD	2			7	WD	1		22	(2) 2'-6" PIVOT DOOR PANELS
231.3	SPEC. ED (8:1:1)	5' - 0"	6' - 0"	PAIR	DF	WD	2			7	WD	1		22	(2) 2'-6" PIVOT DOOR PANELS
231.4	SPEC. ED (8:1:1)	2' - 0"	6' - 0"	SINGLE	FL	WD	2			7	WD	1		23	CLOSET
232.1	SPEC. ED (12:1:1)	5' - 0"	6' - 0"	PAIR	DF	WD	2			7	WD	1		22	(2) 2'-6" PIVOT DOOR PANELS
232.2	SPEC. ED (12:1:1)	5' - 0"	6' - 0"	PAIR	DF	WD	2			7	WD	1		22	(2) 2'-6" PIVOT DOOR PANELS
232.3	SPEC. ED (12:1:1)	5' - 0"	6' - 0"	PAIR	DF	WD	2			7	WD	1		22	(2) 2'-6" PIVOT DOOR PANELS
232.4	SPEC. ED (12:1:1)	2' - 0"	6' - 0"	SINGLE	FL	WD	2			7	WD	1		23	CLOSET
233.1	SPEC. ED (12:1:1)	5' - 0"	6' - 0"	PAIR	DF	WD	2			7	WD	1		22	(2) 2'-6" PIVOT DOOR PANELS
233.2	SPEC. ED (12:1:1)	5' - 0"	6' - 0"	PAIR	DF	WD	2			7	WD	1		22	(2) 2'-6" PIVOT DOOR PANELS
233.3	SPEC. ED (12:1:1)	5' - 0"	6' - 0"	PAIR	DF	WD	2			7	WD	1		22	(2) 2'-6" PIVOT DOOR PANELS
233.4	SPEC. ED (12:1:1)	2' - 0"	6' - 0"	SINGLE	FL	WD	2			7	WD	1		23	CLOSET
COR-H.1	CORRIDOR H	6' - 0"	7' - 0"	PAIR	DV	HM	1	С	90	1	HM	1		51	
COR-K.1	CORRIDOR J	6' - 0"	7' - 0"	PAIR	DG	HM	1	С	S	3	HM	1	С	75	
COR-K.2	CORRIDOR G	6' - 0"	7' - 0"	PAIR	DV	HM	1	С	90	1	HM	1		51	
SF8C.1	STAIR 8	VIF	VIF	SINGLE	FL	WD	2		45	ETR	ETR	1		37	
SF8C.2	STAIR 8	VIF	VIF	SINGLE	FL	WD	2		45	ETR	ETR	1		37	
SF9C.2	STAIR 9	VIF	VIF	SINGLE	FL	WD	2		45	ETR	ETR	1		74	
SF200	CSE OFFICE /CONFERENCE ROOM	VIF	VIF	SINGLE	V	WD	2	С	45	ETR	ETR	1	ETR	25	
SF201	1-3 GRADE CLASSROOM	VIF	VIF	SINGLE	V	WD	2	С	20	ETR	ETR	1	В	34	
SF202	1-3 GRADE CLASSROOM	VIF	VIF	SINGLE	V	WD	2	С	20	ETR	ETR	1	В	34	W16 TRANSOM
SF203	1-3 GRADE CLASSROOM	VIF	VIF	SINGLE	V	WD	2	С	20	ETR	ETR	1	В	34	W16 TRANSOM
SF205	COPIER ROOM	VIF	VIF	SINGLE	FL	WD	2		45	ETR	ETR	1		60	
SF206	RESOURCE ROOM	VIF	VIF	SINGLE	V	WD	2	С	20	ETR	ETR	1	В	34	W16 TRANSOM
SF208	MEN'S TOILET	VIF	VIF	SINGLE	FL	WD	2		45	ETR	ETR	1		5	PROVIDE 1" DOOR UNDERCUT
SF210	SPEC. ED (12:1:1)	VIF	VIF	SINGLE	V	WD	2	С	90	ETR	ETR	1	FILL	34	W16 TRANSOM
SF211	ОТ/РТ	VIF	VIF	SINGLE	V	WD	2	С	45	ETR	ETR	1	С	34	
SF211A	OT/PT	VIF	VIF	SINGLE	V	WD	2			ETR	ETR	1		15	
SF233	SPEC. ED (12:1:1)	VIF	VIF	SINGLE	V	WD	2		45	ETR	ETR	1		34	
SF224	SPEC. ED (8:1:1)	VIF	VIF	SINGLE	V	WD	2	С	20	ETR	ETR	1	В	34	W16 TRANSOM
SF226	SPEC. ED (8:1:1)	VIF	VIF	SINGLE	V	WD	2	С	20	ETR	ETR	1	В	34	W16 TRANSOM
SF227	TEACHER'S CONFRENCE RM.	VIF	VIF	SINGLE	V	WD	2	С	45	ETR	ETR	1	С	35	
SF229	ESOL OFFICE	VIF	VIF	SINGLE	V	WD	2	С	20	ETR	ETR	1	В	45	

	DOOR SCHEDULE														
														HARDWARE	
DOOR NO.	ROOM	WIDTH	HEIGHT	SINGLE/PAIR	TYPE	MAT.	FINISH	GLASS	FIRE RATING	TYPE	MAT.	FINISH	GLASS		COMMENTS
SF231	SPEC. ED (8:1:1)	VIF	VIF	SINGLE	V	WD	2	С	20	ETR	ETR	1	В	1	W16 TRANSOM
SF232	SPEC. ED (12:1:1)	VIF	VIF	SINGLE	V	WD	2	С	20	ETR	ETR	1	В	34	W16 TRANSOM
SF235	TOILET	VIF	VIF	SINGLE	FL	WD	2		45	ETR	ETR	1		9	PROVIDE 1" DOOR UNDERCUT
ST-1C	STAIR 1	6' - 0"	7' - 0"	PAIR	DG	HM	1	С	60	4	HM	1	С	65	
ST-2C	STAIR 2	6' - 0"	7' - 0"	PAIR	DG	HM	1	С	60	4	HM	1	С	65	
ST-3C	STAIR 3	6' - 0"	7' - 0"	PAIR	DG	HM	1	С	60	4	HM	1	С	65	
ST-4C	STAIR 4	6' - 0"	7' - 0"	PAIR	DG	HM	1	С	60	5	HM	1	С	65	
							PENTHOL	JSE FLOOR							
EX300.1	MECHANICAL PENTHOUSE	6'-0" PAIR 7'-0" DF HM 1 2 13 HM2 156											48	EXTERIOR DOOR	
EX300.2	MECHANICAL PENTHOUSE	6' - 0"	PAIR	7' - 0"	DF	HM	1			1	HM	1		48	EXTERIOR DOOR
EX301	ELECTRICAL LIFE SAFETY ROOM	6' - 0"	PAIR	7' - 0"	DF	HM	1			1	НМ	1		48	EXTERIOR DOOR
EX-4D	STAIR 4	3' - 0"	SINGLE	7' - 0"	FL	HM	1			1	HM	1		55	EXTERIOR DOOR

### DOOR SCHEDULE LEGEND:

# DOOR MATERIAL TYPES:

WD WOOD

HM HOLLOW METAL FRP/ALUM FRP/ ALUM HYBRID

### DOOR FIRE RATINGS:

20 20 MINUTE RATED ASSEMBLY

45 3/4 HR RATED ASSEMBLY

60 1 HR RATED ASSEMBLY

90 1 ½ RATED HR ASSEMBLY

S SMOKE RATED ASSEMBLY

#### DOOR/ FRAME FINISH:

1 PRIMED AND PAINTED- COLOR BY ARCHITECT

2 STAIN AND CLEAR COAT- FINISH BY ARCHITECT

MAN. FACTORY PRIMED AND FINISH COTE SELECTED BY ARCHITECT

MISC. ABBREVIATIONS FOR DOORS/ FRAMES/ GLAZING:

SF SALVAGE FRAME

ETR EXISTING TO REMAIN

VIF VERIFY OPENING/ FRAME IN FIELD

OH OVER HEAD DOOR UNIT

UNPAIR UNEVEN PAIRED DOOR LEAFS
PAIR TWO DOOR LEAFS- ONE UNIT
SINGLE ONE DOOR LEAF- ONE UNIT

REFER TO A803 FOR:

**GLAZING TYPES/ SCHEDULE** 

FRAME TYPES DOOR TYPES

# GENERAL DOOR/ FRAME/ HARDWARE NOTES:

- 1. HARDWARE MFR AND PRODUCTS T.B.D. REFER TO HARDWARE TYPE AND CORRESPONDING HEADING IN SPEC. SECTION 087100 'DOOR HARDWARE' FOR GENERAL DESCRIPTION OF HARDWARE FUNCTION AND COMPONENTS. SUCCESSFUL BIDDER ON DOOR HARDWARE SCOPE OF WORK TO SUBMIT HARDWARE SETS AND PRODUCT DATA FOR REVIEW AND APPROVAL BY ARCHITECT, OWNER AND CONSTRUCTION MANAGER.
- 2. ALL HARDWARE TO BE ADA & IBC 2015 ACCESSIBILITY COMPLIANT.

- 3. UNIT ENTRY DOORS TO RECEIVE HARDWARE WITH A DEADBOLT INTERCONNECTED WITH THE DOOR LEVER TO ALLOW FOR EGRESS.
- 4. ALL FIRE RATED DOORS TO BE ADEQUATELY SMOKE SEALED PER BCNYS REQUIREMENTS.
- 5. ALL FIRE RATED DOORS TO BE SELF CLOSING/LATCHING.
- 6. ALL DOORS INDICATED TO RECEIVE CARD READERS ARE TO BE TIED INTO THE FIRE ALARM SYSTEM & TO BE UNLOCKED UPON A FIRE ALARM SCENARIO.
- 7. PROVIDE MAGNETIC HOLD OPENS TIED INTO FIRE ALARM, DOOR TO CLOSE UPON ACTIVATION OF ALARM.
- 8. DOORS SERVING EGRESS FROM ANY SPACE SHALL NOT LOCK OR PREVENT EXITING FROM THE BUILDING.
- 9. ALL GLAZING WITHIN 'HAZARDOUS LOCATIONS' REQUIRE SAFETY GLAZING.
- 10. ALL STUDENT ROOM DOORS SHALL HAVE EVACUATION MAP NON INVASIVELY ADHERED TO THE ROOM SIDE OF DOOR LEAF, REFER TO A600 FOR DETAILS.

# **SECTION 09 51 13 - ACOUSTICAL PANEL CEILINGS**

#### PART 1 - GENERAL

#### 1.1 RELATED DOCUMENTS

A. Drawings and general provisions of the Contract, including General and Supplementary Conditions and Division 01 Specification Sections, apply to this Section.

### 1.2 SUMMARY

A. Section includes acoustical panels and exposed suspension systems for interior ceilings.

### 1.3 ACTION SUBMITTALS

- A. Product Data: For each type of product.
- B. Samples for Verification: For each component indicated and for each exposed finish required, prepared on Samples of sizes indicated below:
  - Acoustical Panels: Set of 6-inch-square Samples of each type, color, pattern, and texture.
  - 2. Exposed Suspension-System Members, Moldings, and Trim: Set of 6-inch-long Samples of each type, finish, and color.

#### 1.4 CLOSEOUT SUBMITTALS

A. Maintenance Data: For finishes to include in maintenance manuals.

### 1.5 MAINTENANCE MATERIAL SUBMITTALS

- A. Furnish extra materials, from the same product run, that match products installed and that are packaged with protective covering for storage and identified with labels describing contents.
  - 1. Acoustical Ceiling Units: Full-size panels equal to 2 percent of quantity installed.

### 1.6 DELIVERY, STORAGE, AND HANDLING

- A. Deliver acoustical panels, suspension-system components, and accessories to Project site and store them in a fully enclosed, conditioned space where they will be protected against damage from moisture, humidity, temperature extremes, direct sunlight, surface contamination, and other causes.
- B. Before installing acoustical panels, permit them to reach room temperature and a stabilized moisture content.

### 1.7 FIELD CONDITIONS

A. Environmental Limitations: Do not install acoustical panel ceilings until spaces are enclosed and weathertight, wet-work in spaces is complete and dry, work above ceilings is complete, and ambient temperature and humidity conditions are maintained at the levels indicated for Project when occupied for its intended use.

#### PART 2 - PRODUCTS

#### 2.1 MANUFACTURERS

A. Source Limitations: Obtain each type of acoustical ceiling panel and its supporting suspension system from single source from single manufacturer.

# 2.2 PERFORMANCE REQUIREMENTS

- A. Seismic Performance: Suspended ceilings shall withstand the effects of earthquake motions determined according to ASCE/SEI 7.
- B. Surface-Burning Characteristics: Comply with ASTM E 84; testing by a qualified testing agency. Identify products with appropriate markings of applicable testing agency.
  - 1. Flame-Spread Index: Class A according to ASTM E 1264.
  - 2. Smoke-Developed Index: 50 or less.
- C. Acoustical Panel Standard: Provide manufacturer's standard panels according to ASTM E 1264 and designated by type, form, pattern, acoustical rating, and light reflectance unless otherwise indicated.

#### 2.3 ACT-2 ACOUSTICAL PANELS

- A. Product/Manufacturer:
  - 1. METALWORKS open cell, 3" 6188; Armstrong Ceiling.
  - 2. Or approved equal
- B. Material: Provide panels as follows:
  - 1. Aluminum, 0.016" thick.
- C. Color: White, powder coated.
- D. Thickness: 3/4 inch.
- E. Modular Size: 24 by 24 inches.

#### 2.4 ACT-1 ACOUSTICAL PANELS

- A. Product/Manufacturer:
  - 1. Mars Acoustic Panels ClimaPlus, Item No. 86785; USG Interiors.
- B. Classification: Provide panels as follows:

- 1. Type and Form: Type IV, mineral base with membrane-faced overlay; Form 1 and 2, nodular; with washable vinyl-film overlay.
- 2. Pattern: E (lightly textured) and G (smooth).
- C. Color: White.
- D. Light Reflectance (LR): Not less than 0.90.
- E. Ceiling Attenuation Class (CAC): Not less than 35.
- F. Noise Reduction Coefficient (NRC): Not less than 0.75.
- G. Edge/Joint Detail: Reveal sized to fit flange of exposed suspension-system members.
- H. Thickness: 3/4 inch.
- I. Modular Size: 24 by 24 inches.

#### 2.5 ACCENT PANELS

- A. Product/Manufacturer:
  - Soundscapes Basics square, Item No. 66331WH; Armstrong Ceiling.
- B. Color: As selected from manufacturer's full range.
- C. Thickness: 1.57 inch.
- D. Modular Size: 48 by 48 inches.

#### 2.6 ACT-3 ACOUSTICAL PANELS

- A. Product/Manufacturer:
  - 1. KITCHEN ZONE, Item No. 673; Armstrong Interiors.
- B. Color: White.
- C. Light Reflectance (LR): Not less than 0.89.
- D. Ceiling Attenuation Class (CAC): Not less than 33.
- E. Noise Reduction Coefficient (NRC): Not less than 0.90.
- F. Edge/Joint Detail: Reveal sized to fit flange of exposed suspension-system members.
- G. Thickness: 1 inch.
- H. Modular Size: 24 by 24 inches.

#### 2.7 ACCESSORIES

- A. Attachment Devices: Size for five times the design load indicated in ASTM C 635/C 635M, Table 1, "Direct Hung," unless otherwise indicated. Comply with seismic design requirements.
  - 1. Power-Actuated Fasteners in Concrete: Fastener system of type suitable for application indicated, fabricated from corrosion-resistant materials, with clips or other accessory devices for attaching hangers of type indicated and with capability to sustain, without failure, a load equal to 10 times that imposed by ceiling construction, as determined by testing according to ASTM E 1190, conducted by a qualified testing and inspecting agency.
- B. Wire Hangers, Braces, and Ties: Provide wires as follows:
  - 1. Stainless-Steel Wire: ASTM A 580/A 580M, Type 304, nonmagnetic.
  - 2. Size: Wire diameter sufficient for its stress at three times hanger design load (ASTM C 635/C 635M, Table 1, "Direct Hung") will be less than yield stress of wire, but not less than 0.106-inch-diameter wire.
- C. Hold-Down Clips: Manufacturer's standard hold-down.

#### 2.8 METAL EDGE MOLDINGS AND TRIM

- A. Roll-Formed, Sheet-Metal Edge Moldings and Trim: Type and profile indicated or, if not indicated, manufacturer's standard moldings for edges and penetrations that comply with seismic design requirements; formed from sheet metal of same material, finish, and color as that used for exposed flanges of suspension-system runners.
  - 1. Edge moldings shall fit acoustical panel edge details and suspension systems indicated and match width and configuration of exposed runners unless otherwise indicated.
- B. Extruded-Aluminum Edge Moldings and Trim: Where indicated, provide manufacturer's extruded-aluminum edge moldings and trim of profile indicated or referenced by manufacturer's designations, including splice plates, corner pieces, and attachment and other clips, complying with seismic design requirements.
  - 1. Product/Manufacturer:
    - a. Axiom Classic Trim; Armstrong World Industries, Inc.
    - b. Axiom Knife edge; trim straight; Armstrong Ceiling
  - 2. Baked-Enamel or Powder-Coat Finish: Minimum dry film thickness of 1.5 mils. Comply with ASTM C 635/C 635M and coating manufacturer's written instructions for cleaning, conversion coating, and applying and baking finish.

#### 2.9 ACOUSTICAL SEALANT

A. Acoustical Sealant: As specified in Section 07 92 19 "Acoustical Joint Sealants."

#### PART 3 - EXECUTION

#### 3.1 EXAMINATION

- A. Examine substrates, areas, and conditions, including structural framing to which acoustical panel ceilings attach or abut, with Installer present, for compliance with requirements specified in this and other Sections that affect ceiling installation and anchorage and with requirements for installation tolerances and other conditions affecting performance of acoustical panel ceilings.
- B. Examine acoustical panels before installation. Reject acoustical panels that are wet, moisture damaged, or mold damaged.
- C. Proceed with installation only after unsatisfactory conditions have been corrected.

#### 3.2 PREPARATION

- A. Measure each ceiling area and establish layout of acoustical panels to balance border widths at opposite edges of each ceiling. Avoid using less-than-half-width panels at borders unless otherwise indicated, and comply with layout shown on reflected ceiling plans.
- B. Layout openings for penetrations centered on the penetrating items.

#### 3.3 INSTALLATION

- A. Install acoustical panel ceilings according to ASTM C 636/C 636M and manufacturer's written instructions.
- B. Suspend ceiling hangers from building's structural members and as follows:
  - Install hangers plumb and free from contact with insulation or other objects within ceiling plenum that are not part of supporting structure or of ceiling suspension system.
  - 2. Splay hangers only where required to miss obstructions; offset resulting horizontal forces by bracing, countersplaying, or other equally effective means.
  - 3. Where width of ducts and other construction within ceiling plenum produces hanger spacings that interfere with location of hangers at spacings required to support standard suspension-system members, install supplemental suspension members and hangers in form of trapezes or equivalent devices.
  - 4. Secure wire hangers to ceiling-suspension members and to supports above with a minimum of three tight turns. Connect hangers directly to structure or to inserts, eye screws, or other devices that are secure and appropriate for substrate and that will not deteriorate or otherwise fail due to age, corrosion, or elevated temperatures.
  - 5. Do not support ceilings directly from permanent metal forms or floor deck. Fasten hangers to cast-in-place hanger inserts, postinstalled mechanical or adhesive anchors, or power-actuated fasteners that extend through forms into concrete.
  - 6. When steel framing does not permit installation of hanger wires at spacing required, install carrying channels or other supplemental support for attachment of hanger wires.

- 7. Do not attach hangers to steel deck tabs.
- 8. Do not attach hangers to steel roof deck. Attach hangers to structural members.
- 9. Space hangers not more than 48 inches o.c. along each member supported directly from hangers unless otherwise indicated; provide hangers not more than 8 inches from ends of each member.
- 10. Size supplemental suspension members and hangers to support ceiling loads within performance limits established by referenced standards.
- C. Secure bracing wires to ceiling suspension members and to supports with a minimum of four tight turns. Suspend bracing from building's structural members as required for hangers, without attaching to permanent metal forms, steel deck, or steel deck tabs. Fasten bracing wires into concrete with cast-in-place or postinstalled anchors.
- D. Install edge moldings and trim of type indicated at perimeter of acoustical ceiling area and where necessary to conceal edges of acoustical panels.
  - 1. Apply acoustical sealant in a continuous ribbon concealed on back of vertical legs of moldings before they are installed.
  - 2. Screw attach moldings to substrate at intervals not more than 16 inches o.c. and not more than 3 inches from ends. Miter corners accurately and connect securely.
  - 3. Do not use exposed fasteners, including pop rivets, on moldings and trim.
- E. Install suspension-system runners so they are square and securely interlocked with one another. Remove and replace dented, bent, or kinked members.
- F. Install acoustical panels with undamaged edges and fit accurately into suspensionsystem runners and edge moldings. Scribe and cut panels at borders and penetrations to provide precise fit.
  - 1. Arrange directionally patterned acoustical panels as follows:
    - a. As indicated on reflected ceiling plans.
  - 2. For square-edged panels, install panels with edges fully hidden from view by flanges of suspension-system runners and moldings.
  - 3. For reveal-edged panels on suspension-system runners, install panels with bottom of reveal in firm contact with top surface of runner flanges.
  - 4. Paint cut edges of panel remaining exposed after installation; match color of exposed panel surfaces using coating recommended in writing for this purpose by acoustical panel manufacturer.
  - 5. Install hold-down clips in areas indicated; space according to panel manufacturer's written instructions unless otherwise indicated.
    - a. Install hold-down clips in vestibules and other areas indicated on Drawings.
    - b. Hold-Down Clips: Space 24 inches o.c. on all cross runners.

#### 3.4 ERECTION TOLERANCES

- A. Suspended Ceilings: Install main and cross runners level to a tolerance of 1/8 inch in 12 feet, non-cumulative.
- B. Moldings and Trim: Install moldings and trim to substrate and level with ceiling suspension system to a tolerance of 1/8 inch in 12 feet, non-cumulative.

CJS Architects Project #1711.00 4/25/2018

#### 3.5 CLEANING

- A. Clean exposed surfaces of acoustical panel ceilings, including trim, edge moldings, and suspension-system members. Comply with manufacturer's written instructions for cleaning and touchup of minor finish damage.
- B. Remove and replace ceiling components that cannot be successfully cleaned and repaired to permanently eliminate evidence of damage.

END OF SECTION 09 51 13

CJS Architects Project #1711.00 4/25/2018

#### SECTION 09 6800 CARPETING

#### **PART 1 GENERAL**

#### 1.01 SECTION INCLUDES

- A. Carpet, direct-glued and woven broadloom.
- B. Entry mats.
- C. Removal of existing carpet.
- D. Accessories.

#### 1.02 RELATED REQUIREMENTS

- Section 01 7419 Construction Waste Management and Disposal: Reclamation/Recycling of new carpet scrap and removed carpet.
- B. Section 03 3000 Cast-in-Place Concrete: Restrictions on curing compounds for concrete slabs and floors to receive adhesive-applied carpet.
- C. Section 09 6100 Water Vapor Reduction System: Independent agency testing of concrete slabs, and preparation of slab for carpet installation.

#### 1.03 REFERENCE STANDARDS

- A. ASTM D2859 Standard Test Method for Ignition Characteristics of Finished Textile Floor Covering Materials; 2006 (Reapproved 2011).
- B. ASTM E648 Standard Test Method for Critical Radiant Flux of Floor-Covering Systems Using a Radiant Heat Energy Source; 2014c.
- C. NFPA 253 Standard Method of Test for Critical Radiant Flux of Floor Covering Systems Using a Radiant Heat Energy Source; National Fire Protection Association; 2015.

#### 1.04 SUBMITTALS

- A. See Section 01 3000 Administrative Requirements, for submittal procedures.
- B. Shop Drawings: Indicate seaming plan, method of joining seams, direction of carpet pile and pattern, location of edge moldings and edge bindings.
- C. Product Data: Provide data on specified products, describing physical and performance characteristics; sizes, patterns, colors available, and method of installation.
- D. Samples: Submit two samples 36 inch by 36 inch in size illustrating color and pattern for each carpet and cushion material specified.
  - When no color and or pattern is specified, submit samples of full color and pattern range for architect selection
- E. Submit two, 6 inch long samples of each accessory for each color specified.
- F. Manufacturer's Installation Instructions: Indicate special procedures and perimeter conditions requiring special attention.
- G. Maintenance Data: Include maintenance procedures, recommended maintenance materials, and suggested schedule for cleaning.
- H. Maintenance Materials: Furnish the following for Rochester City School District's use in maintenance of project.
  - 1. See Section 01 6000 Product Requirements, for additional requirements.
  - 2. Extra BroadloomCarpet: 144 sq ft of each type, color, and pattern installed.
  - 3. Extra Walk-off Matt: Amount equal to a duplicate replacement of installed area.

CJS Architects Project #1711.00 4/25/2018

#### 1.05 QUALITY ASSURANCE

A. Installer Qualifications: Company specializing in installing carpet with minimum three years documented experience in work of this section.

#### 1.06 WARRANTY

- A. Product and workmanship and labor warranty: 2-years.
- B. Provide special prject warranty, signed by contractor, installer, and manufacturer (carpet mill) agreeing to repair or replace defective materials and workmanship of carpeting work during the 2-year warranty period following Date of Substantial Completion. Attached signed copies of product warranties.

#### 1.07 FIELD CONDITIONS

- A. Store materials in area of installation for minimum period of 24 hours prior to installation.
- B. Maintain minimum 70 degrees F ambient temperature 24 hours prior to, during and 24 hours after installation.
- C. Ventilate installation area during installation and for 72 hours after installation.

#### **PART 2 PRODUCTS**

#### 2.01 MANUFACTURERS

- A. Carpet:
  - 1. Mannington Commercial; www.mannington.com.
  - 2. Substitutions: See Section 01 6000 Product Requirements.

#### 2.02 CARPET

- A. Carpet, Type CPT:
  - 1. Product: Everywear III manufactured by Mannington Commercial.
  - 2. Roll Width: 12 ft.
  - 3. Color: As follows.
    - a. CPT: 3306 TECHNO.
  - Critical Radiant Flux: Minimum of 0.22 watts/sq cm, when tested in accordance with ASTM E648 or NFPA 253.
  - 6. Surface Flammability Ignition: Pass ASTM D2859 (the "pill test").
  - 7. Substitutions: See Section 01 6000 Product Requirements.

#### 2.03 ACCESSORIES

- A. Sub-Floor Filler: Type recommended by carpet manufacturer.
  - Cementitious type. No latek type or gypsum based levelinggrouts are permitted.
- B. Underlayments: Manufacturer's vinyl underlayment, compatible with flooring product, suitable to achieve smooth, level sustrate.
- C. Moldings and Edge Strips: color selected by architect.
- D. Adhesives: Manufacturer's recomendation
- E. Seam Adhesive: Recommended by carpet manufacturer.
- F. Carpet Adhesive: Recommended by carpet manufacturer; releasable type.

#### **PART 3 EXECUTION**

#### 3.01 EXAMINATION

- A. Cementitious Sub-floor Surfaces: Verify that substrates are dry enough and ready for flooring installation by testing for moisture and alkalinity (pH).
  - Test in accordance with Section 09 0561.
  - 2. Obtain instructions if test results are not within limits recommended by flooring material manufacturer and adhesive materials manufacturer.

CJS Architects Project #1711.00 4/25/2018

#### 3.02 PREPARATION

- A. Remove existing carpet and carpet cushion.
  - 1. Remove all materials that will interfere with the installation of glue down carpet.
- B. Prepare floor substrates as recommended by flooring and adhesive manufacturers.
- C. Moisture Vapor Transmission Test:
  - 1. Perform subfloor moisture testing in accordance with ASTM F 2170, "Standard Test Method for Determining Relative Humidity in Concrete Slabs Using in-situ Probes" and Bond Tests to determine if surfaces are dry; free of curing and hardening compounds, old adhesive, and other coatings; and ready to receive flooring. Relative humidity shall not exceed that allowed by flooring manufacturer. On installations where both the Percent Relative Humidity and the Moisture Vapor Emission Rate tests are conducted, results for both tests shall comply with the allowable limits listed above. Do not proceed with flooring installation until results of moisture tests are acceptable to the Architect and flooring manufacturer. All test results shall be documented and retained.
  - Perform pH tests on concrete floors regardless of their age or grade level. Do not proceed
    with flooring installation until results of pH tests are acceptable to the Architect and flooring
    manufacturer. All test results shall be documented and retained.
  - If moisture testing is found to be above the approved limits a water vapor reduction system as specified in Section 09 6100 shall be used to meet required limits.
- C. Remove sub-floor ridges and bumps. Fill minor or local low spots, cracks, joints, holes, and other defects with sub-floor filler.
- D. Provide underlayment of type recommended by carpet manufacturer to achieve smooth, flat substrate flush with existing subfloor.
- E. Apply, trowel, and float filler to achieve smooth, flat, hard surface. Prohibit traffic until filler is cured.
- F. Clean substrate.

#### 3.03 INSTALLATION - GENERAL

- A. Starting installation constitutes acceptance of sub-floor conditions, indicates compliance with the requirements of this Section, and subfloor is prepared in accordance with carpet manufacturers recommendations.
- B. Install carpet and cushion in accordance with manufacturer's instructions.
- C. Verify carpet match before cutting to ensure minimal variation between dye lots.
- D. Lay out carpet and locate seams in accordance with shop drawings.
  - Locate seams in area of least traffic, out of areas of pivoting traffic, and parallel to main traffic
  - 2. Do not locate seams perpendicular through door openings.
  - 3. Align run of pile in same direction as anticipated traffic and in same direction on adjacent pieces.
  - 4. Locate change of color or pattern between rooms under door centerline.
  - 5. Provide monolithic color, pattern, and texture match within any one area.
- E. Install carpet tight and flat on subfloor, well fastened at edges, with a uniform appearance.

#### 3.04 DIRECT-GLUED CARPET

A. Double cut carpet seams, with accurate pattern match. Make cuts straight, true, and unfrayed. Apply seam adhesive to cut edges of woven carpet immediately.

CJS Architects Project #1711.00 4/25/2018

- B. Use continuous lengths and a braod widths as possible. No width should be less than one half the roll width whenever practical.
- C. Fit secotions of carpet into each space prior to application of adhesive. lay carpet in one direction within a room and within connection rooms Notify Archiect if manufacturer recommends rotating carpet direction for any reason.
- D. Apply contact adhesive to floor uniformly at rate recommended by manufacturer. After sufficient open time, press carpet into adhesive.
- E. Apply seam adhesive to the base of the edge glued down. Lay adjoining piece with seam straight, not overlapped or peaked, and free of gaps.
- F. Roll with appropriate roller for complete contact of adhesive to carpet backing.
- G. Trim carpet neatly at walls and around interruptions.

#### 3.05 WALK-OFF MAT INSTALLATION AT STAIR LANDING RECESSES

- A. Follow manufacturer's installation instructions for the project application.
- B. Use minimum number of tiles to infill walk-off mat recesses.
- C. Smallest dimension of any tile shall not be less than 12 inches.
- Set all tiles with pattern perpendicular to flow of entry/exit travel. Quarter trun installation method is not acceptable.
- E. Scribe tiles to edges of recesses maintaining pattern true and square to leading recess edge.

#### 3.06 CLEANING

- A. Remove excess adhesive from floor and wall surfaces without damage.
- B. Carpet shall be free of spots, air pockets, dirt or soil, and shall be without tears, frays, or pulls. Replace sections that indicate either damage or improper installation.
- C. Remove debris and unused materials from site. Contractor shall maintian conditions in a manner sutiable to the installer, which ensures caarpet work being without damage on Date of Substatial Completion.
- D. Clean and vacuum carpet surfaces.

**END OF SECTION** 

George M Forbes 09 6800 - 4 CARPETING

#### SECTION 10 28 14 - HAND DRYERS

#### **PART 1 - GENERAL**

#### 1.1 WORK OF THIS SECTION INCLUDES:

1. Provide toilet room hand dryers where indicated on the drawings.

#### 1.2 SUBMITTALS:

- 1. Submit manufacturer's technical data and installation instructions.
- 2. Provide setting drawings, templates, instructions and directions for installation of anchorage devices and cut-out requirements of other work.

#### **PART 2 - PRODUCTS**

#### 2.1 ACCEPTABLE MANUFACTURERS:

1. All items shall be manufactured by World Dryer Company, Bobrick Washroom Equipment Inc., or approved equivalent.

#### 2.2 PRODUCTS:

- 1. Surface-Mounted ADA compliant Automatic Hand Dryer; World Dryer, 'SlimDri' Model #L-974, or approved equivalent.
  - Cover; Vandal resistant die-cast aluminum with epoxy paint, paint to be antimicrobial. Secured to wall-mounting plate with tamperresistant screws.
  - b. Intake; Dryer shall have an ingress protection rating of IP23.
  - Motor; thermally-protected universal brush type motor operating at 13,000 RPM and delivering 70 CFM air flow at a velocity of 140 MPH (12,320 LFM). Dryer shall incorporate universal controls accepting 115 VAC input.
  - d. Blower; Dynamically balanced blower wheels for vibration-free running. All internal parts to be plated for corrosion-resistance.
  - e. Heating Element; Dryer will incorporate a chrome wire heating element protected by an automatic resetting thermal cutoff.
     Control board shall contain a heater control switch which can be controlled in either ON or OFF position. Dryer shall provide a 48°F temperature rise and be inaccessible to vandals.
  - f. Certification; Unit shall be U.L. listed.
  - g. Electronic Sensor; Dryer shall be activated by an automatic infrared sensor with a 3 second run-on time and 60 second vandal shut-off.
  - h. Manual; Manufacturer's service and parts manual shall be provided to building owner/manager upon completion of project.

CJS Architects Project #1711.00 3/15/2018

 Warranty; Unit shall be protected by a limited 10-year warranty on all parts except motor brushes and sensor. Motor brushes and electronic sensors shall be warranted for a period of five years from date of installation.

#### **PART 3 - EXECUTION**

#### 3.1 INSTALLATION:

- Install accessories in accordance with manufacturer's instructions, using fasteners which are appropriate to substrate and recommended by manufacturer of units. Install units plumb and level firmly anchored in locations indicated.
- 2. Dedicated circuit to be provided by electrical contractor with 15 amp and must be properly grounded with GFI circuit protection.
- 3. Exposed fasteners shall be chrome plated with tamperproof heads.
- 4. Install accessories to manufacturer's recommended heights, except as shown otherwise.
- 5. Adjust toilet accessories for proper operation and verify that mechanisms function properly. Replace damaged or defective items.
- 6. Clean and polish all exposed surfaces after removing temporary labels and protective coatings.

**END OF SECTION** 

CJS Architects Project #1711.00 4/25/2018

#### **SECTION 11 30 19**

#### STATIONARY LOADING DOCK EQUIPMENT

#### PART 1 - GENERAL

#### 1.1 SUMMARY

- A. Related Documents: Provisions established within General and Supplementary Conditions of the Contract, Division 1 General Requirements and Drawings are collectively applicable to this Section.
- B. Related Sections:
  - Section 03 3000: Cast in Place Concrete for loading dock recess.
  - 2. Section 13 1319.23: Scissor Lifts.

#### 1.2 SYSTEM DESCRIPTION

- A. Design Requirements: Provide fixed-in-place adjustable loading and unloading platform for difference in height and gap between truck bed and building loading dock.
- B. Provide loading dock equipment, which has been manufactured, fabricated, and installed to withstand loads specified and to maintain performance criteria stated by manufacturer without defects or failure.
- C. Comply with ANSI MH14.1-1987.
- D. General: Submit in accordance with Section 01 3300.
- E. Product Data: Submit product data for dock equipment.
- F. Shop Drawings: Submit drawings indicating fabrication and erection of dock equipment including plans, elevations and large scale details.
  - 1. Show anchorage, pit sizes, critical installation clearances, connections, and accessory items.
  - 2. Provide location template drawings for items supported or anchored to permanent construction.
  - 3. Provide rough-in drawings for electrical service in advance of concrete work.
- G. Informational Submittals: Submit following:
  - Manufacturer's instructions.
- H. Closeout Submittals: Submit following in accordance with Section 01 7800
  - 1. Maintenance data.
  - Warranty: Specified warranty.

#### 1.3 QUALITY ASSURANCE

- A. Single Source Responsibility: Each component of dock equipment is required to be from same manufacturer.
- B. Manufacturer Qualifications: Company specializing in manufacturing Products specified in this Section with minimum ten years documented experience.
- C. Regulatory Requirements: In compliance with ANSI MH14.1-1987 and the safety and labeling requirements of ANSI MH30.1-2007.
- D. Certifications: Submit manufacturer's certification that products furnished for Project meet or exceed specified requirements.
- E. Manufacturer to hold current ISO 9001 certification

#### 1.4 WARRANTY

A. Special Warranty: Prepare and submit in accordance with Section 01 7836.

- Manufacturer's standard prorated ten-year warranty for structural components upon approval of written application.
- 2. Manufacturer's limited 5-year parts & labor warranty on lifting system (bag, motor, hoses, gaskets, fittings, & seals). Limited 1-year parts and labor warranty on remaining components.

#### PART 2 - PRODUCTS

#### 2.1 MANUFACTURERS

- A. Acceptable Manufacturers:
  - 4Front Engineered Solutions Kelley; Product AFX-S7X6 Air Powered Leveler. (Basis of Design)
  - 2. Substitutions: See Section 01 6000 Product Requirements.

#### 2.2 AIR POWERED DOCK LEVELER

- A. General:
  - 1. Capacity: 35,000 (per ANSI MH14.1-1987).
  - 2. Platform Width: 7 feet.
  - 3. Platform Length: 6 feet.
  - 4. Platform Deck Thickness: 1/4 inch high tensile steel safety tread plate with abrasive non-skid finish.
  - 5. Lip Length: 16 inch extension 5/8 inch high tensile steel safety tread plate with abrasive non-skid finish, Lip Rod 1 inch solid steel.
  - Vertical Compensation: Floating travel up and down to compensate for loading and unloading of truck.
  - 7. Service Range: 12 inches above and 12 inches below dock level.
  - 8. Side to Side Cross-Tilt: 4 inches maximum over width of ramp.
  - 9. Pit Floor Slope: Minimum 1/2 inch, back to front.
  - 10. Pit Frame: 3 inch x 3 inch x 1/4 inch steel angle, welded corners and anchors for casting into concrete.
  - 11. Identification: Attach to dock leveler in conspicuous place stating:
    - a. Capacity
    - b. Name of Manufacturer.
    - c. Model Number.
    - d. Serial Number.
  - 12. Standard Features:
    - a. Full operating range toe guard protection.
    - b. Dual-Position patented airDefense® Structural Safety Legs.
    - c. Integral Maintenance strut.
    - d. Open frame design-open front structure to allow easy clean out.
    - e. High volume, low pressure air bag lifting mechanism.
    - f. Direct connection of fan unit to air bag, no hoses or clamps accepted.
    - g. Shimless front and rear frame design.
  - 13. Options:
    - a. Master control panel with combination device controls.
       Master control panel to be 100% UL approved (INCLUDING components).
    - b. Safety Barrier Lip.
    - c. Automatic Night locks
    - d. Star 4 Vehicle Restraint.
    - e. Dock Bumpers: Pair of laminated bumpers.

CJS Architects Project #1711.00 4/25/2018

#### B. Motor Operation:

- 1. 10 amp fan with two-stage, single speed, self-cleaning filter, UL-approved motor; powered by 110 volt single-phase electrical power.
- 2. Remote Control Station: Constant pressure push button station complying with NEMA 4.
  - Constant Pressure on Control Button: Raise unit.

#### 2.3 FABRICATION

- A. Dock Equipment:
  - 1. Welded base frame construction.
  - 2. Unit supplied completely assembled, ready for use

#### 2.4 FINISHES

- A. Dock Equipment Finish:
  - 1. Preparation: Clean surfaces free from slag and splatter, loose mill scale, oil, grease, or rust.
  - 2. Dock Leveler: Factory apply manufacturer's standard DTM (Direct to Metal) Water based Paint with built in rust inhibitors.
  - Color: Manufacturer's standard color.

#### **PART 3 - EXECUTION**

#### 3.1 EXAMINATION

A. Examine conditions and proceed with Work in accordance with Section 01 4000.

#### 3.2 PREPARATION

- A. Coordinate forming of recess to receive dock leveler.
  - 1. Pit angle curbing and embeds by others.
  - 2. Ensure curb angles are square, level and flush with pit surfaces.
  - 3. Ensure that curb angles are in proper place and pit is of adequate size to receive leveler.
    - a. Pit Design:
      - 1. 20" pit depth.
      - 2. 20" to 24" sloped pit depth to facilitate easy pit cleanout of debris and water.
  - 4. Ensure that power accessories have been installed and made ready for installation.

#### 3.3 INSTALLATION

- A. Install in flat or sloped prepared pit in accordance with manufacturers installation instructions.
- B. Set square and level; anchor securely flush to dock floor; shim where applicable to keep flush; weld back and front of subframe to curb angles.
- C. Adjust installed unit for operation as specified by manufacturer.

#### 3.4 ADJUSTING AND CLEANING


- A. Adjust installed unit for smooth, safe, efficient and balanced operation.
- B. Remove temporary labels and coverings and protection of adjacent work areas.
- C. Repair or replace damaged products.
- D. Remove construction debris from site and dispose.


#### 3.5 INSTRUCTION OF OWNER'S PERSONNEL

A. Instruct Owner's personnel in operation and maintenance of installed units. Provide bound copy of manufacturer's operation and maintenance manual at time of instruction.

CJS Architects Project #1711.00 4/25/2018

**END OF SECTION** 

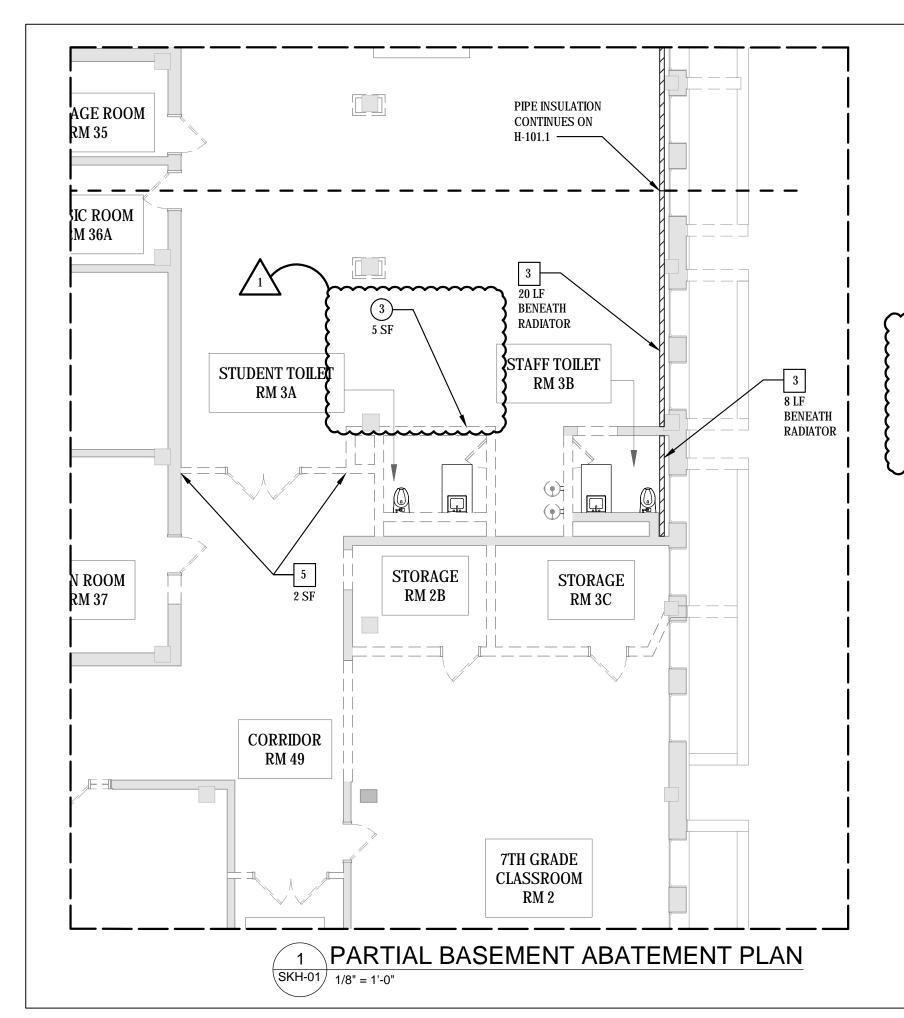

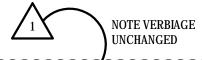

### **KEYED MOLD REMOVAL NOTES:**

NOTE: NOT ALL REMOVAL NOTES ARE UTILIZED ON EVERY SHEET. REFERENCE SPECIFICATION 02 8500.

REMOVE THE MICROBIAL GROWTH LOCATED BEHIND THE VINYL COVE BASE WITHIN A NEGATIVE AIR PRESSURE ENCLOSURE.






Rochester Schools Modernization Program -Phase 2c George M. Forbes-Renovation, Alterations and Addition


DATE: 04/25/18 REV: SCALE: 1/8 " = 1' DRN BY: EJR 1711 JOB NO: DWG REF: Checker

**PARTIAL BASEMENT ABATEMENT** PLAN -**ADDENDUM** #1

DWG NO:

**SKH-01** 

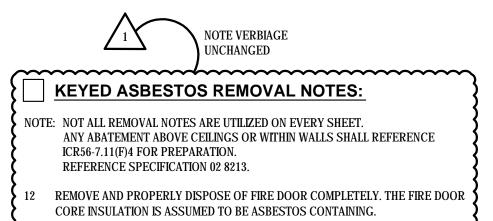

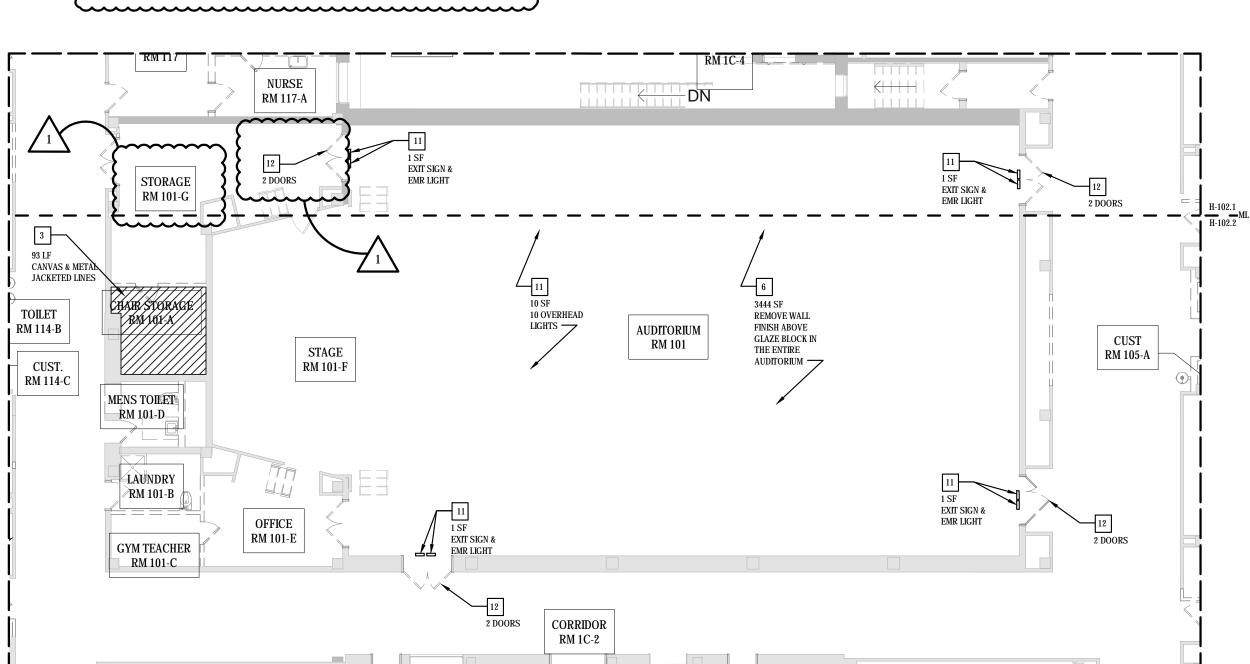

SKH-02

3/32" = 1'-0"

PARTIAL FIRST FLOOR ABATEMENT PLAN



SIENNA

Rochester Schools Modernization Program -Phase 2c George M. Forbes-Renovation, Alterations and Addition

DATE: 04/25/18
REV: 1
SCALE: 3/32 " = 1'
DRN BY: EJR
JOB NO: 1711
DWG REF: 1
Checker

PARTIAL FIRST FLOOR ABATEMENT PLAN -ADDENDUM #1

DWG NO:

SKH-02

## LAVATORY IN KINDERGARTEN AND PRE-K CLASSROOMS

<u>RM #</u>	<u>NAME</u>
117	KINDERGARTEN
121	KINDERGARTEN
122	PRE-K
124	PRE-K

## ROLL UNDER LAVATORY IN ALL OTHER SPACES (DETAIL 4/A710)

<u>RM #</u>	<u>NAME</u>
3	COMPUTER CLASSROOM
4	ART ROOM
102	1-3 GRADE CLASSROOM
103	1-3 GRADE CLASSROOM
104	1-3 GRADE CLASSROOM
107	SPEC. ED
110	SPEC. ED
111	MUSIC CLASSROOM
112	MUSIC CLASSROOM
120	NURSES SUITE
129	LIBRARY
201	1-3 GRADE CLASSROOM
202	1-3 GRADE CLASSROOM
203	1-3 GRAQDE CLASSROOM
206	RESOURCE ROOM
210	SPEC. ED
211	OT/PT
212	4-6 GRADE CLASSROOM
213	4-6 GRADE CLASSROOM
216	4-6 GRADE CLASSROOM
217	4-6 GRADE FLEX/MAKER CLASSROOM
221	4-6 GRADE FLEX/MAKER CLASSROOM
222	4-6 GRADE CLASSROOM
224 226	SPEC. ED SPEC. ED
231	SPEC. ED SPEC. ED
231	SPEC. ED SPEC. ED
232	SPEC. ED SPEC. ED
	0. 20. 25
227	TEACHER CONFERENCE ROOM



DRAWING TITLE:


**ADA SINKS** 

DATE: 04/25/18 JOB NO: 1711

REV: 1 DWG REF: A-710

SCALE:

DRN BY: ETG

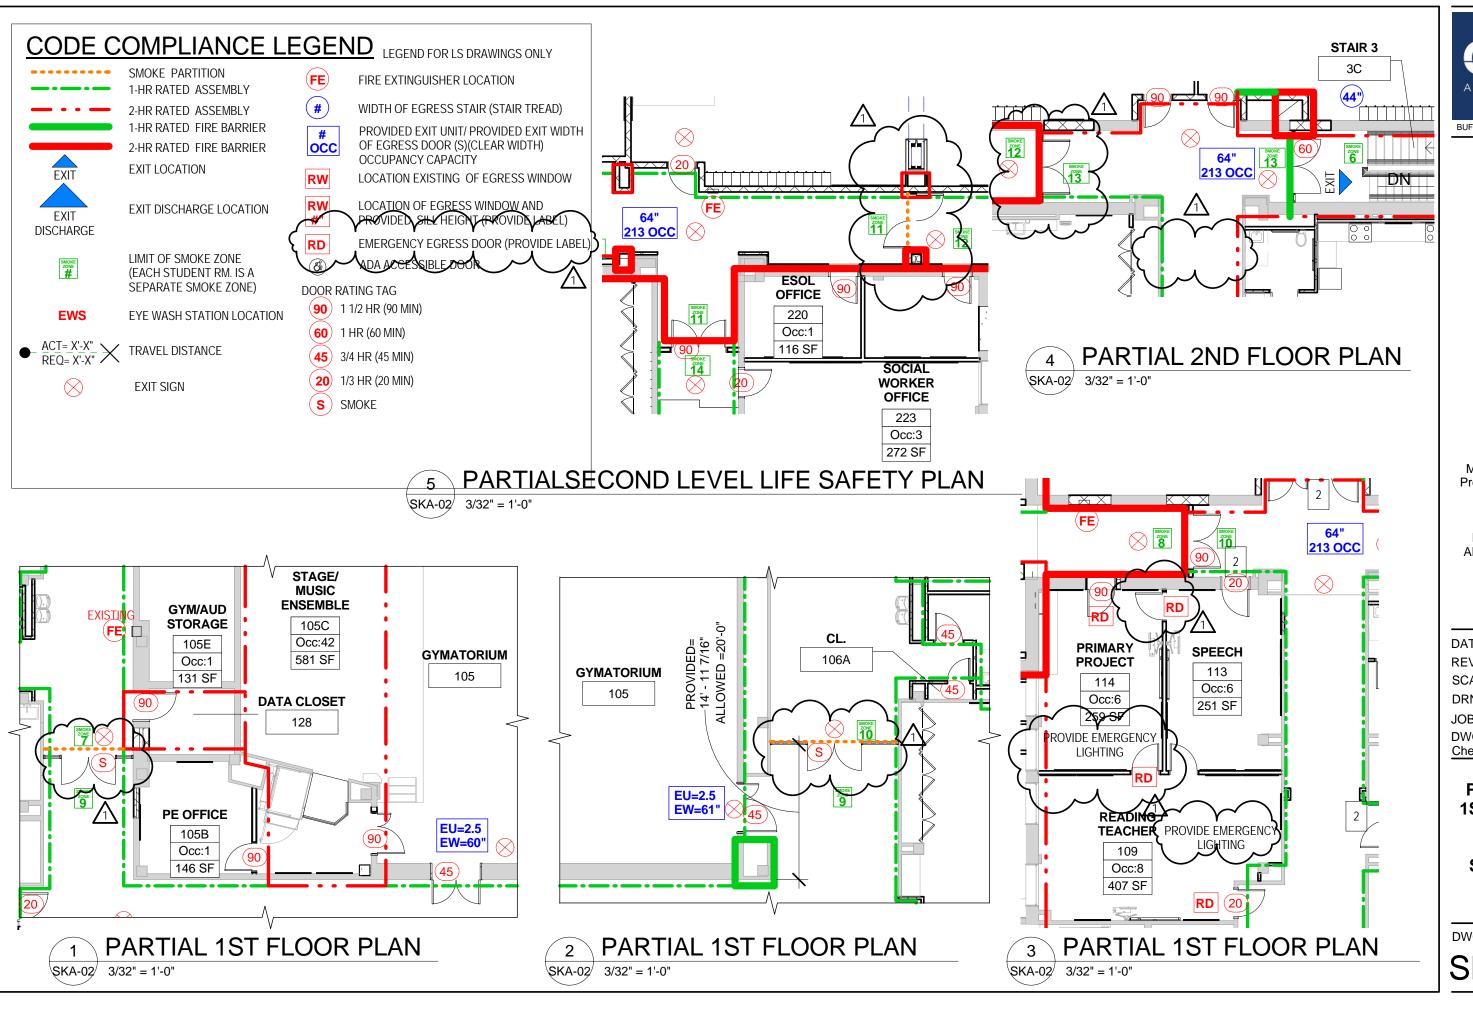




Rochester Schools Modernization Program -Phase 2c George M. Forbes-Renovation, Alterations and Addition

DATE: 04/25/18
REV: 1
SCALE3/32" = 1'-0"
DRN BY: ETG
JOB NO: 1711
DWG REF: LS -102 &
Checker LS-103

PARTIAL 1ST & 2ND FLOOR LIFE SAFETY PLANS

DWG NO:

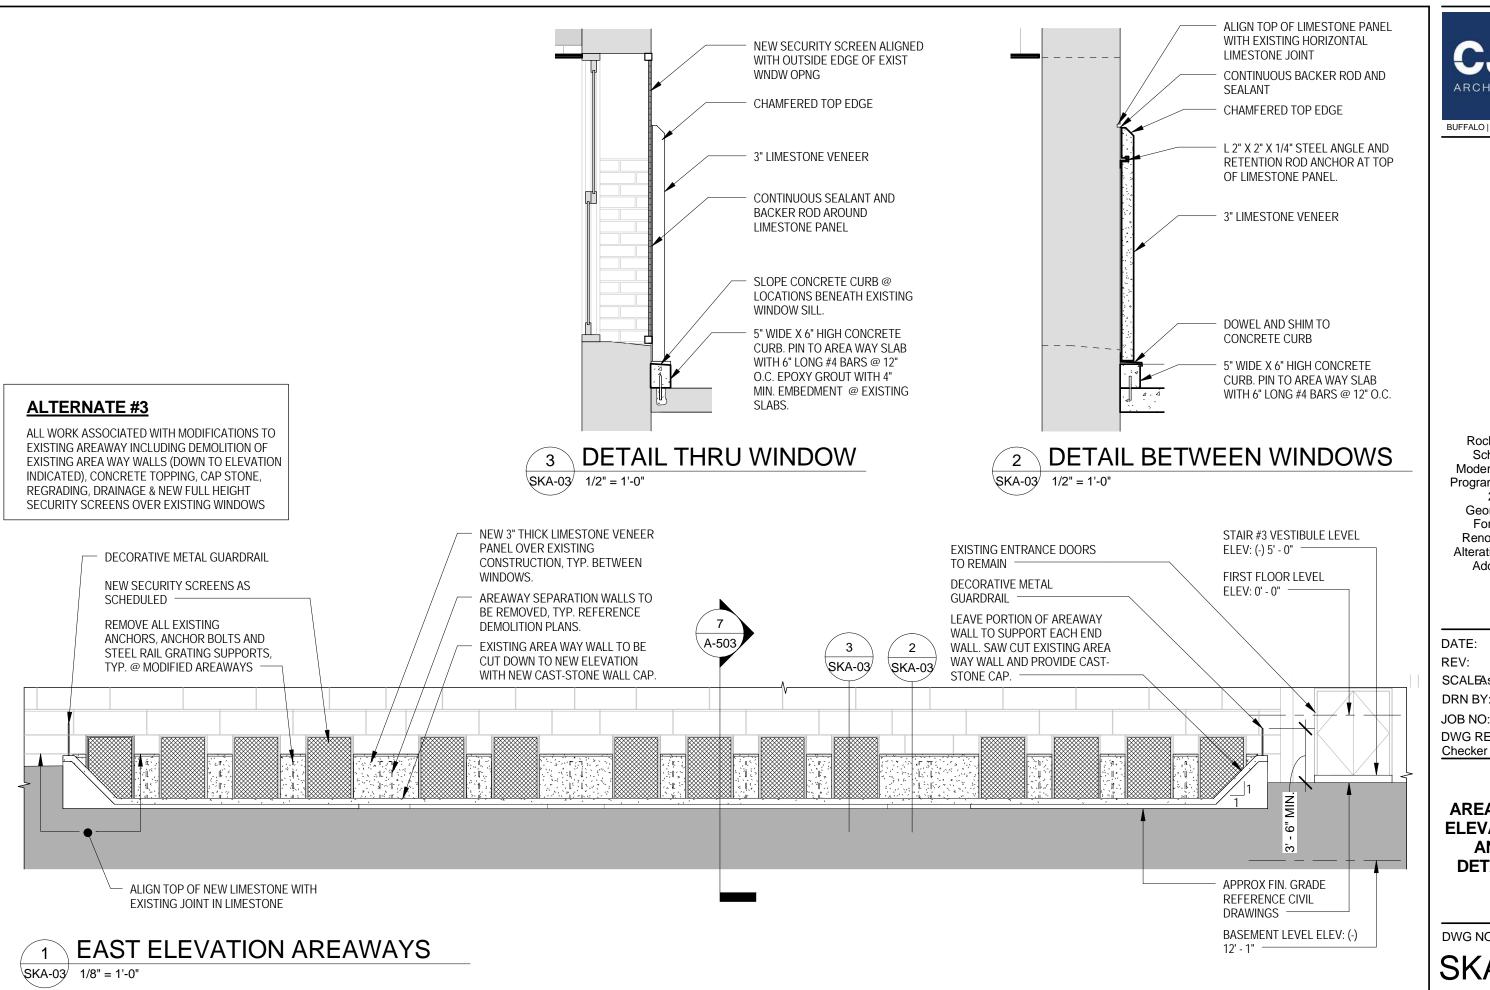



Rochester Schools Modernization Program -Phase 2c George M. Forbes-Renovation. Alterations and Addition

04/19/18 DATE: REV:


> ETG 1711


SCALEAs indicated DRN BY:

JOB NO: DWG REF:

> **AREAWAY ELEVATION** AND **DETAILS**

DWG NO:

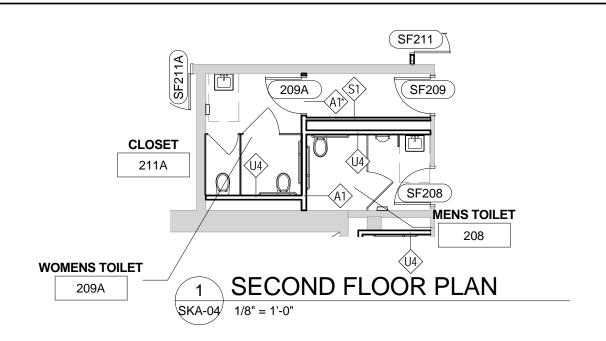

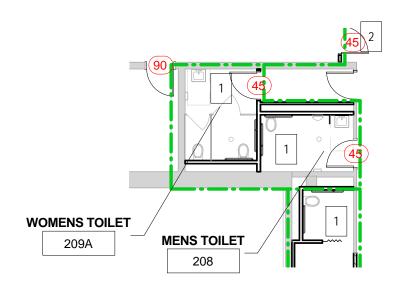

2 SECOND LEVEL LIFE SAFETY PLAN. SKA-04 3/32" = 1'-0"



DRAWING TITLE:

2ND FLOOR ROOM 209 WALL RATING CHANGE

DATE: 04/25/18


REV:

SCALE: As indicated

DRN BY: Author

JOB NO: 1711

DWG REF: LS-103 & A103.2

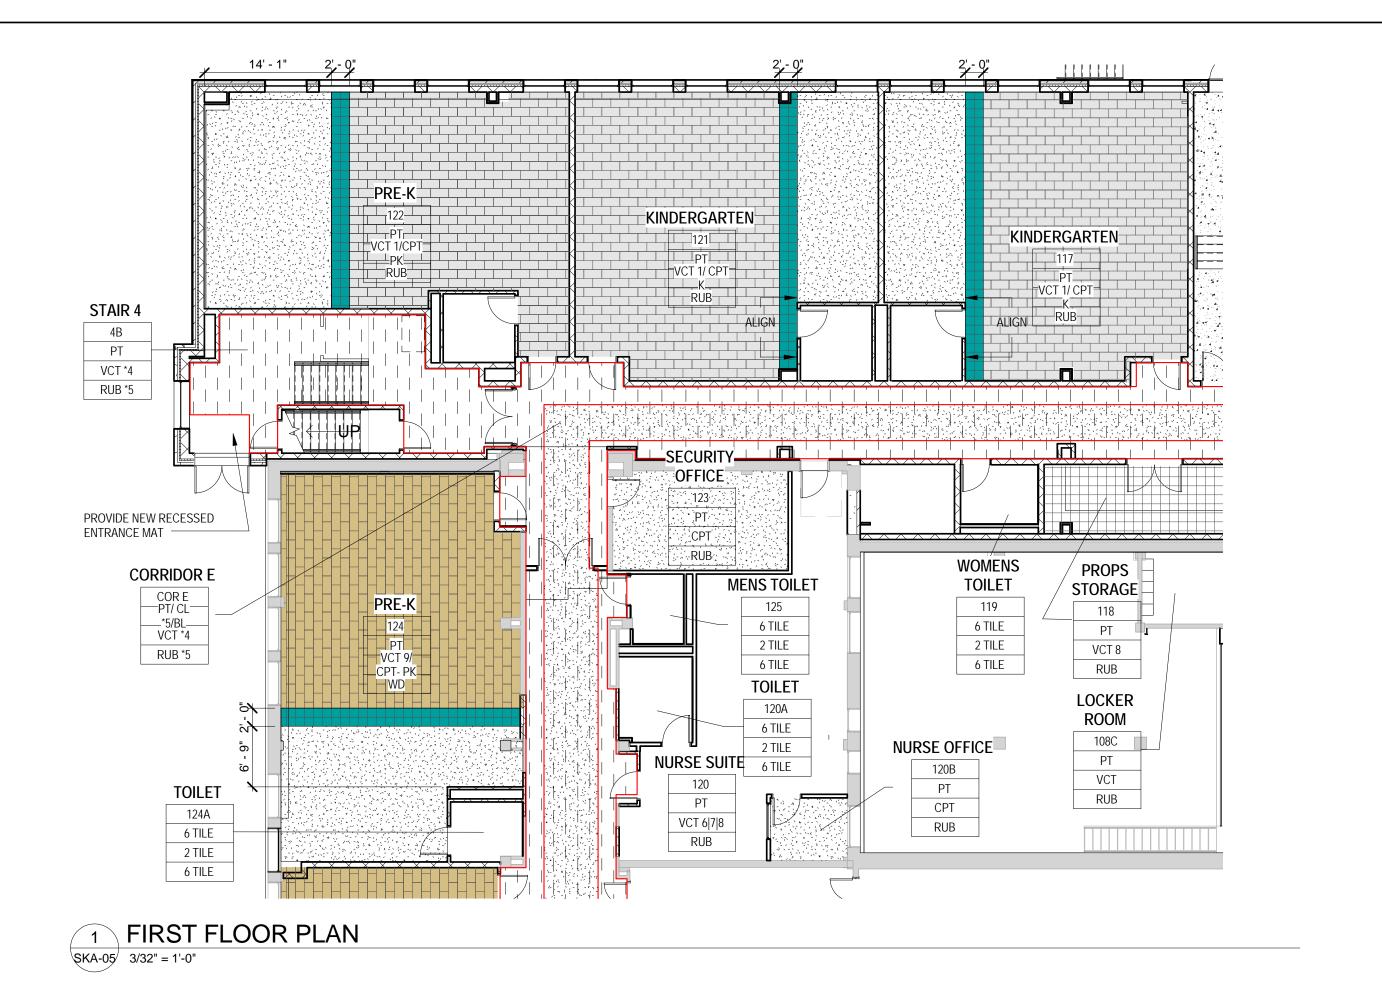



Rochester Schools Modernization Program -Phase 2c George M. Forbes-Renovation, Alterations and Addition


DATE: 04/25/18 REV:

SCALE3/32" = 1'-0" DRN BY: Author 1711 JOB NO:

DWG REF: I-102 Checker

> **PARTIAL FIRST FLOOR FINISH PLAN**

DWG NO:

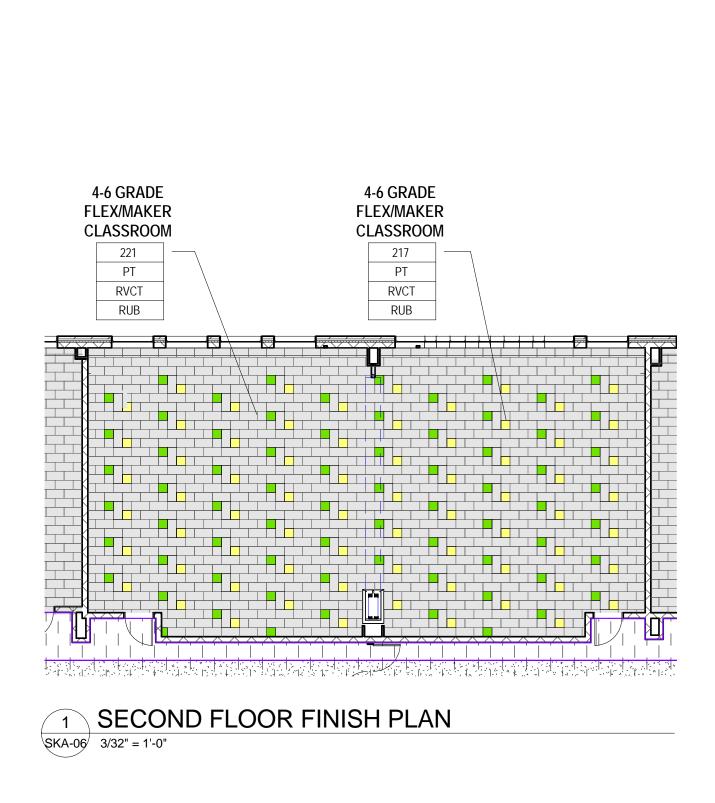



DRAWING TITLE:

PARTIAL SECOND FLOOR FINISH PLAN

DATE: 04/24/18


REV:

SCALE:3/32" = 1'-0"

DRN BY: Author

JOB NO: 1711

DWG REF: I-103

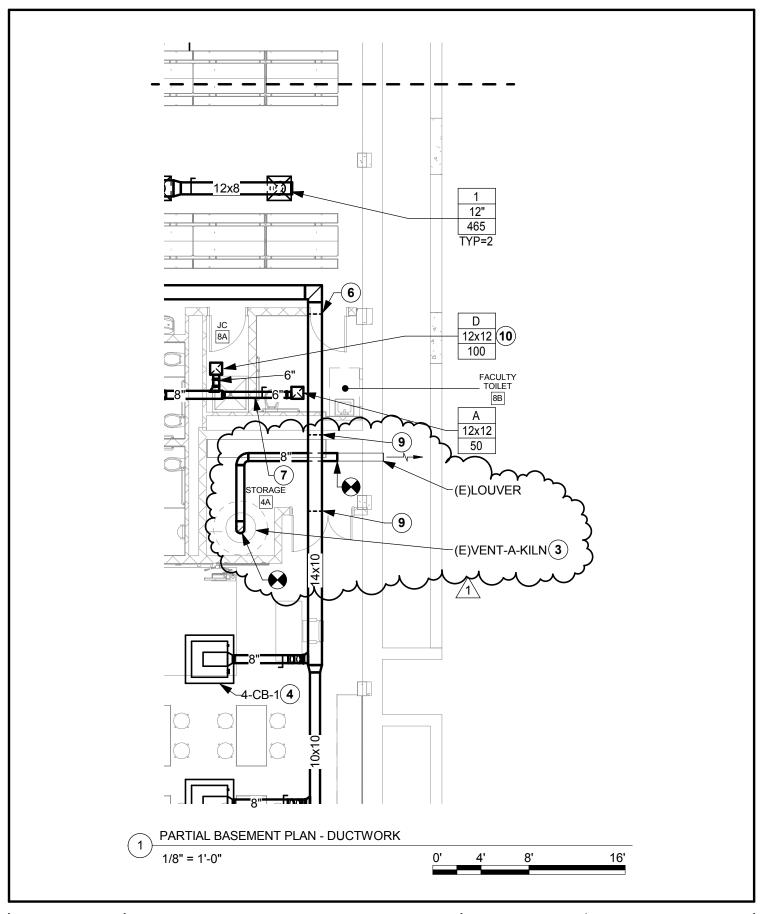





**DRAWING TITLE:** 

PARTIAL BASEMENT DUCTWORK PLAN -HVAC DATE: 04/25/18


REV: ADDENDUM 1

SCALE: 1/8" = 1'-0"


DRN BY: JPP

04/25/18 JOB NO: 1711 ENDUM 1 DWG REF: M101.2

**SKM-01** 

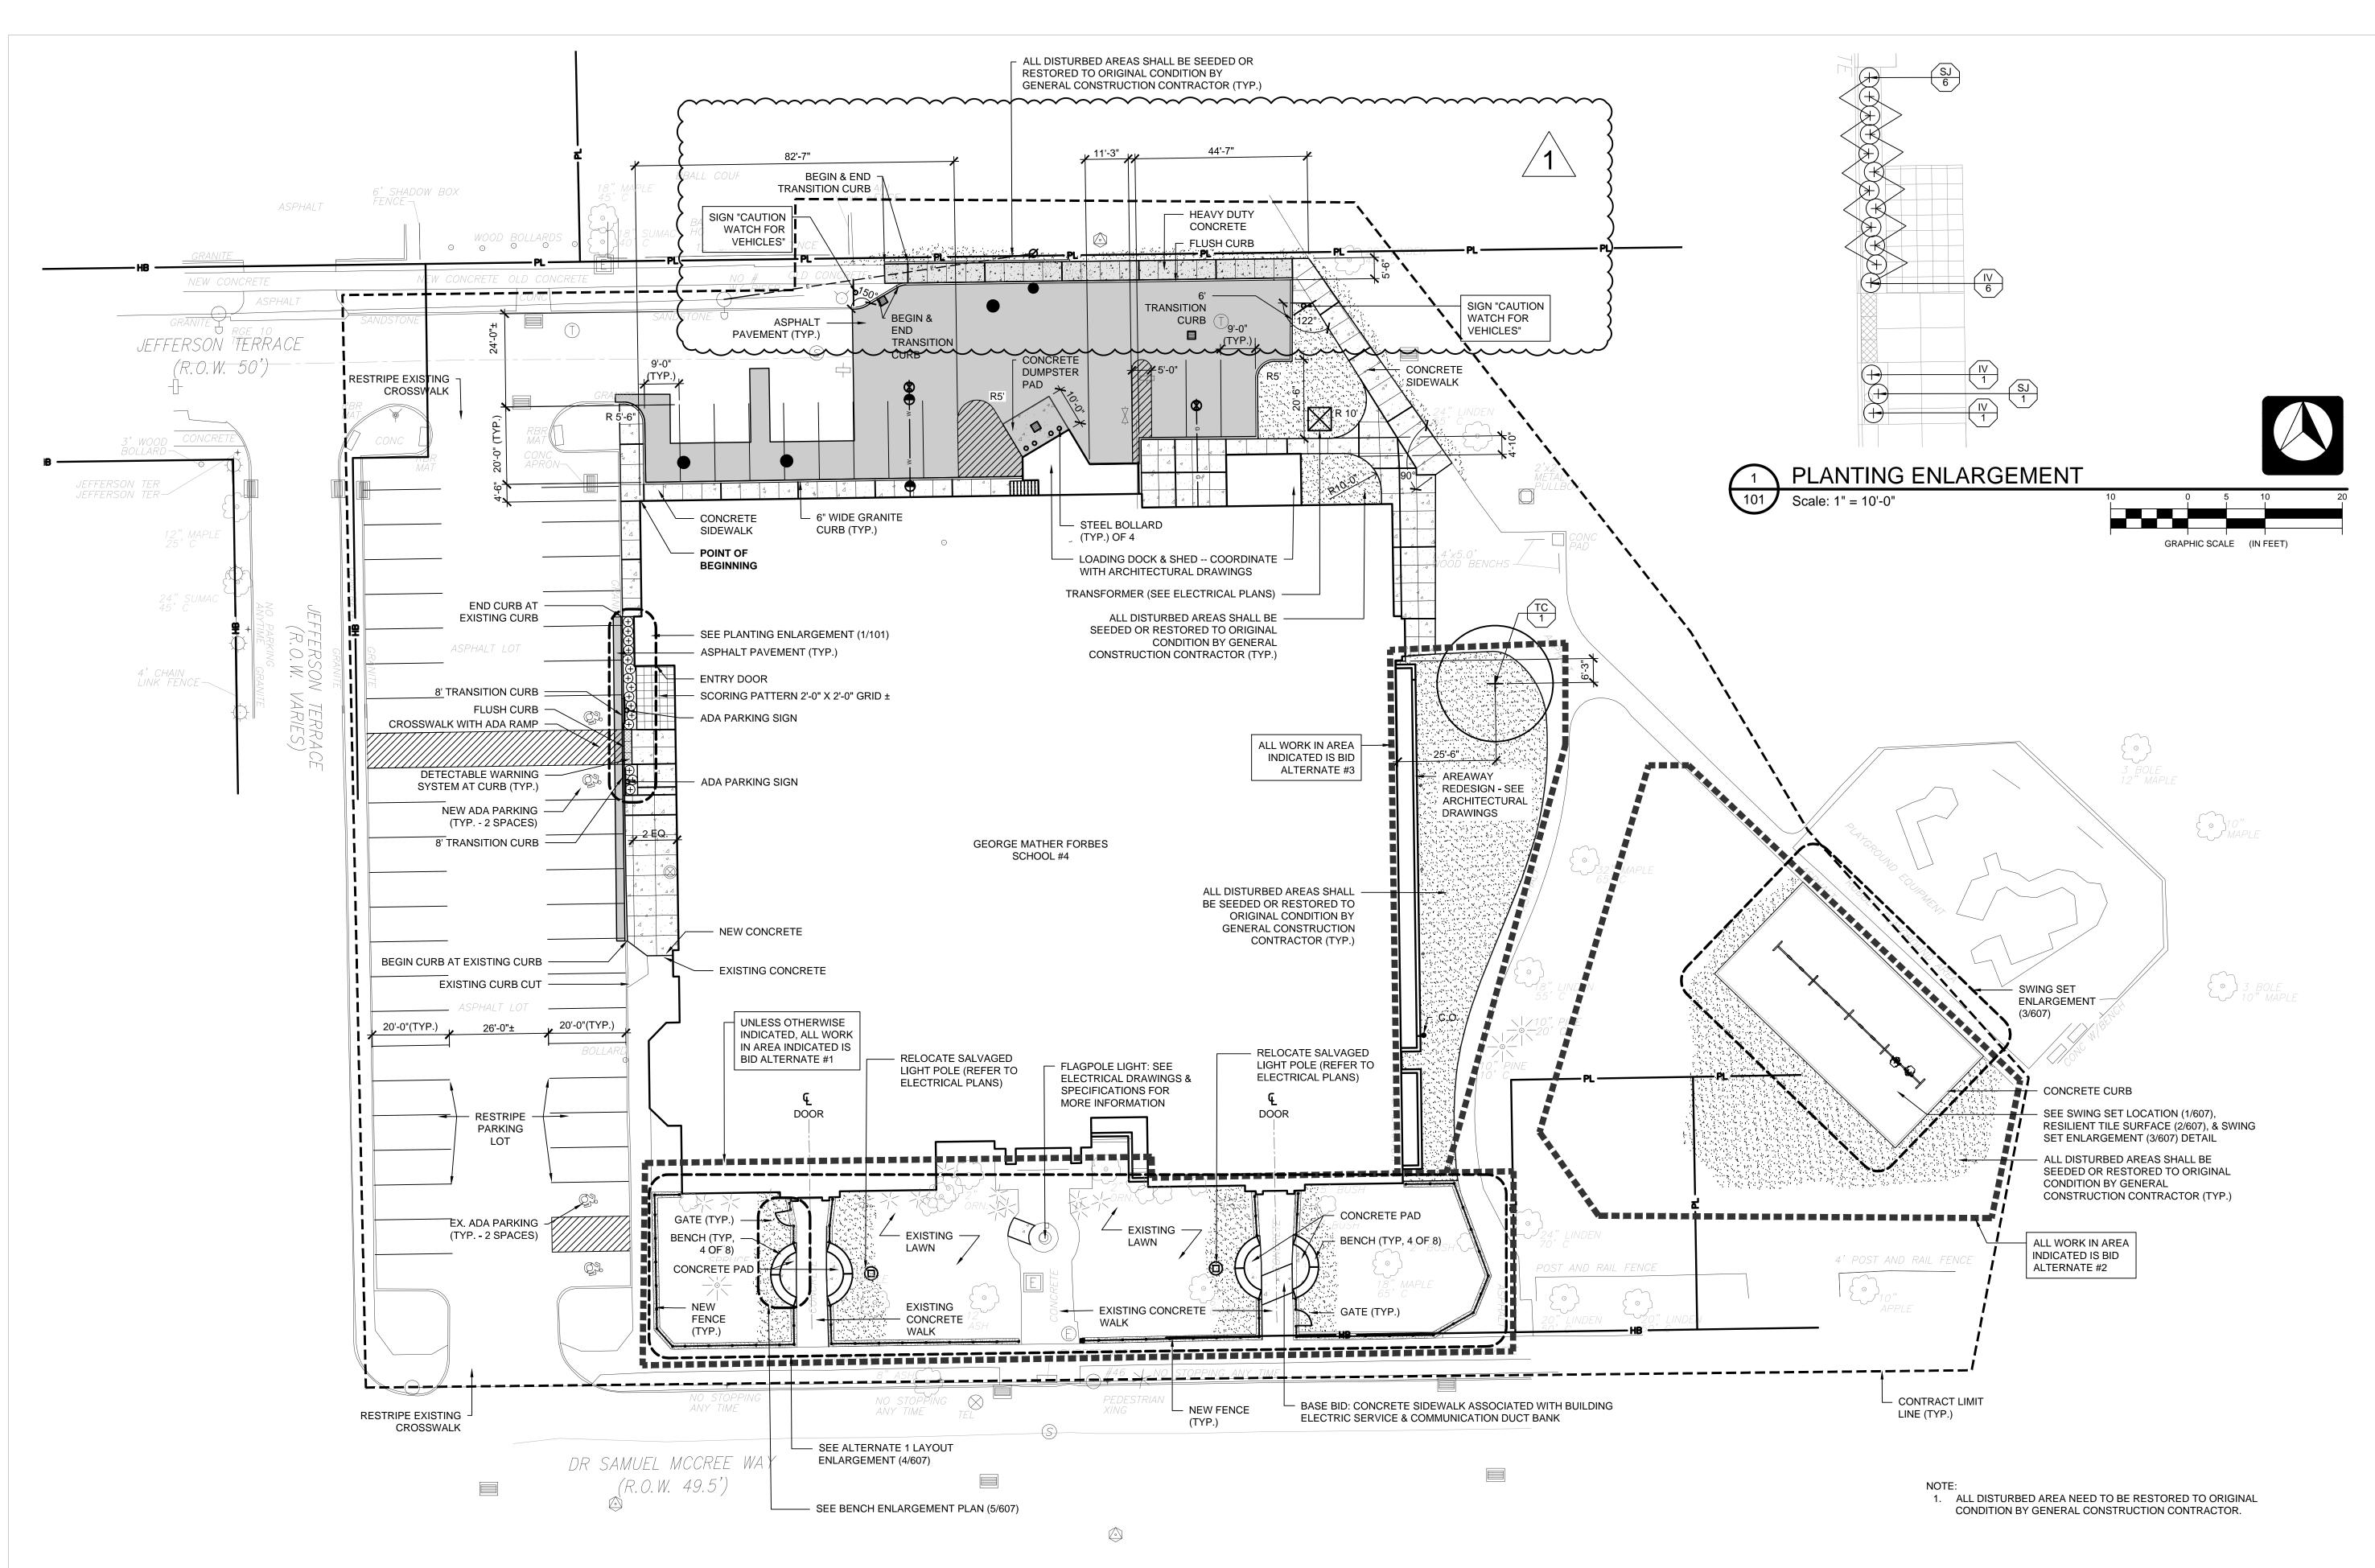

	PLANT LIST - TREES			
KEY	BOTANICAL NAME	COMMON NAME	ROOT	COMMENTS
IV	ITEA VIRGINICA 'SPRICH'	LITTLE HENRY VIRGINIA SWEETSPIRE	#3 CONTAINER	18" HT.
SJ	SPIRAEA JAPONICA 'DOUBLE PLAY RED'	DOUBLE PLAY RED SPIREA	#3 CONTAINER	18" HT.
тс	TILIA CORDATA	LITTLE LEAF LINDEN	2" CAL. B&B	

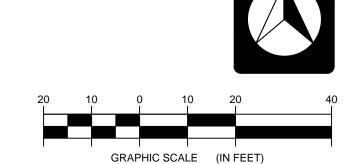






www.cjsarchitects.com





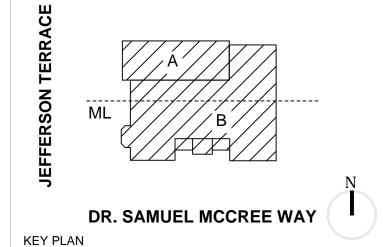

ROCHESTER SCHOOLS MODERNIZATION PROGRAM GEORGE MATHER FORBES SCHOOL NO.4

GEORGE M. FORBES - PHASE 2C

SED # 26-16-00-01-0-004-024 DWT # 26-16-00-01-7-999-020

198 Dr Samuel McCree Way, Rochester, NY 14611

REV.#	DESCRIPTION	DATE
1	ADDENDUM 1	4/25/18

JOB NO.	1711
SCALE	1" = 20'-0"
ISSUE DATE	4/9/18
DRAWN BY	CSC
CHECKED BY	SG


THIS IS A SINGLE SHEET OF A COHESIVE SET OF CONSTRUCTION DOCUMENTS (INCLUDING DRAWINGS AND SPECIFICATIONS). INTERPRETATION OF THE INFORMATION AS PRESENTED SHOULD BE BASED ON THE ENTIRE SET OF DOCUMENTS.

DRAWING TITLE

SITE & PLANTING PLAN

C-101


ISSUED FOR BIDDING

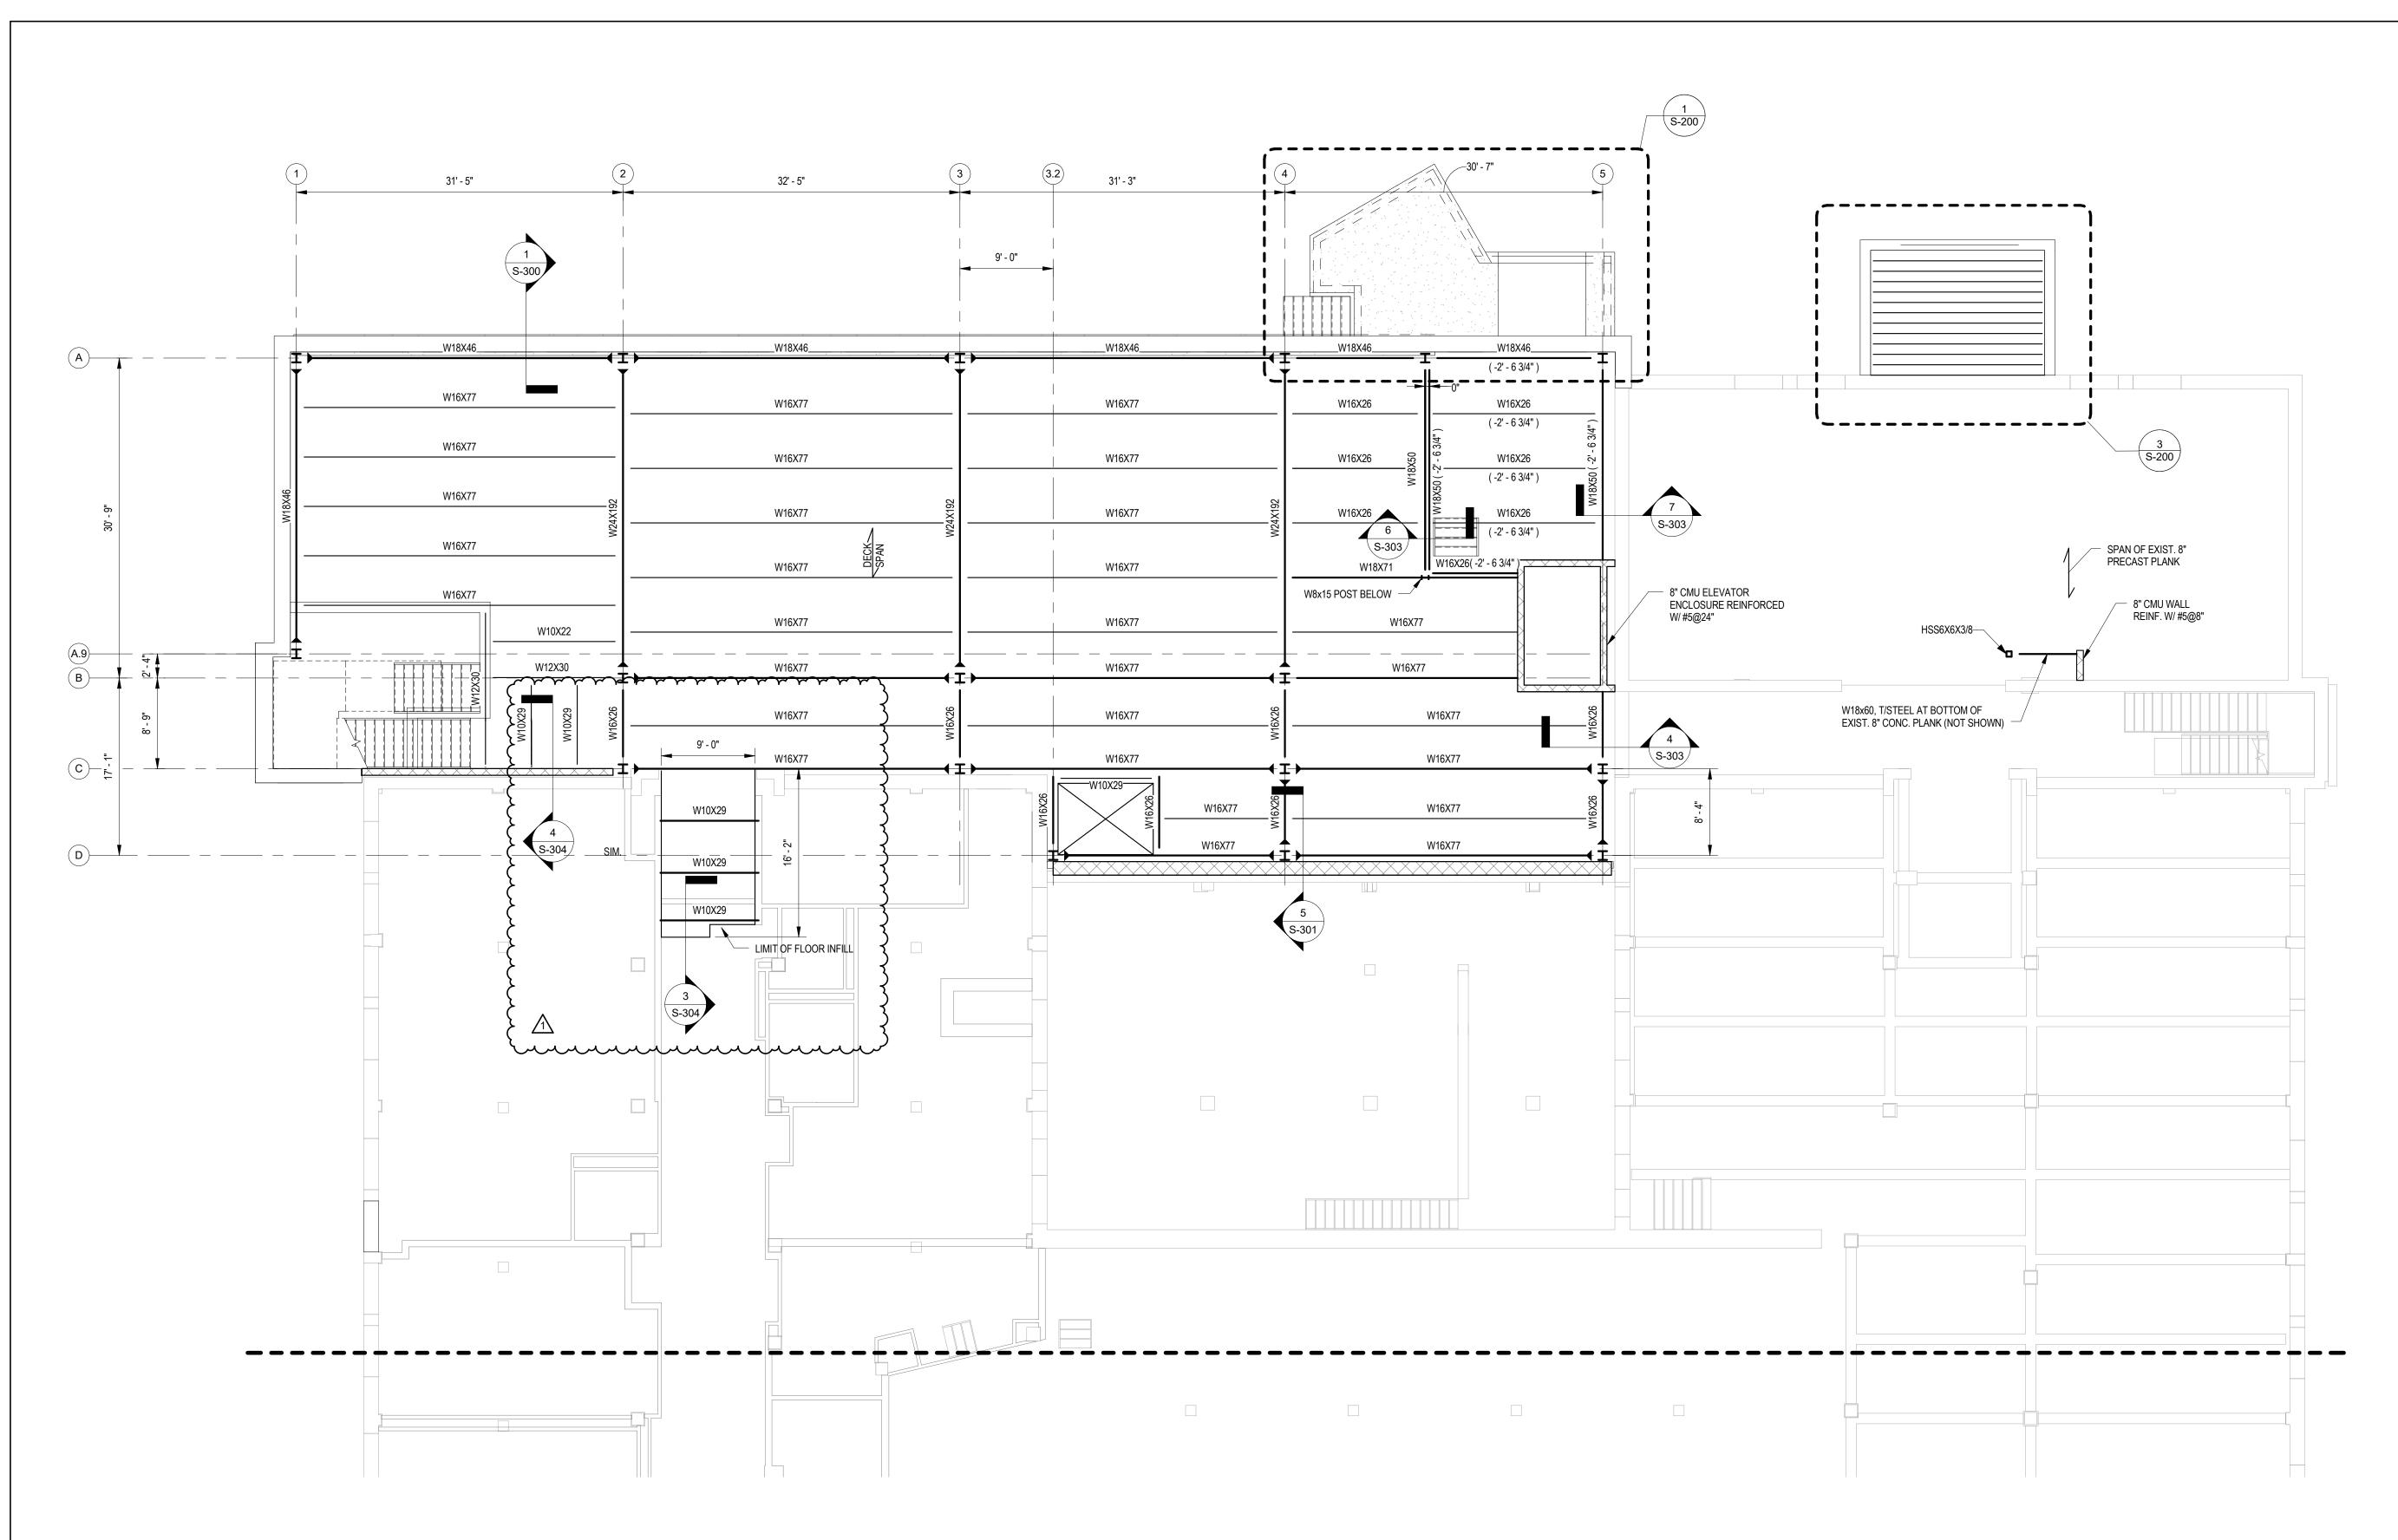

### NOTES:

- 1. REFERENCE ELEVATION = 0'-0" (548.30')= FINISHED FIRST FLOOR ELEVATION AT ADDITION.
- 2. T/STEEL ELEV. = -0'-4" (547.86') UNLESS NOTED OTHERWISE.
- 3. FLOOR SLAB SHALL CONSIST OF 2" DEEP G60 GALVANIZED COMPOSITE STEEL DECK, DESIGN THICKNESS 0.0358 INCH (20 GAUGE), (TYPE 2VLI20 BY VULCRAFT OR APPROVED EQUAL) WITH 3-1/4 INCH THICK, 3,000 PSI, LIGHTWEIGHT CONCRETE TOPPING (TOTAL THICKNESS= 5-1/4 INCHES) REINFORCED WITH 6x^-W1.4xW1.4 WWF. FLOOR SLAB SHALL PROVIDE 2 HR FIRE-RESISTANCE RATING, REFERENCE U.L. DESIGN NO. D902 FOR ASSEMBLY INFORMATION.
- 4. DENOTES MOMENT CONNECTION MOMENT CONNECTIONS, REFER TO DETAILS ON S-401.
- 5. COORDINATE FINAL TOP OF SLAB AND TOP OF STEEL ELEVATIONS WITH EXISTING CORRIDOR FLOOR SLABS.
- 6. CONTRACTOR TO FIELD VERIFY ALL DIMENSIONS AT EXISTING CONSTRUCTION.
- 7. CONTRACTOR AND CONTRACTOR'S ENGINEER SHALL DESIGN AND INSTALL TEMPORARY SHORING SYSTEM TO SUPPORT EXISTING BUILDING COMPONENTS DURING CONSTRUCTION.


1 FIRST FLOOR FRAMING PLAN \$-102.1 1/8" = 1'-0"

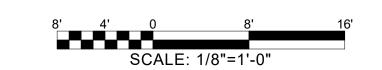







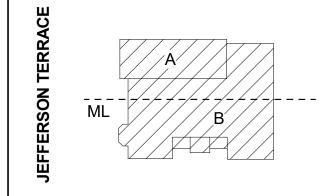

# DR. SAMUEL MCCREE WAY KEY PLAN

SED # 26-16-00-01-0-004-024 DWT SED # 26-16-00-01-7-999-020

-Phase 2c George M. Forbes- Renovation, Alterations and Addition

Rochester Schools Modernization Program

198 Dr Samuel McCree Way, Rochester, NY 14611

REV#	DESCRIPTION	DATE
1	ADDENDA #1	4/25/2018


JOB NO.	1711
SCALE	As indicated
ISSUE DATE	4/9/18
DRAWN BY	SNP
CHECKED BY	MNW
THIS IS A SINICLE SHEET OF A COHESIVE	

THIS IS A SINGLE SHEET OF A COHESIVE SET OF CONSTRUCTION DOCUMENTS (INCLUDING DRAWINGS AND SPECIFICATIONS). INTERPRETATION OF THE INFORMATION AS PRESENTED SHOULD BE BASED ON THE ENTIRE SET OF DOCUMENTS.

DRAWING TITLE


FIRST FLOOR FRAMING PLAN

S-102.1

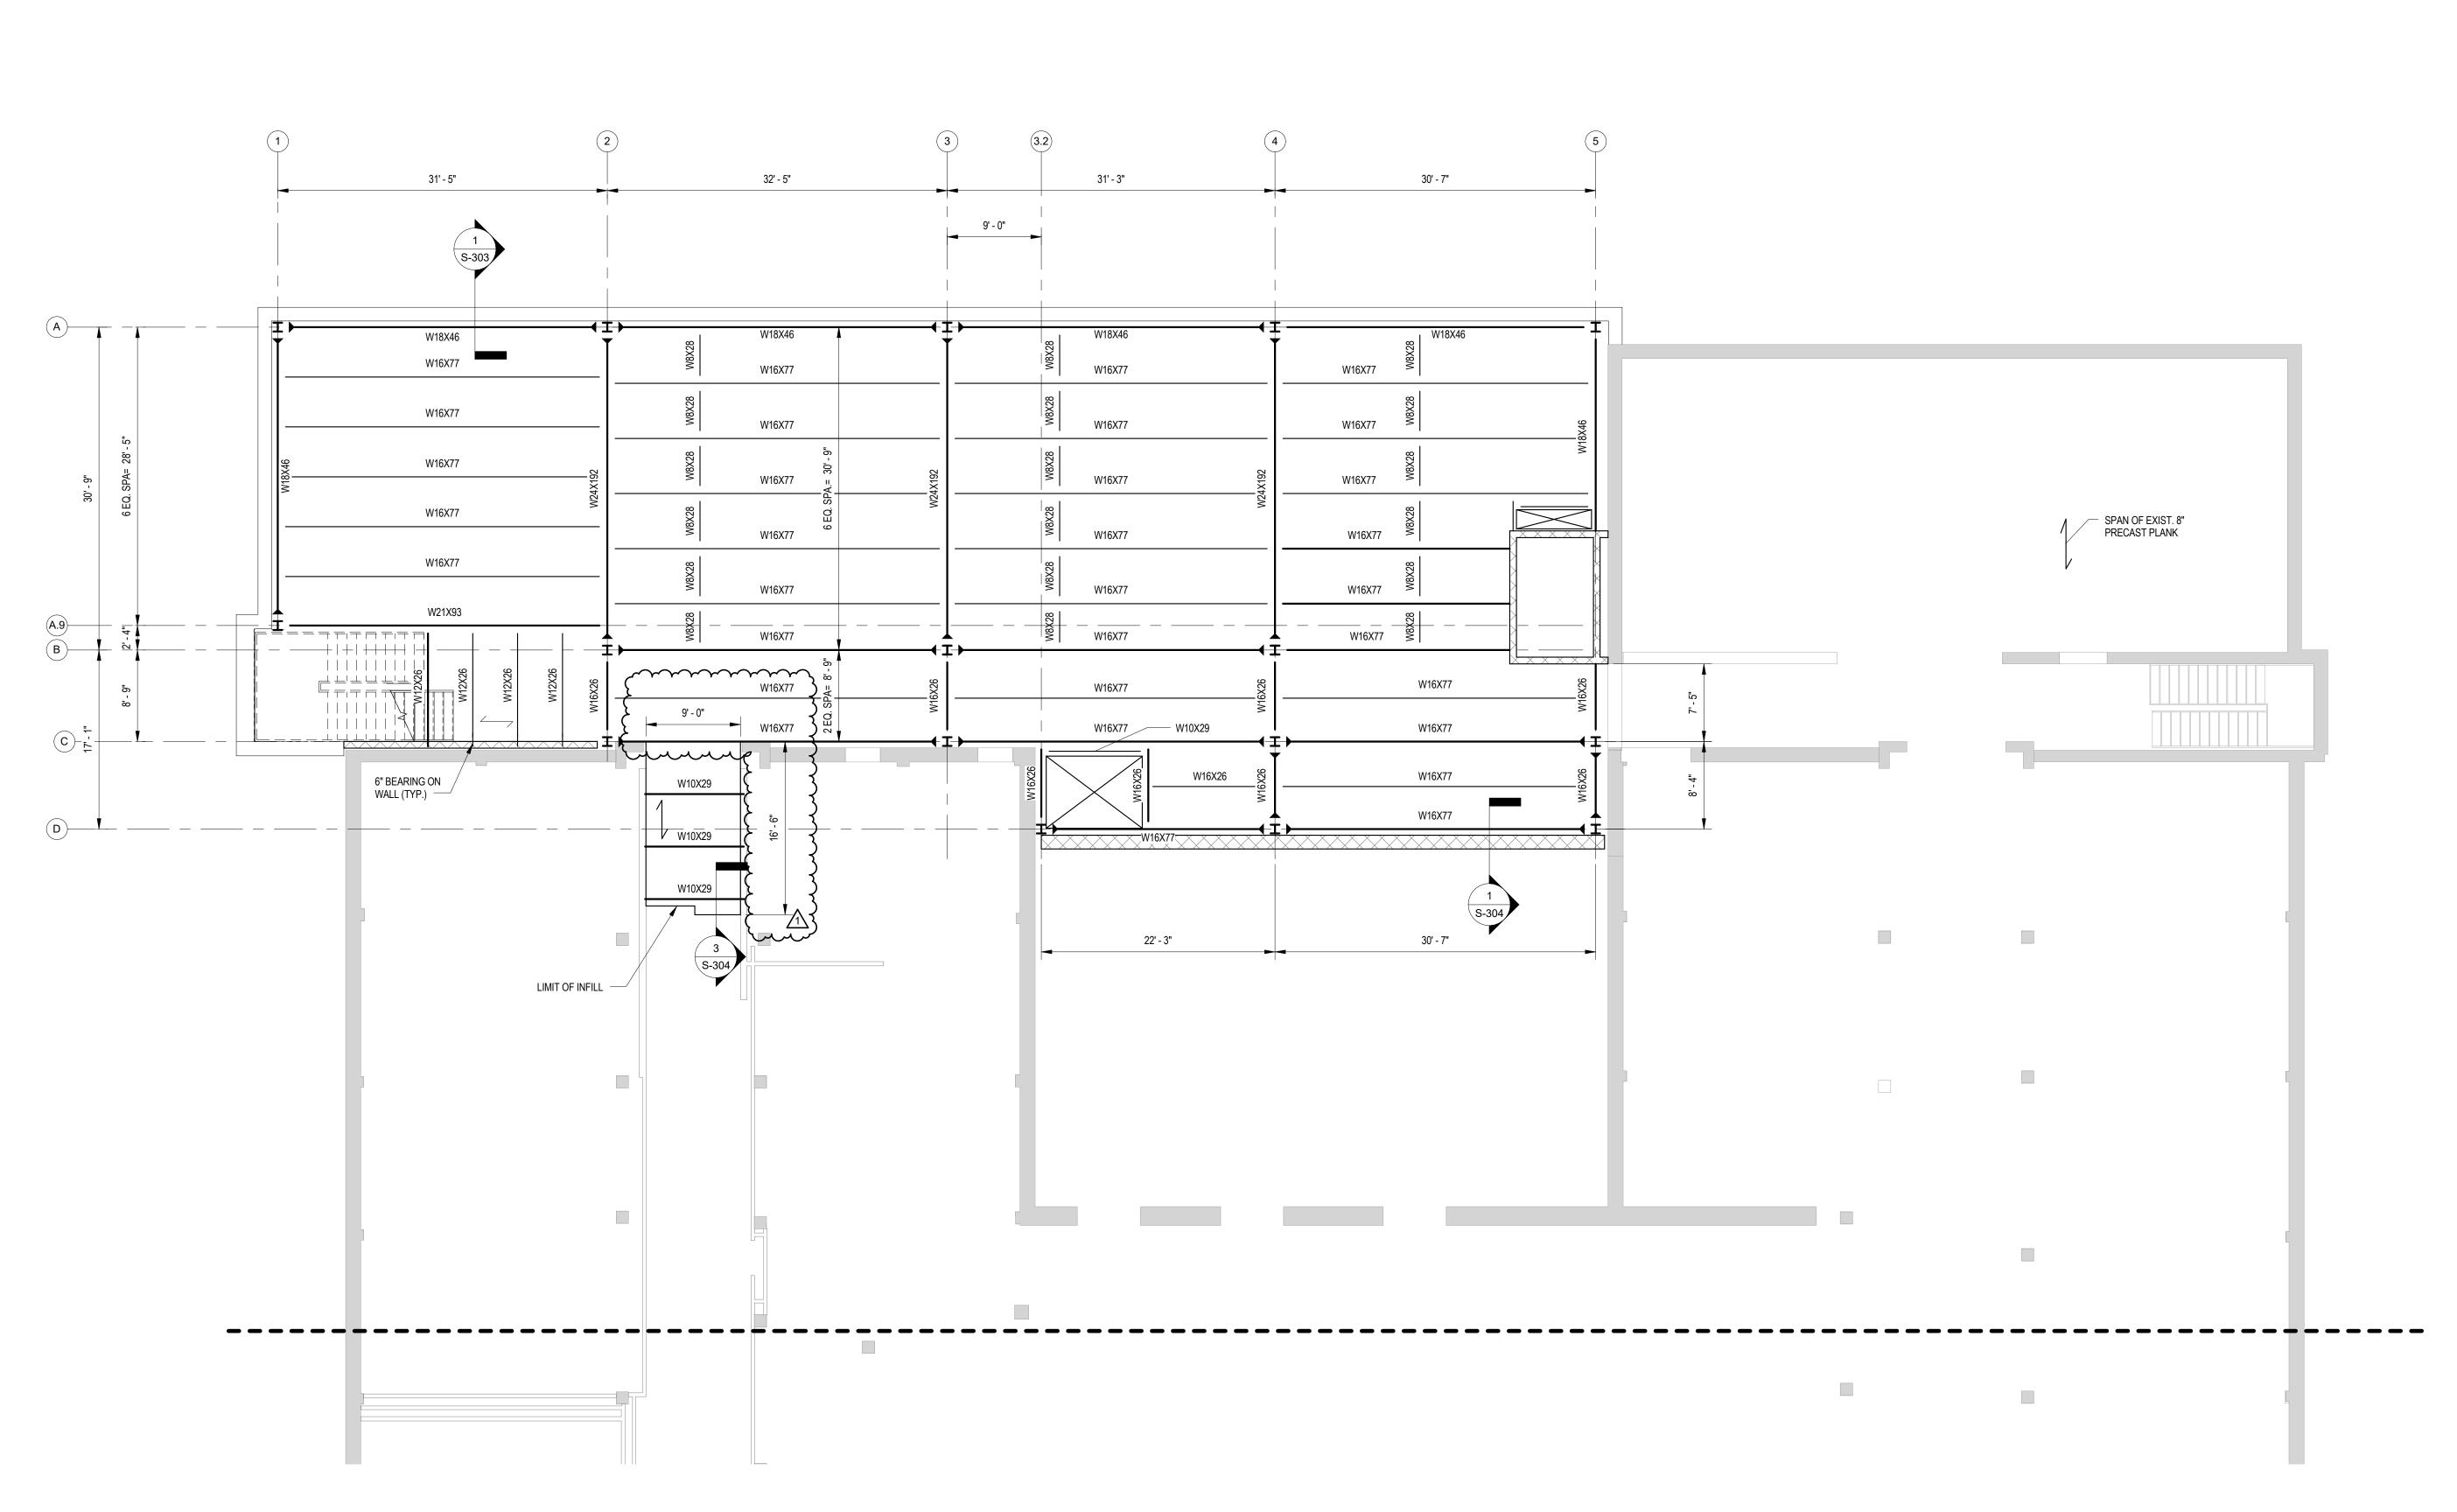

## NOTES:


- REFERENCE ELEVATION = 0'-0" (548.30')= FINISHED FIRST FLOOR ELEVATION AT ADDITION.
- T/STEEL ELEV. = +13'-1 3/4" (561.45') UNLESS NOTED OTHERWISE.
- 3. FLOOR SLAB SHALL CONSIST OF 2" DEEP G60 GALVANIZED COMPOSITE STEEL DECK, DESIGN THICKNESS 0.0358 INCH (20 GAUGE), (TYPE 2VLI20 BY VULCRAFT OR APPROVED EQUAL) WITH 3-1/4 INCH THICK, 3,000 PSI, LIGHTWEIGHT CONCRETE TOPPING (TOTAL THICKNESS= 5-1/4 INCHES) REINFORCED WITH 6x6-W1.4xW1.4 WWF. FLOOR SLAB SHALL PROVIDE 2 HR FIRE-RESISTANCE RATING, REFERENCE U.L. DESIGN NO. D902 FOR ASSEMBLY INFORMATION.
- 4. DENOTES MOMENT CONNECTION. REFER TO DETAILS ON S-401.
- 5. COORDINATE FINAL TOP OF SLAB AND TOP OF STEEL ELEVATIONS WITH EXISTING CORRIDOR FLOOR SLABS.
- 6. CONTRACTOR TO FIELD VERIFY ALL DIMENSIONS AT EXISTING CONSTRUCTION.

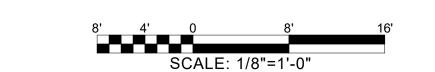







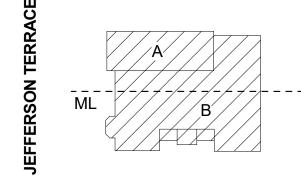

DR. SAMUEL MCCREE WAY

KEY PLAN

SED # 26-16-00-01-0-004-024 DWT SED # 26-16-00-01-7-999-020

Rochester Schools Modernization Program
-Phase 2c
George M. Forbes- Renovation, Alterations

and Addition

198 Dr Samuel McCree Way, Rochester, NY 14611

REV#	DESCRIPTION	DATE
1	ADDENDA #1	4/25/2018


JOB NO.	1711
SCALE	As indicated
ISSUE DATE	4/9/18
DRAWN BY	SNP
CHECKED BY	MNW

THIS IS A SINGLE SHEET OF A COHESIVE SET OF CONSTRUCTION DOCUMENTS (INCLUDING DRAWINGS AND SPECIFICATIONS). INTERPRETATION OF THE INFORMATION AS PRESENTED SHOULD BE BASED ON THE ENTIRE SET OF DOCUMENTS.

DRAWING TITLE

SECOND FLOOR FRAMING PLAN

S-103.1

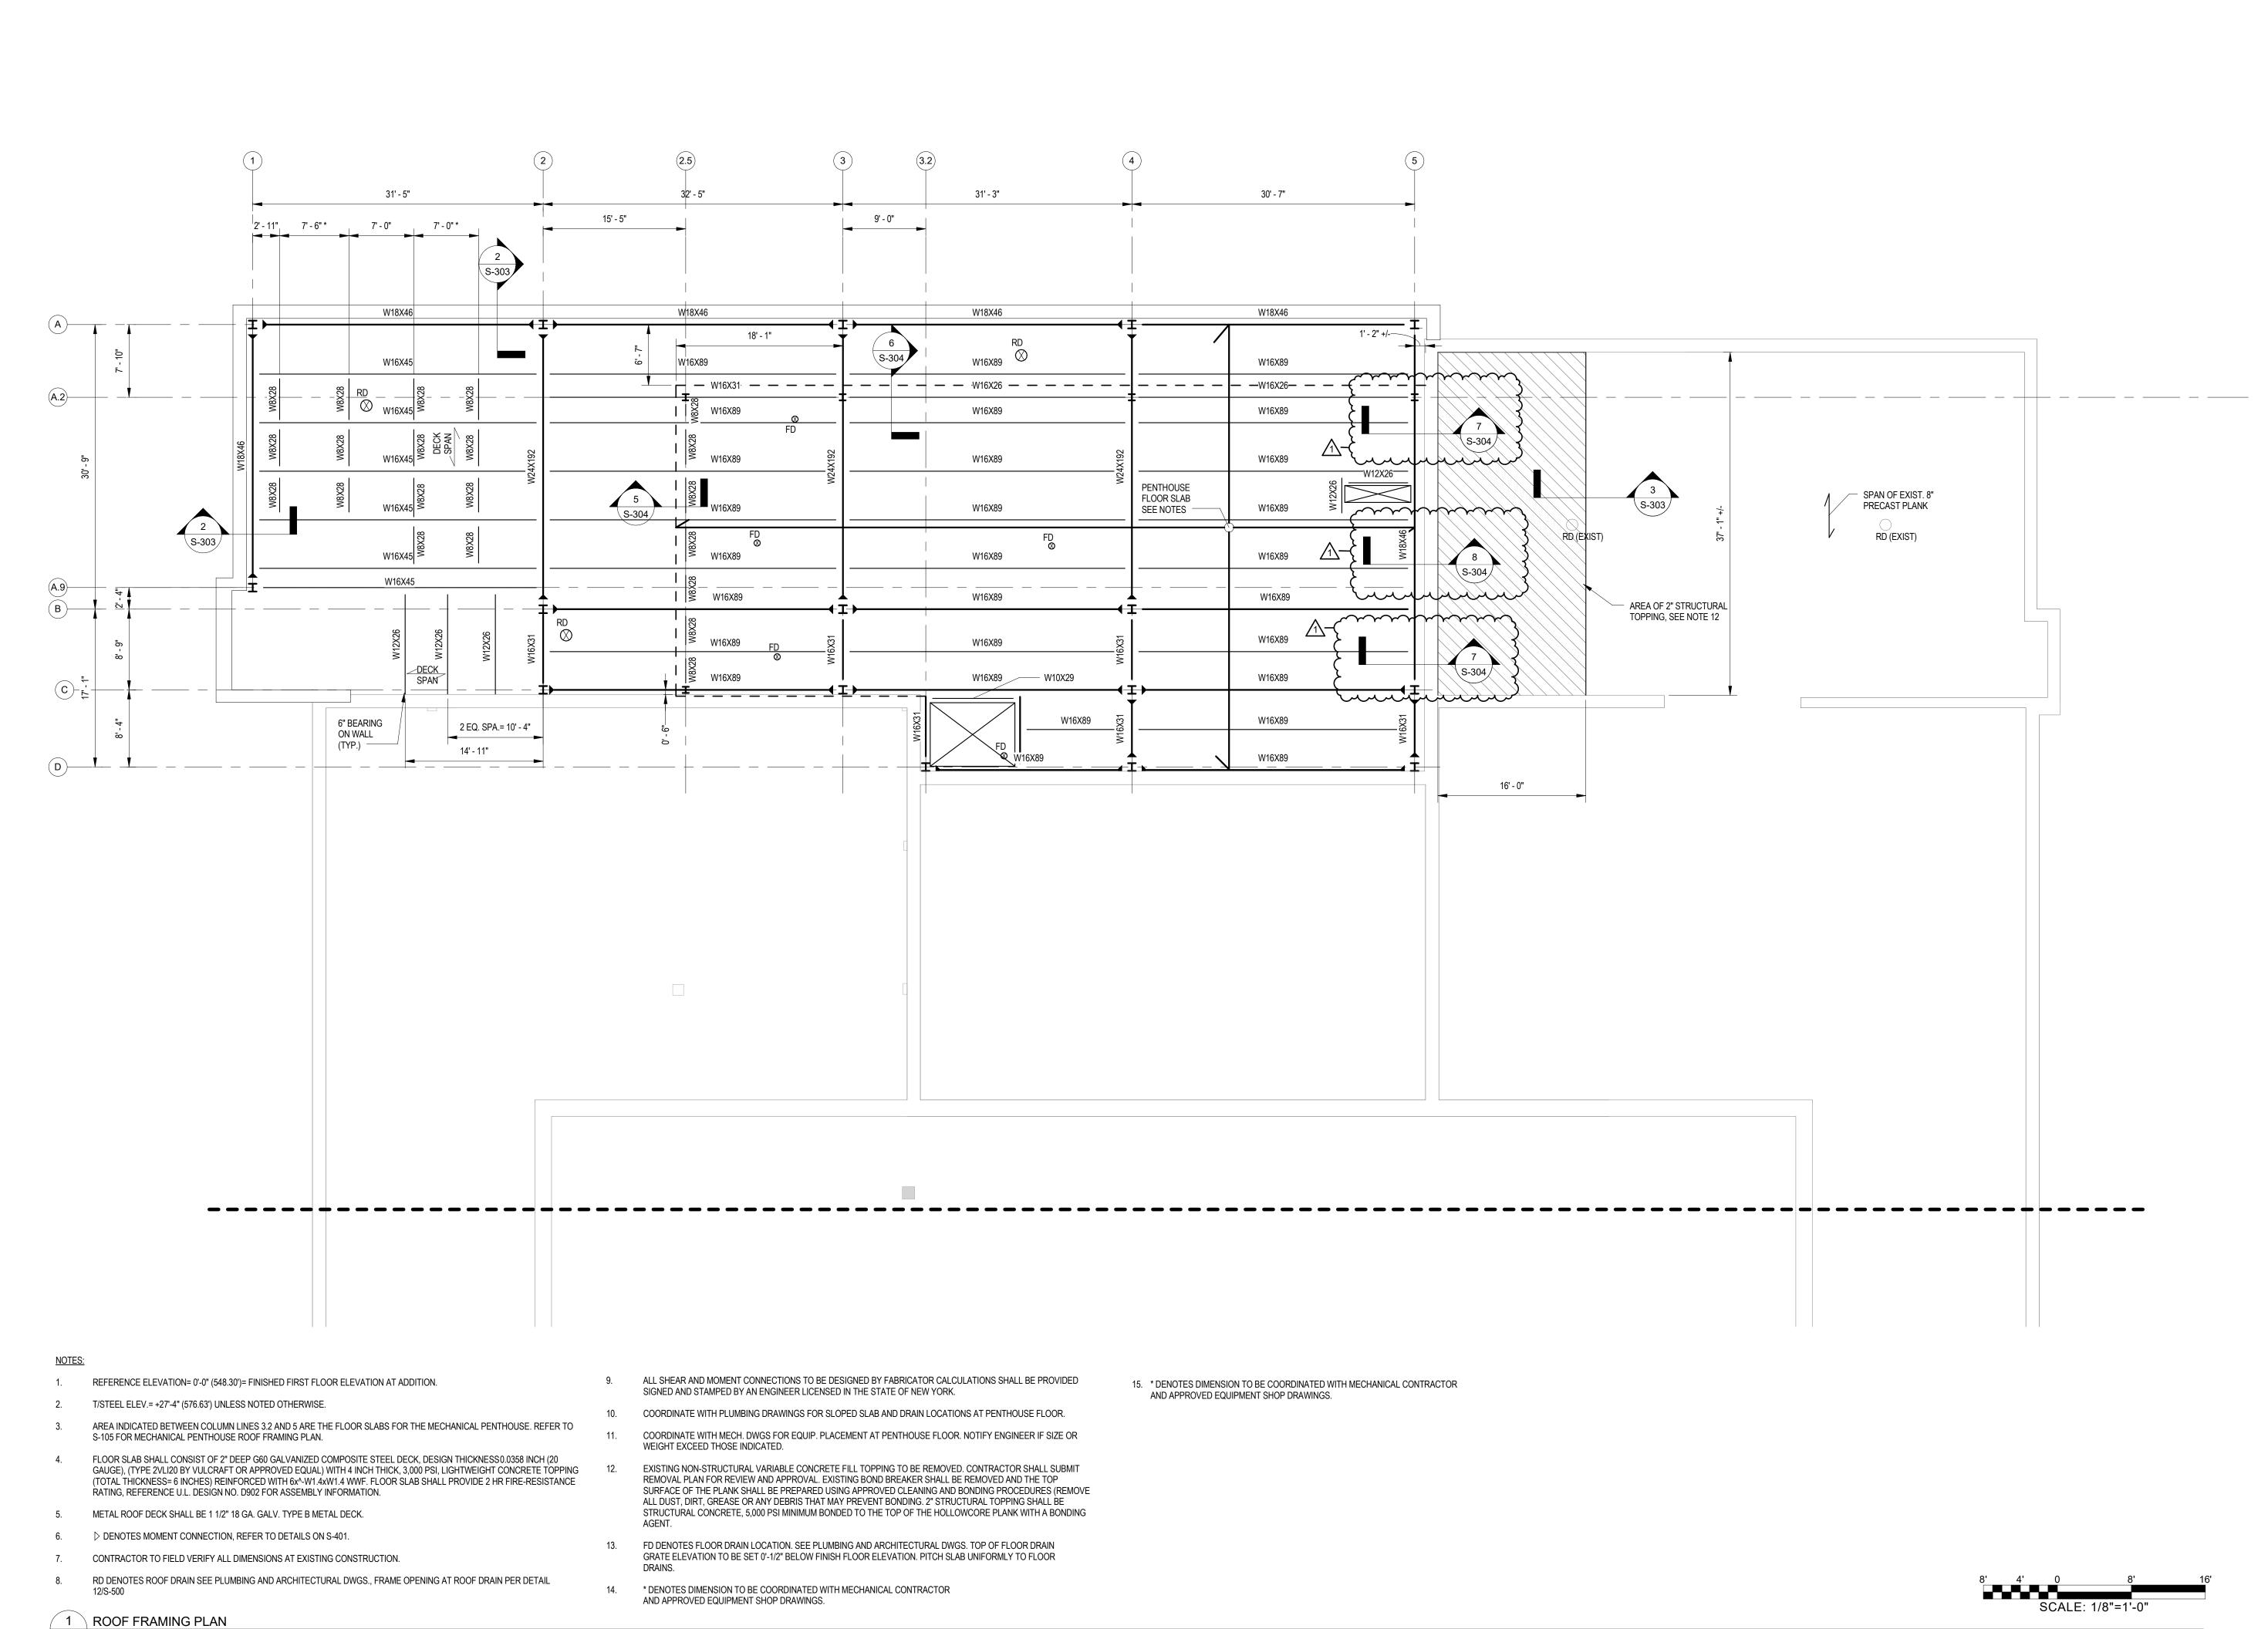


S-104.1 1/8" = 1'-0"







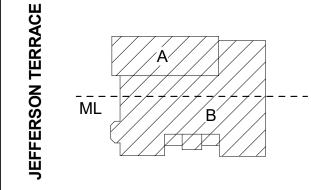

DR. SAMUEL MCCREE WAY

KEY PLAN

SED # 26-16-00-01-0-004-024 DWT SED # 26-16-00-01-7-999-020

Rochester Schools Modernization Program
-Phase 2c
George M. Forbes- Renovation, Alterations

and Addition

198 Dr Samuel McCree Way, Rochester, NY 14611

REV#	DESCRIPTION	DATE
1	ADDENDA #1	4/25/2018


	JOB NO.	1711
-;	SCALE	As indicated
-	SSUE DATE	4/9/18
Ī	DRAWN BY	SNP
	CHECKED BY	MNW
_		


THIS IS A SINGLE SHEET OF A COHESIVE SET OF CONSTRUCTION DOCUMENTS (INCLUDING DRAWINGS AND SPECIFICATIONS). INTERPRETATION OF THE INFORMATION AS PRESENTED SHOULD BE BASED ON THE ENTIRE SET OF DOCUMENTS.


DRAWING TITLE


ROOF FRAMING PLAN

S-104.1

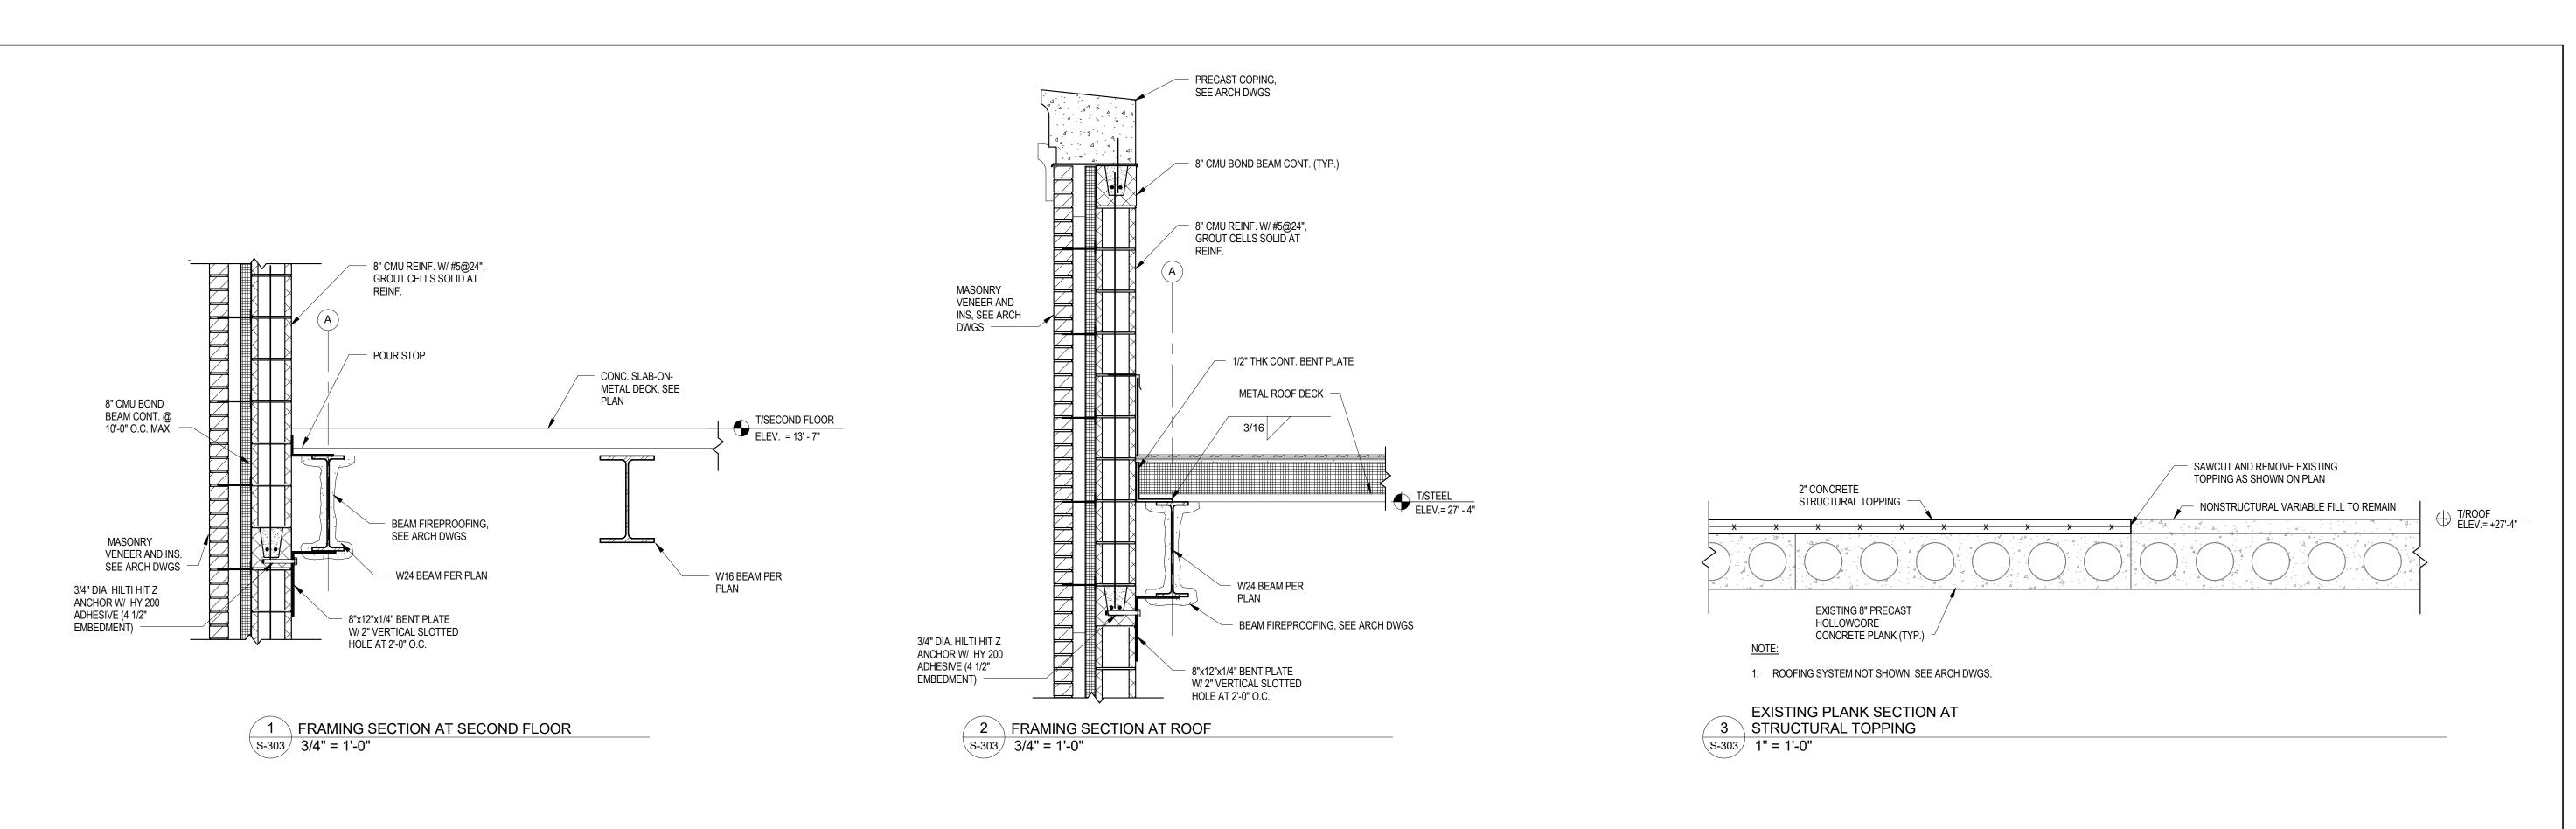

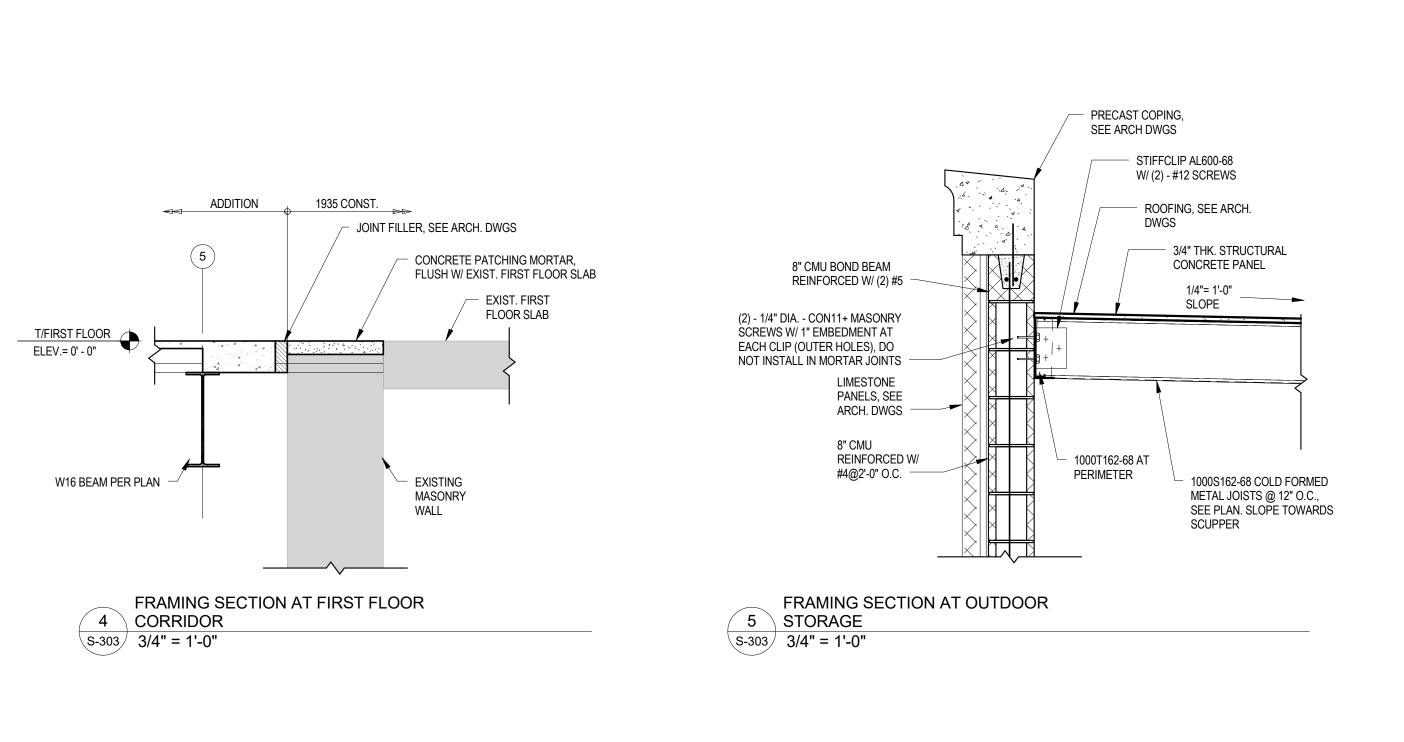


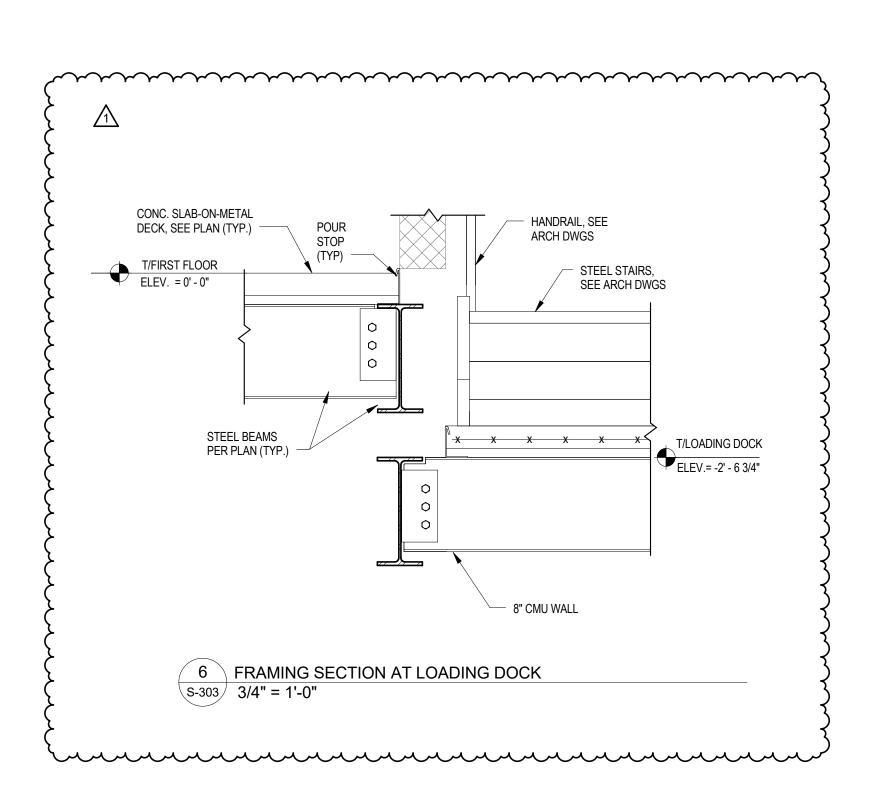


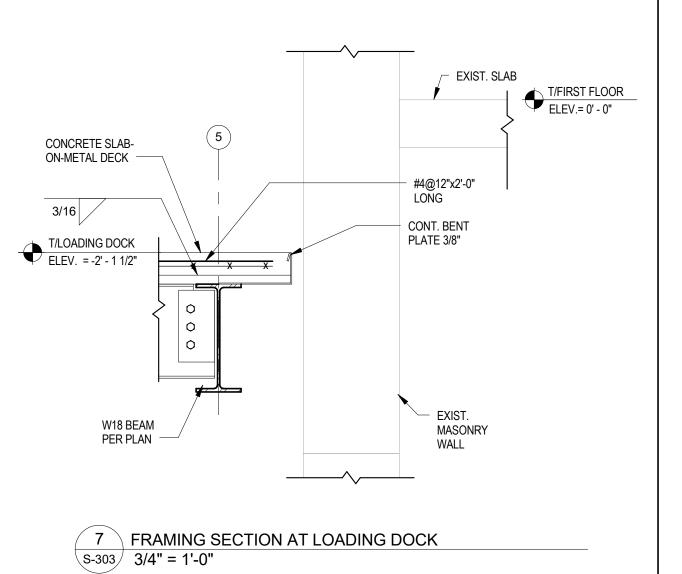





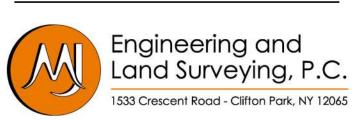

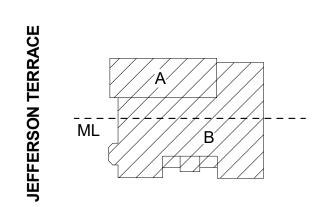

# DR. SAMUEL MCCREE WAY KEY PLAN

SED # 26-16-00-01-0-004-024 DWT SED # 26-16-00-01-7-999-020

Rochester Schools Modernization Program
-Phase 2c
George M. Forbes- Renovation, Alterations

eorge M. Forbes- Renovation, Alteration and Addition

198 Dr Samuel McCree Way, Rochester, NY 14611

REV#	DESCRIPTION	DATE
1	ADDENDA #1	4/25/2018


JOB NO.	1711		
SCALE	As indicated		
ISSUE DATE	4/9/18		
DRAWN BY	SNP		
CHECKED BY	MNW		
THIS IS A SINGLE SHEET OF A COHESIVE			

THIS IS A SINGLE SHEET OF A COHESIVE SET OF CONSTRUCTION DOCUMENTS (INCLUDING DRAWINGS AND SPECIFICATIONS). INTERPRETATION OF THE INFORMATION AS PRESENTED SHOULD BE BASED ON THE ENTIRE SET OF DOCUMENTS.


DRAWING TITLE

FRAMING SECTIONS

**S-303** 

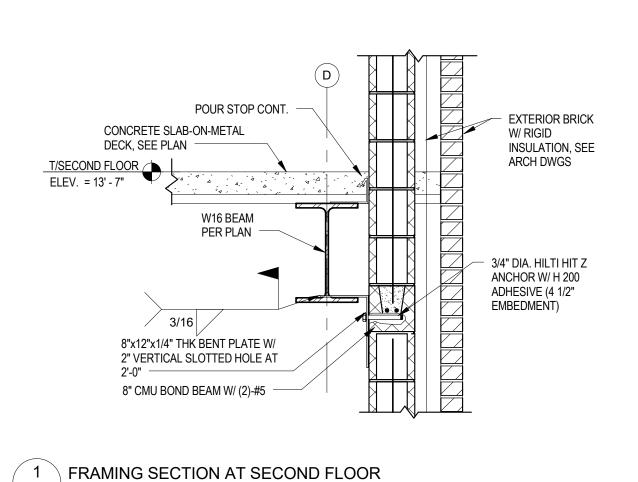

S-304 3/4" = 1'-0"

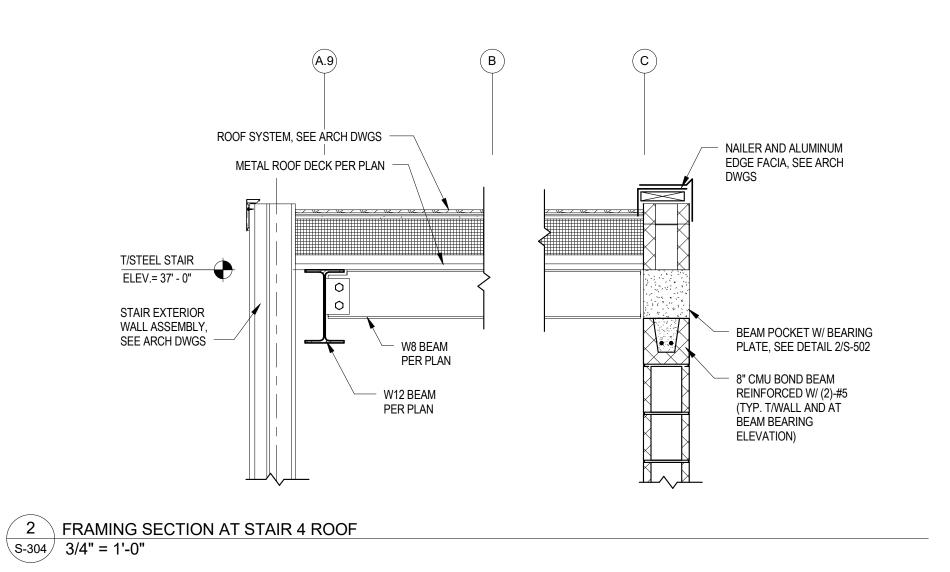

8" WIDEx1'-0" HIGH CONC.

CURB, TYP. AT PERIMETER OF

PENTHOUSE FLOOR SLAB

ROUGHEN CONCRETE TO 1/4"

AMPLITUDE BENEATH CURB

6" THK CONC. SLAB-ON-METAL

PENTHOUSE FLOOR
ELEV.= 27' - 10"

DECK, SEE PLAN

W8 BEAM,

SEE PLAN

1' - 1"

FRAMING SECTION AT PENTHOUSE

PENTHOUSE EXTERIOR

(2)-#4 CONT.

2'-0" #4@12"

WALL ASSEMBLY, SEE

ARCH DWGS

ROOFING SYSTEM,


SEE ARCH DWGS

5 FLOOR


S-304 3/4" = 1'-0"


METAL ROOF

DECK, SEE PLAN -

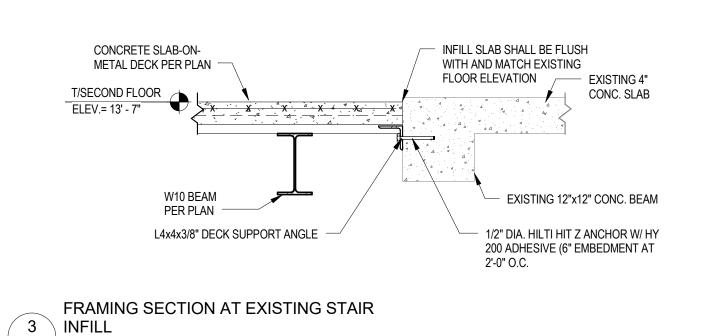



s-304 3/4" = 1'-0"

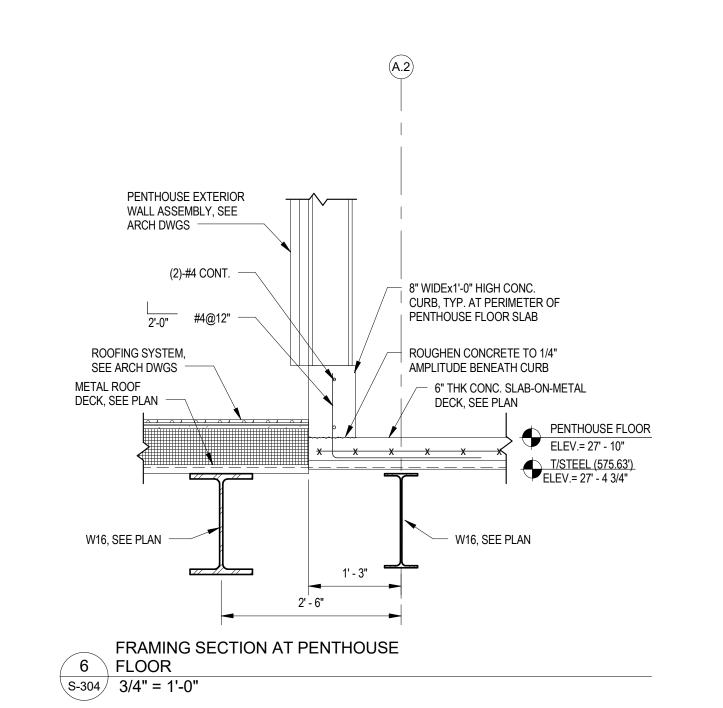


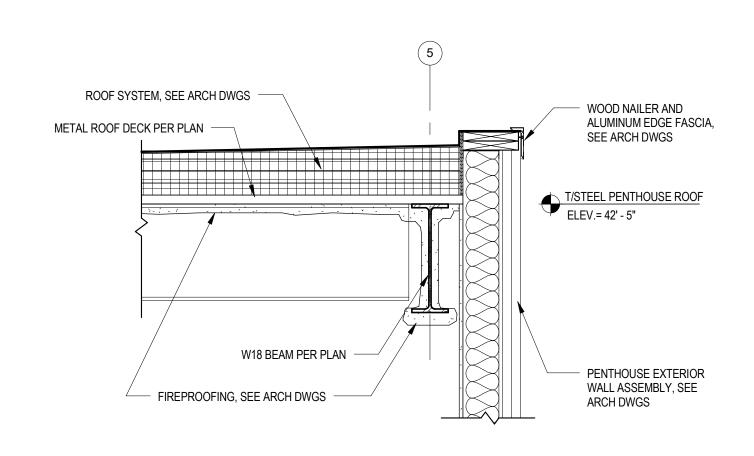



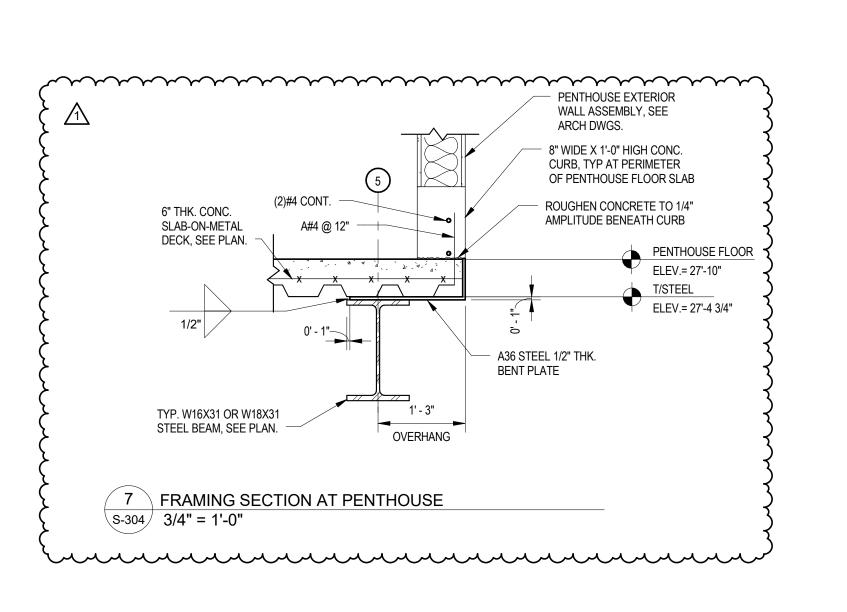


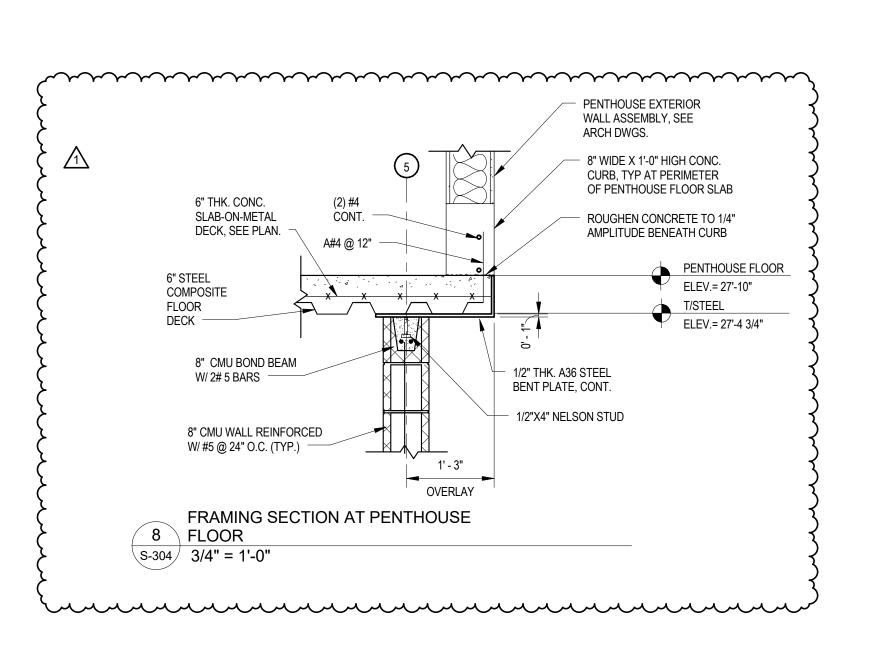


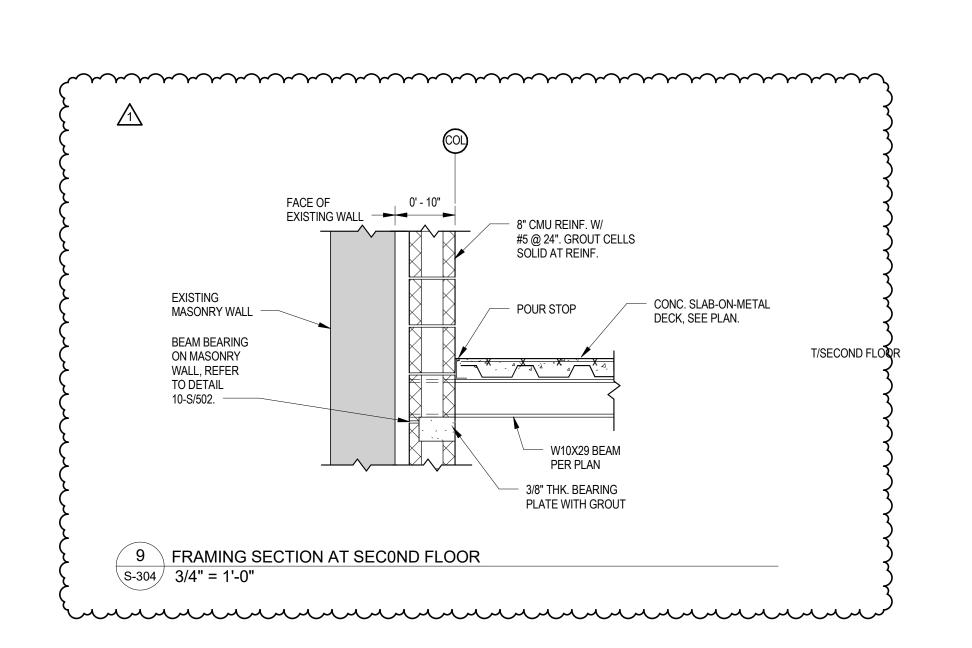





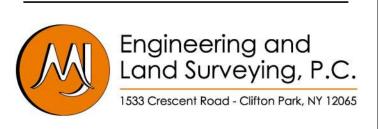

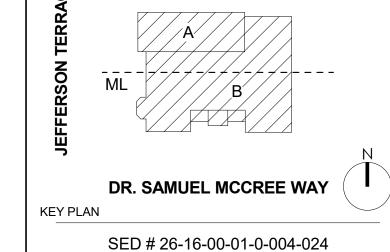

DWT SED #
26-16-00-01-7-999-020

Rochester Schools Modernization Program

-Phase 2c

George M. Forbes- Renovation, Alterations and Addition

198 Dr Samuel McCree Way, Rochester, NY 14611

REV#	DESCRIPTION	DATE
1	ADDENDA #1	4/25/2018

JOB NO.	171
SCALE	3/4" = 1'-0
ISSUE DATE	4/9/18
DRAWN BY	SNF
CHECKED BY	MNW
THIS IS A SINGLE SHEET OF A COHESIVE SET OF CONSTRUCTION DOCUMENTS (INCLUDING DRAWINGS AND SPECIFICATIONS). INTERPRETATION OF THE INFORMATION	

SET OF CONSTRUCTION DOCUMENTS
(INCLUDING DRAWINGS AND SPECIFICATION
INTERPRETATION OF THE INFORMATION
AS PRESENTED SHOULD BE BASED ON
THE ENTIRE SET OF DOCUMENTS.

DRAWING TITLE

FRAMING SECTIONS

**S-304** 


STEEL LINTEL SCHEDULE					
WALL	MAS	ONRY OPENING WIDT	Ή		
THICKNESS AND TYPE	UP TO 4'-0" 4" BRG. EA. END	4'-0" TO 8'-0" 6" BRG. EA. END	8'-1" TO 12'-0" 8" BRG. EA. END		
4" - WALL A (30psf)	L3 1/2x3 1/2x3/8	L3 1/2x5x3/8 LLV	L7x4x3/8 LLV		
8" - WALL D (60psf)	2 LL3 1/2x3 1/2x3/8	2 Ц4х3 1/2х3/8 LLV	W8x15 & 1 3/16 3@12 1/4x7 1/2		
12" - WALL D (90psf)	2 IL5x3 1/2x3/8 LLH	2 Ц5х5х3/8	<u>I</u> 3/16 3@12 W8x18 & □ 1/4x11 1/2		
14" - WALL D (105psf)	2 년5x3 1/2x3/8 LLH	<b>I</b> 3/16 3@12 W8x18 & □ 1/4x11 1/2	<b>→</b> 3/16 3@12 W10x39 & □ 1/4x11 1/2		


WALL A	WALL B	WALL C	WALL D
OIN		MALLO A O D ADE EO	ם ווסר

SINGLE ANGLE LINTELS, WALLS A & B ARE FOR USE WHERE ONLY ONE FACE OF WALL IS IN A FINISHED AREA.

### LINTEL NOTES:

- TABLE INDICATES STEEL LINTELS FOR NON-LOAD BEARING MASONRY WALLS. WEIGHT OF MAS. UNITS, AS SHOWN IN TABLE, IS POUNDS PER SQUARE FOOT OF FACE AREA OF WYTHE INDICATED.
- 2. FOR GREATER WYTHES, HEAVIER MATERIALS, BEARING WALLS AND LARGER OPENINGS, SEE STRUCT. DWGS.
- 3. IF NO LINTEL NOTED ON STRUCT. DWGS, USE ABOVE SCHEDULE. SEE ARCH., STRUCT., MECH. & ELEC. DWGS FOR LOCATION OF OPENINGS
- 4. ALL EXTERIOR LINTELS TO BE GALVANIZED PRIOR TO PAINTING.
- 5. GROUT CORES IN MASONRY WALL FOR 16" BELOW LINTELS, MIN.
- 6. WELD TOGETHER BACK-TO-BACK LINTELS.
- 7. DO NOT LOCATE CONTROL OR EXP. JOINTS ABOVE LENGTH OF LINTEL.
- 8. LINTELS ARE NOT REQUIRED FOR PENETRATIONS WHICH DO NOT EXCEED THE FOLLOWING DIMENSION PARALLEL TO THE WALL.
  A. BRICK WALL: 8" MAX.
  B. CMU WALL: 16" MAX.
  - MULTIPLE PENETRATIONS SPACED LESS THAN 12" APART SHALL BE SUPPORTED AS A SINGLE PENETRATION CONSIDERING THE TOTAL OPENING WIDTH.

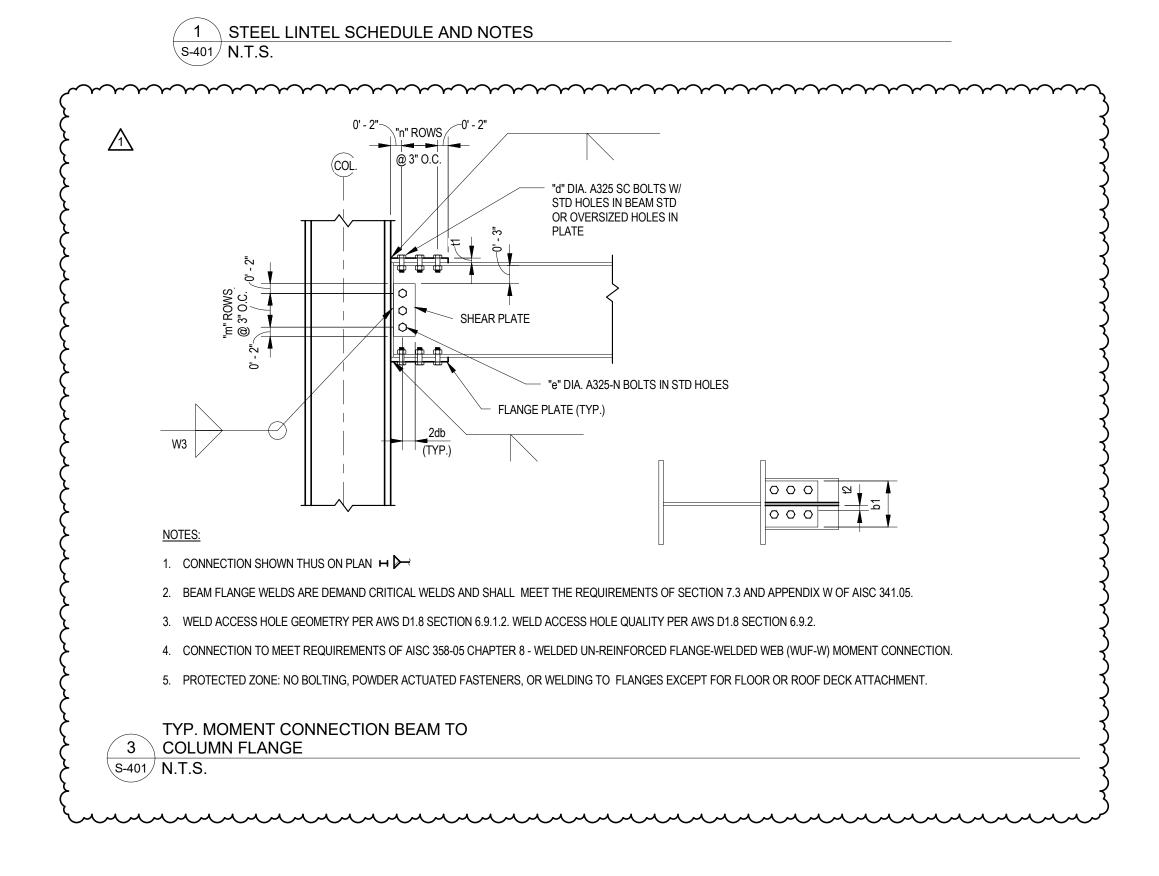

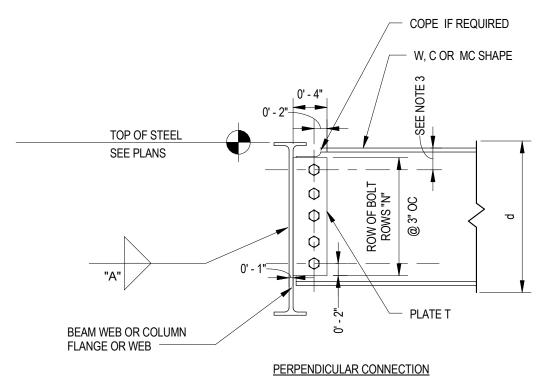


3/4" DIA BOLTS					
NOMINAL BEAM DEPTH "D"	N.O OF BOLT ROWS "N"	PLATE THICKNESS "T"	WELD SIZE "A"		
W8	2	5/16	1/4		
W10	2	5/16	1/4		
W12	3	3/8	5/16		
W14	3	3/8	5/16		
W16	3	3/8	5/16		
W18	5	3/8	5/16		
W21	6	3/8	5/16		
W24	7	3/8	5/16		

SINGLE PLATE BEAM CONNECTION SCHEDULE

### NOTES:

- 1. ALL BOLTS SHALL BE 3/4" DIA A325-N UNLESS NOTED OTHERWISE.
- 2. PROVIDE MINIMUM NUMBER OF BOLT ROWS "N" SHOWN AS THE TYPICAL CONNECTION. INCREASE NUMBER OF ROWS AND OR BOLTS DIA IF INIDICATED ON PLANS.
- 3. MINIMUM DISTANCE FROM CL OF TOP BOLT TO TOP OF STEEL SHALL BE 3". WHERE DEEP COPES ARE REQUIRED INCREASE DISTANCE FROM TOP OF BEAM TO CL OF TOP BOLT.
- 4. USE ONLY SHORT HORIZONTAL SLOTTED HOLES.



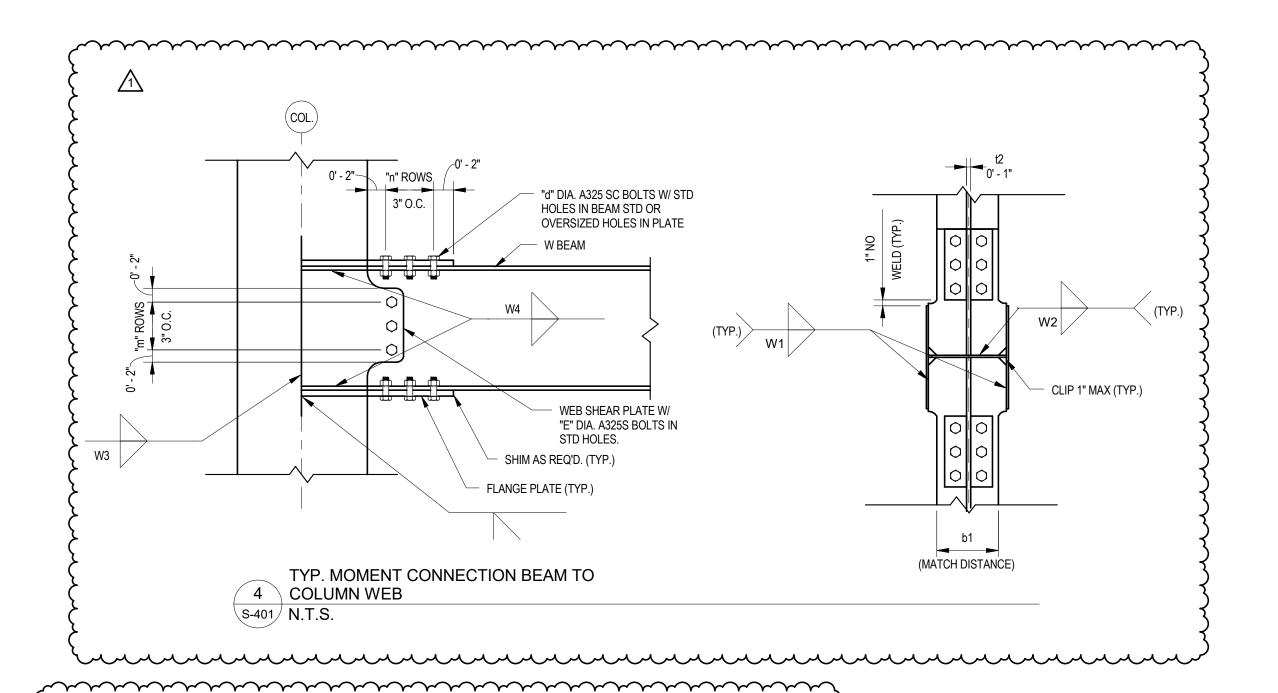




MOMENT CONNECTIONS											
IVDL   I I I I I I I I I I I I I I I I I I					ATES	S WEB PLATES			TES		
CF/CVV	SIZE TO COL.	t1	b1	W1	W2	n	d	t2	W3/W4	М	е
CF	W16	5/16"	7"	FP	FP	3	3/4"	3/8"	5/16"	3	3/4"
CF	W18	5/16"	7"	FP	FP	3	3/4"	3/8"	5/16"	5	3/4"
CW	W16	5/16"	7"	5/16"	5/16"	3	3/4"	3/8"	5/16"	3	3/4"
CW	W18	5/16"	7"	5/16"	5/16"	3	3/4"	3/8"	5/16"	5	3/4"
CF	W21	3/4"	9"	FP	FP	4	3/4"	3/4"	3/8"	7	3/4"
	CF/CW  CF  CF  CW  CW	CONNECTION @ MOMENT BEAM SIZE TO COL.  CF W16  CF W18  CW W16  CW W18	CONNECTION @ CF/CW         MOMENT BEAM SIZE TO COL.         t1           CF         W16         5/16"           CF         W18         5/16"           CW         W16         5/16"           CW         W18         5/16"	CONNECTION @ MOMENT BEAM SIZE TO COL.	CONNECTION @ CF/CW         MOMENT BEAM SIZE TO COL.         FLANGE PLANGE PLANG	CONNECTION @ MOMENT BEAM SIZE TO COL.	CONNECTION @ MOMENT BEAM SIZE TO COL.  The state of the s	CONNECTION @ MOMENT BEAM SIZE TO COL.    t1   b1   W1   W2   n   d	CONNECTION @ MOMENT BEAM SIZE TO COL.	CONNECTION @ MOMENT BEAM SIZE TO COL.    t1   b1   W1   W2   n   d   t2   W3/W4	CONNECTION @ MOMENT BEAM SIZE TO COL.    T1   b1   W1   W2   n   d   12   W3/W4   M

### NOTES:


- 1. "CF" DENOTES CONNECTION AT COLUMN FLANGE.
- 2. "CW" DENOTES CONNECTION AT COLUMN WEB.
- 3. "\*" DENOTES PROVIDE FULL DEPTH 1/2" THK. TRANSVERSE COLUMN STIFFENERS WITH 5/16" FILLET WELD TOP AND
- 4. ALL 3/4" DIAMETER BOLTS TO BE A325.

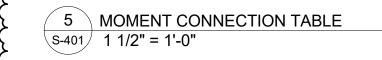







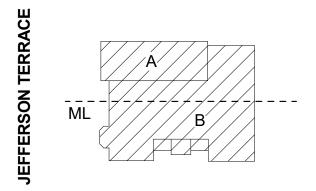

DR. SAMUEL MCCREE WAY

KEY PLAN
SED # 26-16-00-01-0-004-024

DWT SED # 26-16-00-01-7-999-020

Rochester Schools Modernization Program
-Phase 2c
George M. Forbes- Renovation, Alterations
and Addition

198 Dr Samuel McCree Way, Rochester, NY 14611

REV#	DESCRIPTION	DATE
1	ADDENDA #1	4/25/201


OB NO.	171
CALE	As indicate
SSUE DATE	4/9/1
RAWN BY	Autho
HECKED BY	Checke

THIS IS A SINGLE SHEET OF A COHESIVE SET OF CONSTRUCTION DOCUMENTS (INCLUDING DRAWINGS AND SPECIFICATIONS). INTERPRETATION OF THE INFORMATION AS PRESENTED SHOULD BE BASED ON THE ENTIRE SET OF DOCUMENTS.

DRAWING TITLE

SCHEDULES


S-401

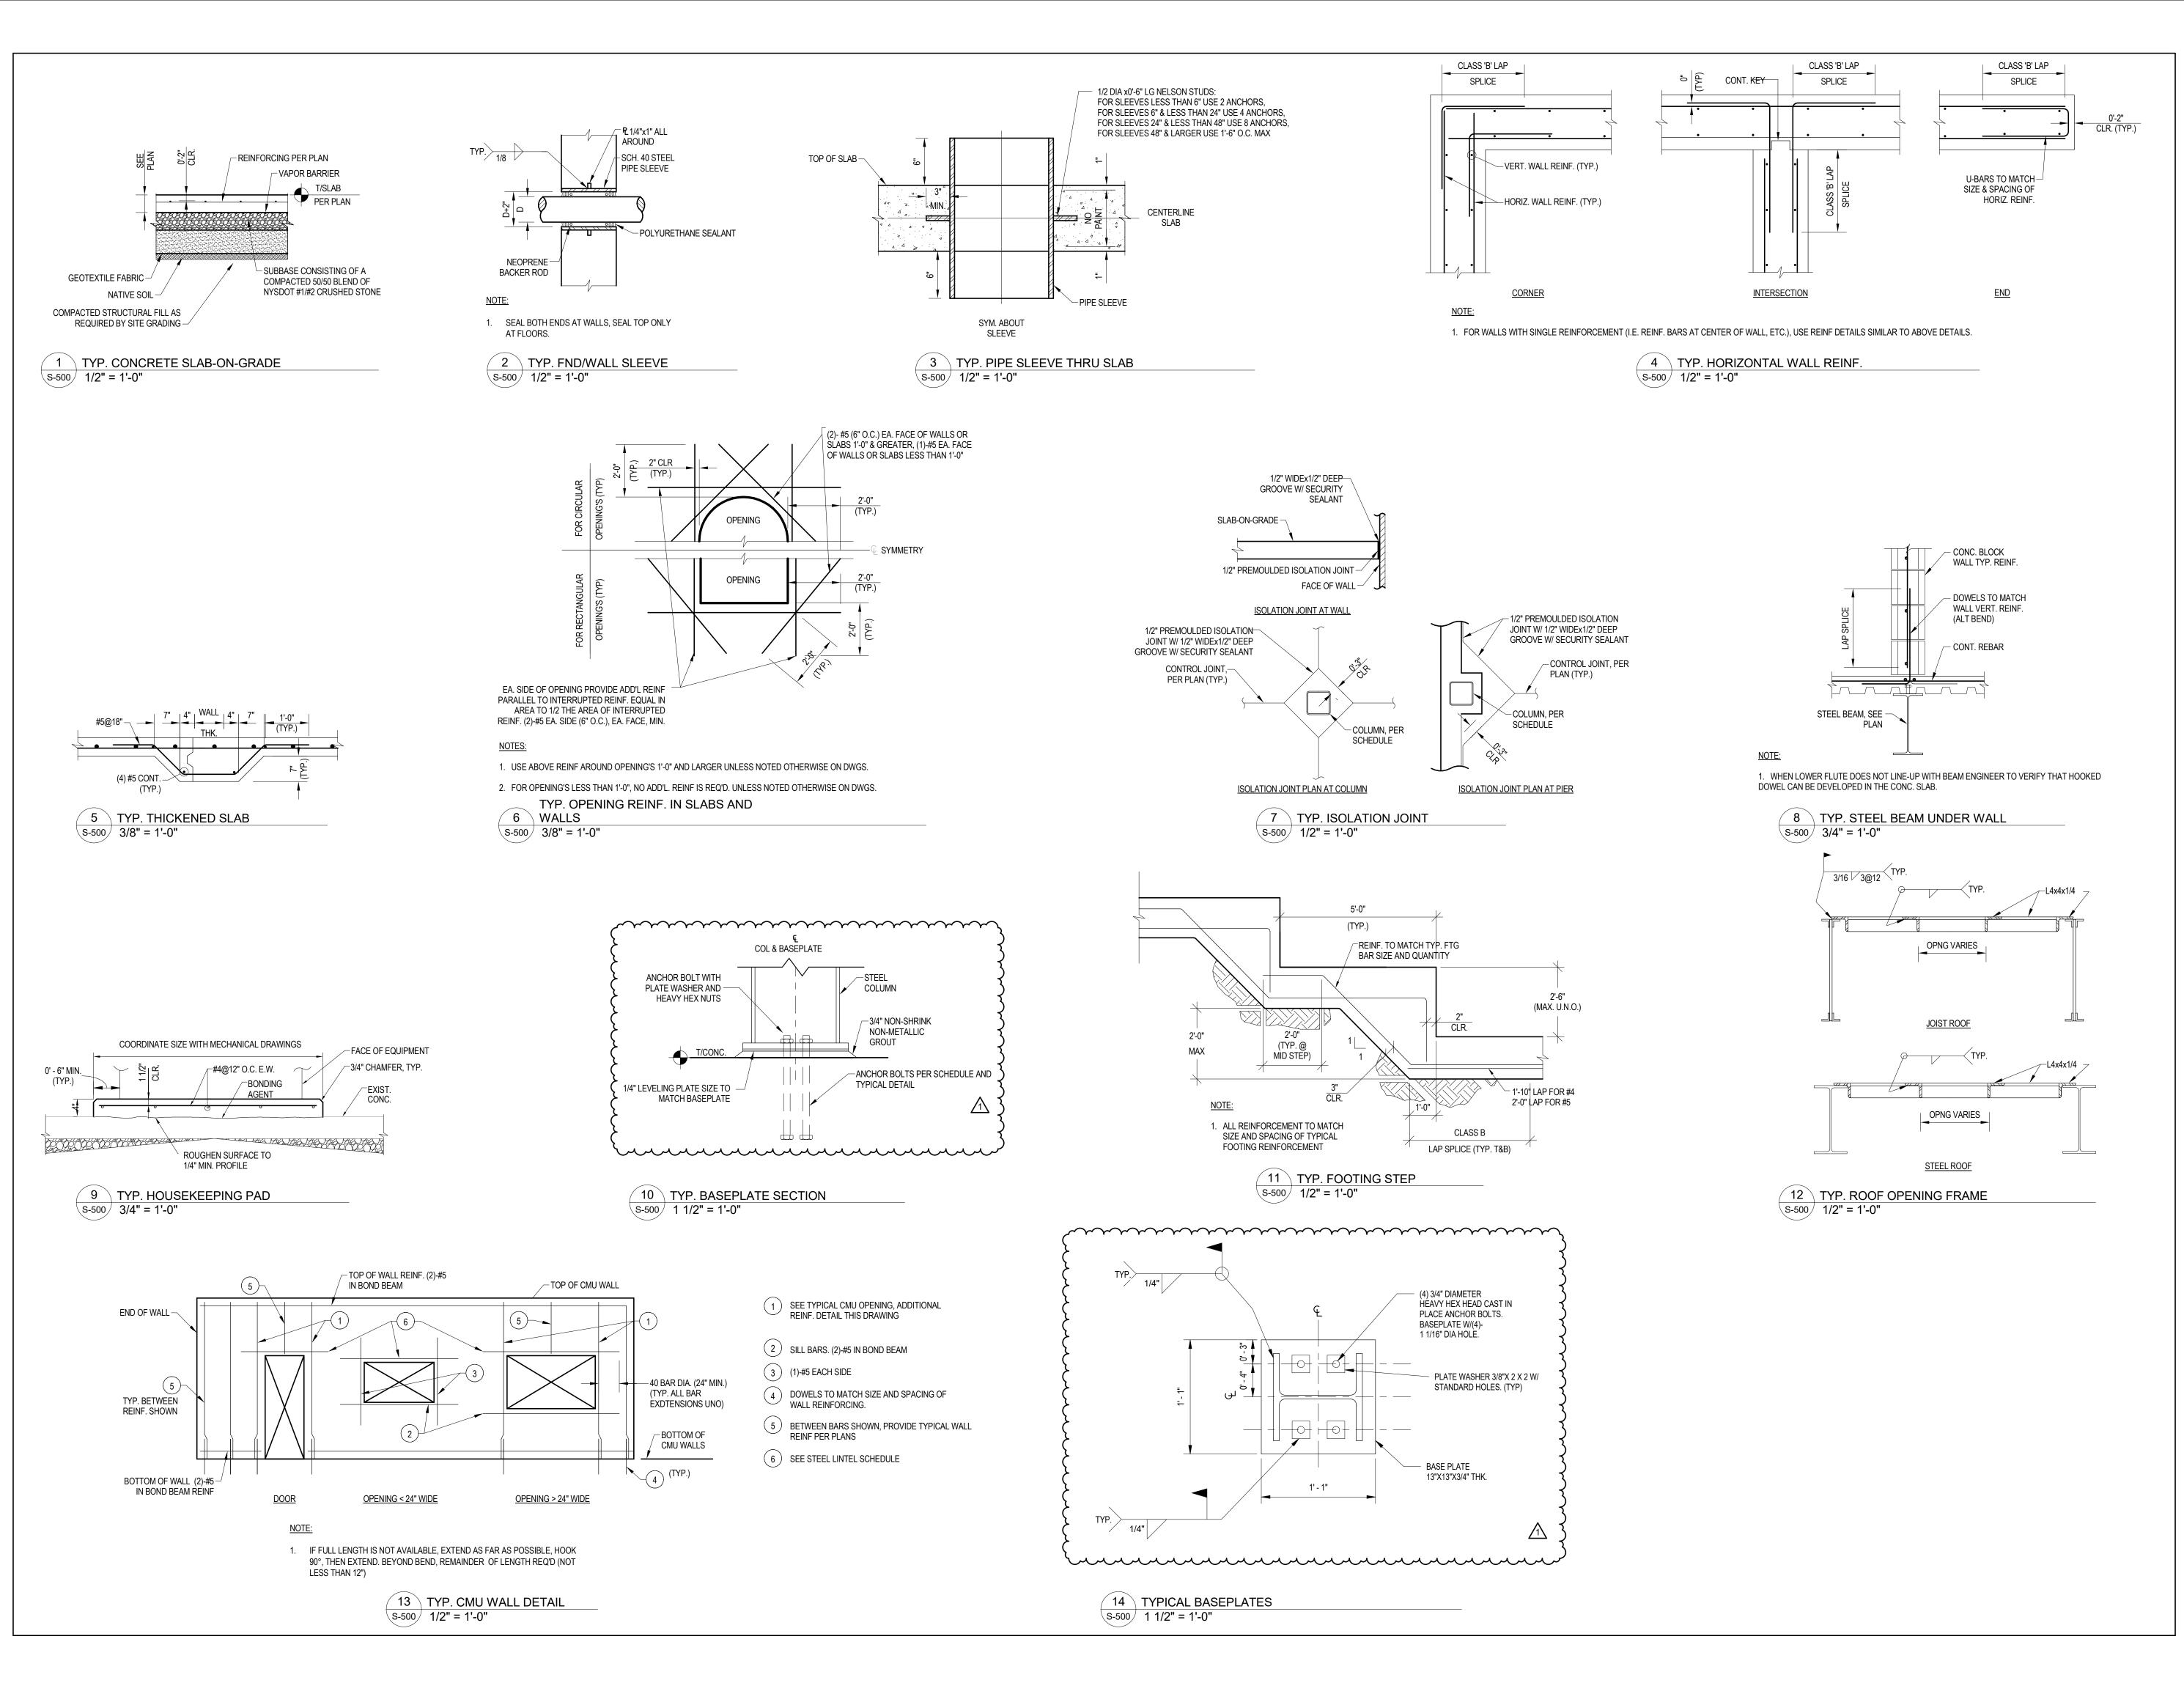







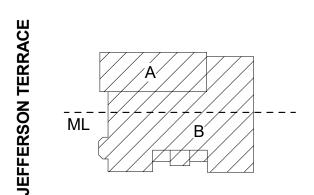

DR. SAMUEL MCCREE WAY

KEY PLAN

SED # 26-16-00-01-0-004-024 DWT SED # 26-16-00-01-7-999-020

Rochester Schools Modernization Program

-Phase 2c

George M. Forbes- Renovation, Alterations and Addition

198 Dr Samuel McCree Way, Rochester, NY 14611




JOB NO.	1711
SCALE	As indicated
ISSUE DATE	4/9/18
DRAWN BY	SNP
CHECKED BY	MNW
THIS IS A SINGLE SHEET OF A COHESIVE SET OF CONSTRUCTION DOCUMENTS	

THIS IS A SINGLE SHEET OF A COHESIVE SET OF CONSTRUCTION DOCUMENTS (INCLUDING DRAWINGS AND SPECIFICATIONS). INTERPRETATION OF THE INFORMATION AS PRESENTED SHOULD BE BASED ON THE ENTIRE SET OF DOCUMENTS.


DRAWING TITLE

TYPICAL DETAILS

**S-500** 

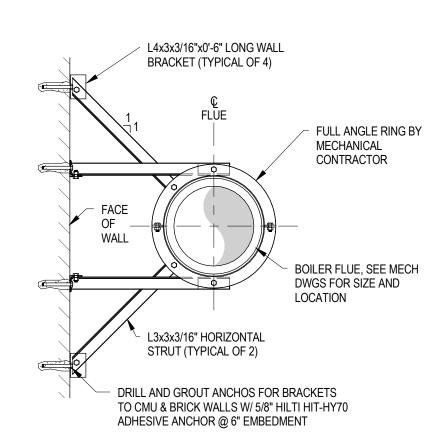


### <u>PLAN</u>

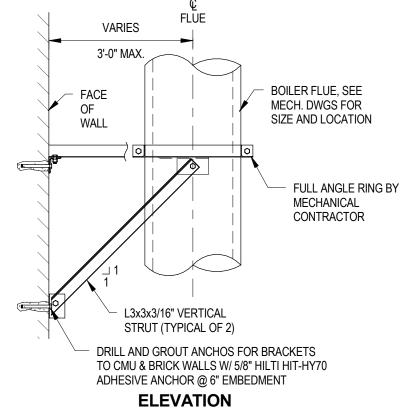


- 1. COORDINATE SUPPORT LOCATIONS WITH MECHANICAL CONTRACTOR AND BOILER FLUE MANUFACTURER. MAXIMUM VERTICAL SUPPORT SPACING= 12'-6".
- 2. ALL STEEL AND FASTENERS SHALL BE 304 STAINLESS STEEL.
- 3. ALL BOLTS SHALL BE 1/2" ASTM A325.


1 TYP. BOILER FLUE WALL GUIDE S-502 1/2" = 1'-0"

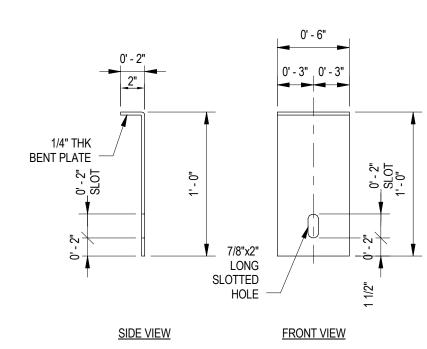

- 1. INSTALL PLATES ON EACH SIDE OF BEAM AT 2'-0" O.C. MAX.
- 2. WELD TO BEAM BOTTOM FLANGE AFTER CMU PLACEMENT.
- 3. INSTALL THROUGH BOLTS AT BOTTOM OF PLATE SLOT TO ALLOW FOR MOVEMENT OF BEAM.
- 2 TYP. BEAM CONNECTOR PLATE DETAIL S-502 N.T.S.

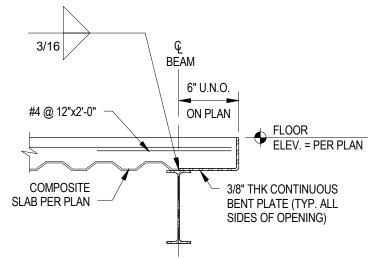




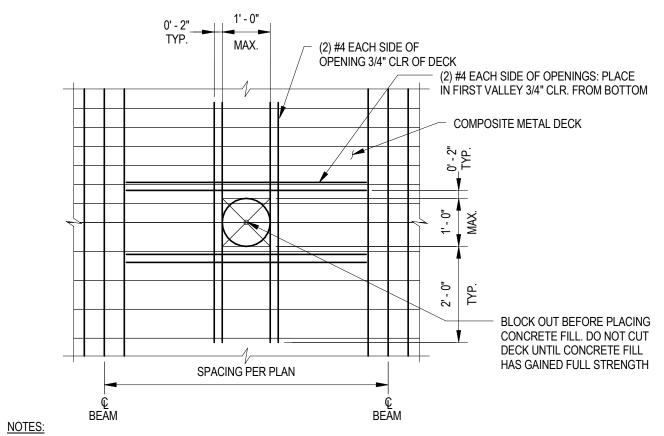

1. BOXED OUT OPENINGS, RECESSED BOXES, CONDUITS, AND PIPE SLEVES WHERE INDIVIDUAL CONDUITS OR SLEEVES ARE CLOSER THAN 6" O.C. SHALL BE TREATED AS FRAMED SLAB OPENINGS.


2. FOR OPENINGS LARGER THAN 1'-0", SEE TYPICAL FRAMED OPENING IN COMPOSITE SLAB DETAIL.


TYPICAL UNFRAMED OPENING IN 4 COMPOSITE SLAB DETAIL S-502 N.T.S.

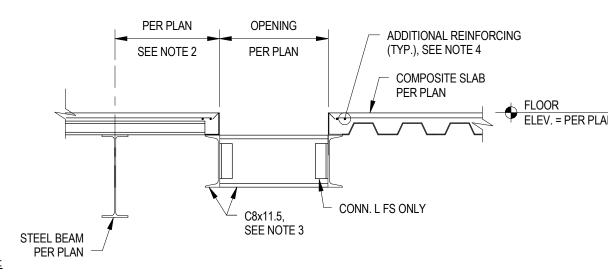


- 1. FOR OPENINGS SMALLER THAN 1'-0", SEE TYPICAL UNFRAMED OPENING IN COMPOSITE SLAB DETAIL
- 2. FACE ALL OPENINGS IN ROOF DECK 1'-0" OR LARGER WITH A STRUCTURAL STEEL MEMBER ON ALL SIDES EXCEPT WHERE A SIDE MAY BE WITHIN 1'-0" OF ANOTHER FRAMING MEMBER.
- 3. FRAME OPENINGS WITH C8x11.5 FOR MEMEBRS UP TO 8'-0" IN LENGTH AND WITH W8x21 FOR MEMBER LENGTHS BETWEEN 8'-0" AND 15'-0" UNLESS NOTED OTHERWISE.
- 4. PROVIDE (2) #4 BARS EACH SIDE OF OPENING PER TYPICAL UNFRAMED OPENINGS IN COMPOSITE




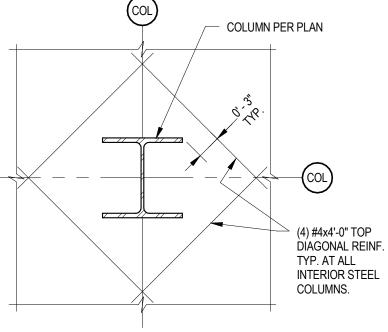

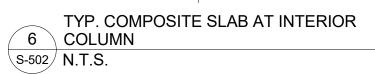


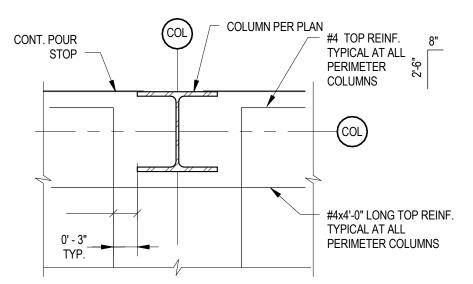

TYP. COMPOSITE SLAB AT PERIMETER 7 COLUMN S-502 N.T.S.

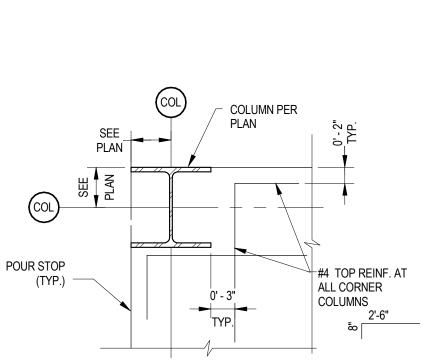


TYP. COMPOSITE SLAB AT CORNER 8 COLUMN S-502 N.T.S.

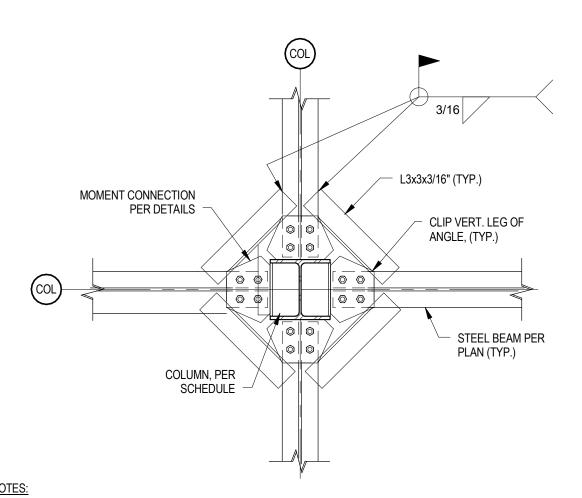


1. INSTALL ANGLES AS REQUIRED TO PROVIDE BEARING FOR FULL WIDTH OF ALL METAL DECK SHEETS, TYP.

2. DECK NOT SHOWN FOR CLARITY.

TYP. DECK SUPPORT AT COLUMN W/ 9 MOMENT CONNECTION S-502 N.T.S.

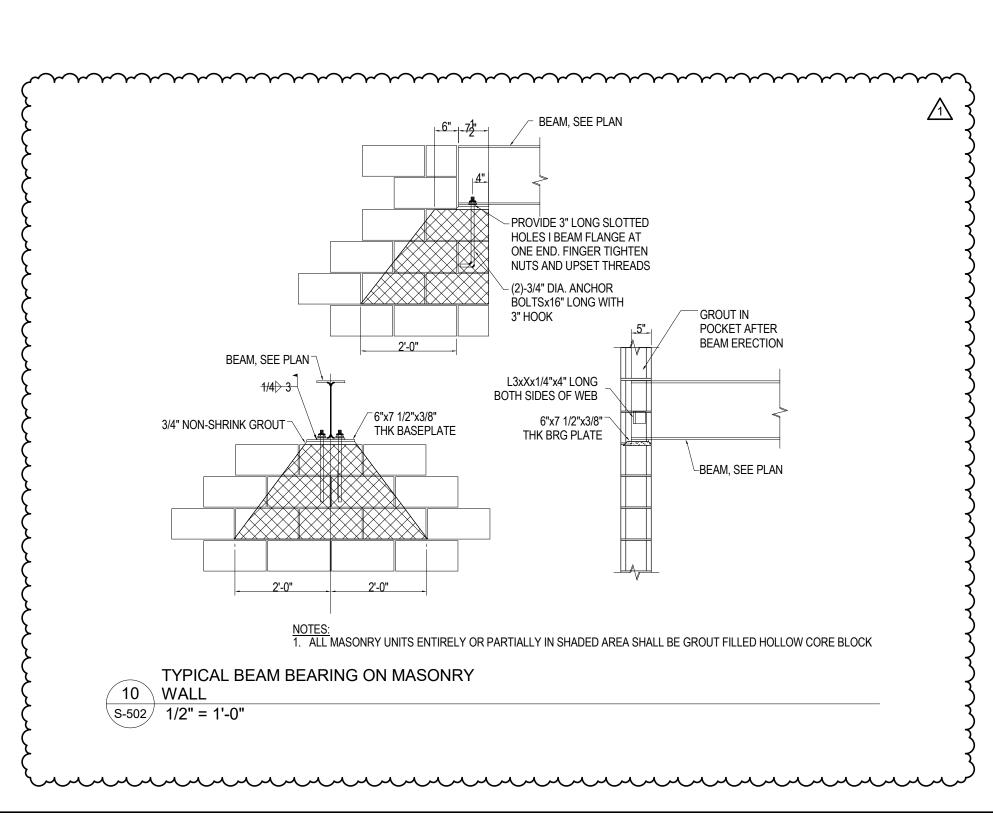


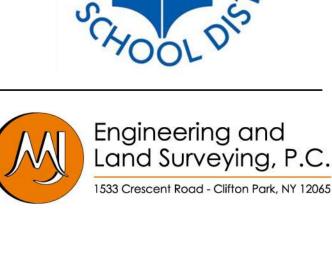

ARCHITECTS

BUFFALO | ROCHESTER

www.cjsarchitects.com

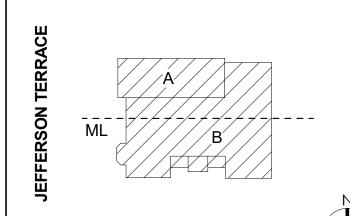

KEY PLAN

DR. SAMUEL MCCREE WAY

SED # 26-16-00-01-0-004-024 DWT SED# 26-16-00-01-7-999-020

Rochester Schools Modernization Program

-Phase 2c George M. Forbes- Renovation, Alterations and Addition

> 198 Dr Samuel McCree Way, Rochester, NY 14611

REV#	DESCRIPTION	DATE
1	ADDENDA #1	4/25/2018


OB NO.	171
CALE	As indicated
SSUE DATE	4/9/18
RAWN BY	Autho
CHECKED BY	Checke


THIS IS A SINGLE SHEET OF A COHESIVE SET OF CONSTRUCTION DOCUMENTS (INCLUDING DRAWINGS AND SPECIFICATIONS). INTERPRETATION OF THE INFORMATION AS PRESENTED SHOULD BE BASED ON THE ENTIRE SET OF DOCUMENTS.

DRAWING TITLE

TYPICAL DETAILS

**S-502** 

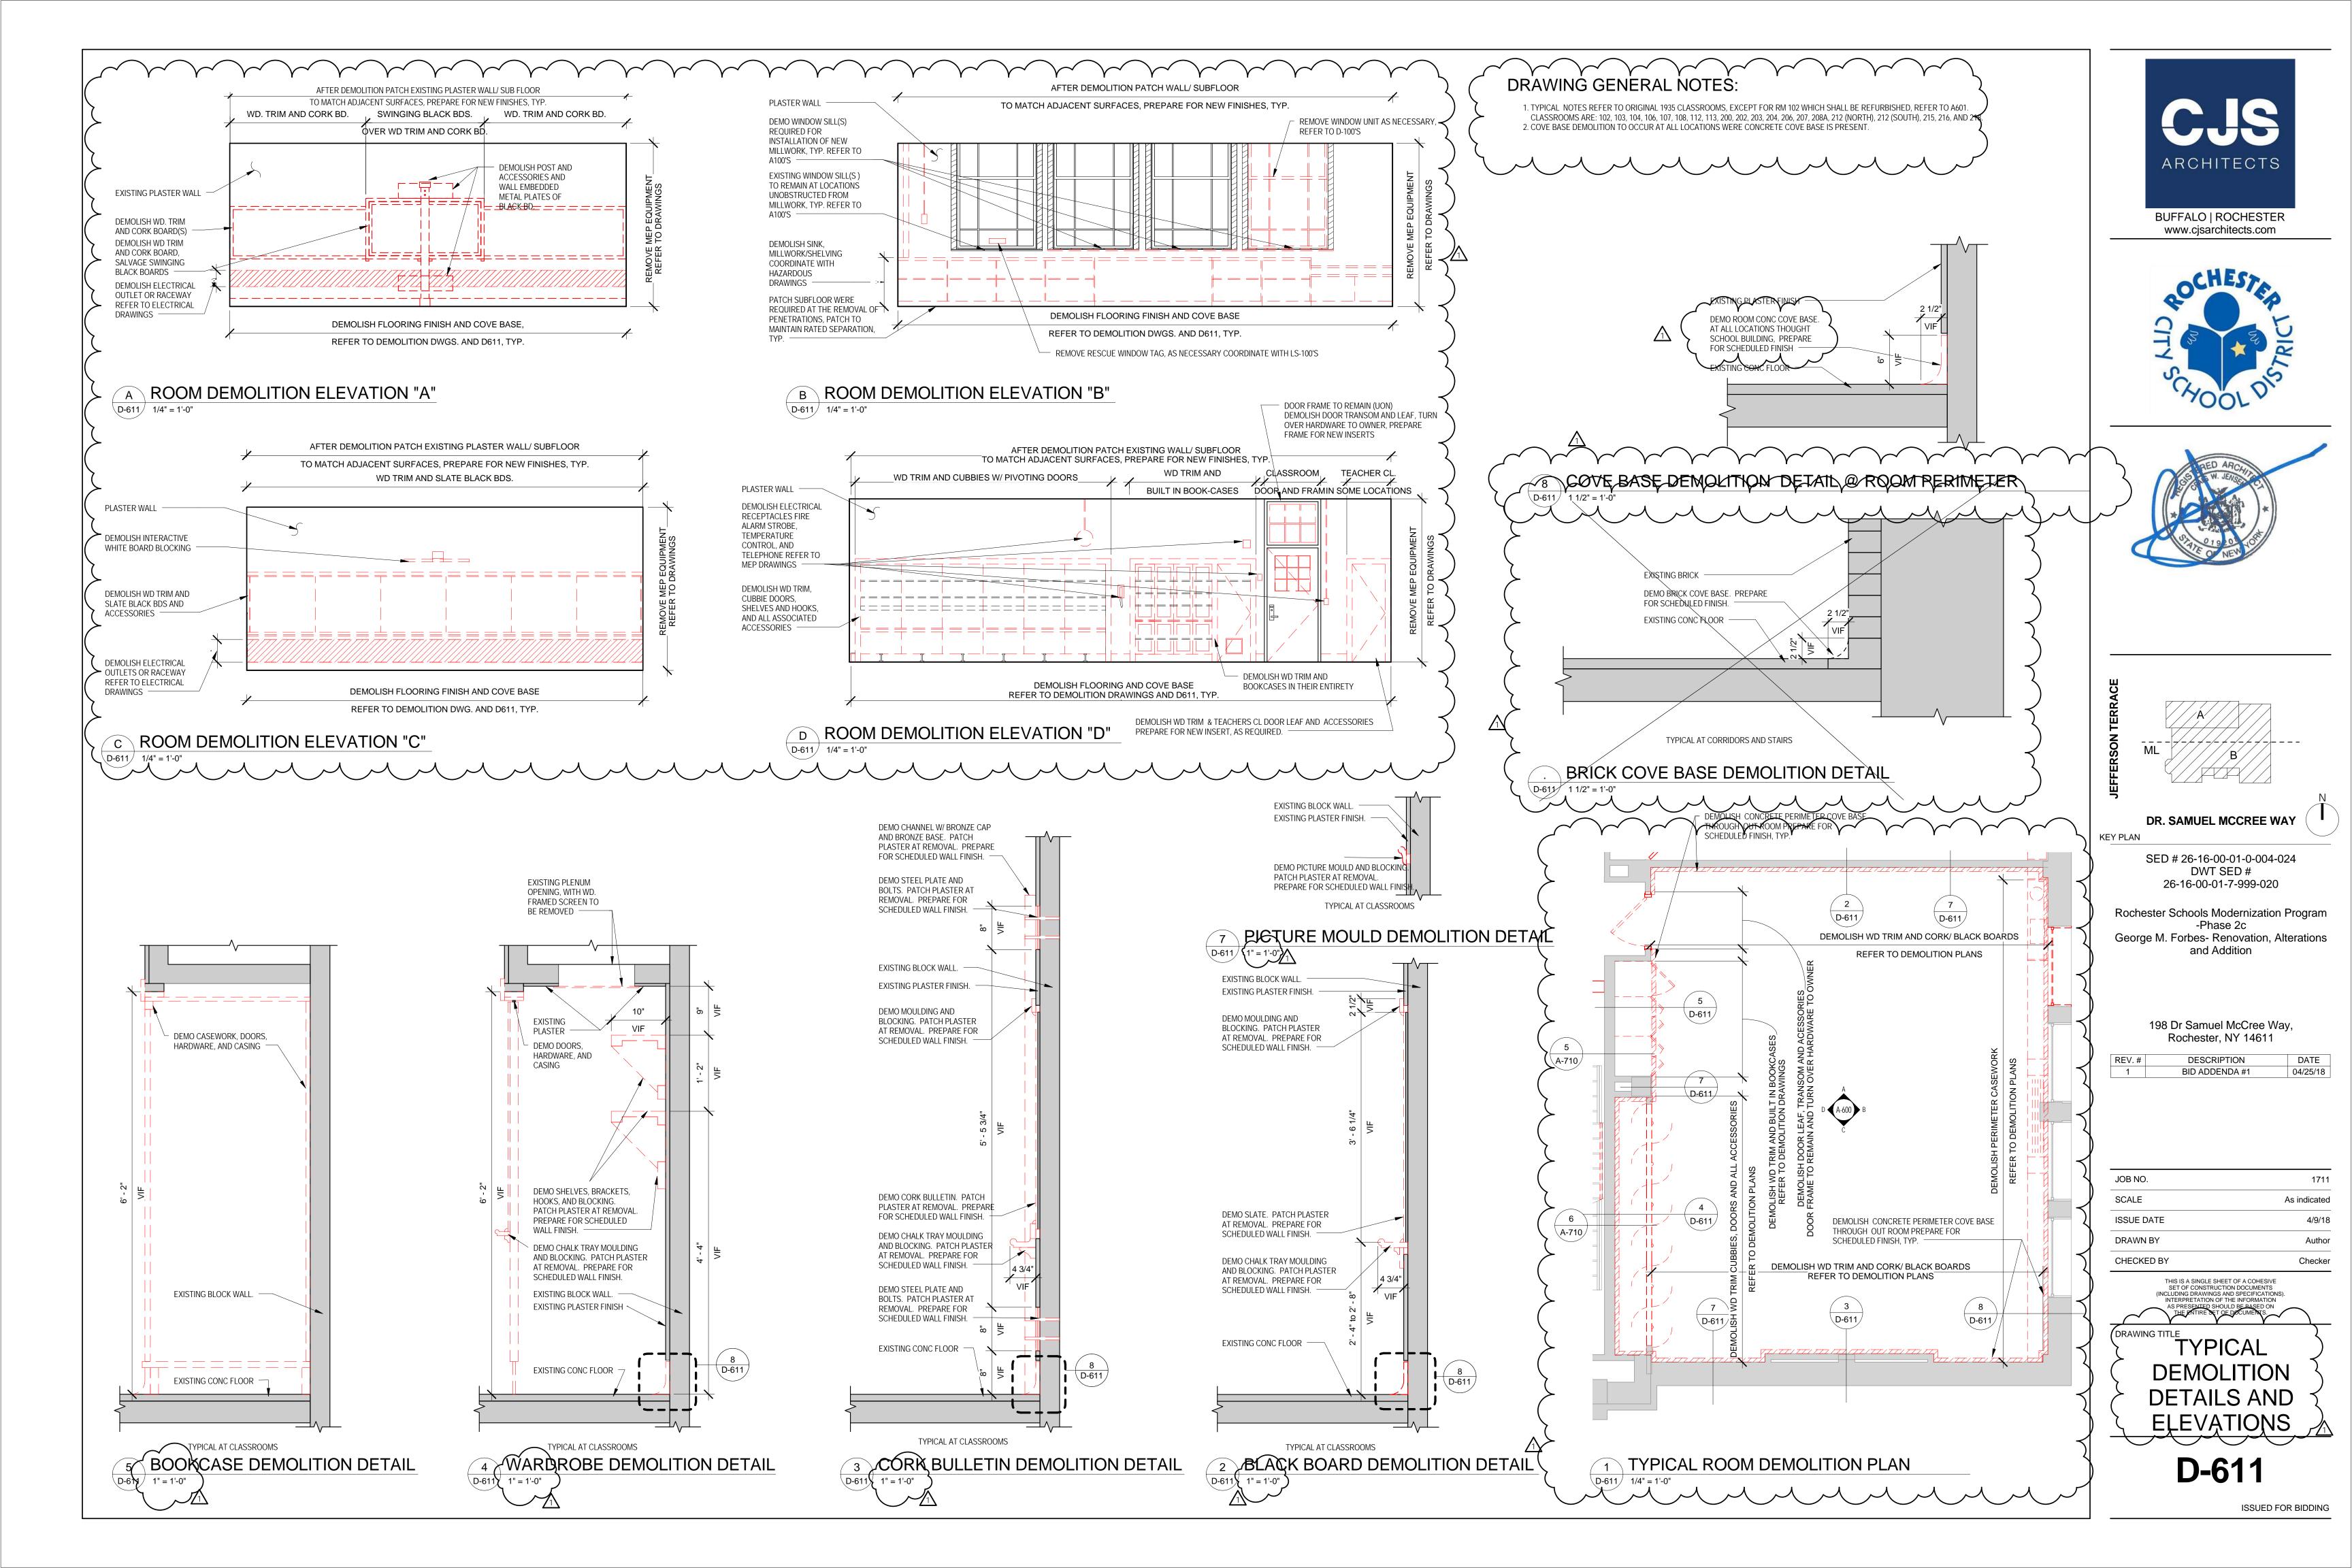


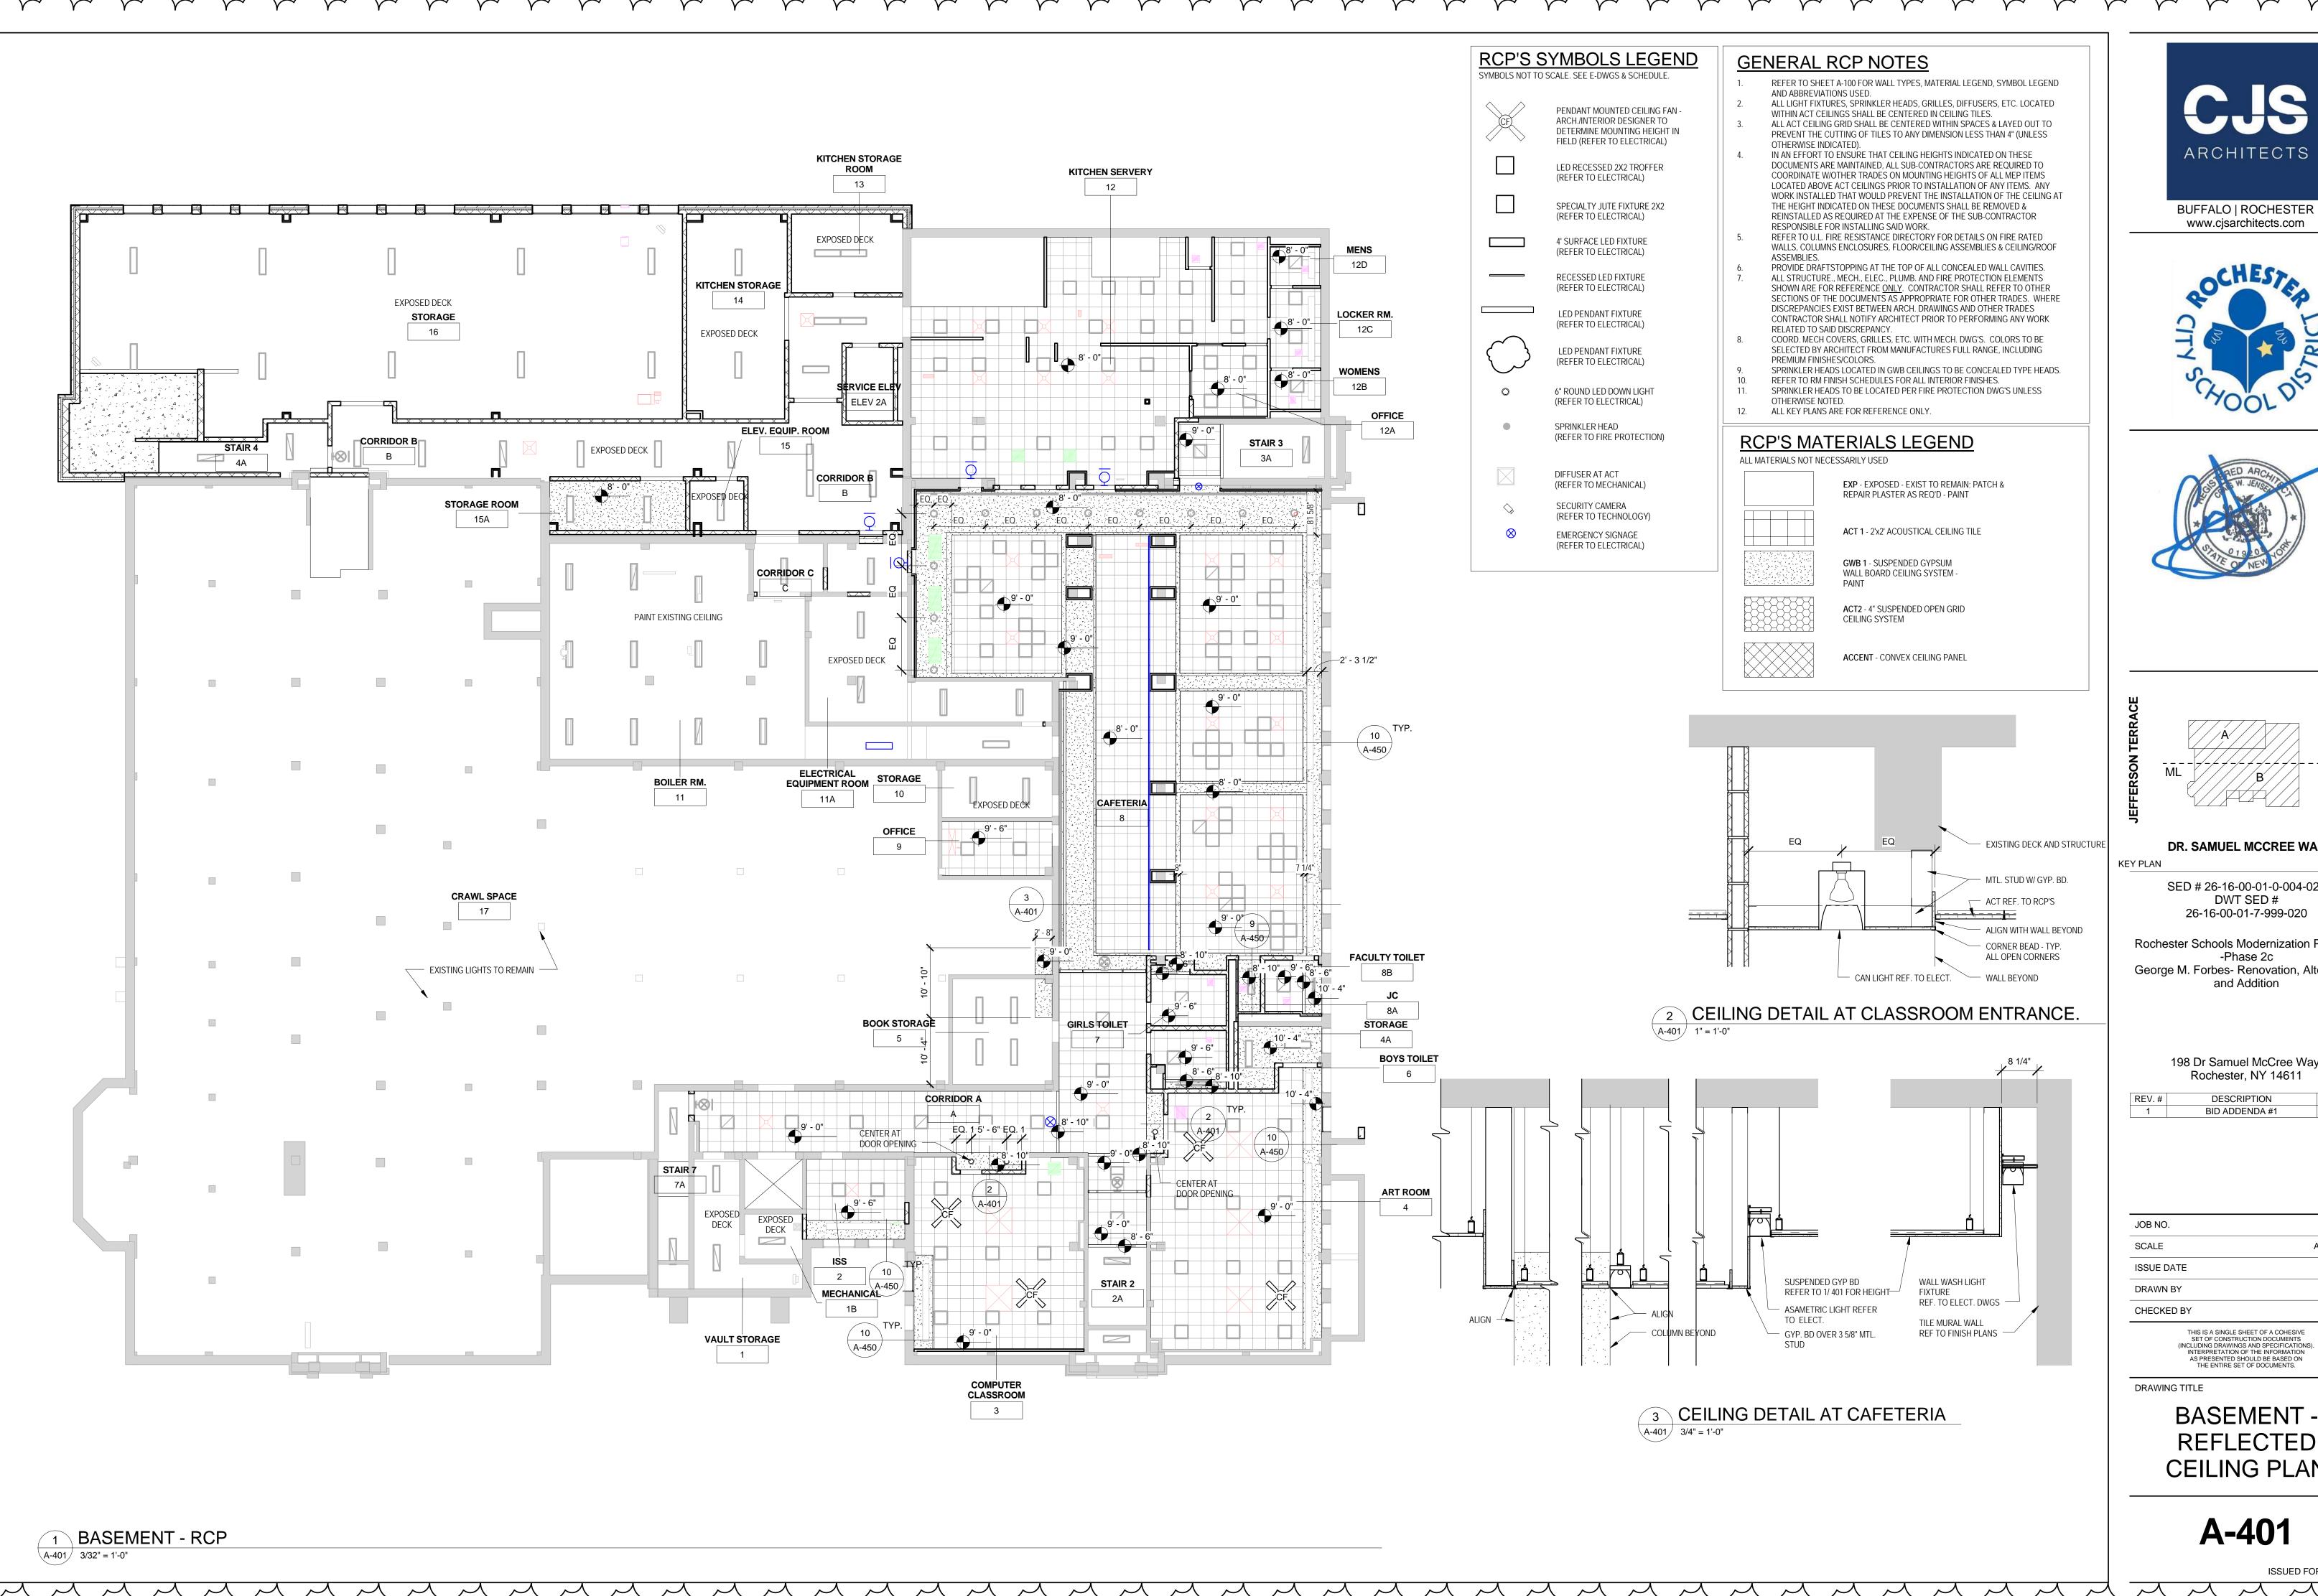



www.cjsarchitects.com



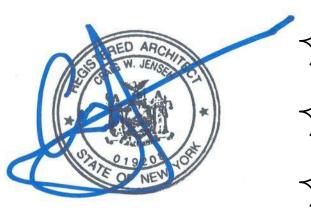

DR. SAMUEL MCCREE WAY

SED # 26-16-00-01-0-004-024 DWT SED# 26-16-00-01-7-999-020

Rochester Schools Modernization Program

-Phase 2c George M. Forbes- Renovation, Alterations . and Addition

> 198 Dr Samuel McCree Way, Rochester, NY 14611

DESCRIPTION BID ADDENDA #1 04/25/18


As indicated Author Checker

THIS IS A SINGLE SHEET OF A COHESIVE SET OF CONSTRUCTION DOCUMENTS (INCLUDING DRAWINGS AND SPECIFICATIONS). INTERPRETATION OF THE INFORMATION AS PRESENTED SHOULD BE BASED ON THE ENTIRE SET OF DOCUMENTS.

DRAWING TITLE

BASEMENT -REFLECTED **CEILING PLAN** 

**A-401** 

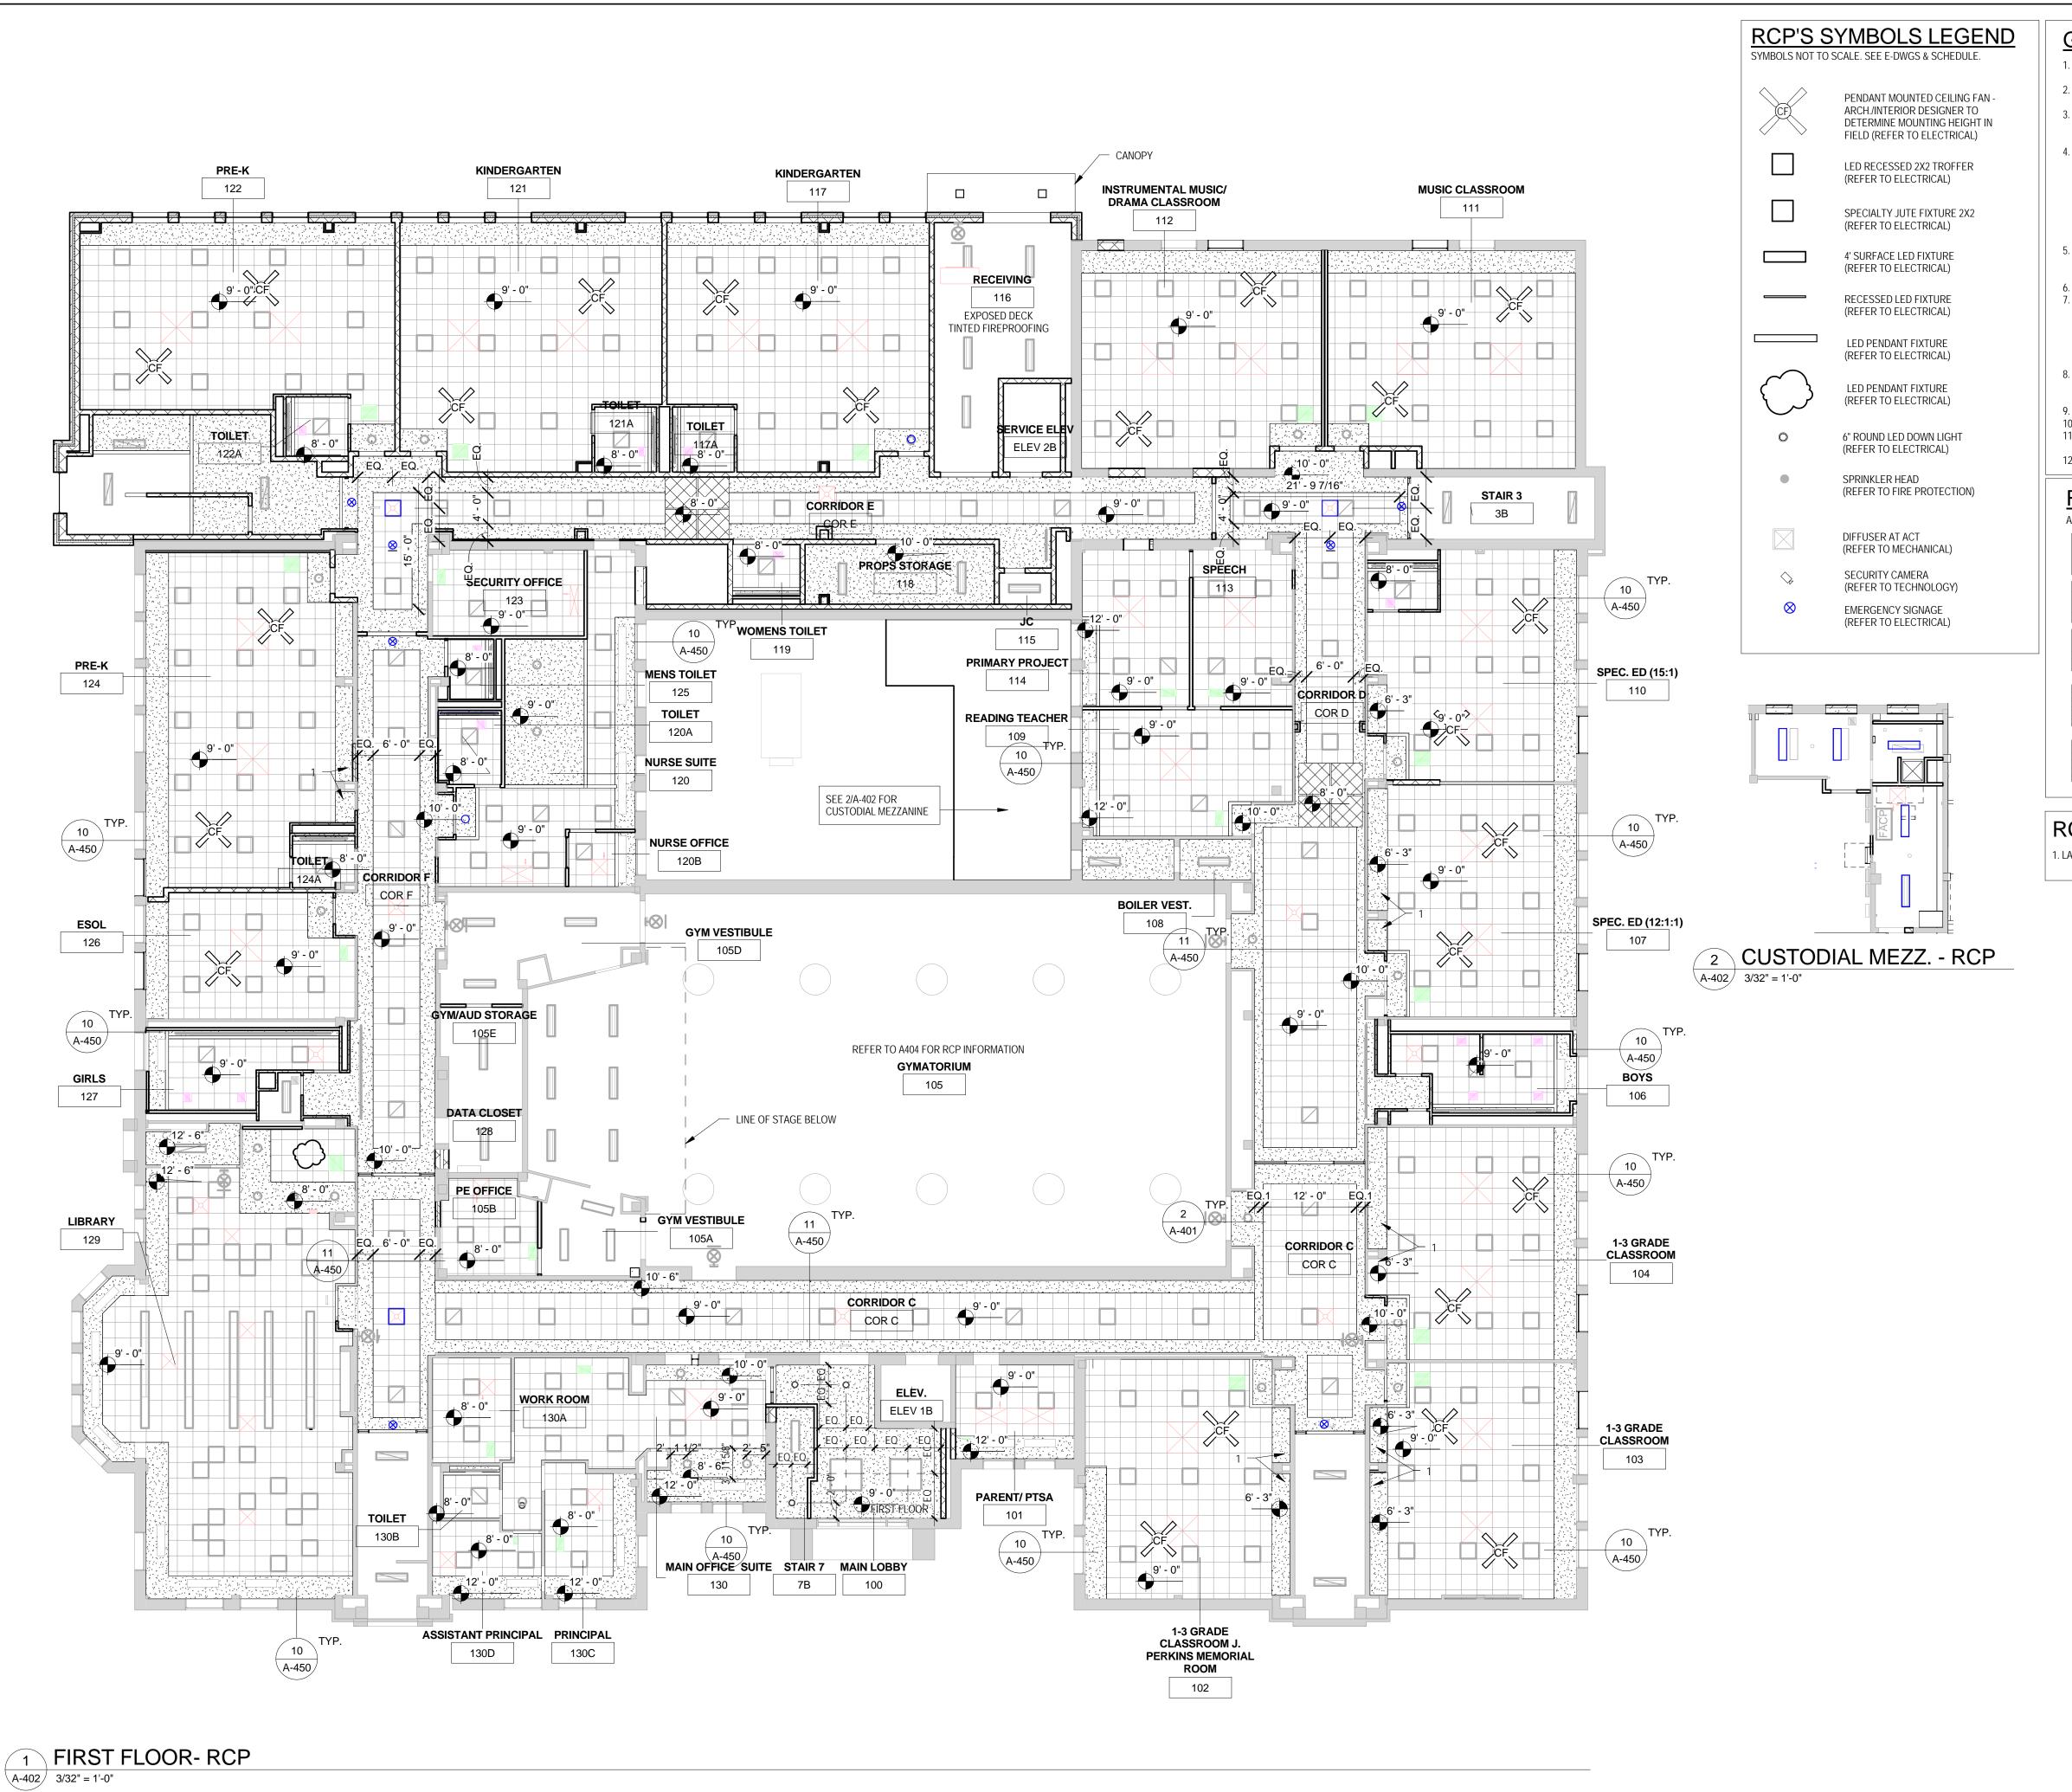

## **GENERAL RCP NOTES**

- REFER TO SHEET A-100 FOR WALL TYPES, MATERIAL LEGEND, SYMBOL LEGEND AND ABBREVIATIONS USED.
- ALL LIGHT FIXTURES, SPRINKLER HEADS, GRILLES, DIFFUSERS, ETC. LOCATED WITHIN ACT CEILINGS SHALL BE CENTERED IN CEILING TILES.

  ALL ACT CEILING GRID SHALL BE CENTERED WITHIN SPACES & LAYED OUT TO PREVENT THE CUTTING OF TILES TO ANY DIMENSION LESS THAN 4" (UNLESS
- OTHERWISE INDICATED).

  4. IN AN EFFORT TO ENSURE THAT CEILING HEIGHTS INDICATED ON THESE DOCUMENTS ARE MAINTAINED, ALL SUB-CONTRACTORS ARE REQUIRED TO COORDINATE W/OTHER TRADES ON MOUNTING HEIGHTS OF ALL MEP ITEMS LOCATED ABOVE ACT CEILINGS PRIOR TO INSTALLATION OF ANY ITEMS. ANY WORK INSTALLED THAT WOULD PREVENT THE INSTALLATION OF THE CEILING AT THE HEIGHT INDICATED ON THESE DOCUMENTS SHALL BE REMOVED & REINSTALLED AS REQUIRED AT THE EXPENSE OF THE SUB-CONTRACTOR
- RESPONSIBLE FOR INSTALLING SAID WORK.
  REFER TO U.L. FIRE RESISTANCE DIRECTORY FOR DETAILS ON FIRE RATED
  WALLS, COLUMNS ENCLOSURES, FLOOR/CEILING ASSEMBLIES & CEILING/ROOF
  ASSEMBLIES.
- PROVIDE DRAFTSTOPPING AT THE TOP OF ALL CONCEALED WALL CAVITIES.
   ALL STRUCTURE., MECH., ELEC., PLUMB. AND FIRE PROTECTION ELEMENTS
   SHOWN ARE FOR REFERENCE ONLY. CONTRACTOR SHALL REFER TO OTHER
   SECTIONS OF THE DOCUMENTS AS APPROPRIATE FOR OTHER TRADES. WHERE
   DISCREPANCIES EXIST BETWEEN ARCH. DRAWINGS AND OTHER TRADES
   CONTRACTOR SHALL NOTIFY ARCHITECT PRIOR TO PERFORMING ANY WORK
   RELATED TO SAID DISCREPANCY.
- COORD. MECH COVERS, GRILLES, ETC. WITH MECH. DWG'S. COLORS TO BE SELECTED BY ARCHITECT FROM MANUFACTURES FULL RANGE, INCLUDING PREMIUM FINISHES/COLORS.
- SPRINKLER HEADS LOCATED IN GWB CEILINGS TO BE CONCEALED TYPE HEADS.

  REFER TO RM FINISH SCHEDULES FOR ALL INTERIOR FINISHES.
- SPRINKLER HEADS TO BE LOCATED PER FIRE PROTECTION DWG'S UNLESS

EXP - EXPOSED - EXIST TO REMAIN; PATCH &

OTHERWISE NOTED. ALL KEY PLANS ARE FOR REFERENCE ONLY.

## RCP'S MATERIALS LEGEND

ALL MATERIALS NOT NECESSARILY USED

REPAIR PLASTER AS REQ'D - PAINT

ACT 1 - 2'x2' ACOUSTICAL CEILING TILE

GWB 1 - SUSPENDED GYPSUM
WALL BOARD CEILING SYSTEM PAINT

ACT2 - 4" SUSPENDED OPEN GRID CEILING SYSTEM

### RCP'S KEY NOTES


1. LAMINATE GYPSUM BOARD OVER EXISTING PLASTER SOFFIT- PAINT REFER TO FINISH PLANS


**ACCENT** - CONVEX CEILING PANEL

CJS

BUFFALO | ROCHESTER www.cjsarchitects.com



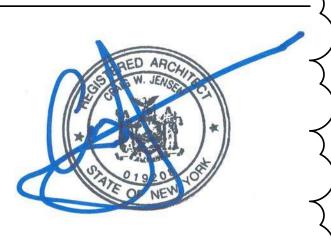

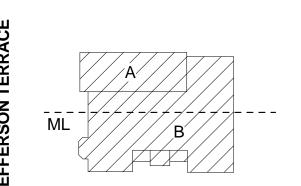

DR. SAMUEL MCCREE WAY

KEY PLAN

SED # 26-16-00-01-0-004-024 DWT SED # 26-16-00-01-7-999-020

Rochester Schools Modernization Program
-Phase 2c
George M. Forbes- Renovation, Alterations

and Addition

198 Dr Samuel McCree Way,

Rochester, NY 14611

 REV. #
 DESCRIPTION
 DATE

 1
 BID ADDENDA #1
 04/25/18

JOB NO. 1711

SCALE As indicated

ISSUE DATE 4/9/18

DRAWN BY Author

CHECKED BY Checker


THIS IS A SINGLE SHEET OF A COHESIVE SET OF CONSTRUCTION DOCUMENTS (INCLUDING DRAWINGS AND SPECIFICATIONS). INTERPRETATION OF THE INFORMATION AS PRESENTED SHOULD BE BASED ON THE ENTIRE SET OF DOCUMENTS.

DRAWING TITLE

FIRST FLOOR -REFLECTED CEILING PLAN

A-402

ISSUED FOR BIDDING

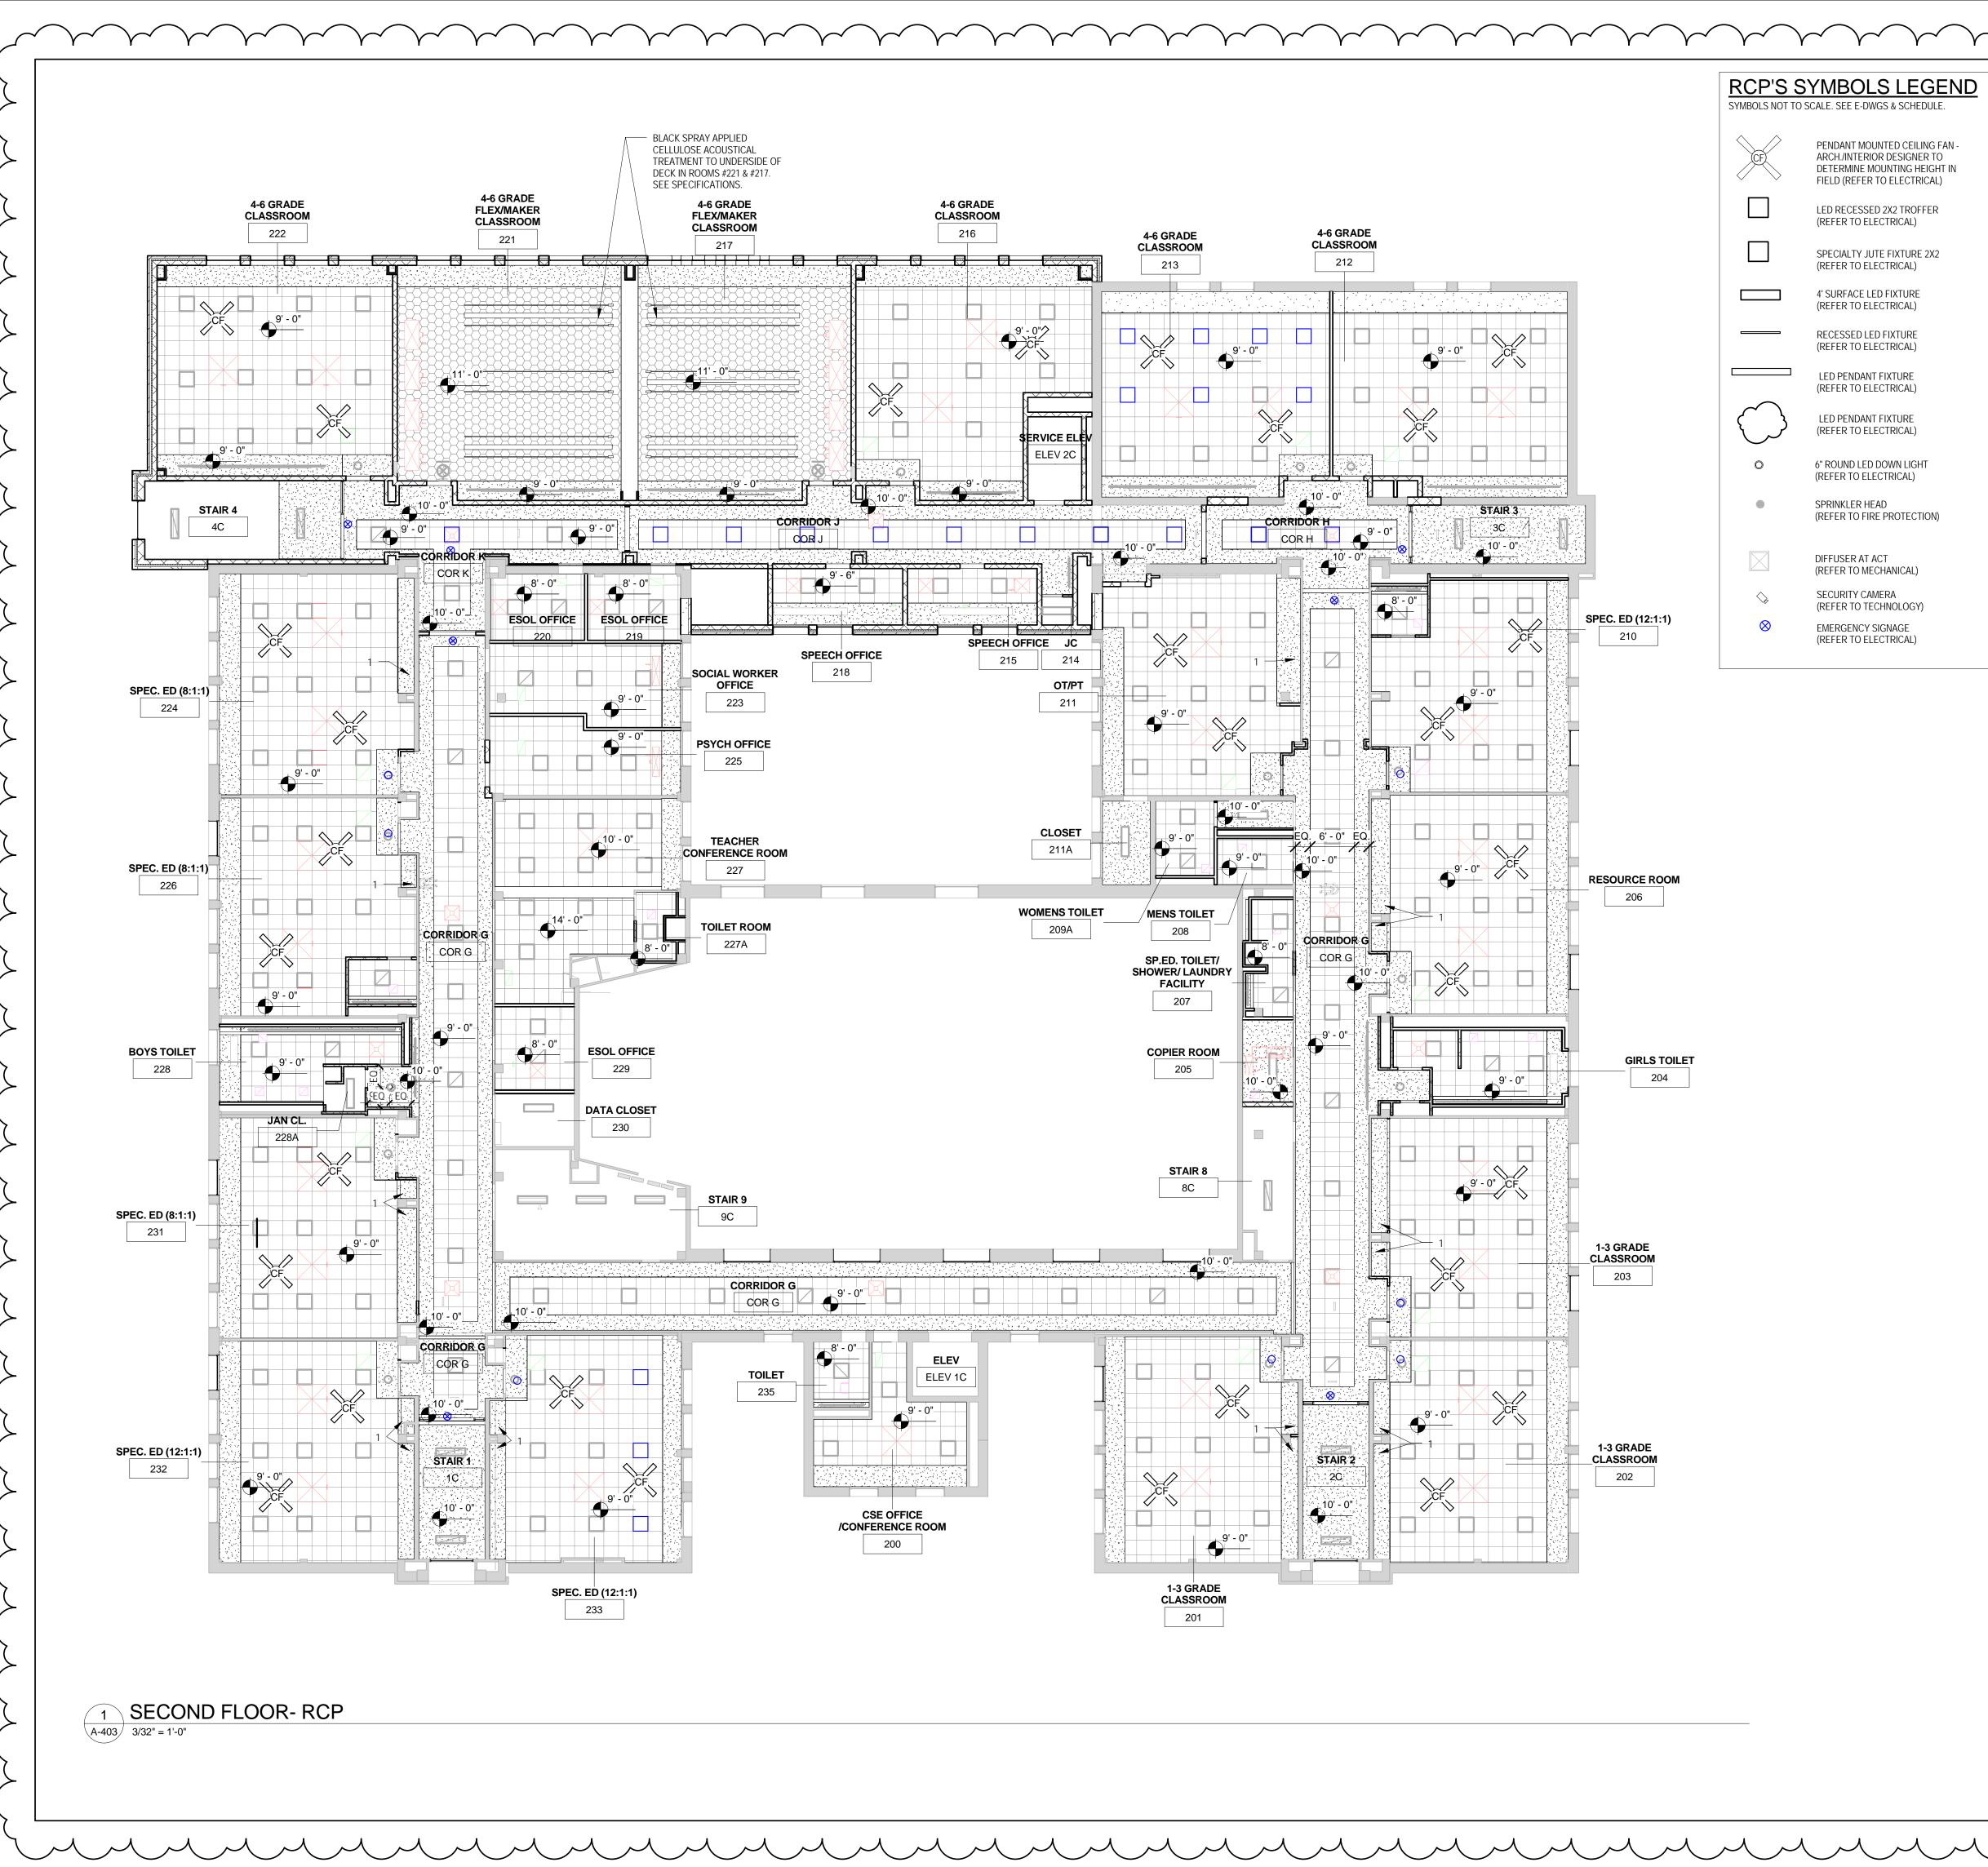

#### **GENERAL RCP NOTES**

REFER TO SHEET A-100 FOR WALL TYPES, MATERIAL LEGEND, SYMBOL LEGEND

AND ABBREVIATIONS USED. ALL LIGHT FIXTURES, SPRINKLER HEADS, GRILLES, DIFFUSERS, ETC. LOCATED

WITHIN ACT CEILINGS SHALL BE CENTERED IN CEILING TILES. ALL ACT CEILING GRID SHALL BE CENTERED WITHIN SPACES & LAYED OUT TO PREVENT THE CUTTING OF TILES TO ANY DIMENSION LESS THAN 4" (UNLESS

OTHERWISE INDICATED). IN AN EFFORT TO ENSURE THAT CEILING HEIGHTS INDICATED ON THESE DOCUMENTS ARE MAINTAINED, ALL SUB-CONTRACTORS ARE REQUIRED TO COORDINATE W/OTHER TRADES ON MOUNTING HEIGHTS OF ALL MEP ITEMS WORK INSTALLED THAT WOULD PREVENT THE INSTALLATION OF THE CEILING A THE HEIGHT INDICATED ON THESE DOCUMENTS SHALL BE REMOVED & REINSTALLED AS REQUIRED AT THE EXPENSE OF THE SUB-CONTRACTOR

RESPONSIBLE FOR INSTALLING SAID WORK. REFER TO U.L. FIRE RESISTANCE DIRECTORY FOR DETAILS ON FIRE RATED WALLS, COLUMNS ENCLOSURES, FLOOR/CEILING ASSEMBLIES & CEILING/ROOF

PROVIDE DRAFTSTOPPING AT THE TOP OF ALL CONCEALED WALL CAVITIES. ALL STRUCTURE., MECH., ELEC., PLUMB. AND FIRE PROTECTION ELEMENTS SHOWN ARE FOR REFERENCE <u>ONLY</u>. CONTRACTOR SHALL REFER TO OTHER SECTIONS OF THE DOCUMENTS AS APPROPRIATE FOR OTHER TRADES. WHERE DISCREPANCIES EXIST BETWEEN ARCH. DRAWINGS AND OTHER TRADES CONTRACTOR SHALL NOTIFY ARCHITECT PRIOR TO PERFORMING ANY WORK

RELATED TO SAID DISCREPANCY. COORD. MECH COVERS, GRILLES, ETC. WITH MECH. DWG'S. COLORS TO BE SELECTED BY ARCHITECT FROM MANUFACTURES FULL RANGE, INCLUDING PREMIUM FINISHES/COLORS.

SPRINKLER HEADS LOCATED IN GWB CEILINGS TO BE CONCEALED TYPE HEADS. REFER TO RM FINISH SCHEDULES FOR ALL INTERIOR FINISHES. SPRINKLER HEADS TO BE LOCATED PER FIRE PROTECTION DWG'S UNLESS

OTHERWISE NOTED. ALL KEY PLANS ARE FOR REFERENCE ONLY.

### RCP'S MATERIALS LEGEND

ALL MATERIALS NOT NECESSARILY USED

**EXP** - EXPOSED - EXIST TO REMAIN; PATCH & REPAIR PLASTER AS REQ'D - PAINT

ACT 1 - 2'x2' ACOUSTICAL CEILING TILE

WALL BOARD CEILING SYSTEM -

ACT2 - 4" SUSPENDED OPEN GRID **CEILING SYSTEM** 

**GWB 1** - SUSPENDED GYPSUM


#### —ACCENT - CONVEX CEILING PANEL-RCP'S KEY NOTES


1. LAMINATE GYPSUM BOARD OVER EXISTING PLASTER SOFFIT- PAINT REFER TO FINISH PLANS



BUFFALO | ROCHESTER www.cjsarchitects.com



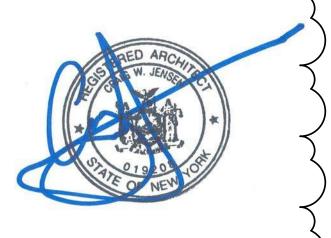

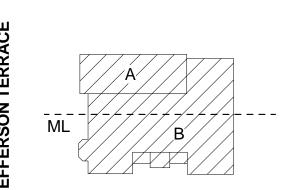

DR. SAMUEL MCCREE WAY

KEY PLAN

SED # 26-16-00-01-0-004-024 DWT SED# 26-16-00-01-7-999-020

Rochester Schools Modernization Program -Phase 2c George M. Forbes- Renovation, Alterations

and Addition

198 Dr Samuel McCree Way,

Rochester, NY 14611 REV.# DESCRIPTION BID ADDENDA #1 04/25/18

JOB NO. As indicated SCALE ISSUE DATE 4/9/18 DRAWN BY


> THIS IS A SINGLE SHEET OF A COHESIVE SET OF CONSTRUCTION DOCUMENTS (INCLUDING DRAWINGS AND SPECIFICATIONS). INTERPRETATION OF THE INFORMATION AS PRESENTED SHOULD BE BASED ON THE ENTIRE SET OF DOCUMENTS.

DRAWING TITLE

CHECKED BY


SECOND FLOOR -REFLECTED **CEILING PLAN** 

**A-403** 

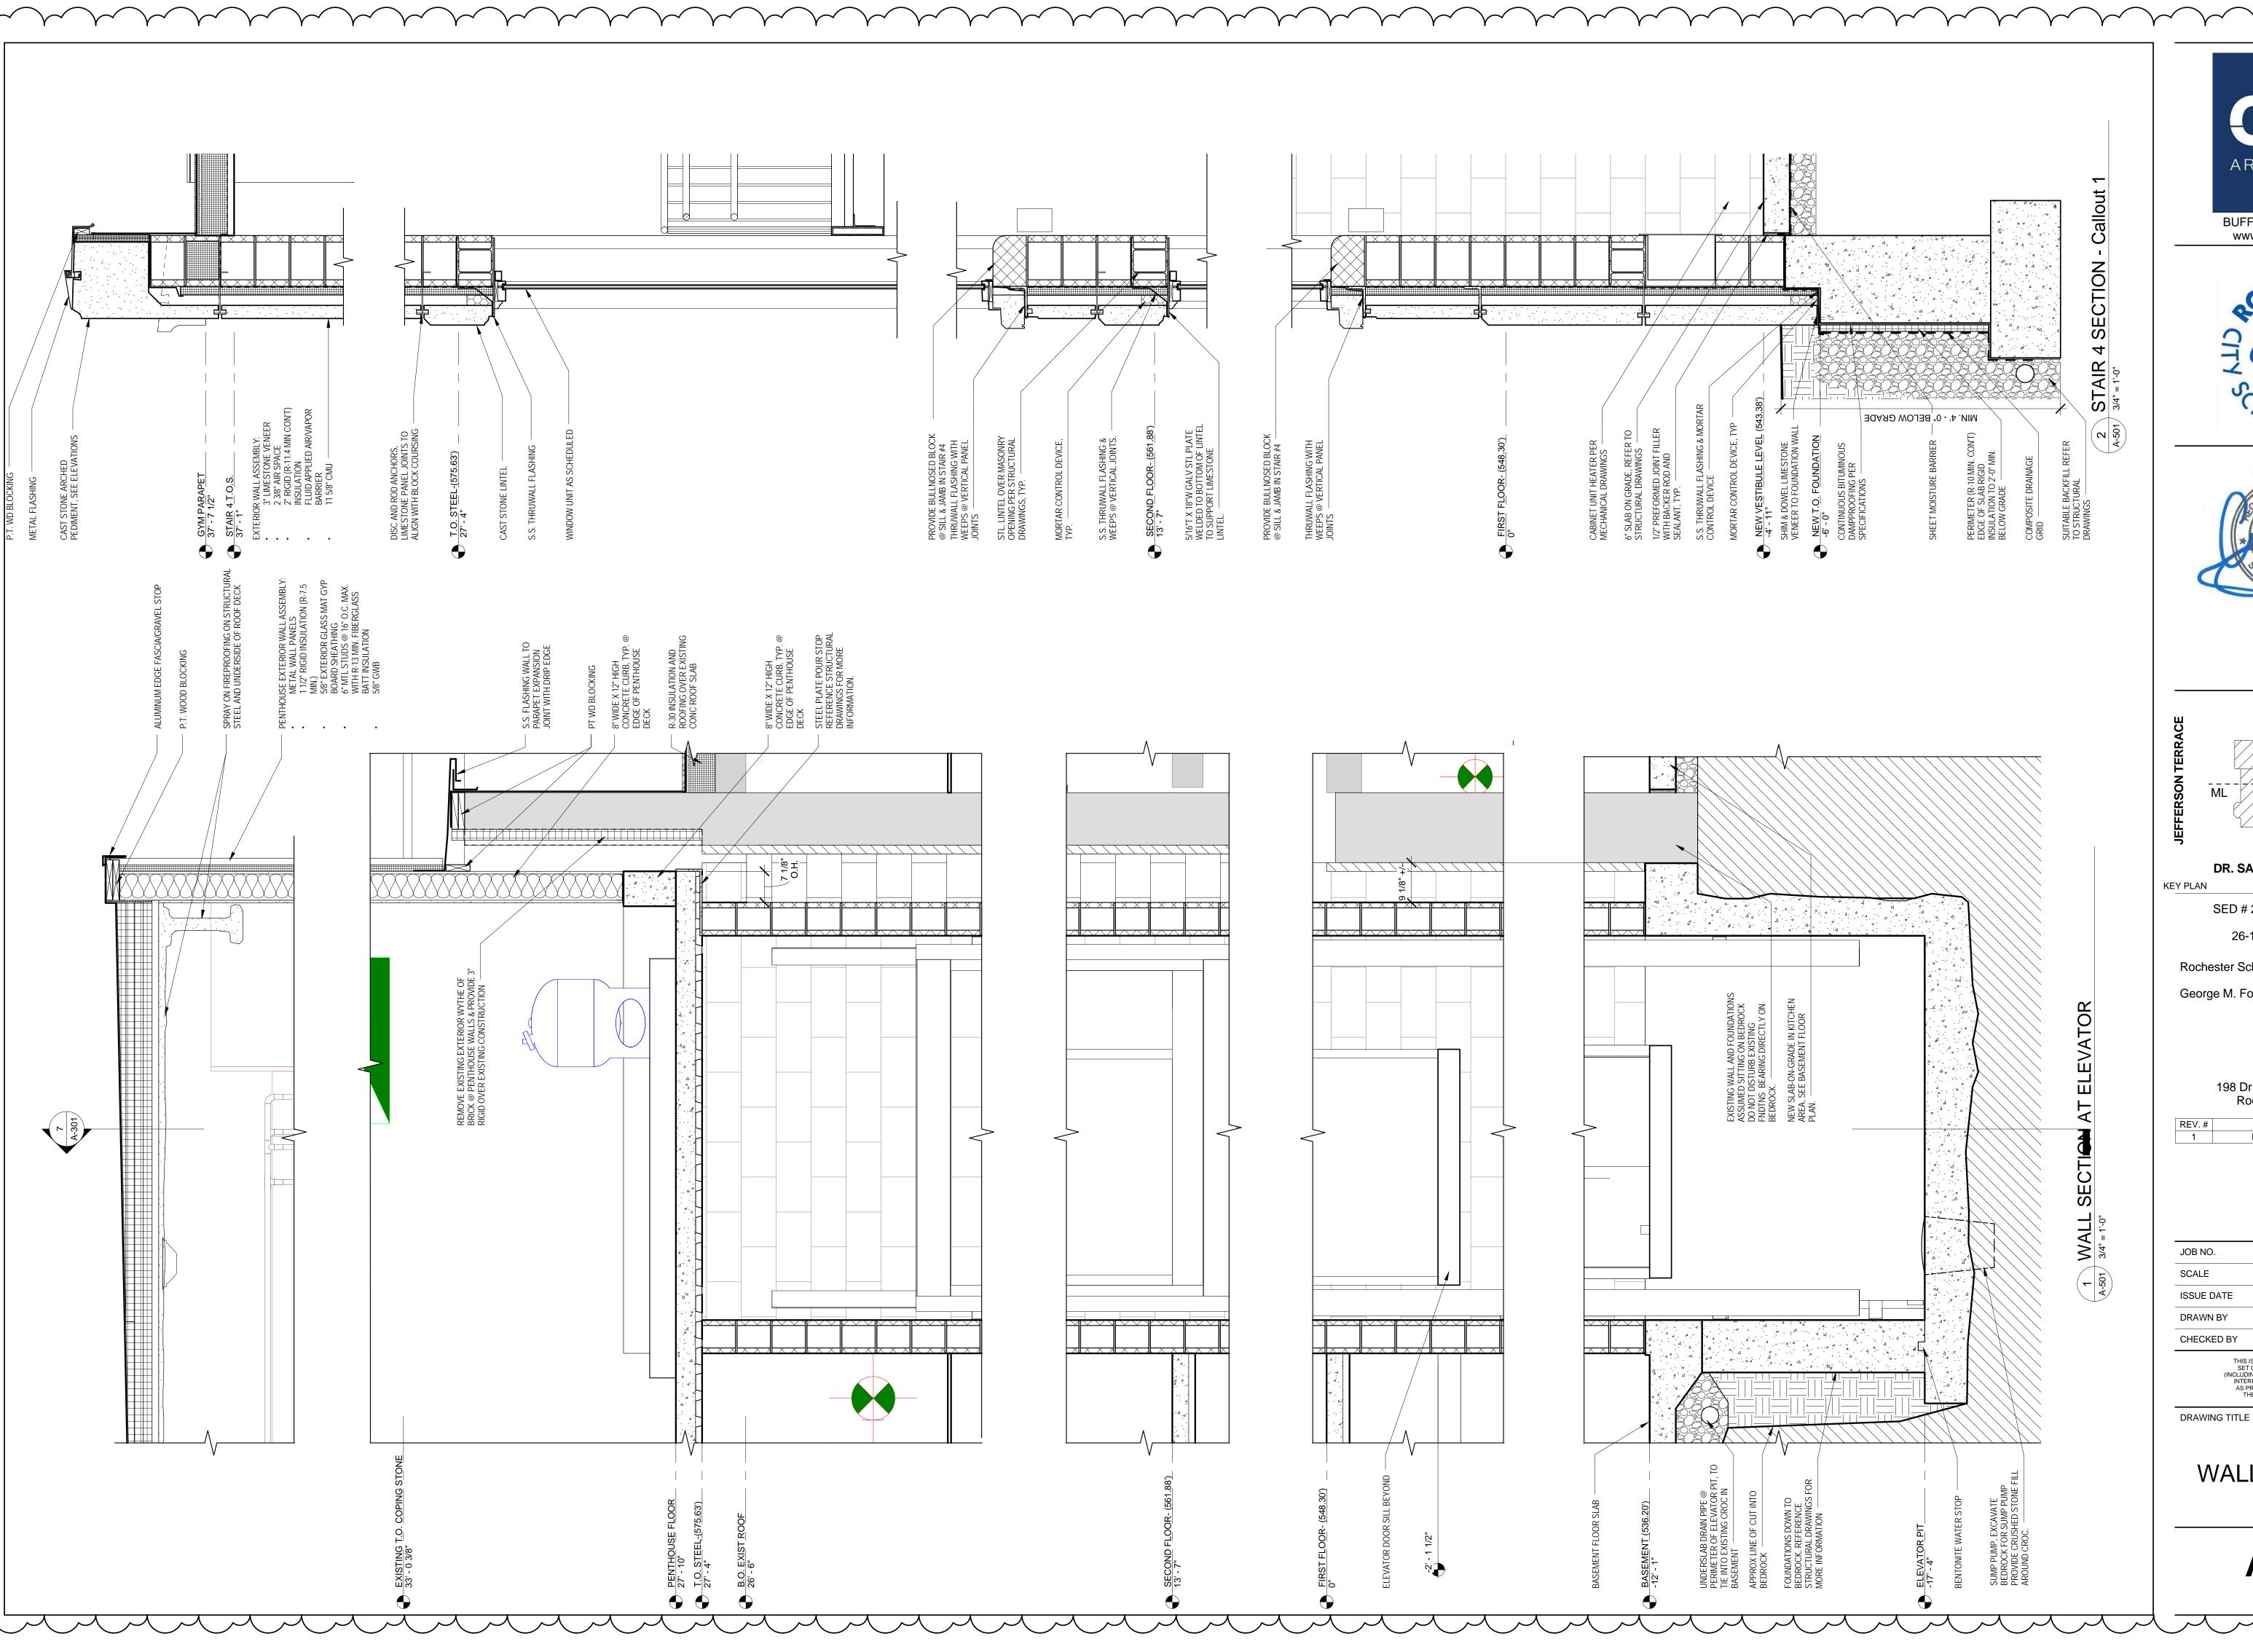





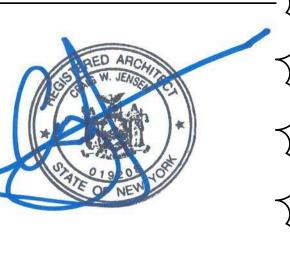

ML B

DR. SAMUEL MCCREE WAY

SED # 26-16-00-01-0-004-024 DWT SED # 26-16-00-01-7-999-020 Rochester Schools Modernization Program

-Phase 2c George M. Forbes- Renovation, Alterations and Addition

> 198 Dr Samuel McCree Way, Rochester, NY 14611

> > DESCRIPTION
> > BID ADDENDA #1

1711\_ 3/4" = 1'-0" 4/9/18

DATE

04/25/18


SINGLE SHEET OF A COHESIVE CONSTRUCTION DOCUMENTS DRAWINGS AND SPECIFICATIONS). ETATION OF THE INFORMATION

THIS IS A SINGLE SHEET OF A COHESIVE SET OF CONSTRUCTION DOCUMENTS (INCLUDING DRAWINGS AND SPECIFICATIONS). INTERPRETATION OF THE INFORMATION AS PRESENTED SHOULD BE BASED ON THE ENTIRE SET OF DOCUMENTS.

WALL SECTIONS

A-501

SSUED FOR BIDD

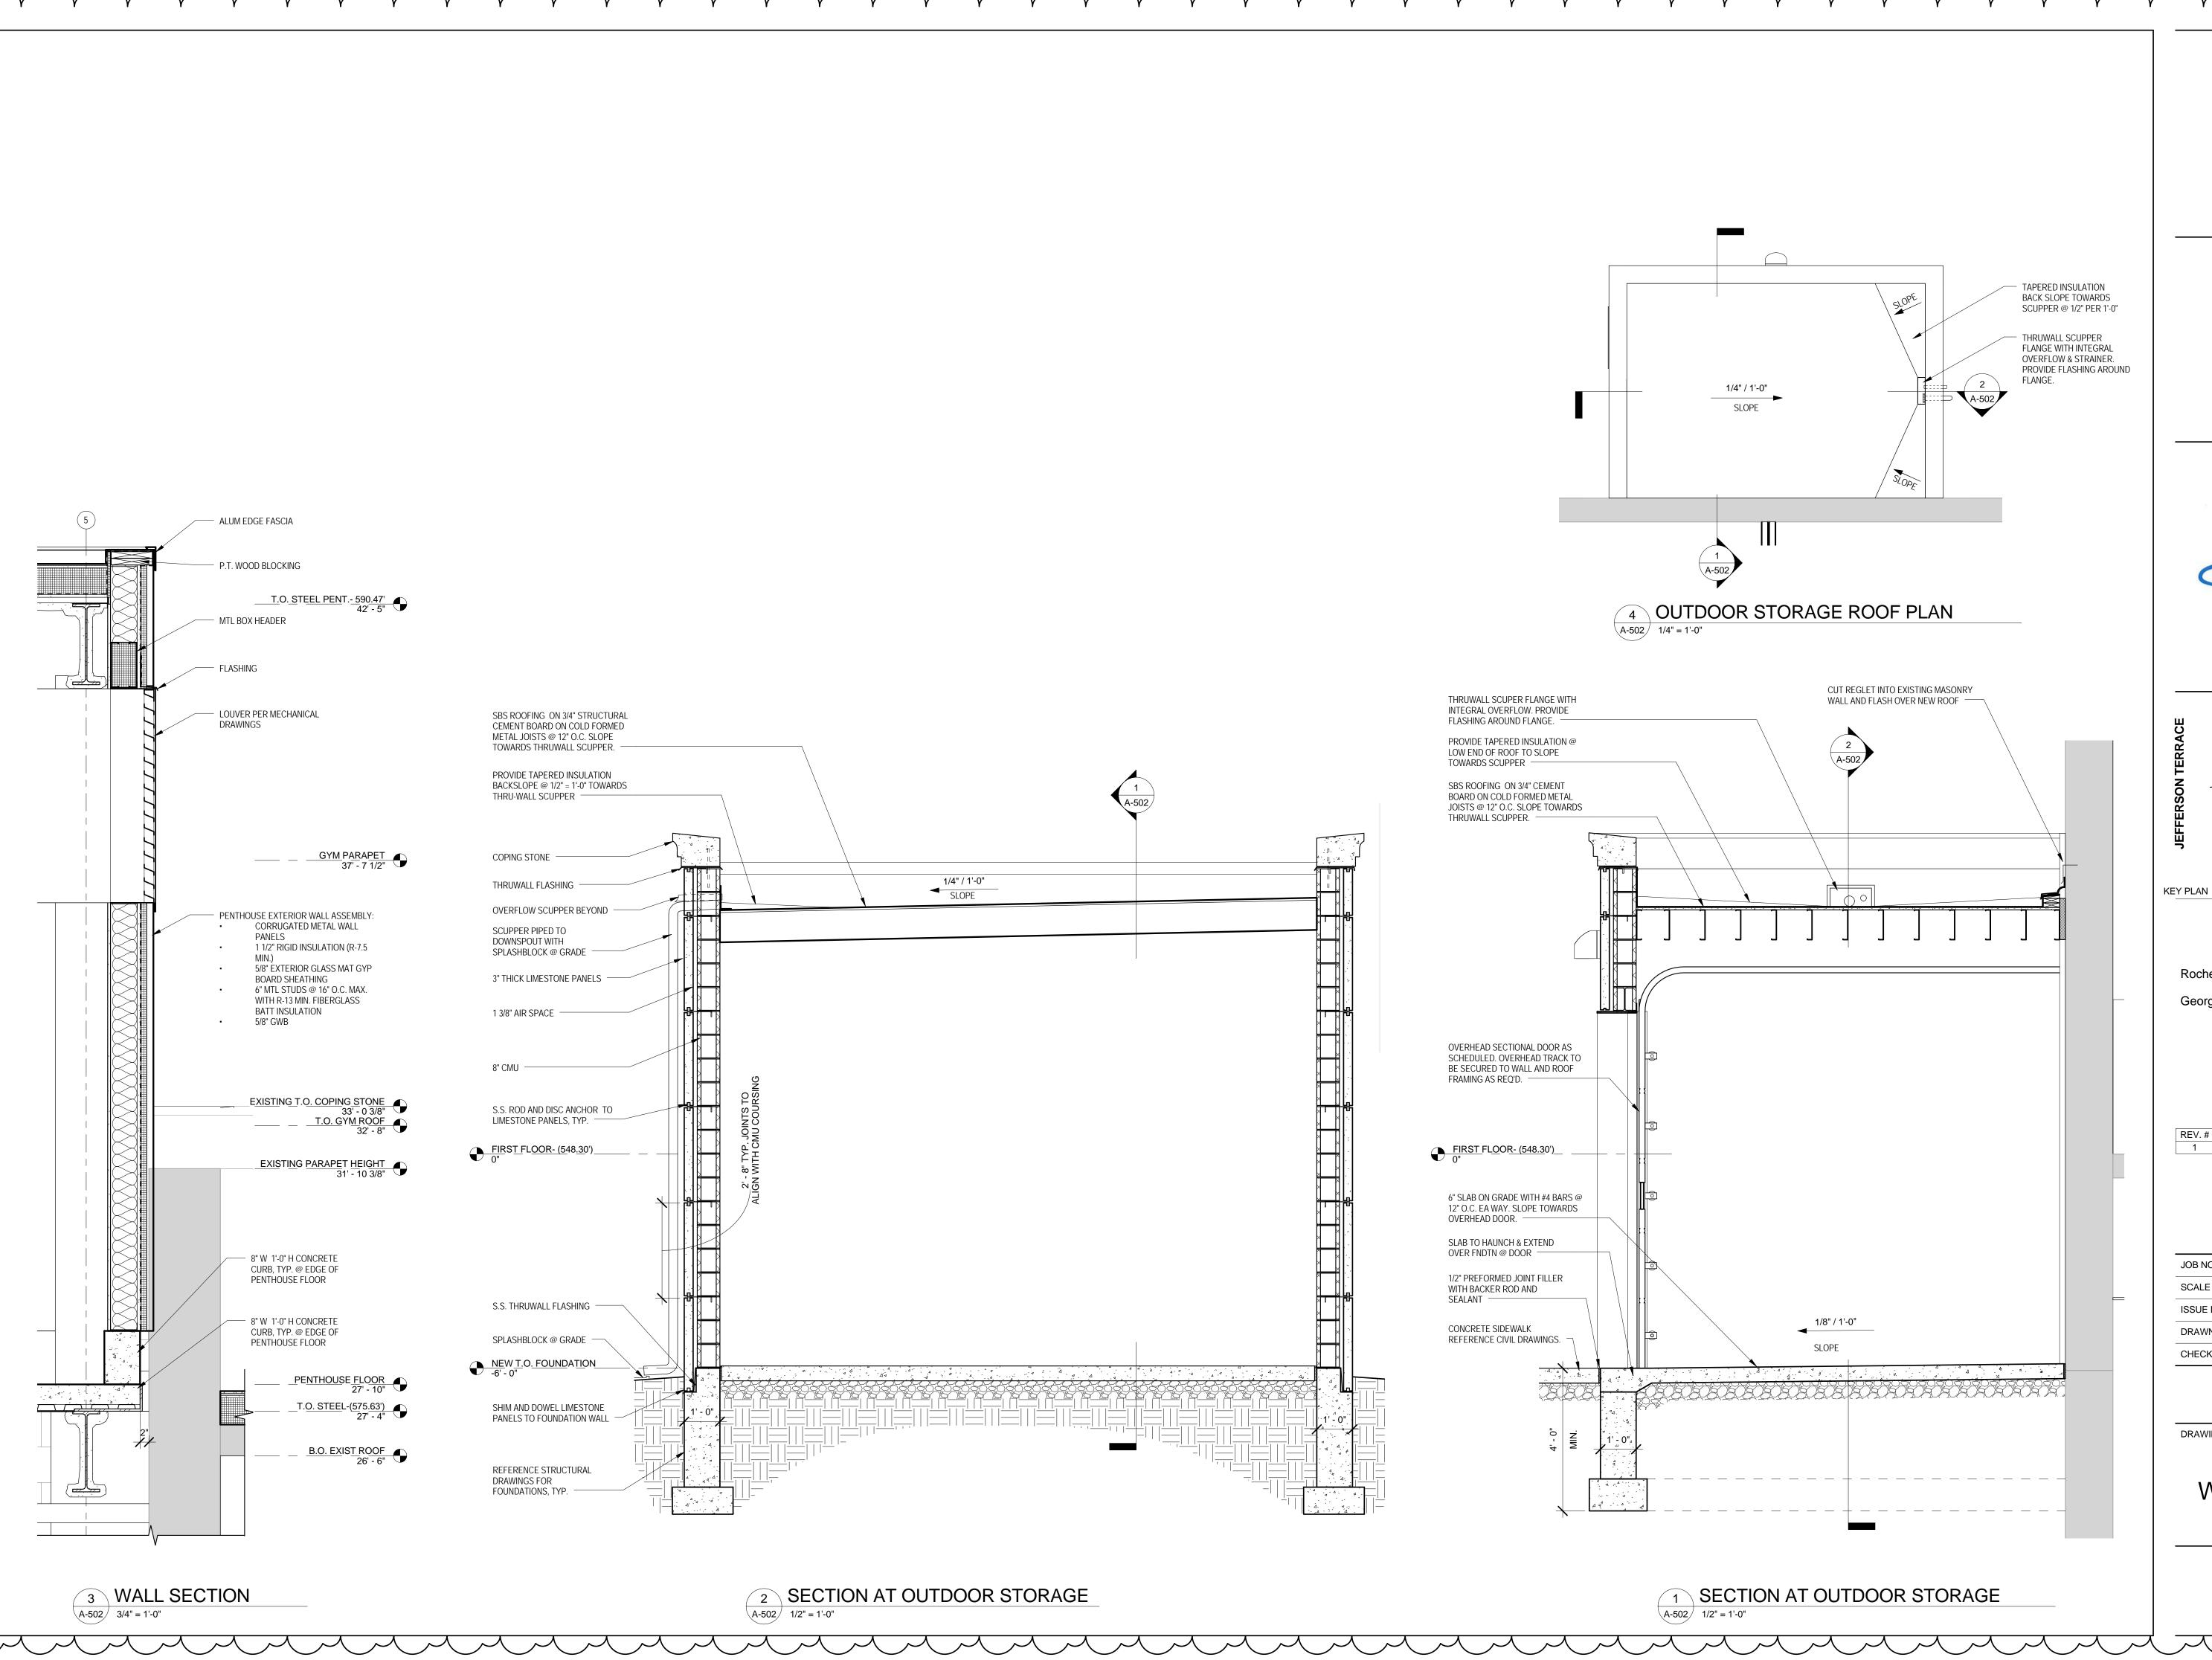







EFFERSON TERRACE

DR. SAMUEL MCCREE WAY

SED # 26-16-00-01-0-004-024 DWT SED #

26-16-00-01-7-999-020

Rochester Schools Modernization Program
-Phase 2c

-Phase 2c
George M. Forbes- Renovation, Alterations and Addition

198 Dr Samuel McCree Way, Rochester, NY 14611

REV. # DESCRIPTION DATE
1 BID ADDENDA #1 04/25/18

JOB NO. 1711

SCALE As indicated

ISSUE DATE 4/9/18

DRAWN BY Author


CHECKED BY Checker

THIS IS A SINGLE SHEET OF A COHESIVE SET OF CONSTRUCTION DOCUMENTS (INCLUDING DRAWINGS AND SPECIFICATIONS). INTERPRETATION OF THE INFORMATION AS PRESENTED SHOULD BE BASED ON THE ENTIRE SET OF DOCUMENTS.

DRAWING TITLE

WALL SECTIONS

A-502

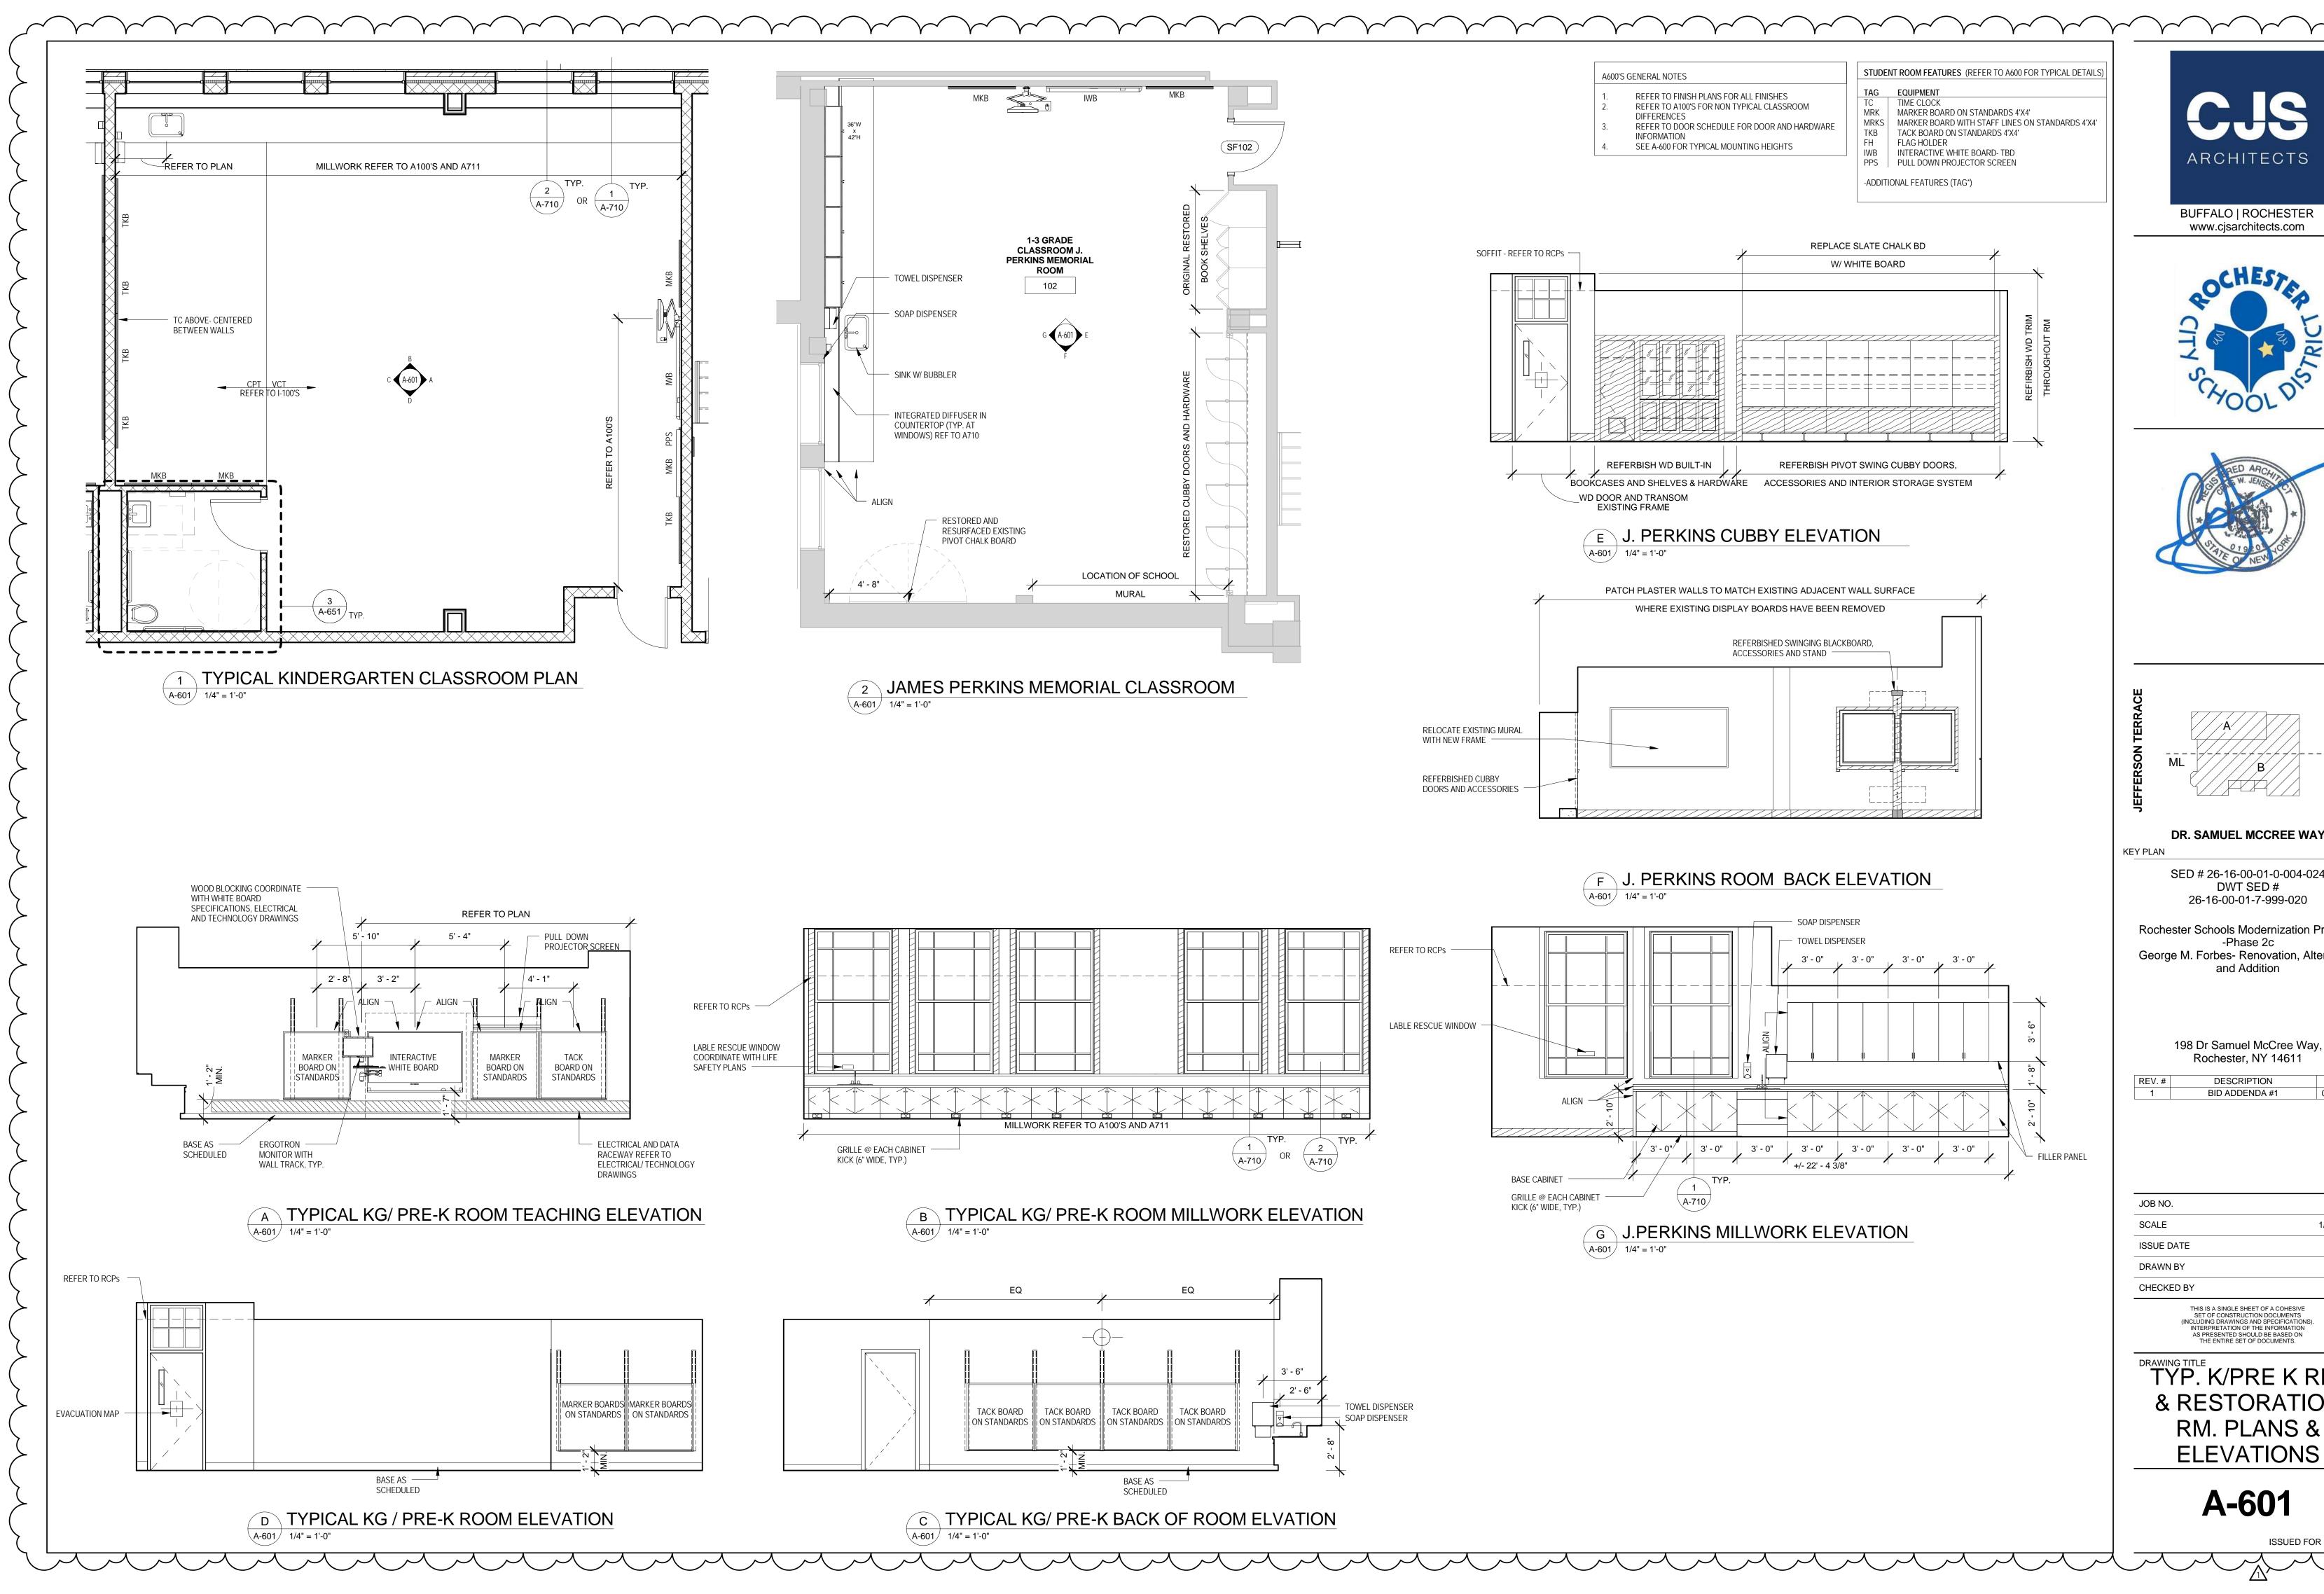



BUFFALO | ROCHESTER www.cjsarchitects.com





DR. SAMUEL MCCREE WAY

SED # 26-16-00-01-0-004-024 DWT SED# 26-16-00-01-7-999-020

Rochester Schools Modernization Program -Phase 2c

George M. Forbes- Renovation, Alterations and Addition

> 198 Dr Samuel McCree Way, Rochester, NY 14611


DATE DESCRIPTION BID ADDENDA #1 04/25/18

1711 1/4" = 1'-0" 4/9/18 Author Checker

> THIS IS A SINGLE SHEET OF A COHESIVE SET OF CONSTRUCTION DOCUMENTS (INCLUDING DRAWINGS AND SPECIFICATIONS). INTERPRETATION OF THE INFORMATION AS PRESENTED SHOULD BE BASED ON THE ENTIRE SET OF DOCUMENTS.

TYP. K/PRE K RM. & RESTORATION RM. PLANS &

A-601

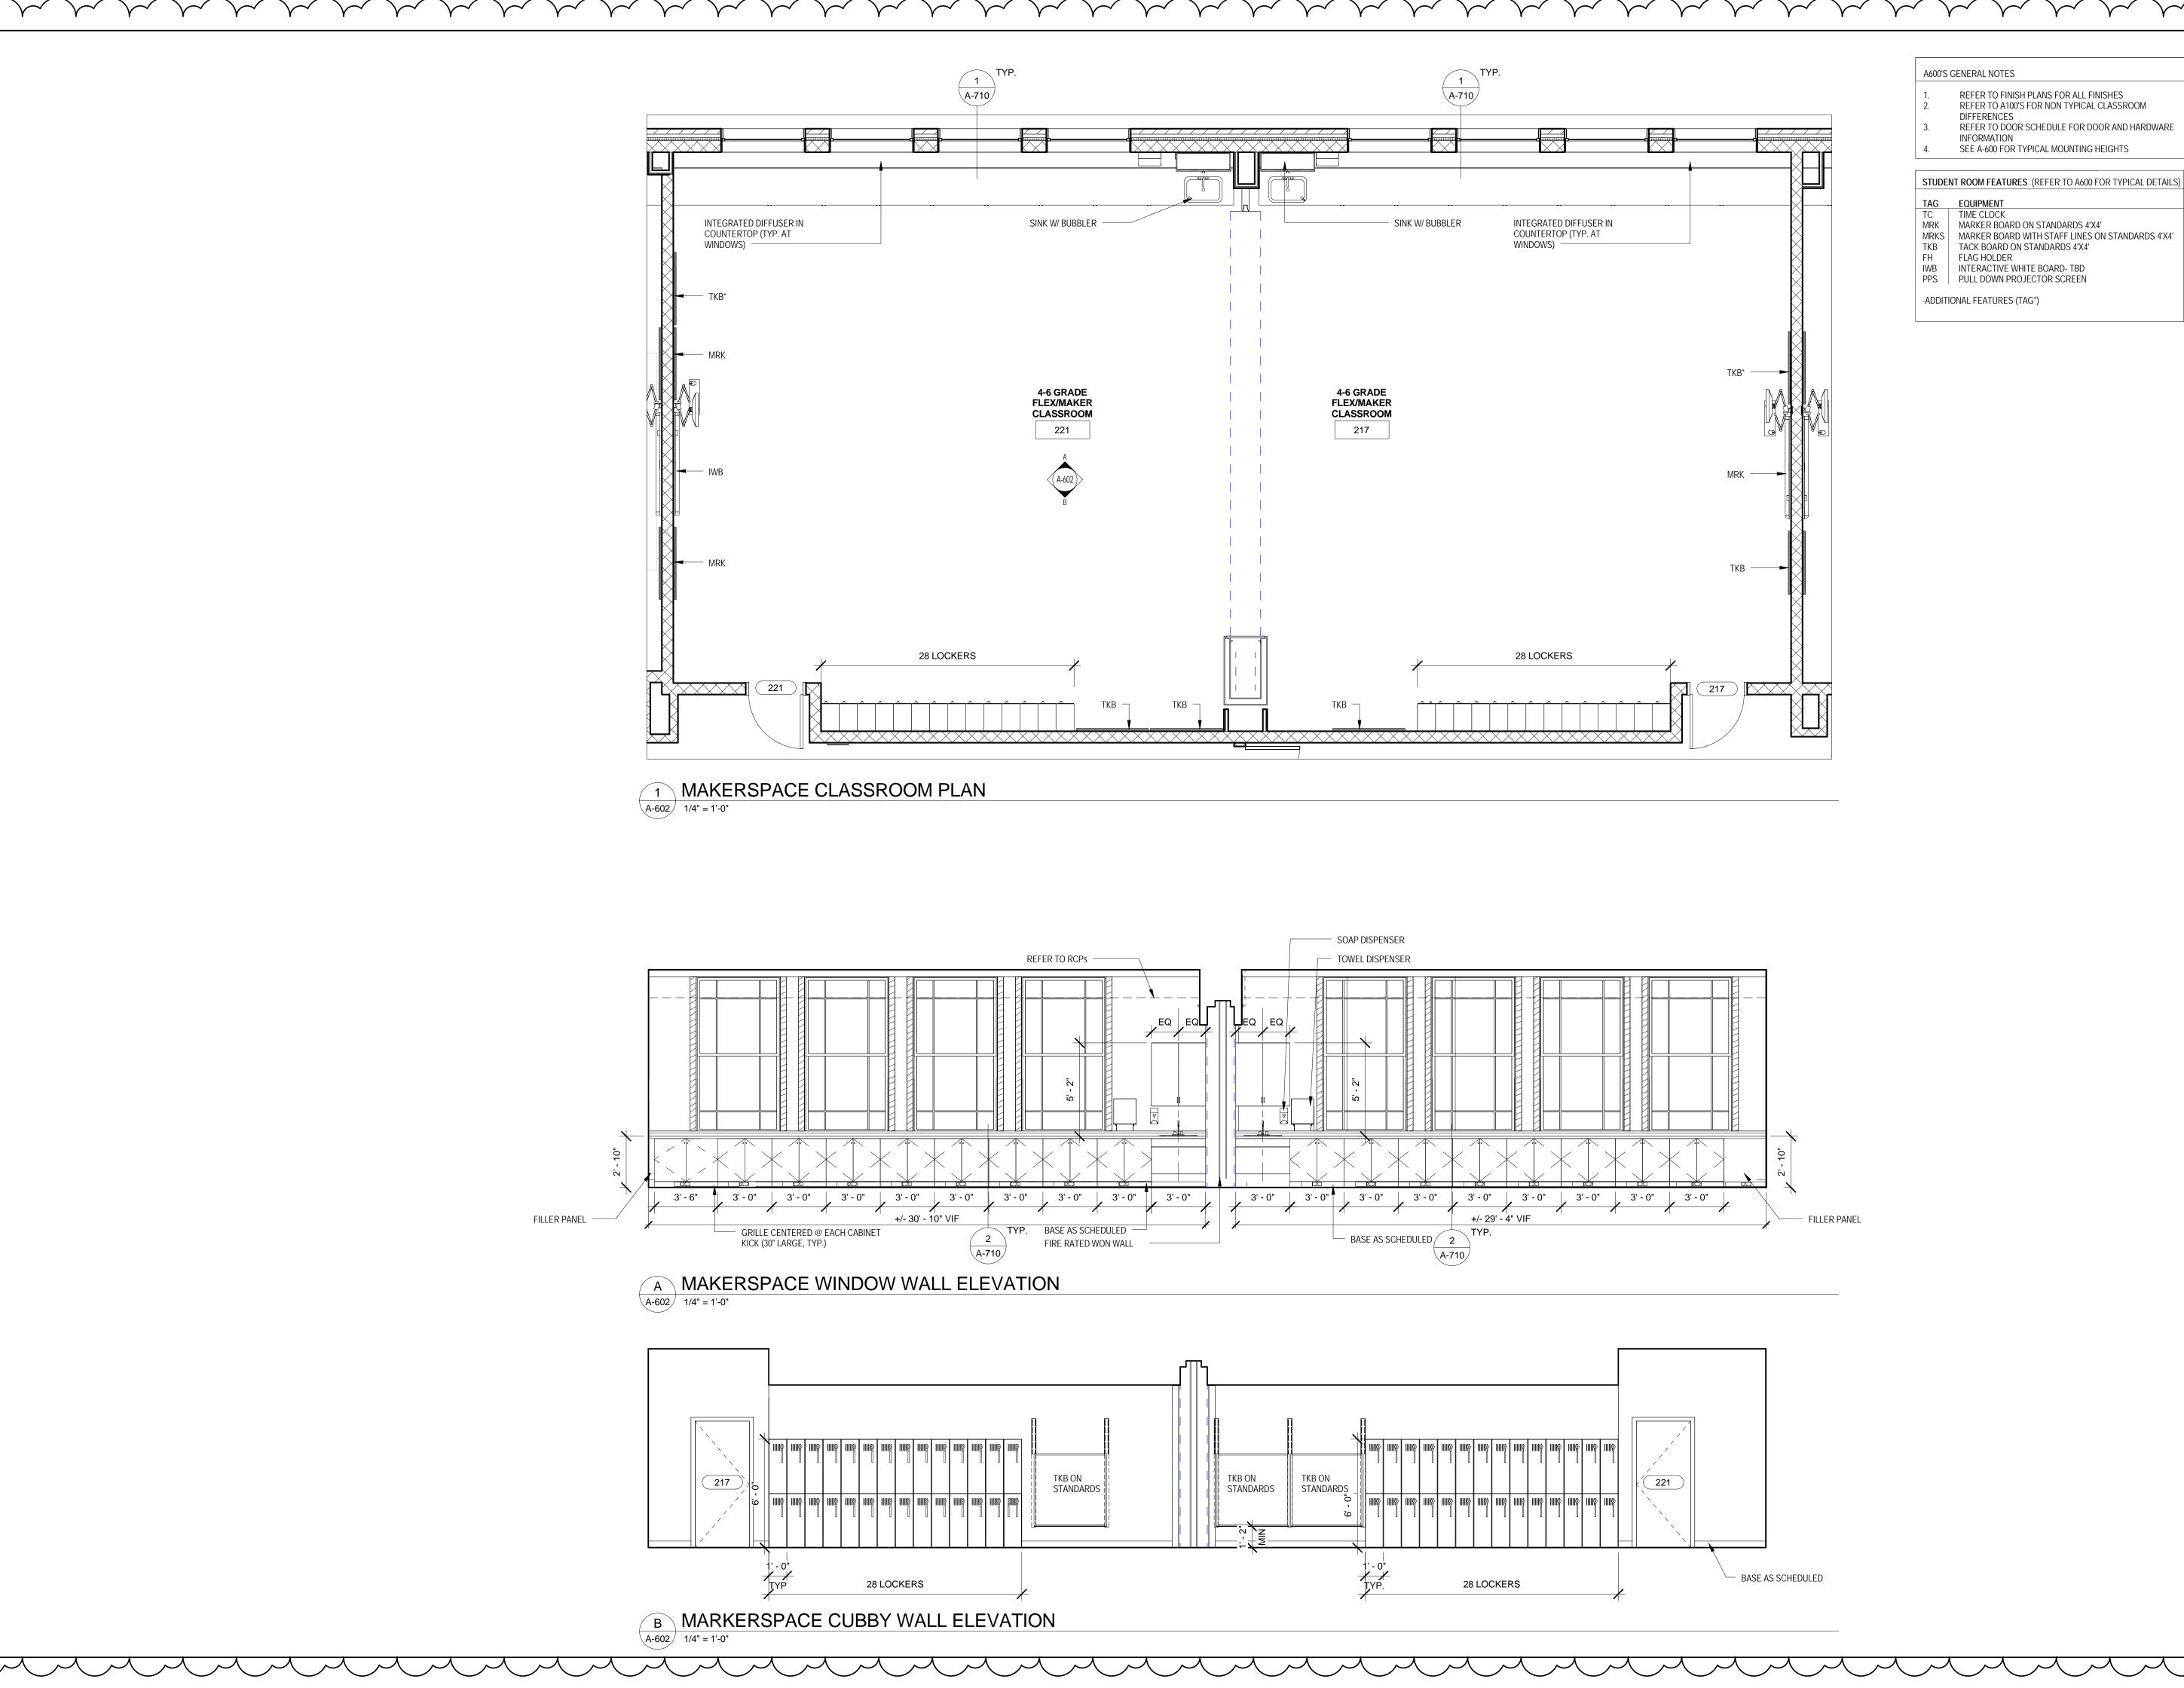

FINISHES
AL CLASSROOM
DOOR AND HARDWARE
G HEIGHTS

ARCHITECTS

BUFFALO | ROCHESTER www.cjsarchitects.com





DR. SAMUEL MCCREE WAY

KEY PLAN

SED # 26-16-00-01-0-004-024 DWT SED # 26-16-00-01-7-999-020

Rochester Schools Modernization Program
-Phase 2c
George M. Forbes- Renovation, Alterations

and Addition

198 Dr Samuel McCree Way, Rochester, NY 14611

 REV. #
 DESCRIPTION
 DATE

 1
 BID ADDENDA #1
 04/25/18

 JOB NO.
 1711

 SCALE
 1/4" = 1'-0"

 ISSUE DATE
 4/9/18


 DRAWN BY
 Author

 CHECKED BY
 Checker

THIS IS A SINGLE SHEET OF A COHESIVE SET OF CONSTRUCTION DOCUMENTS (INCLUDING DRAWINGS AND SPECIFICATIONS). INTERPRETATION OF THE INFORMATION AS PRESENTED SHOULD BE BASED ON THE ENTIRE SET OF DOCUMENTS.

MAKERSPACE
CLASSROOM
PLANS AND
ELEVATIONS

A-602

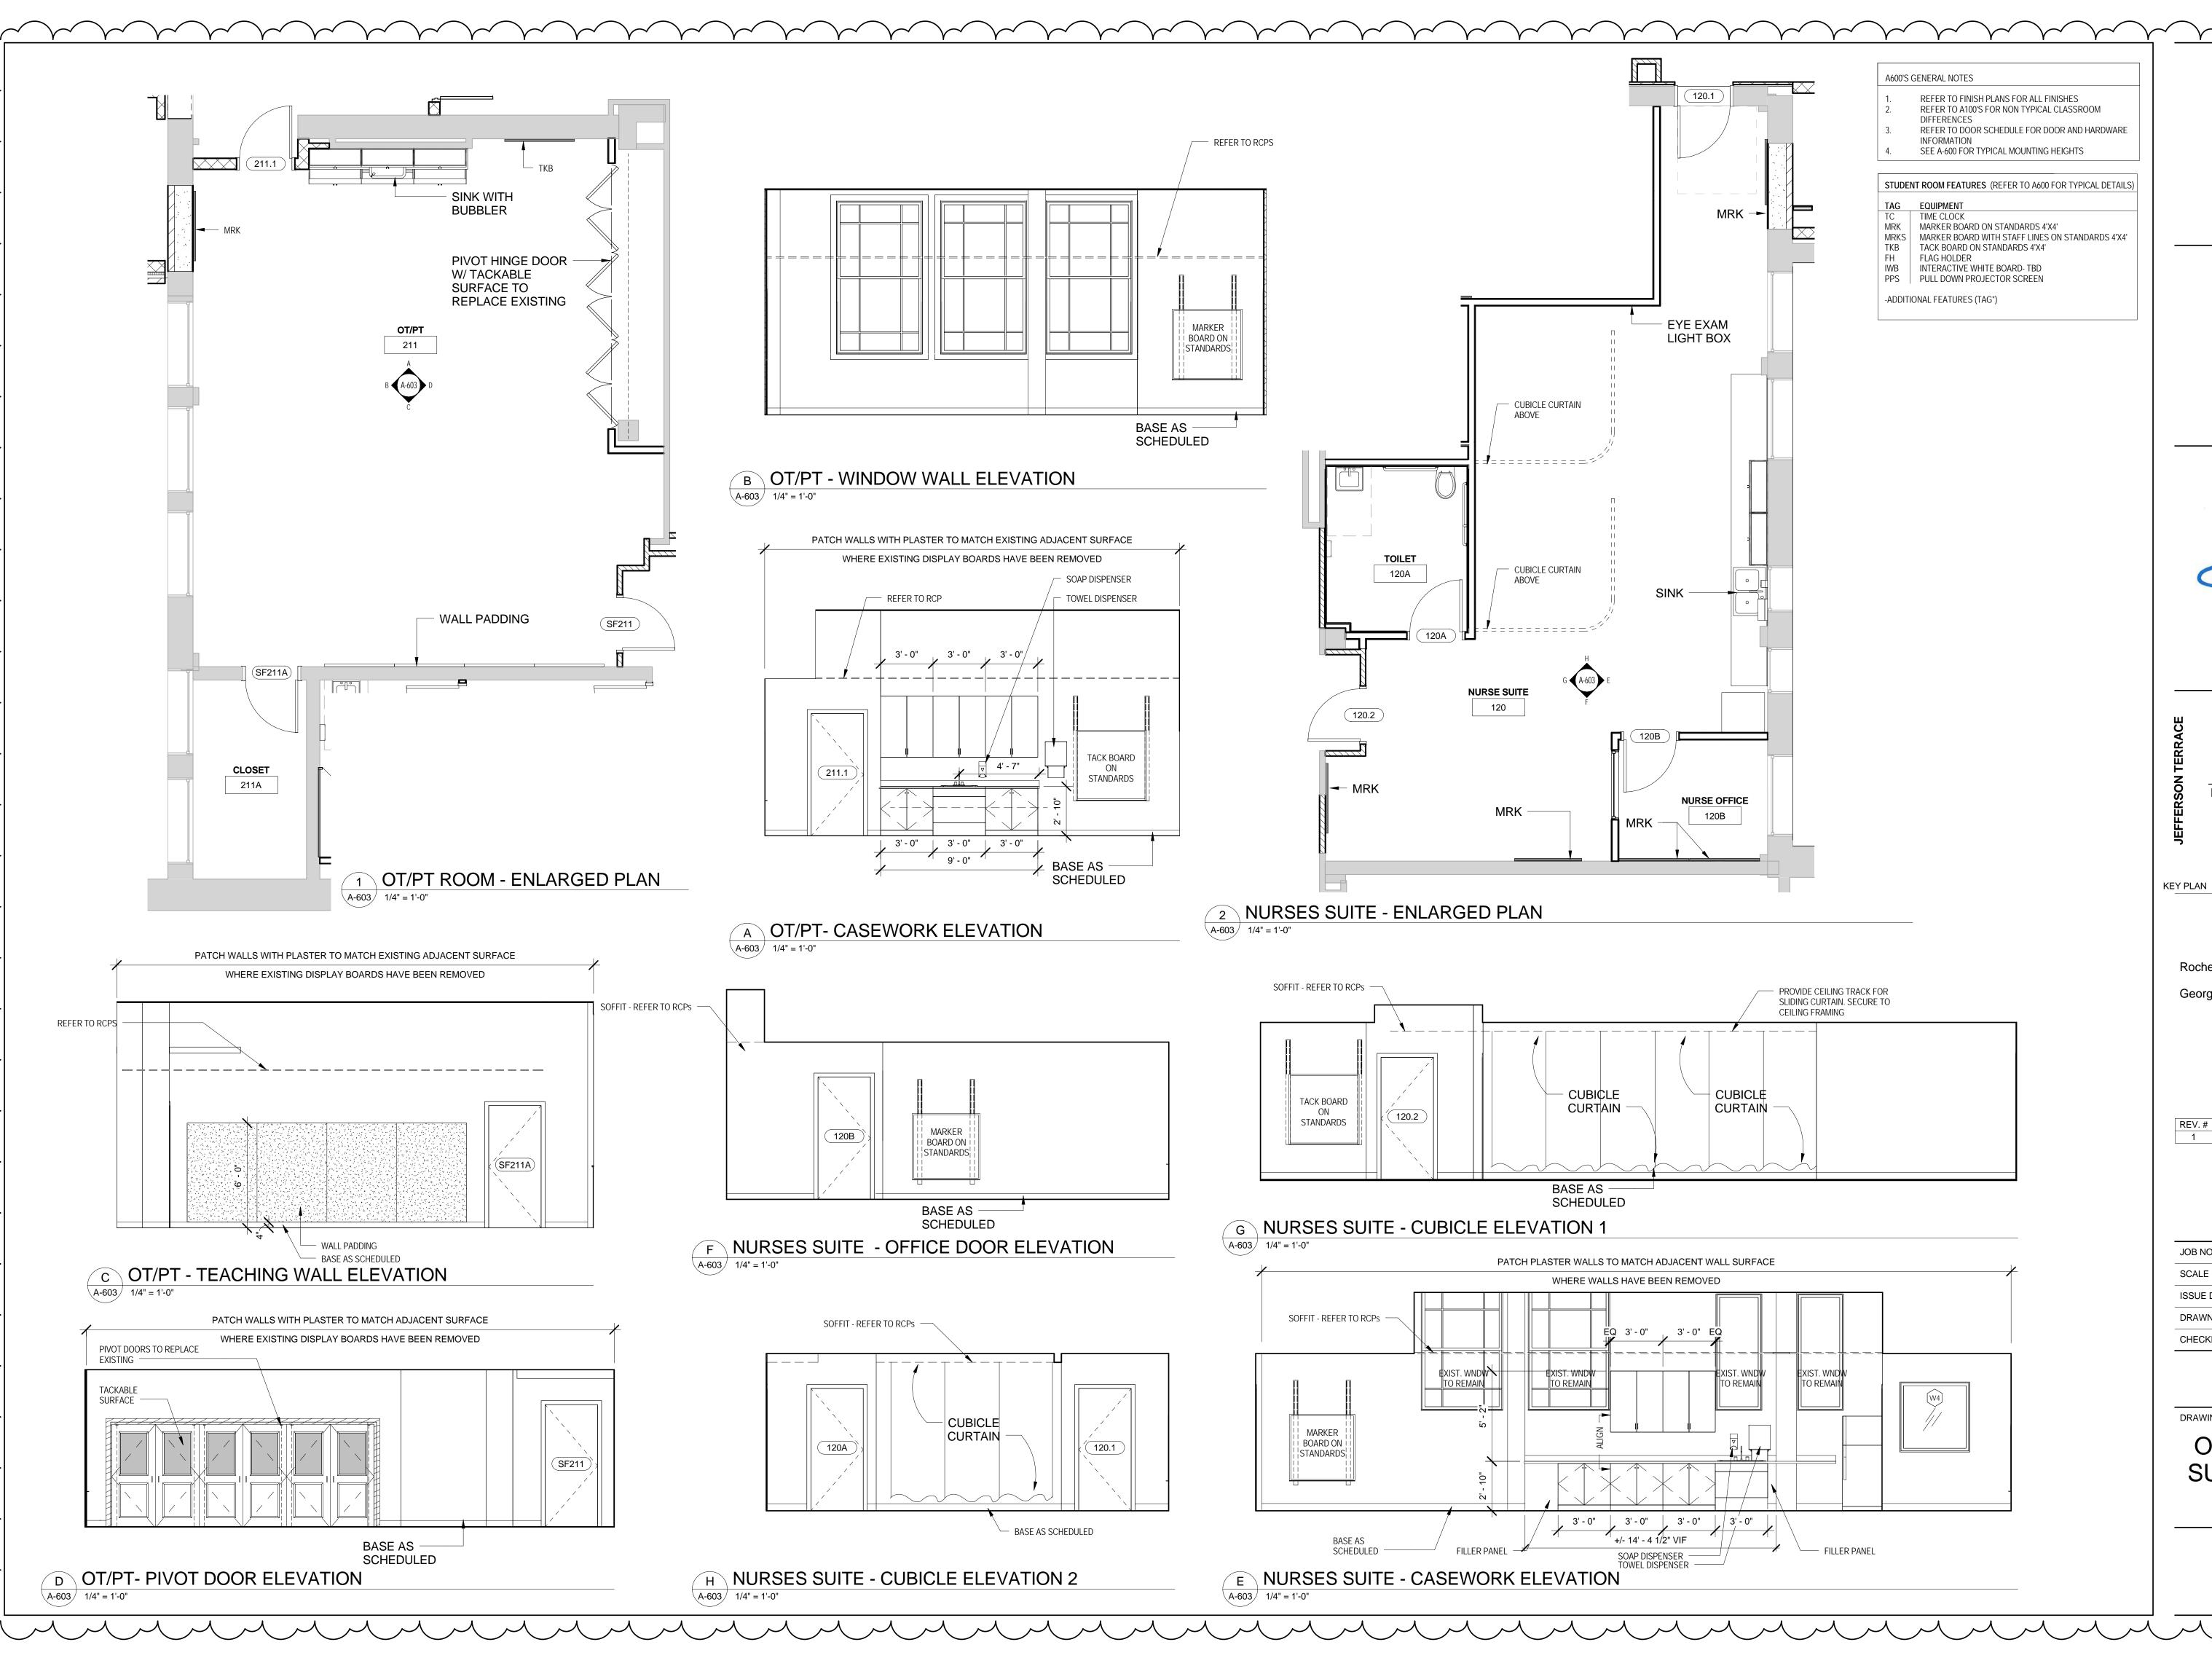




BUFFALO | ROCHESTER www.cjsarchitects.com





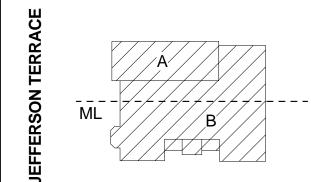

DR. SAMUEL MCCREE WAY

SED # 26-16-00-01-0-004-024 DWT SED# 26-16-00-01-7-999-020

Rochester Schools Modernization Program

-Phase 2c George M. Forbes- Renovation, Alterations and Addition

> 198 Dr Samuel McCree Way, Rochester, NY 14611

REV.#	DESCRIPTION	DATE	
1	BID ADDENDA #1	04/25/18	


JOB NO.		17′
SCALE		1/4" = 1'-
ISSUE D	ATE	4/9/
DRAWN	ВҮ	Auth
CHECKE	D BY	Check
-	THE IS A SINCLE SHEET OF A COHESIVE	

THIS IS A SINGLE SHEET OF A COHESIVE SET OF CONSTRUCTION DOCUMENTS (INCLUDING DRAWINGS AND SPECIFICATIONS). INTERPRETATION OF THE INFORMATION AS PRESENTED SHOULD BE BASED ON THE ENTIRE SET OF DOCUMENTS.

DRAWING TITLE

OT/PT & NURSES SUITE PLANS AND SECTIONS


A-603

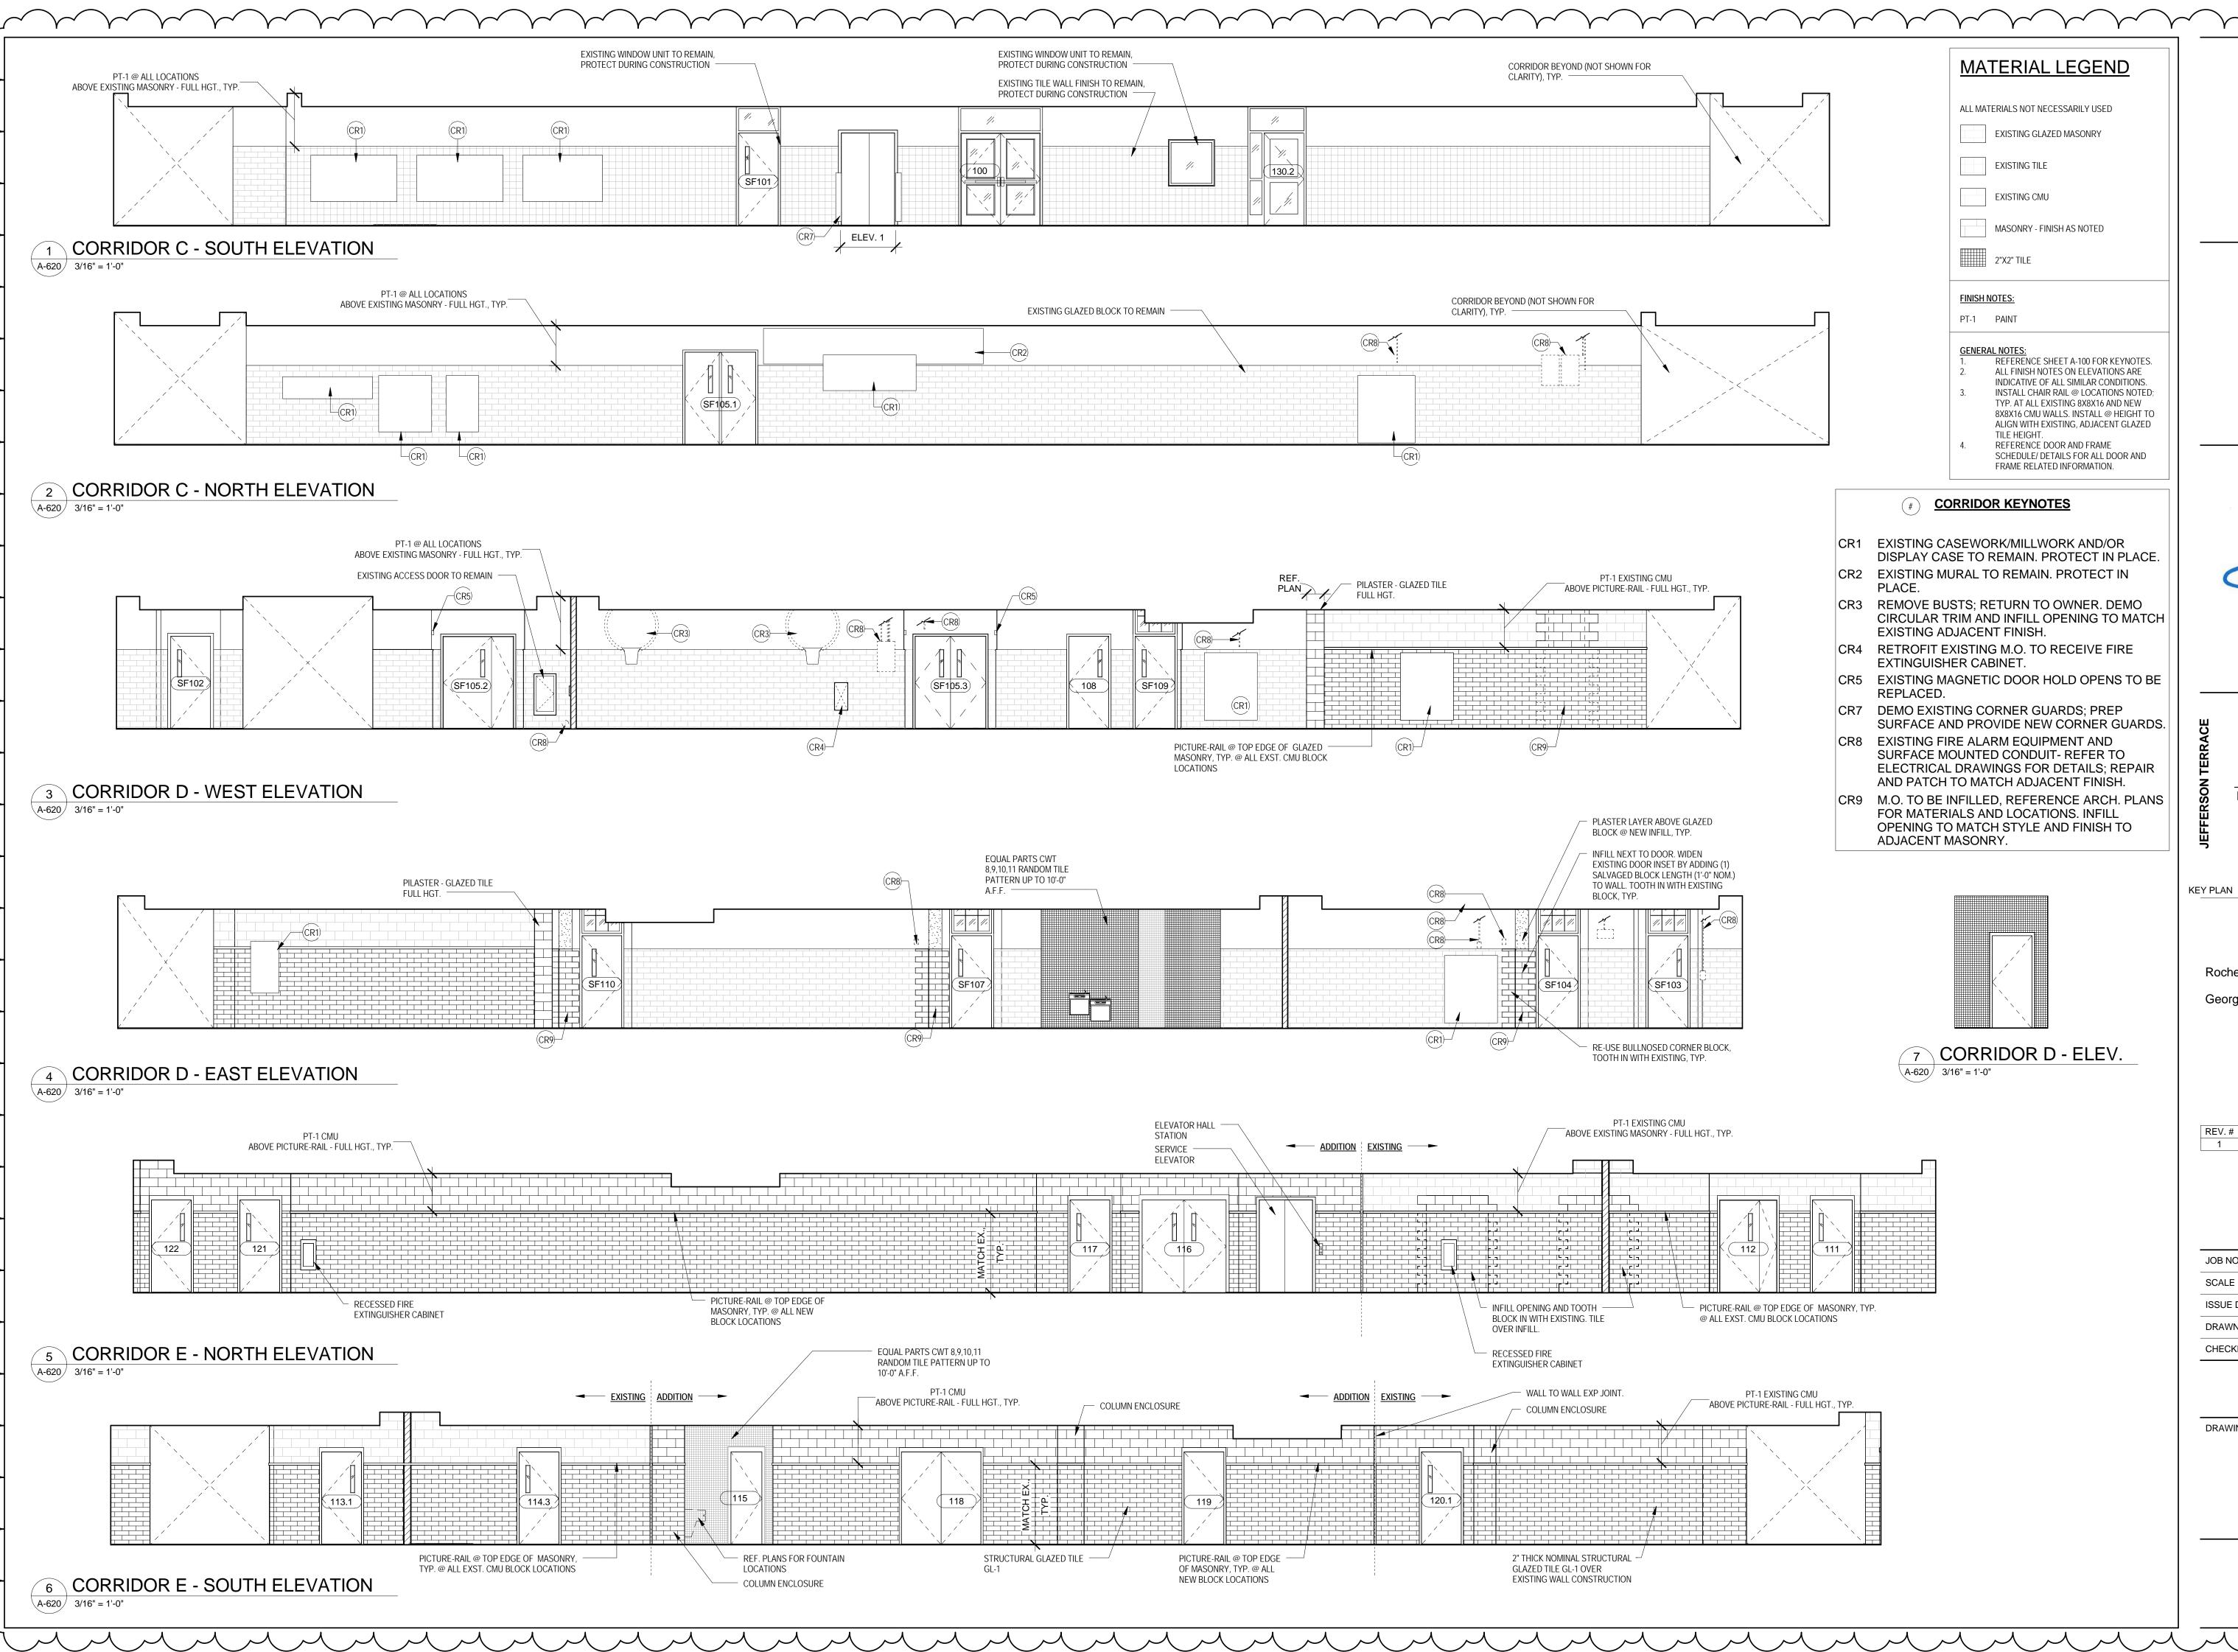




BUFFALO | ROCHESTER

www.cjsarchitects.com

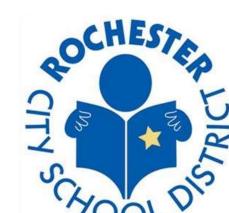



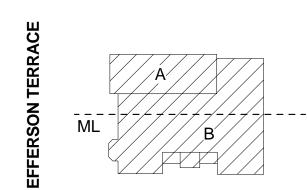

#### DR. SAMUEL MCCREE WAY

SED # 26-16-00-01-0-004-024 DWT SED# 26-16-00-01-7-999-020

Rochester Schools Modernization Program -Phase 2c

George M. Forbes- Renovation, Alterations and Addition

> 198 Dr Samuel McCree Way, Rochester, NY 14611

DATE REV.# DESCRIPTION BID ADDENDA #1 04/25/18


JOB NO.	1711
SCALE	As indicated
ISSUE DATE	4/9/18
DRAWN BY	ETG
CHECKED BY	LM
THIS IS A SINGLE SHEET OF A COHESIVE SET OF CONSTRUCTION DOCUMENTS	

(INCLUDING DRAWINGS AND SPECIFICATIONS). INTERPRETATION OF THE INFORMATION AS PRESENTED SHOULD BE BASED ON THE ENTIRE SET OF DOCUMENTS.

DRAWING TITLE

CORRIDOR **ELEVATIONS** 

A-620

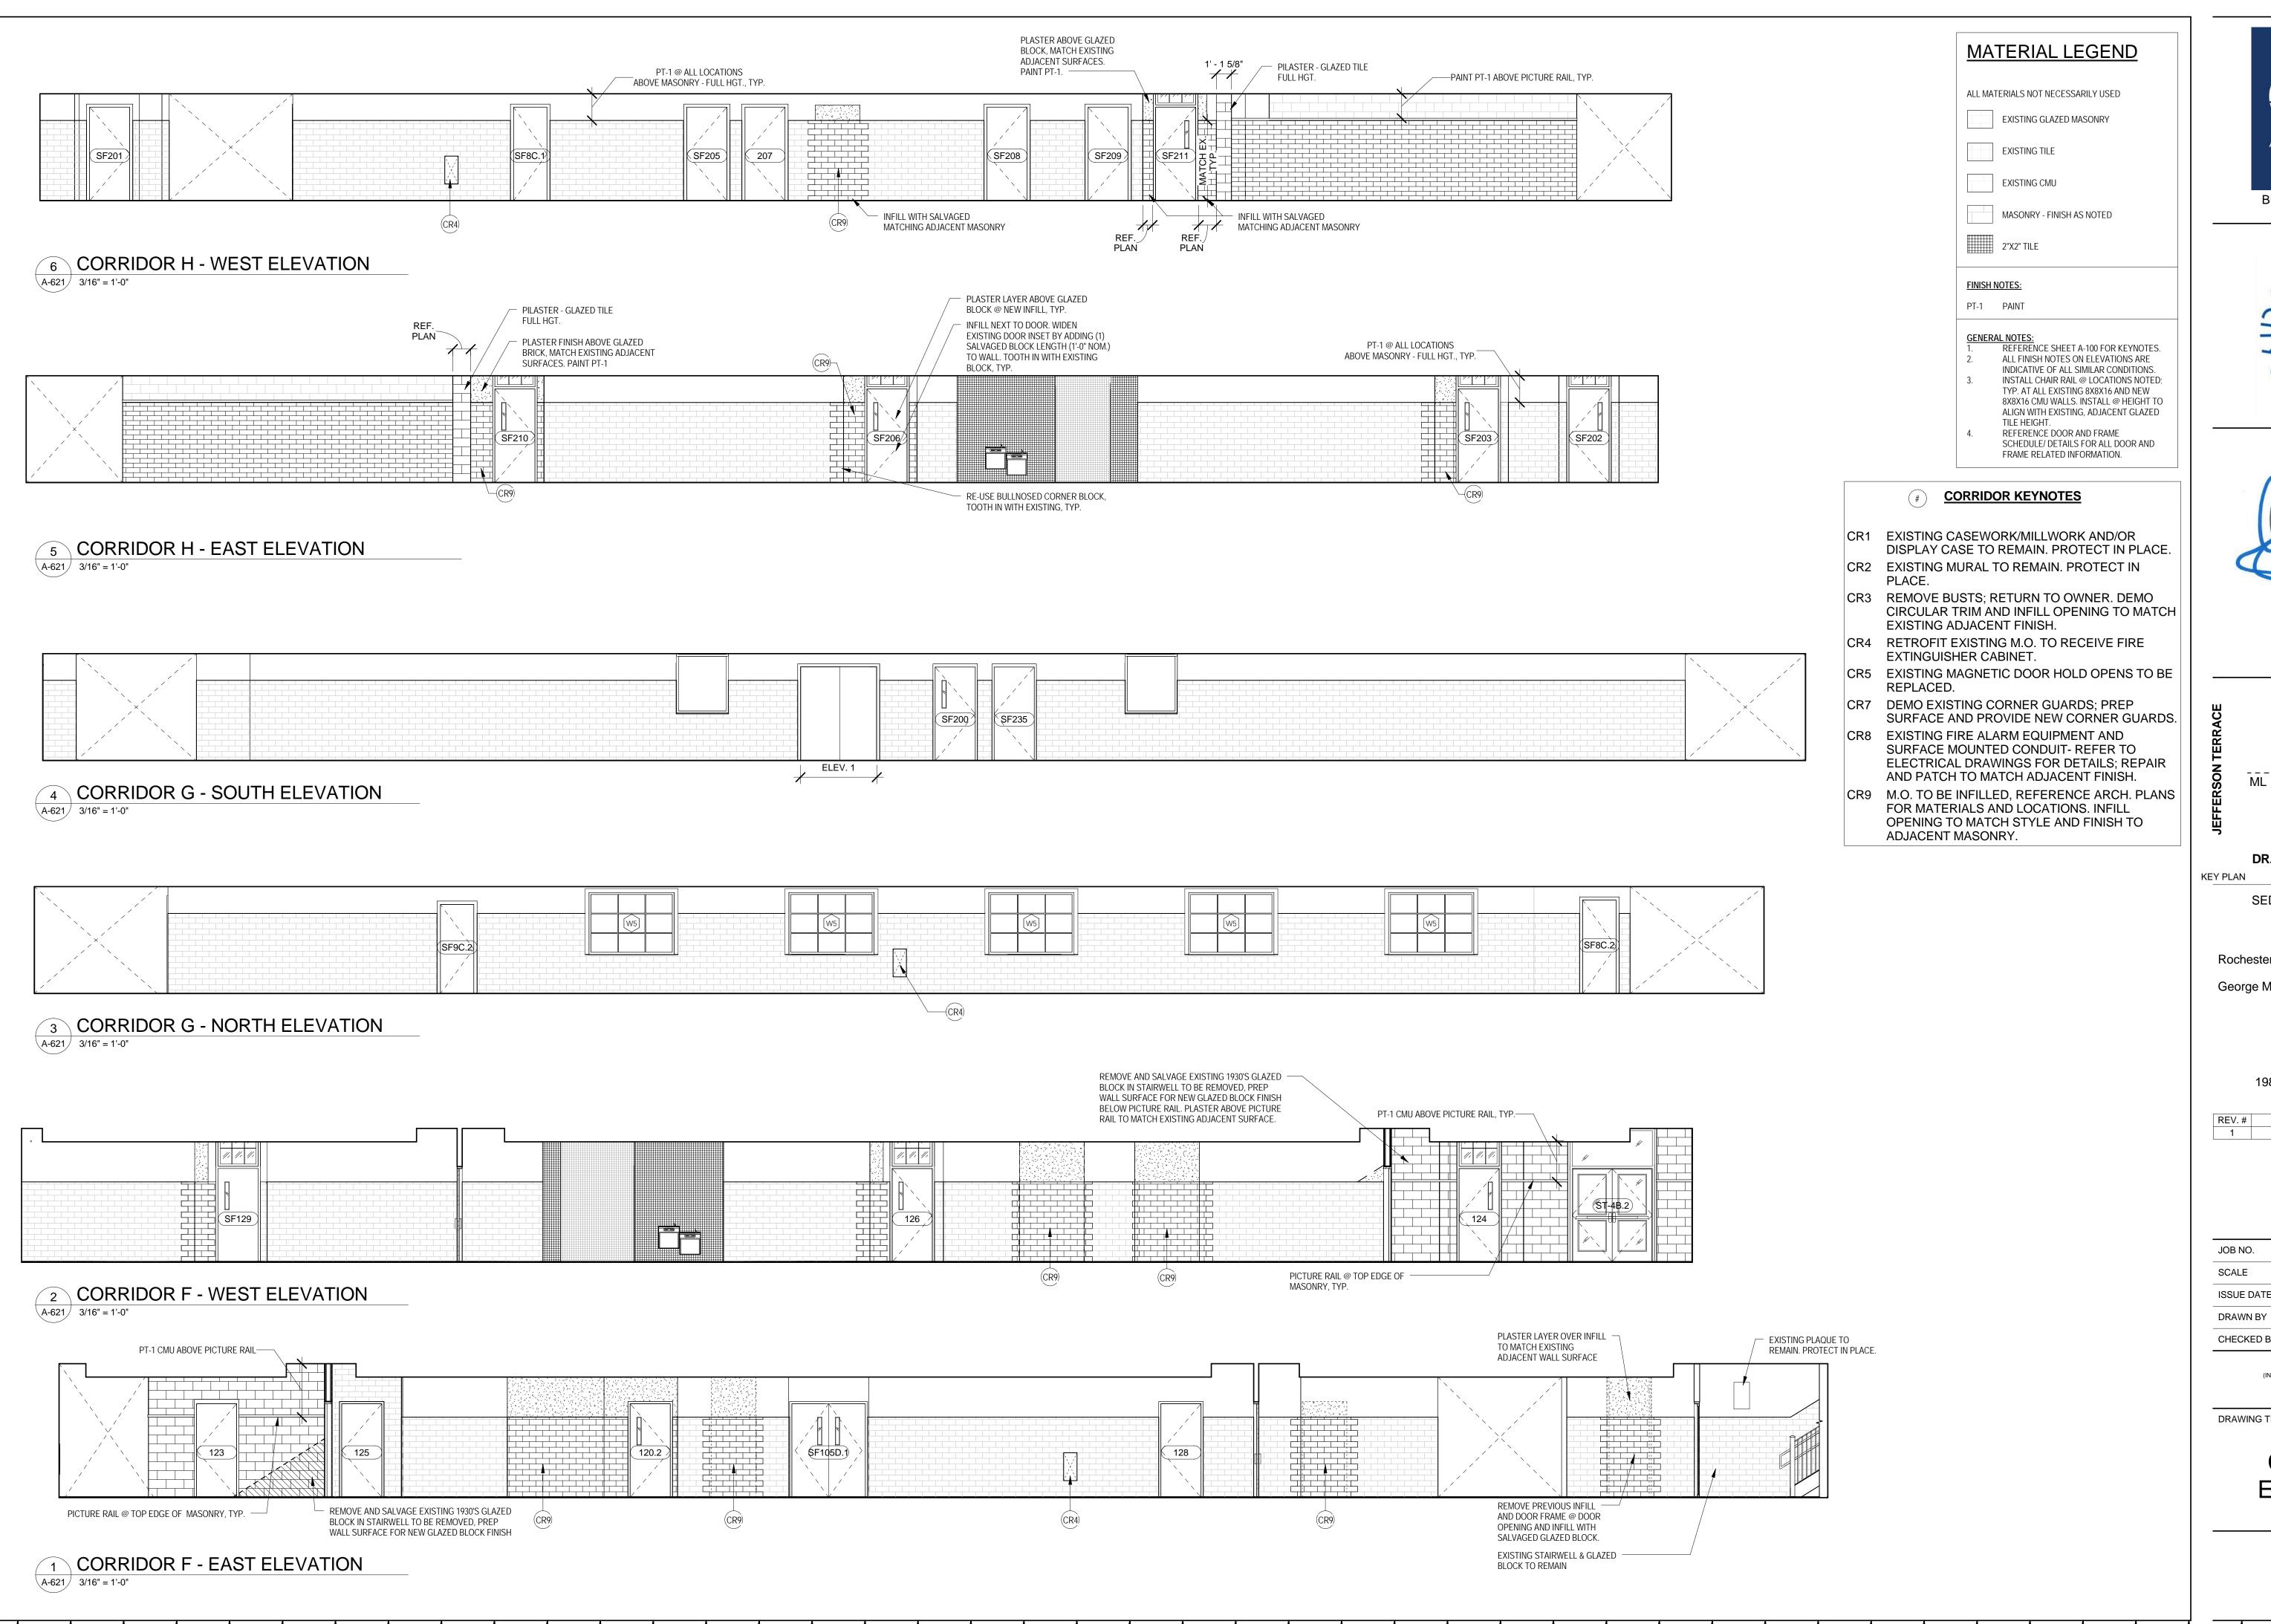

ARCHITECTS BUFFALO | ROCHESTER

www.cjsarchitects.com





DR. SAMUEL MCCREE WAY

SED # 26-16-00-01-0-004-024 DWT SED# 26-16-00-01-7-999-020

Rochester Schools Modernization Program -Phase 2c

George M. Forbes- Renovation, Alterations and Addition

> 198 Dr Samuel McCree Way, Rochester, NY 14611

DESCRIPTION DATE BID ADDENDA #1 04/25/18


As indicated ISSUE DATE 4/9/18 ETG CHECKED BY THIS IS A SINGLE SHEET OF A COHESIVE SET OF CONSTRUCTION DOCUMENTS
(INCLUDING DRAWINGS AND SPECIFICATIONS).
INTERPRETATION OF THE INFORMATION

AS PRESENTED SHOULD BE BASED ON THE ENTIRE SET OF DOCUMENTS.

DRAWING TITLE

CORRIDOR **ELEVATIONS** 

A-621

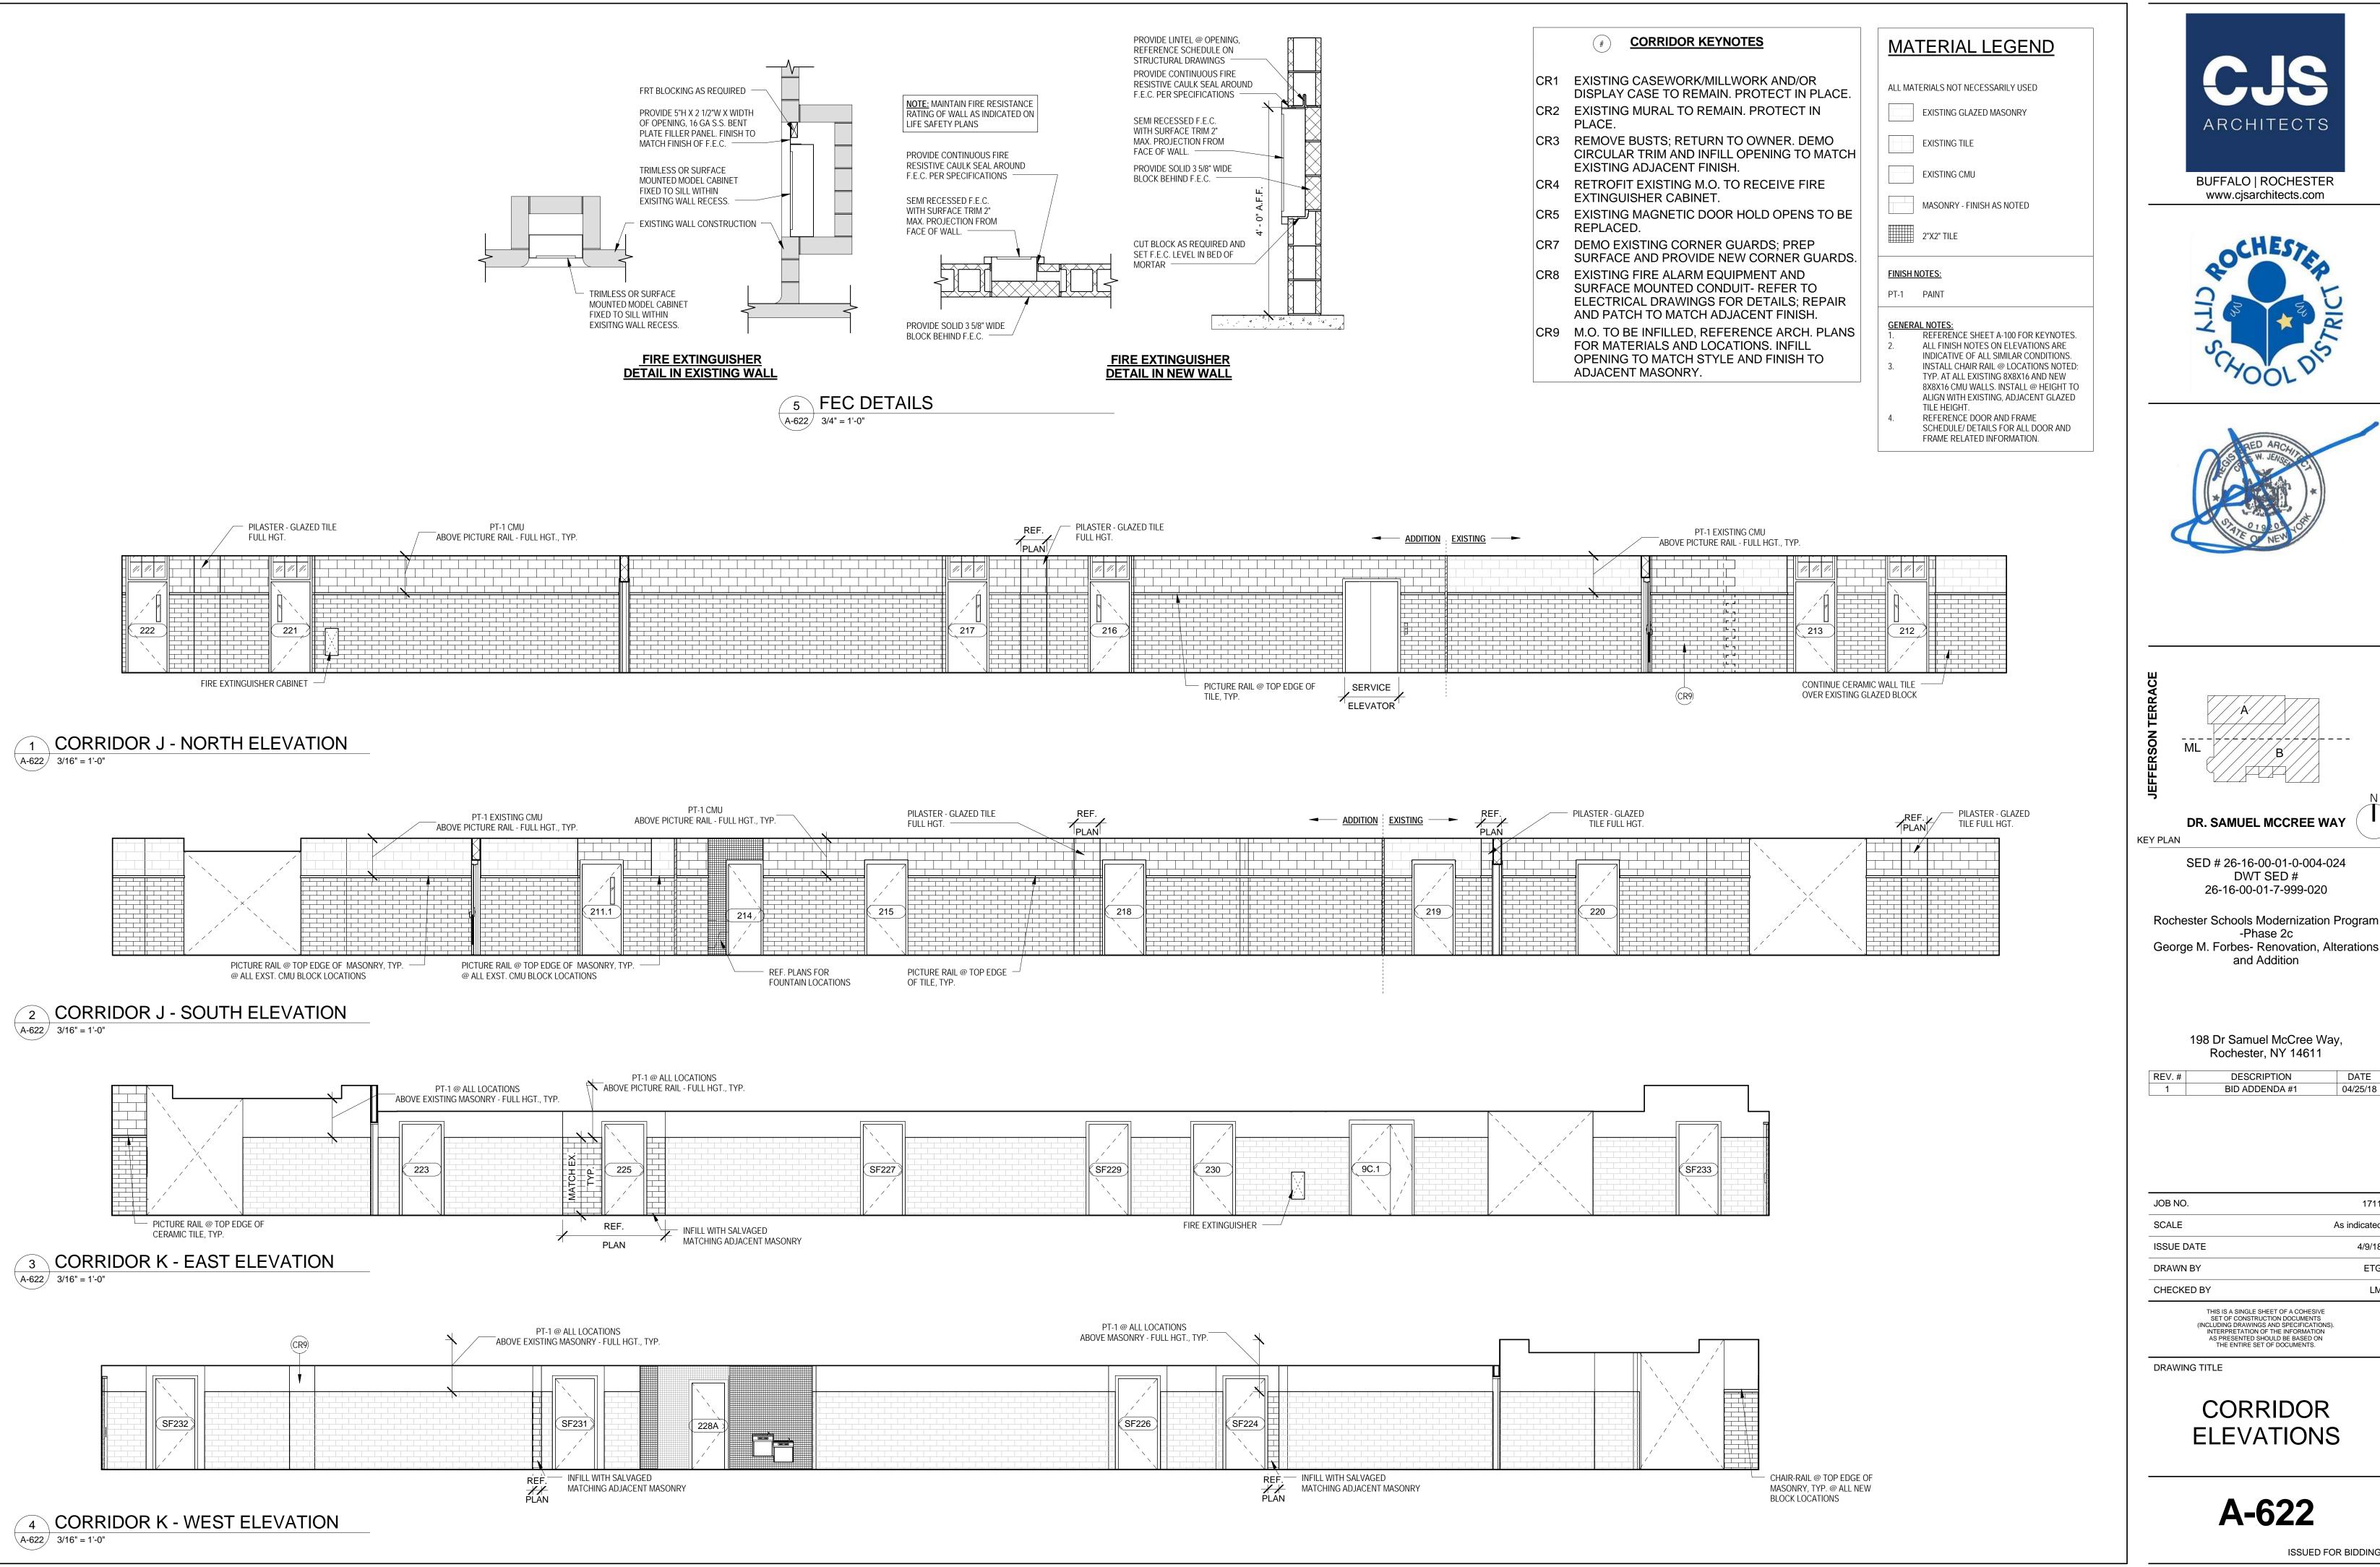






www.cjsarchitects.com



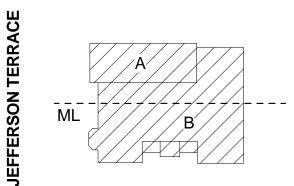

#### DR. SAMUEL MCCREE WAY

KEY PLAN

SED # 26-16-00-01-0-004-024 DWT SED# 26-16-00-01-7-999-020

Rochester Schools Modernization Program -Phase 2c

and Addition

198 Dr Samuel McCree Way, Rochester, NY 14611

REV.#	DESCRIPTION	DATI
1	BID ADDENDA #1	04/25/

JOB NO.	1711
SCALE	As indicated
ISSUE DATE	4/9/18
DRAWN BY	ETG.
CHECKED BY	LM
THIS IS A SINGLE SHEET OF A COHESIVE SET OF CONSTRUCTION DOCUMENTS	

(INCLUDING DRAWINGS AND SPECIFICATIONS)
INTERPRETATION OF THE INFORMATION AS PRESENTED SHOULD BE BASED ON THE ENTIRE SET OF DOCUMENTS.

DRAWING TITLE

CORRIDOR **ELEVATIONS** 

**A-622** 















Prime contractors to reference Kitchen Equipment Drawings as part of their Contract scope of work

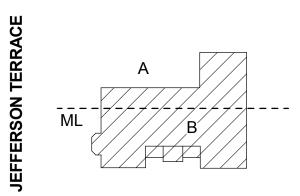

DR. SAMUEL MCCREE WAY

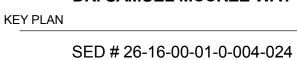

DWT SED # 26-16-00-01-7-999-020

Rochester Schools Modernization Program
-Phase 2c
George M. Forbes- Renovation, Alterations

George M. Forbes- Renovation, Alteration and Addition

198 Dr Samuel McCree Way, Rochester, NY 14611

REV.#	DESCRIPTION	DATE
1	BID ADDENDA #1	04/25/18

JOB NO.	1711
SCALE	1/4" = 1'-0"
ISSUE DATE	3/15/2018
DRAWN BY	EK
CHECKED BY	DT/LR

THIS IS A SINGLE SHEET OF A COHESIVE SET OF CONSTRUCTION DOCUMENTS (INCLUDING DRAWINGS AND SPECIFICATIONS). INTERPRETATION OF THE INFORMATION AS PRESENTED SHOULD BE BASED ON THE ENTIRE SET OF DOCUMENTS.

DRAWING TITLE

BASEMENT -ENLARGED PLAN & LIST

QF-102

				OF 1	MED COLIEDUI E					
QF - MEP SCHEDULE										
		ELECTRICAL		<u> </u>	PLUMBING	GAS	MECHANICAL HVAC EXHAUST	H	VAC MAKE-UP AIR	
TEM NO. QTY DESCRIPTION  .000 7 SHELVING, PLASTIC, LOUVERED  .001 5 SHELVING, PLASTIC, LOUVERED	EQUIPMENT REMARKS SUBJECT SALVEY	CONN.  ELECTRICAL REMARKS	CW SIZE (IN) HW SIZE (IN)	DIR. WASTE SIZE (IN) INDIR. WASTE SIZE (	PLUMBING REMARKS	OAS SIZE (IX)  MECHANICAL REMARKS  MECHANICAL REMARKS	DUCT WIDTH (IN) DUCT DEPTH (IN) DUCT DIA. (IN) VOLUME (CFM)	DUCT WIDTH (IN)	VOLUME (CFM)	HVAC REMARKS
5 SHELVING, PLASTIC, LOUVERED  1 SHELVING, PLASTIC, LOUVERED										
004 1 HAND SINK			1/2" 1/2"	1 1/2"						
.005	5.0 A 120	3 60 DIRECT EMERGENCY PWR REQ'D	1/2"   1/2"	(2")						
.011 1 TEMPERATURE ALARM	5.0 A 120	PWR FROM 1.010. CONN. TO B.A.S. BY CONTROLS DIV.								
.012 1 EVAPORATOR COIL	9.8 A 208	1 60 DIRECT ADD'L 120/1/60 1A AND EMERGENCY PWR REQ'D		1"	TO F.F.D.		1,500 CFM			
.013 1 CONDESING UNIT	LOCATION T.B.C. 12.3 A 208	3 60 DIRECT EMERGENCY PWR REQ'D								
.014 2 SHELVING, PLASTIC, LOUVERED .015 3 SHELVING, PLASTIC, LOUVERED										
.020 1 WALK-IN COOLER	2.0 A 120	1 60 DIRECT EMERGENCY PWR REQ'D								
.021 1 TEMPERATURE ALARM	2.07( 120	PWR FROM 1.020. CONN. TO B.A.S. BY CONTROLS DIV.								
.022 1 EVAPORATOR COIL	0.8 A 120	1 60 DIRECT EMERGENCY PWR REQ'D		1"	TO F.F.D.		1,500 CFM			
.023 1 CONDESING UNIT	LOCATION T.B.C. 12.8 A 208	3 60 DIRECT EMERGENCY PWR REQ'D								
.024 2 SHELVING, PLASTIC, LOUVERED .025 3 SHELVING, PLASTIC, LOUVERED										
.030 1 EXHAUST HOOD	REFER TO QF-400 SERIES DRAWINGS 15.0 A 208	3 60 DIRECT					20" 10" 2,090 CFM -0.7 IN-V	G 12" 28	836 CFM 0.2 IN-WG	6 2@12" X 28" MAKE-UP DUCTS @ 836 CFM EACH. REFER TO QF-400 SERIES
.030A 1 F.P.S. CONTROL PANEL	REFER TO QF-400 SERIES DRAWINGS 3.4 A 208	3 60 DIRECT CONN. TO B.A.S. SYSTEM. ADD'L 120/1/60 15A CONN. REQ'D								REFER TO QF-400 SERIES
.031 2 COMBI OVEN, GAS	15.0 A 208	1 60 PLUG NEMA 6-15P	3/4"	2" 168,000 BTU/F	TO F.S. WATER FROM 1.031A. TO G.T.	3/4" 170,000 BTU/H				
.031A 1 WATER FILTER			3/4"							
.032		4 CO DILIC CENERAL BURDOCE BODT								
.034 1 S.S. TABLE .034A 1 WALL SHELF	12.0 A 120	1 60 PLUG GENERAL PURPOSE RCPT								
.035 1 S.S. TABLE W/ SINK	12.0 A 120	1 60 PLUG GENERAL PURPOSE RCPT	1/2" 1/2"	1 1/2"						+
.036 1 WASTE BIN W/ DOLLY										
.037 1 S.S. TABLE W/ SINK	12.0 A 120	1 60 PLUG GENERAL PURPOSE RCPT	1/2" 1/2"	1 1/2"						
.038	12.0 A 120	1 60 PLUG GENERAL PURPOSE RCPT								
.039 1 S.S. MOBILE TABLE										
.040 2 POT RACK										
.042 1 WASTE BIN W/ DOLLY										
.043			1/2" 1/2"	1 1/2"	2@1/2" HW+CW, 3@1 1/2" DIRECT DRAINS					
.045 1 STACKED WASHER/DRYER, ELEC.	15.0 A 120	1 60 PLUG ADD'L 240/1/60 30A REQ'D	3/4" 3/4"	1 1/2"			4" (220 CFM)			VENT TO EXTERIOR
.050 1 HAND SINK		1 60 PLUG ADD'L 240/1/60 30A REQ'D	1/2" 1/2"	11/2" 1						
.051 1 EYE WASH SINK			1/2" 1/2"	1 1/2"						
.060 1 HAND SINK .061 1 S.S. TABLE W/ SINK	12.0 A 120	1 60 PLUG GENERAL PURPOSE RCPT	1/2" 1/2" 1/2" 1/2"	1 1/2"						
.061A	12.0 A 120	1 00 1 LOO GLIVELIAE FURFOSE ROFT	1/2 1/2	1 1/2						+
.062 1 WASTE BIN W/ DOLLY										
.063 1 HOT HOLDING CABINET	16.0 A 120	1 60 PLUG NEMA 6-15P								
.064 1 PASS-THRU REFRIGERATOR	9.1 A 120 9.6 A 120	1 60 PLUG NEMA 5-15P		4"	TO F 0					
.070 1 FORCED AIR MILK COOLER .071 1 HOT TOP FOOD TABLE W/ FULL SERVE SNEEZE GUAF		1 60 PLUG 1 60 PLUG NEMA 14-60P (DAISY CHAIN TYPE SYSTEM)		T"	TO F.S.					-
.072 1 CONVERTIBLE HOT/COLD FOOD TABLE W/ FULL SER		PLUGS INTO 1.071 (DAISY CHAIN TYPE SYSTEM). POWER FROM 1.071		1"	TO F.S.					
SNEEZE GUARD - 3 WELL  .073 1 SOLID TOP TABLE		PLUGS INTO 1.072 (DAISY CHAIN TYPE SYSTEM). POWER FROM 1.071								_
.074 1 REFRIGERATED COLD FOOD TABLE W/ SELF SERVE		PLUGS INTO 1.073 (DAISY CHAIN TYPE SYSTEM). POWER FROM 1.071		1"	TO F.S.					
SNEEZE GUARD - 5 WELL										
.075		PLUGS INTO 1.074 (DAISY CHAIN TYPE SYSTEM). POWER FROM 1.071								
.078 2 CASHIER STAND .079 2 POS SCREEN	12.0 A 120	1 60 PLUG DATA CONN. REQ'D								_
.080 1 HAND SINK	12.071 120		1/2" 1/2"							
.081 1 S.S. TABLE W/ SINK	12.0 A 120	1 60 PLUG GENERAL PURPOSE RCPT	1/2" 1/2"							
.081A 1 WALL SHELF										
.082	16.0 A 120	1 60 PLUG NEMA 6-15P								
.084 1 PASS-THRU REFRIGERATOR	9.1 A 120	1 60 PLUG NEAM 5-15P								
.090 1 FORCED AIR MILK COOLER	9.6 A 120	1 60 PLUG		1"	TO F.S.					
.091 1 HOT TOP FOOD TABLE W/ FULL SERVE SNEEZE GUAI		1 60 PLUG NEMA 14-60P (DAISY CHAIN TYPE SYSTEM)		4.11	TO 5.0					
.092 1 CONVERTIBLE HOT/COLD FOOD TABLE W/ FULL SER\ SNEEZE GUARD - 3 WELL	VE	PLUGS INTO 1.091 (DAISY CHAIN TYPE SYSTEM). POWER FROM 1.071		1"	TO F.S.					
O O		PLUGS INTO 1.092 (DAISY CHAIN TYPE SYSTEM). POWER FROM 1.071								
.093 1 SOLID TOP TABLE										
.093 1 SOLID TOP TABLE .094 1 REFRIGERATED COLD FOOD TABLE W/ SELF SERVE SNEEZE GUARD - 5 WELL		PLUGS INTO 1.093 (DAISY CHAIN TYPE SYSTEM). POWER FROM 1.071		1"	TO F.S.					












Prime contractors to reference Kitchen Equipment Drawings as part of their Contract scope of work

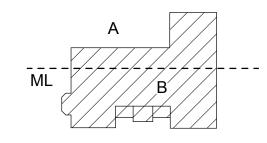

SED # 26-16-00-01-0-004-024 DWT SED # 26-16-00-01-7-999-020

Rochester Schools Modernization Program
-Phase 2c
George M. Forbes- Renovation, Alterations
and Addition

198 Dr Samuel McCree Way, Rochester, NY 14611

REV.#	DESCRIPTION	DATE
1	BID ADDENDA #1	04/25/18


JOB NO.	1711
SCALE	
ISSUE DATE	3/15/2018
DRAWN BY	EK
CHECKED BY	DT/LR
THIS IS A SIN	GLE SHEET OF A COHESIVE

THIS IS A SINGLE SHEET OF A COHESIVE SET OF CONSTRUCTION DOCUMENTS (INCLUDING DRAWINGS AND SPECIFICATIONS). INTERPRETATION OF THE INFORMATION AS PRESENTED SHOULD BE BASED ON THE ENTIRE SET OF DOCUMENTS.

DRAWING TITLE

MEP SCHEDULE

QF-105

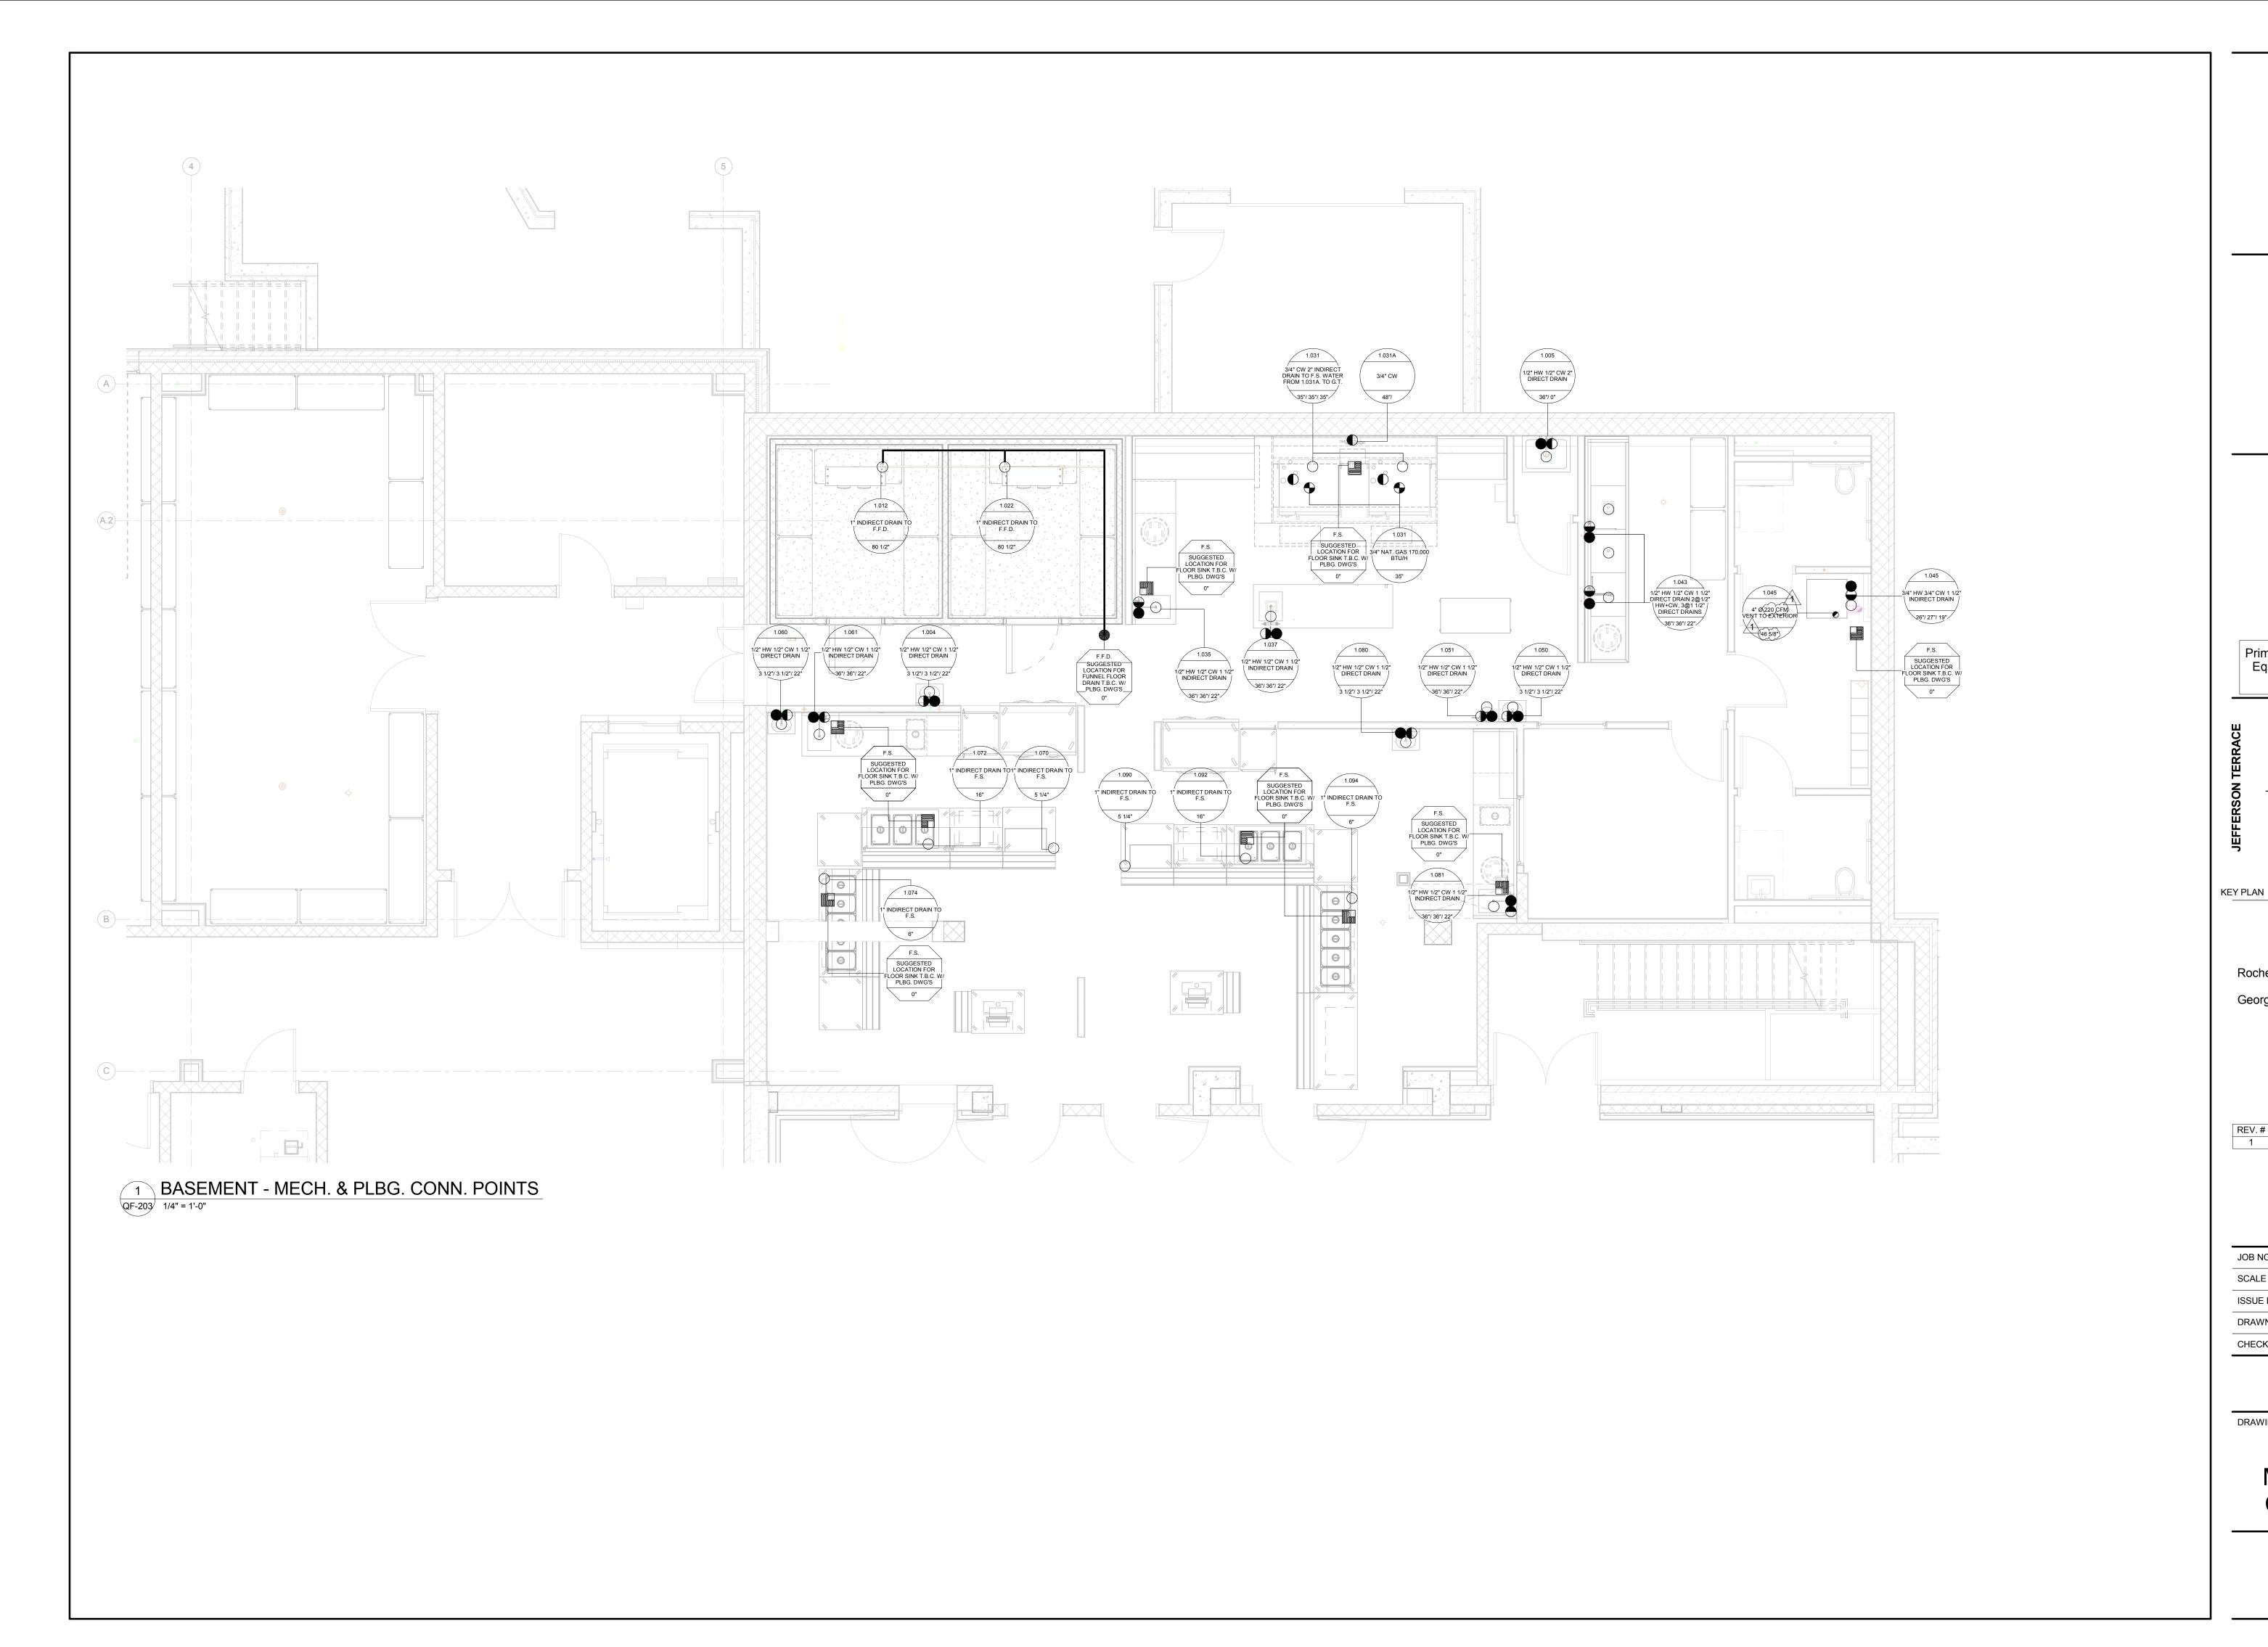












Prime contractors to reference Kitchen Equipment Drawings as part of their
Contract scope of work

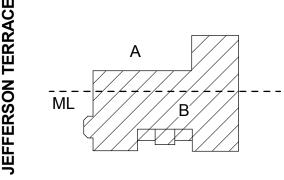

# DR. SAMUEL MCCREE WAY

SED # 26-16-00-01-0-004-024 DWT SED# 26-16-00-01-7-999-020

Rochester Schools Modernization Program -Phase 2c George M. Forbes- Renovation, Alterations

and Addition

198 Dr Samuel McCree Way Rochester, NY 14611				
REV.#	DESCRIPTION	DATE		
1	BID ADDENDA #1	04/25/18		


JOB NO.	171
SCALE	1/4" = 1'-0
ISSUE DATE	3/15/201
DRAWN BY	El
CHECKED BY	DT/LF
THO IO A OINOLE OUTET OF A COLUEON (F	

THIS IS A SINGLE SHEET OF A COHESIVE SET OF CONSTRUCTION DOCUMENTS (INCLUDING DRAWINGS AND SPECIFICATIONS). INTERPRETATION OF THE INFORMATION AS PRESENTED SHOULD BE BASED ON THE ENTIRE SET OF DOCUMENTS.


DRAWING TITLE

BASEMENT -MECH. & PLBG. CONN. POINTS

**QF-203** 

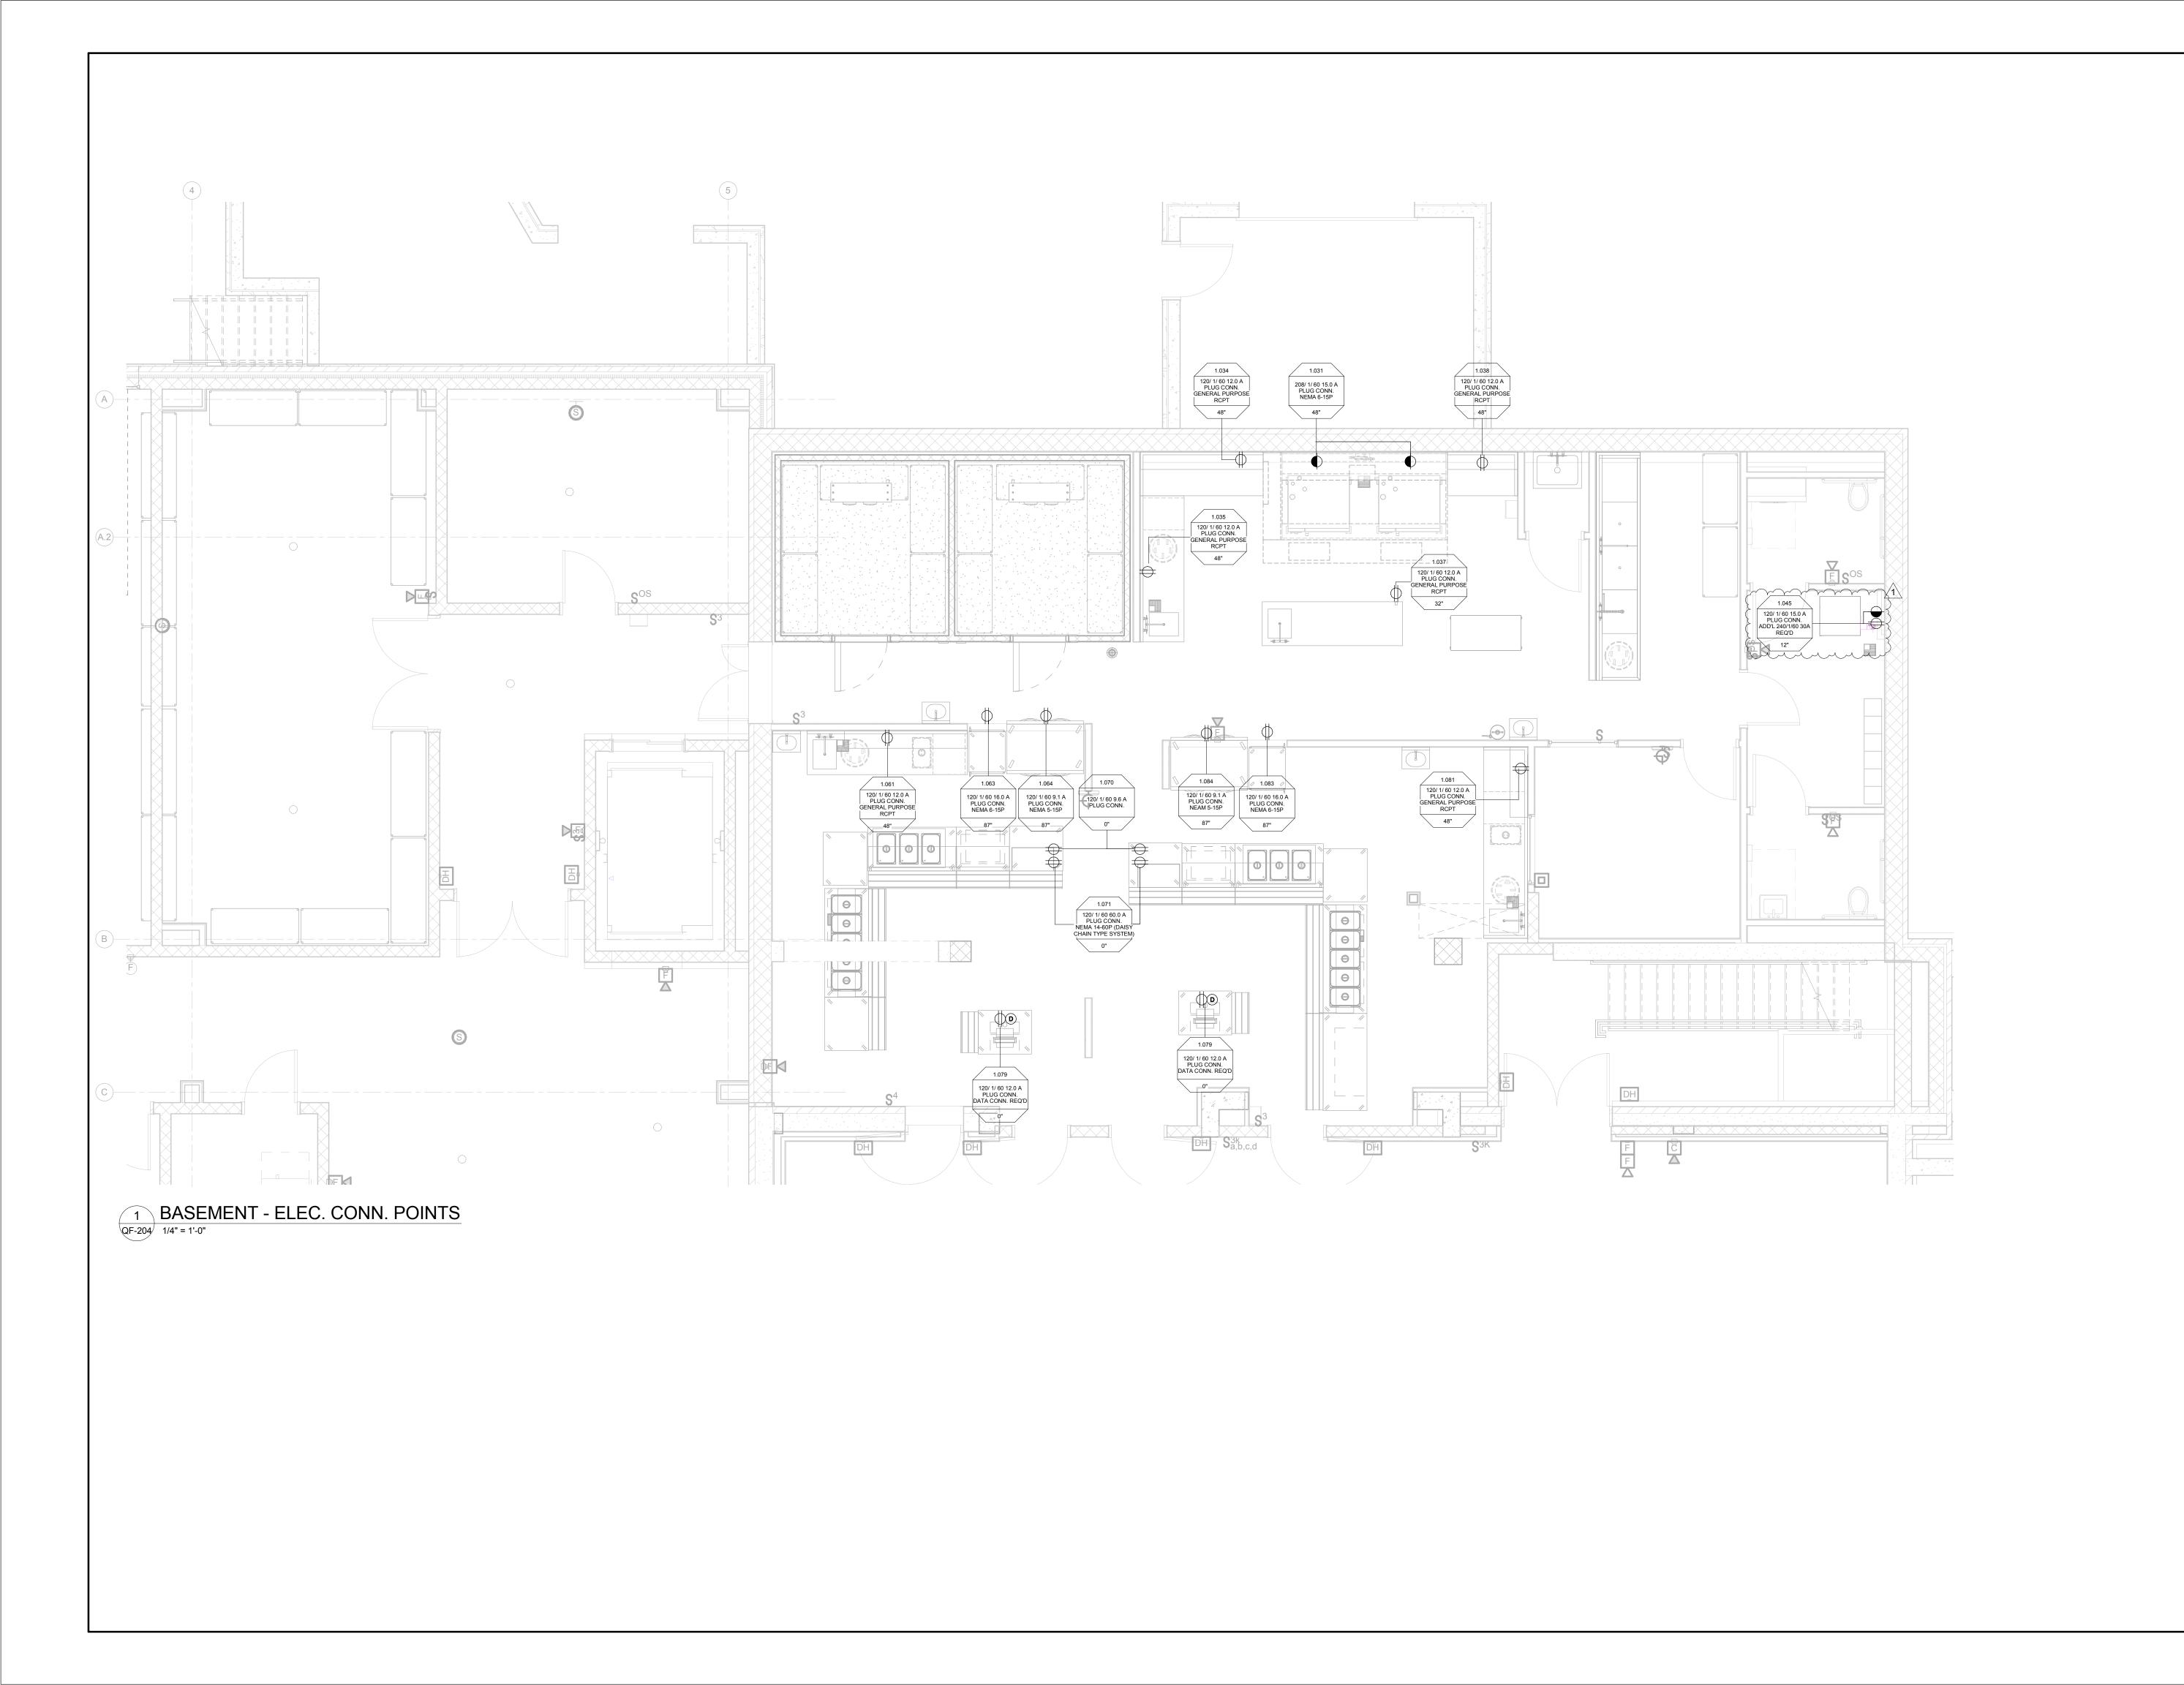



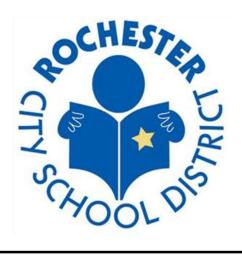








Prime contractors to reference Kitchen Equipment Drawings as part of their Contract scope of work

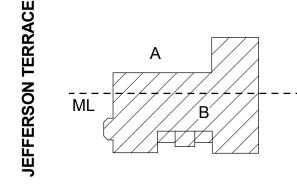

DR. SAMUEL MCCREE WAY
KEY PLAN

SED # 26-16-00-01-0-004-024 DWT SED # 26-16-00-01-7-999-020

Rochester Schools Modernization Program
-Phase 2c
George M. Forbes- Renovation, Alterations
and Addition

198 Dr Samuel McCree Way, Rochester, NY 14611				
REV.#	DESCRIPTION	DATE		
1	1 BID ADDENDA #1			

JOB NO.	171
SCALE	1/4" = 1'-0
ISSUE DATE	3/15/201
DRAWN BY	E
CHECKED BY	DT/L
•	

THIS IS A SINGLE SHEET OF A COHESIVE SET OF CONSTRUCTION DOCUMENTS (INCLUDING DRAWINGS AND SPECIFICATIONS). INTERPRETATION OF THE INFORMATION AS PRESENTED SHOULD BE BASED ON THE ENTIRE SET OF DOCUMENTS.

DRAWING TITLE

BASEMENT -ELEC. CONN. POINTS

QF-204

	DOMESTIC COLD WATER (SUPPLY, CWS)	<u> </u>	PLUG VALVE		PUMP (SCHEMATIC)
	DOMESTIC HOT WATER (SUPPLY, HWS)  DOMESTIC HOT WATER RECIRCULATION (HWR)		SHUT-OFF VALVE (GATE, BALL, OR BUTTERFLY - REFER TO		
	DOMESTIC HOT WATER (SUPPLY, 140°F HWS)	<b>→</b>	SPECS) CHECK VALVE		IN-LINE PUMP (PLAN)
	DOMESTIC HOT WATER RECIRCULATION (140°F HWR)	——————————————————————————————————————	BALANCING VALVE		FLEX CONNECTION
	NATURAL GAS	<b>─</b> ►		——————————————————————————————————————	EXPANSION JOINT
	CONDENSATE PIPING  CANITARY PRAIN(SEWER (AROVE CRAPE)		ANGLE VALVE		WITH
	SANITARY DRAIN/SEWER (ABOVE GRADE) SANITARY DRAIN/SEWER (BELOW GRADE)		PRESSURE REDUCING VALVE	×	GUIDES PIPE ANCHOR
	SANITARY VENT PIPING (ABOVE GRADE)		DNELIMATIC VALVE	<del></del>	PIPE GUIDE
- $ V$ $  -$	SANITARY VENT PIPING (BELOW GRADE)		PNEUMATIC VALVE	FCO	FLOOR CLEAN OUT (PLAN VIEW
ST	STORM DRAIN SEWAGE (ABOVE GRADE)		PNEUMATIC CONTROL VALVE (3 WAY)	FCO	TEOON OLL/114 OOT (FE) 114 VIEV
	STORM DRAIN SEWAGE (BELOW GRADE)		SOLENOID OR MOTORIZED VALVE	CO	CLEAN OUT
	SECONDARY STORM DRAIN SEWAGE (ABOVE GRADE)		SOLENOID OR MOTORIZED	\-\-\-\-\-\-\-\-\-\-\-\-\-\-\-\-\-\-\-	
SST———————————————————————————————————	SECONDARY STORM DRAIN SEWAGE (BELOW GRADE)  SREASE WAS TE (BELOW GRADE)	<u> </u>	CONTROL VALVE (3 WAY)		EQUIPMENT TO BE REMOVED
			TRIPLE DUTY VALVE		
	PIPE TURNED UP	—— <b>^</b>	RELIEF VALVE		EXISTING EQUIPMENT TO REMAIN
	PIPE TURNED DOWN	· · · · · · · · · · · · · · · · · · ·	TEMPERATURE & PRESSURE		DIDE CONTINUESTION
<del></del>	BRANCH OFF BOTTOM OF PIPE	<u> </u>	RELIEF VALVE		PIPE CONTINUATION
· · · · · · · · · · · · · · · · · · ·	BRANCH OFF TOP OF PIPE	<b></b>	HOSE BIBB OR DRAIN VALVE	lacktriangle	NEW CONNECTION TO EXIST.
	VALVE ON VERTICAL		STRAINER	×	REMOVE TO THIS POINT
Q <del>/</del> ],	VALVE(S) IN VERTICAL PIPE	, 	UNION		REMOVE TO THIS POINT
<b>*</b> /	REDUCER		FLANGE	$\langle x \rangle$	KEYNOTE
	PIPE BREAK	$\bigcirc$		_	KITCHEN EQUIPMENT TAG
T	BALL VALVE	<u> </u>	PRESSURE GAUGE	X	MITOTIEN EQUIT MENT TAG
_		Щ	THERMOMETER		BACKFLOW PREVENTER
	BUTTERFLY VALVE		HERIMONETER		(SCHEMATIC)
——————————————————————————————————————	GATE VALVE - NRS		WATER HAMMER ARRESTER		
	GATE VALVE - OS&Y	<u></u> ОС—	FLOOR DRAIN WITH P-TRAP		
——————————————————————————————————————	GLOBE VALVE				

#### **ABBREVIATIONS** OUTSIDE DIMENSION ODWH ON DEMAND WATER HEATER OPG OPENING BACK FLOW PREVENTOR OS **OPEN SITE** BLDG BUILDING OFF TOP BSMT BASEMENT OUNCE CUBIC FEET PER HOUR PARTIAL PLENUM DRAIN CAST IRON CENTER LINE PERF PERFORATED CEILING **CLEAN OUT** CONN CONNECTION POST INDICATOR VALVE POSITIVE PIV POS PRESS CWS COLD WATER (COND CONDENSATE COLD WATER (SUPPLY) PRESSURE PRESSURE SWITCH DRAIN BOX POUNDS PER SQUARE INCH DEG DEGREE POUNDS PER SQUARE DRINKING FOUNTAIN INCH GAUGE DIAMETER POUNDS PER SQUARE DOWN INCH ABSOLUTE DARK ROOM DOUBLE BOWL SINK DRS PRESSURE TRANSMITTER DOMESTIC WATER PLUG VALVE DWG DRAWING POLYVINYL CHLORIDE DWH DOMESTIC WATER HEATER POLYVINYL COATED STEEL **EXISTING** QUAN QUANTITY ELEV ELEVATION **ENTERING** RELIEF EQUAL REQUIRED EQUIP EQUIPMENT RAIN LEADER EQUIV EQUIVALENT **DEGREES FAHRENHEIT** RECIRCULATION PUMP FRESH AIR INTAKE REVOLUTIONS PER MINUTE FCO FLOOR CLEANOUT SHOCK ABSORBER FD FLOOR DRAIN SANITARY PIPING FIN FINISHED SCHEDULE FLOOR SCHEMATIC STAINLESS STEEL SINK SCHEM FULL LOAD AMPS FPWH FREEZE PROOF WALL HYDRANT SERVICE SINK SPECIFICATION SUMP PUMP SYSTEM SQUARE GENERAL CONTRACTOR GALLONS PER DAY STAINLESS STEEL GPH GPM GALLONS PER HOUR STORM SECONDARY STORM GALLONS PER MINUTE GREASE WASTE STD STANDARD STRUCTURAL HOSE BIBB HEAD (SEE SCHEDULES) SUP SUPPLY SYS SYSTEM HORSE POWER S/SHO SAFETY SHOWER HOSE REEL HTR HEATER HOT WATER (SUPPLY) HWR HOT WATER- RECIRCULATED URINAL INTERNAL DIAMETER INCLUDING VACUUM BREAKER INV INVERT VIVARIUM SINK TYPE OF COPPER TUBING VTR VENT THRU ROOF KILOWATT LAVATORY WATER HAMMER ARRESTER MECHANICAL CONTRACTOR WITHOUT MEDIUM WATER CLOSET **MANUFACTURER** WATER METER MISCELLANEOUS X-RAY DEVELOPER CABINET MOP SERVICE SINK

NEW

NTS

NO HUB

NUMBER

NORMALLY CLOSED

NATURAL GAS

NORMALLY OPEN

NOT TO SCALE

#### **GENERAL NOTES**

- A. DO NOT SHUT DOWN ANY PLUMBING, FIRE PROTECTION, NATURAL GAS, MECHANICAL, ELECTRICAL, OR RELATED SYSTEMS WITHOUT BUILDING OWNER'S PRIOR WRITTEN APPROVAL. FOLLOW ALL OWNER REQUIREMENTS AND SHUT DOWN PROCEDURES AS WELL AS ALL REQUIREMENTS OF THIS PROJECT.
- B. IF REQUIRED, PROVIDE SHUT DOWNS AND TIE-INS DURING OFF HOURS TO AVOID DISRUPTION OF BUILDING SYSTEMS. COORDINATE ALL SHUT DOWN REQUIREMENTS PRIOR TO SUBMITTING BID (INCLUDE ALL REQUIRED DURING OFF HOURS IN BID).
- C. PROVIDE ALL WORK IN COMPLIANCE WITH ALL LOCAL, STATE AND FEDERAL CODES. OBTAIN ALL REQUIRED PERMITS.
- D. PROVIDE ALL REQUIRED EXCAVATION, BACKFILL AND COMPACTION FOR ALL UNDERGROUND WORK.
- FIELD VERIFY EXACT LOCATION, DEPTH, COMPOSITION AND CONDITION OF ALL PIPING, VALVES AND SYSTEMS AS REQUIRED FOR WORK OF THE
- PROVIDE CUTTING, CORING AND PATCHING OF ALL WALLS, SLABS AND DECKS AS REQUIRED FOR WORK SHOWN. COORDINATE ALL WORK WITH OWNER AND GENERAL CONTRACTOR AND ALL TRADES.
- G. PROVIDE SCHEDULE 40 BLACK STEEL PIPE SLEEVES FOR ALL UNDERGROUND PIPING PASSING THROUGH OR UNDER FOOTINGS, WALLS, FOUNDATION WALLS, SLABS FLOORS AND/OR UNDERGROUND STRUCTURES. REFER TO THE PROJECT SPECIFICATIONS FOR ADDITIONAL REQUIREMENTS.
- H. WHERE PIPING IS LOCATED OVER FOOTINGS AND/OR OTHER UNDERGROUND STRUCTURES. ROLL DOWN AS REQUIRED TO CONNECT TO SYSTEMS NOTED. PROVIDE ALL REQUIRED OFFSETS, FITTINGS AND
- PITCH ALL SANITARY, WASTE, AND STORM PIPING AS FOLLOWS: PIPING 3" AND SMALLER, PITCH AT 2 PERCENT (1/4" PER FOOT) MINIMUM, PIPING 4" AND LARGER, PITCH AT 1 PERCENT (1/8" PER FOOT) MINIMUM.
- CONNECT TO SITE PIPING OUTSIDE BUILDING AS SHOWN. PROVIDE ALL REQUIRED OFFSETS, FITTINGS AND CONNECTIONS. FIELD VERIFY EXACT LOCATION, DEPTH AND COMPOSITION OF SITE SERVICES AND COORDINATE ALL WORK WITH SITE CONTRACTOR.
- COORDINATE ALL VENTATERMINATIONS ABOVE ROOF WITH HVAC CONTRACTOR. ALL VENT TERMINATIONS ABOVE ROOF SHALL BE A MINIMUM 25'-0" AWAY FROM ANY HVAC OUTSIDE AIR INTAKE (ROOFTOP UNIT, LOUVER, ETC.).
- PROVIDE BARRIER TYPE SEAL DEVICE ON ALL FLOOR DRAINS.
- M. REFER TO ARCHITECTURAL DRAWINGS AND THE PROJECT SPECIFICATIONS FOR ANY PROJECT PHASING REQUIREMENTS.

- THE ENTIRE PLUMBING SYSTEM SHALL BE IN ACCORDANCE WITH THE LATEST EDITION OF THE PLUMBING CODE OF NEW YORK STATE AND LOCAL PLUMBING INSPECTOR.
- THE EXISTING PIPING INDICATED ON THESE PLANS SHALL BE VERIFIED IN THE FIELD FOR EXACT LOCATIONS, QUANTITY, AND PIPE
- THE PIPING INDICATED ON THESE PLANS IS DIAGRAMATIC. ALL WORK SHALL BE COORDINATED WITH ALL OTHER TRADES PRIOR TO INSTALLATION. CONTRACTOR SHALL COORDINATE ROUTING OF ALL PIPING WITH EXISTING CONDITIONS AND SHALL PROVIDE ANY NECESSARY OFFSETS, REROUTING, TEES, ELBOWS, ETC. REQUIRED FOR A COMPLETE AND COORDINATED INSTALLATION.
- 4.) THE CONTRACTOR SHALL OBTAIN AND PAY ALL FEES RELATED TO PERMITTING, INSPECTIONS, TAP-ON FEES, ETC.
- CONTRACTOR SHALL COORDINATE ANY PLUMBING OR PIPING SYSTEM

SHUTDOWN WITH THE OWNER 48 HOURS IN ADVANCE.

- 6.) CONTRACTOR SHALL COORDINATE AND PROVIDE ALL NECESSARY PIPING & PLUMBING FITTINGS, PIPING, MISCELLANEOUS ITEMS REQUIRED FOR A COMPLETE INSTALLATION OF ALL PLUMBING RELATED ITEMS.
- 7.) ALL WORK SHALL BE COORDINATED WITH THE EQUIPMENT VENDORS.
- THE CONTRACTOR SHALL COORDINATE THE INSTALLATION OF ALL UNDER SLAB PIPING WITH EXISTING STRUCTURAL FOUNDATIONS. UNDERGROUND UTILITY LOCATIONS SHALL BE VERIFIED PRIOR TO ANY WORK BEING PERFORMED. CONTRACTOR SHALL REPAIR OR REPLACE ALL PIPING NOT IN PROPER WORKING ORDER OR DAMAGED DURING INSTALLATION OF THE NEW UNDERSLAB PIPING.
- 9.) ALL PLUMBING & PIPING SYSTEMS SHALL BE SUPPORTED AS REQUIRED BY THE STATE AND LOCAL CODE REQUIREMENTS AND PER MANUFACTURER'S RECOMMENDATIONS.
- 10.) ALL PIPING PENETRATIONS THROUGH NEW, EXISTING WALL, OR FLOOR SHALL BE SEALED TO EQUAL THE RATING OF THE NEW, EXISTING WALL OR FLOOR.
- 11.) THE PLUMBING SYSTEM SHALL BE TESTED AS REQUIRED BY STATE AND LOCAL CODE OR BY THE REQUIREMENTS OF THE LOCAL PLUMBING INSPECTOR.
- 12.) THE ENTIRE DOMESTIC WATER SYSTEM (EXISTING/NEW) SHALL BE DISINFECTED IN ACCORDANCE TO THE LOCAL CODE & HEALTH DEPARTMENT REQUIREMENTS.
- 13.) THE BACKFLOW PREVENTION DEVICE SHALL BE INSTALLED PER STATE AND LOCAL CODE & PER AUTHORITY HAVING JURISDICTION REQUIREMENTS.
- 14.) ALL (VTR'S) VENT THRU ROOF PENETRATIONS INDICATED ON PLANS ARE PRELIMINARY. FINAL LOCATIONS SHALL BE COORDINATED WITH ALL TRADES. ALL VTR'S SHALL BE A MINIMUM OF 25'-0" FROM ALL FRESH AIR INTAKE OPENINGS.



BUFFALO | ROCHESTER www.cjsarchitects.com









DR. SAMUEL MCCREE WAY

**KEY PLAN** 

SED # 26-16-00-01-0-004-024 DWT SED # 26-16-00-01-7-999-020

Rochester Schools Modernization Program - Phase 2c

George M. Forbes - Renovation, Alterations and Addition

> 198 Dr Samuel McCree Way, Rochester NY, 14611

REV.#	DESCRIPTION	DAT
1	Revision 1	Date

GEORGE MATHER FORBES SCHOOL NO.4


JOB NO. 1711 SCALE ISSUE DATE 4/25/18 DRAWN BY BCW CHECKED BY Checker

THIS IS A SINGLE SHEET OF A COHESIVE SET OF CONSTRUCTION DOCUMENTS (INCLUDING DRAWINGS AND SPECIFICATIONS). INTERPRETATION OF THE INFORMATION AS PRESENTED SHOULD BE BASED ON THE ENTIRE SET OF DOCUMENTS.


DRAWING TITLE

PLUMBING NOTES AND SYMBOLS

P-000

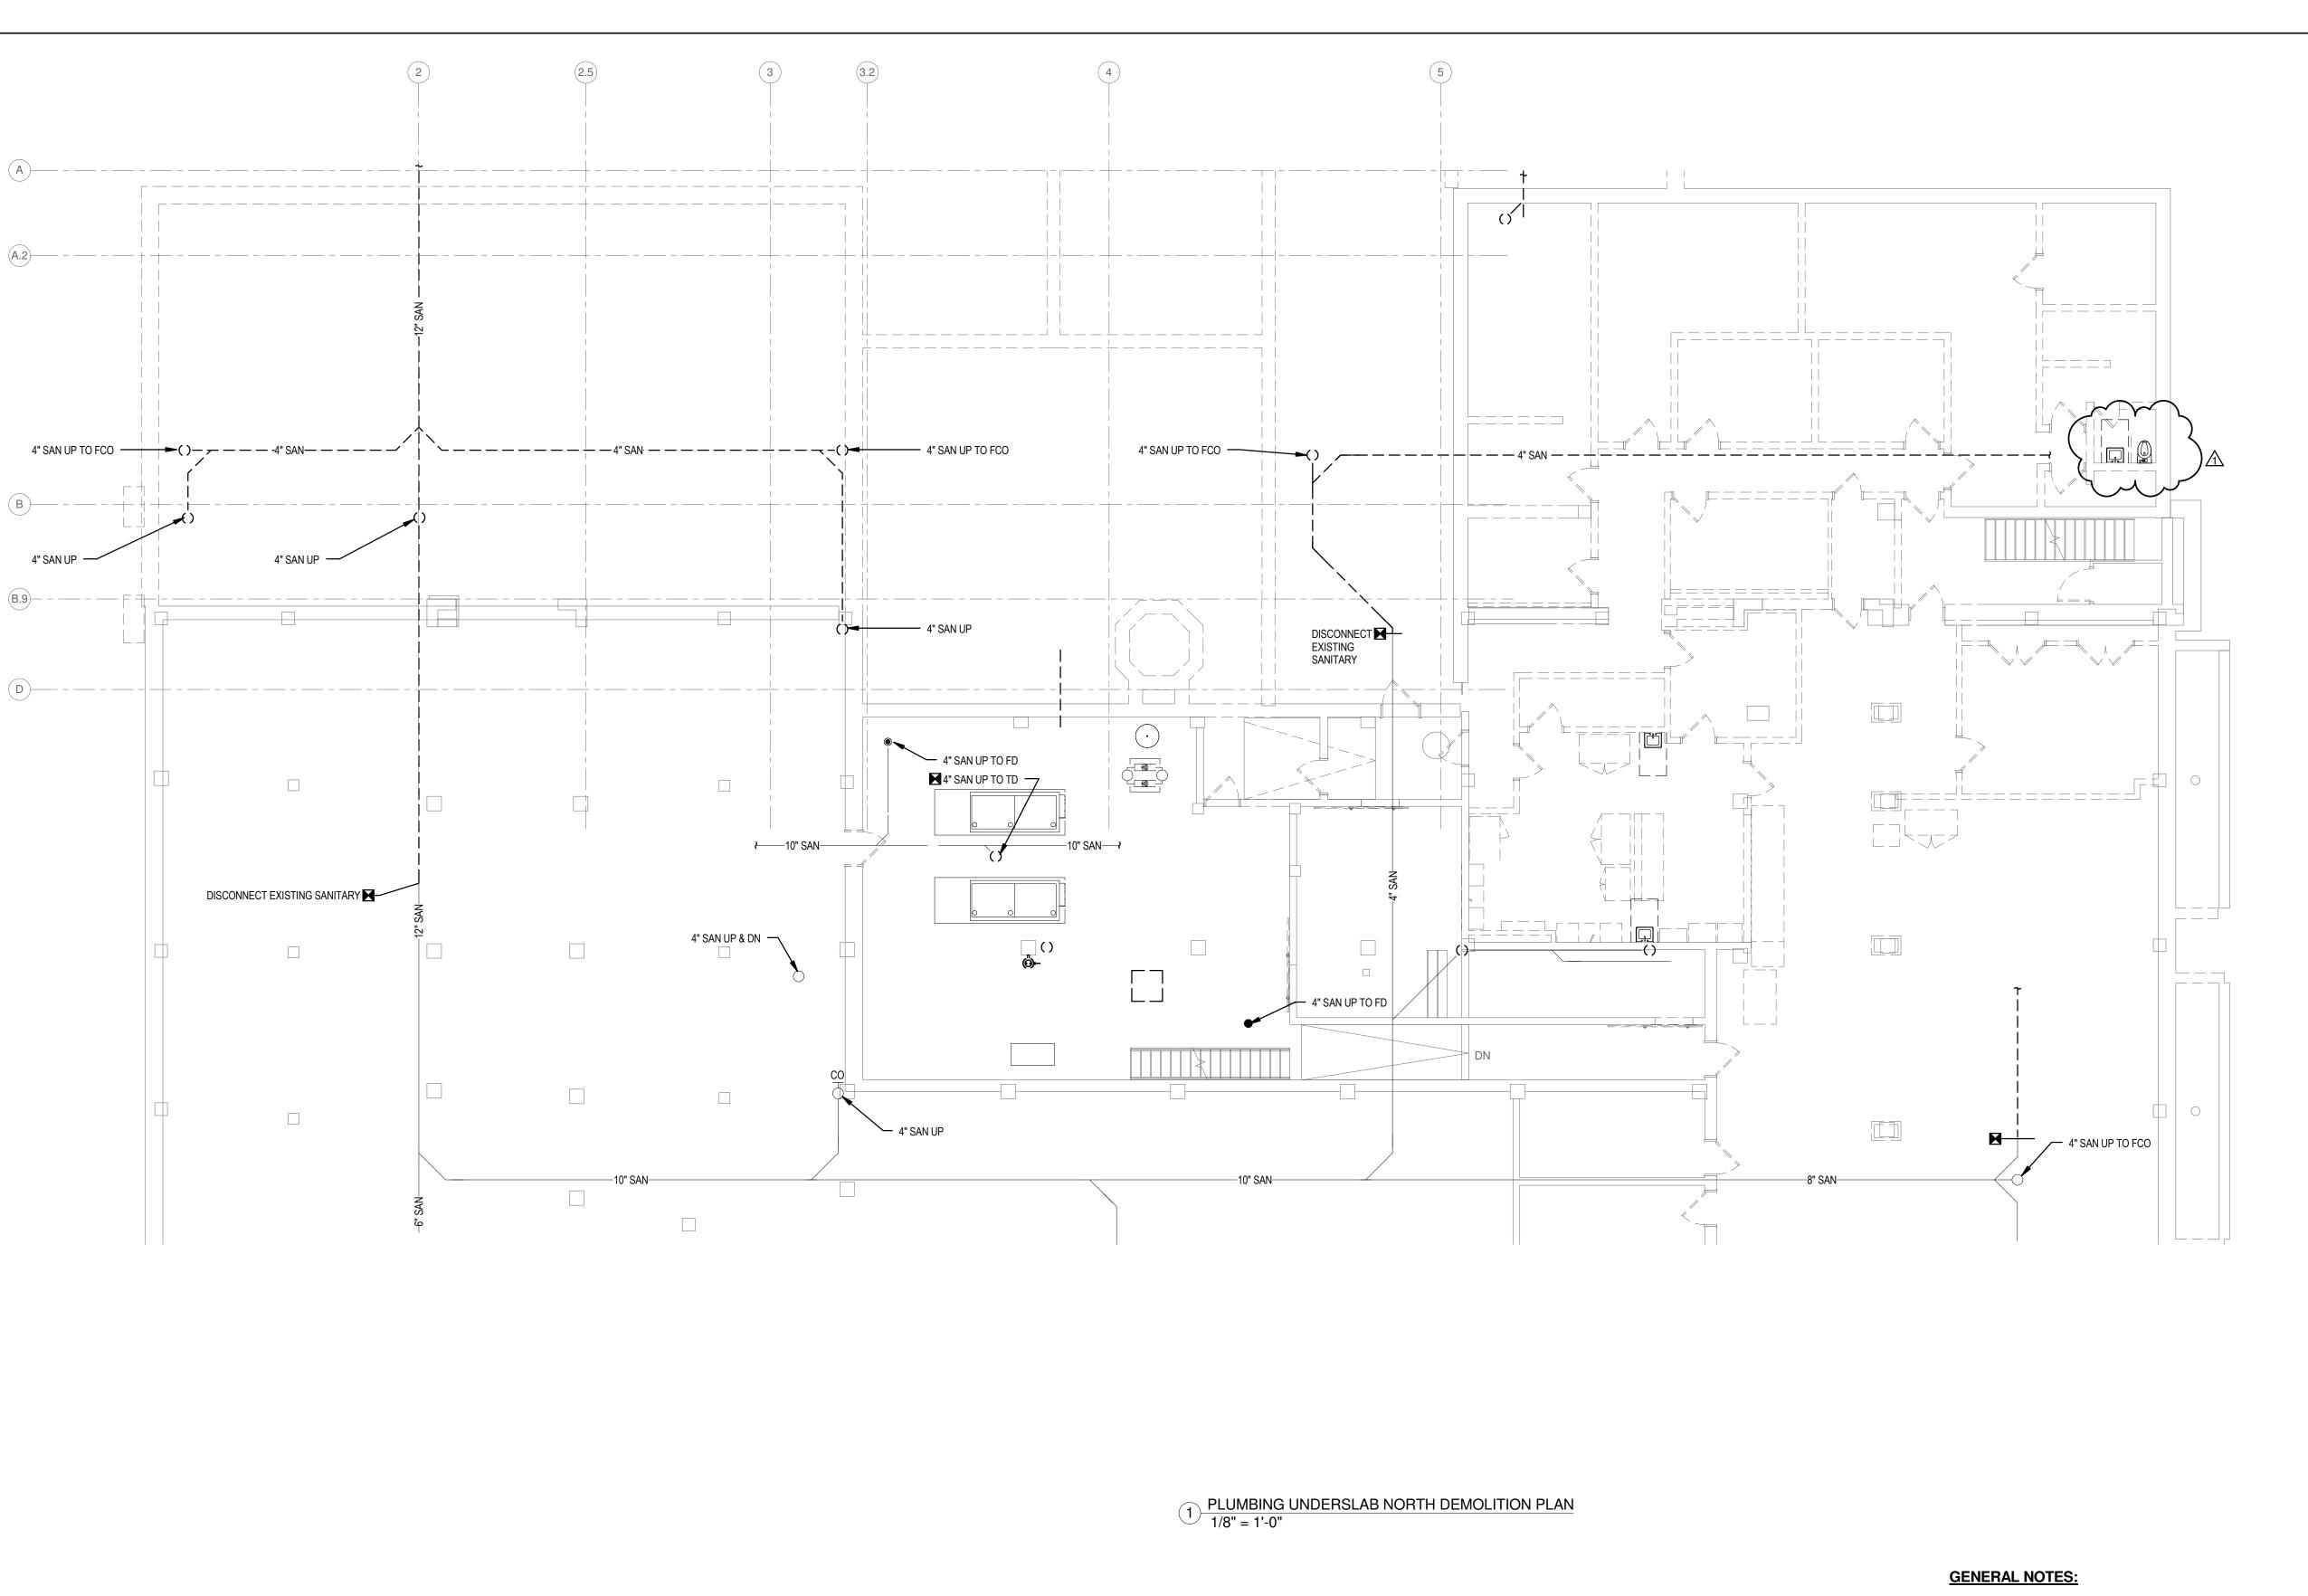

1. ALL CUTTING AND PATCHING ASSOCIATED WITH THE PLUMBING SCOPE OF WORK SHALL BE COMPLETED BY THE PLUMBING CONTRACTOR.

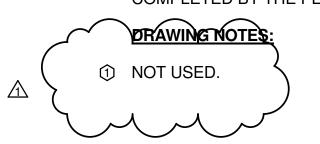










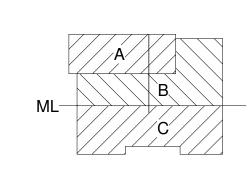

**KEY PLAN** 



SED # 26-16-00-01-0-004-024 DWT SED # 26-16-00-01-7-999-020

Rochester Schools Modernization Program
- Phase 2c

George M. Forbes - Renovation, Alterations and Addition

198 Dr Samuel McCree Way, Rochester NY, 14611

REV.#	DESCRIPTION	DATE
1	Revision 1	Date 1
		•

### GEORGE MATHER FORBES SCHOOL NO.4


JOB NO.		1711
SCALE		1/8" = 1'-0"
ISSUE DATE		4/25/18
DRAWN BY		BCW
CHECKED BY		Checker
TI	HIS IS A SINGLE SHEET OF A COHESIVE	

THIS IS A SINGLE SHEET OF A COHESIVE
SET OF CONSTRUCTION DOCUMENTS
(INCLUDING DRAWINGS AND SPECIFICATIONS).
INTERPRETATION OF THE INFORMATION
AS PRESENTED SHOULD BE BASED ON
THE ENTIRE SET OF DOCUMENTS.

\_\_\_\_\_

PLUMBING PARTIAL DEMOLITION UNDERSLAB PLAN


PD-100.1

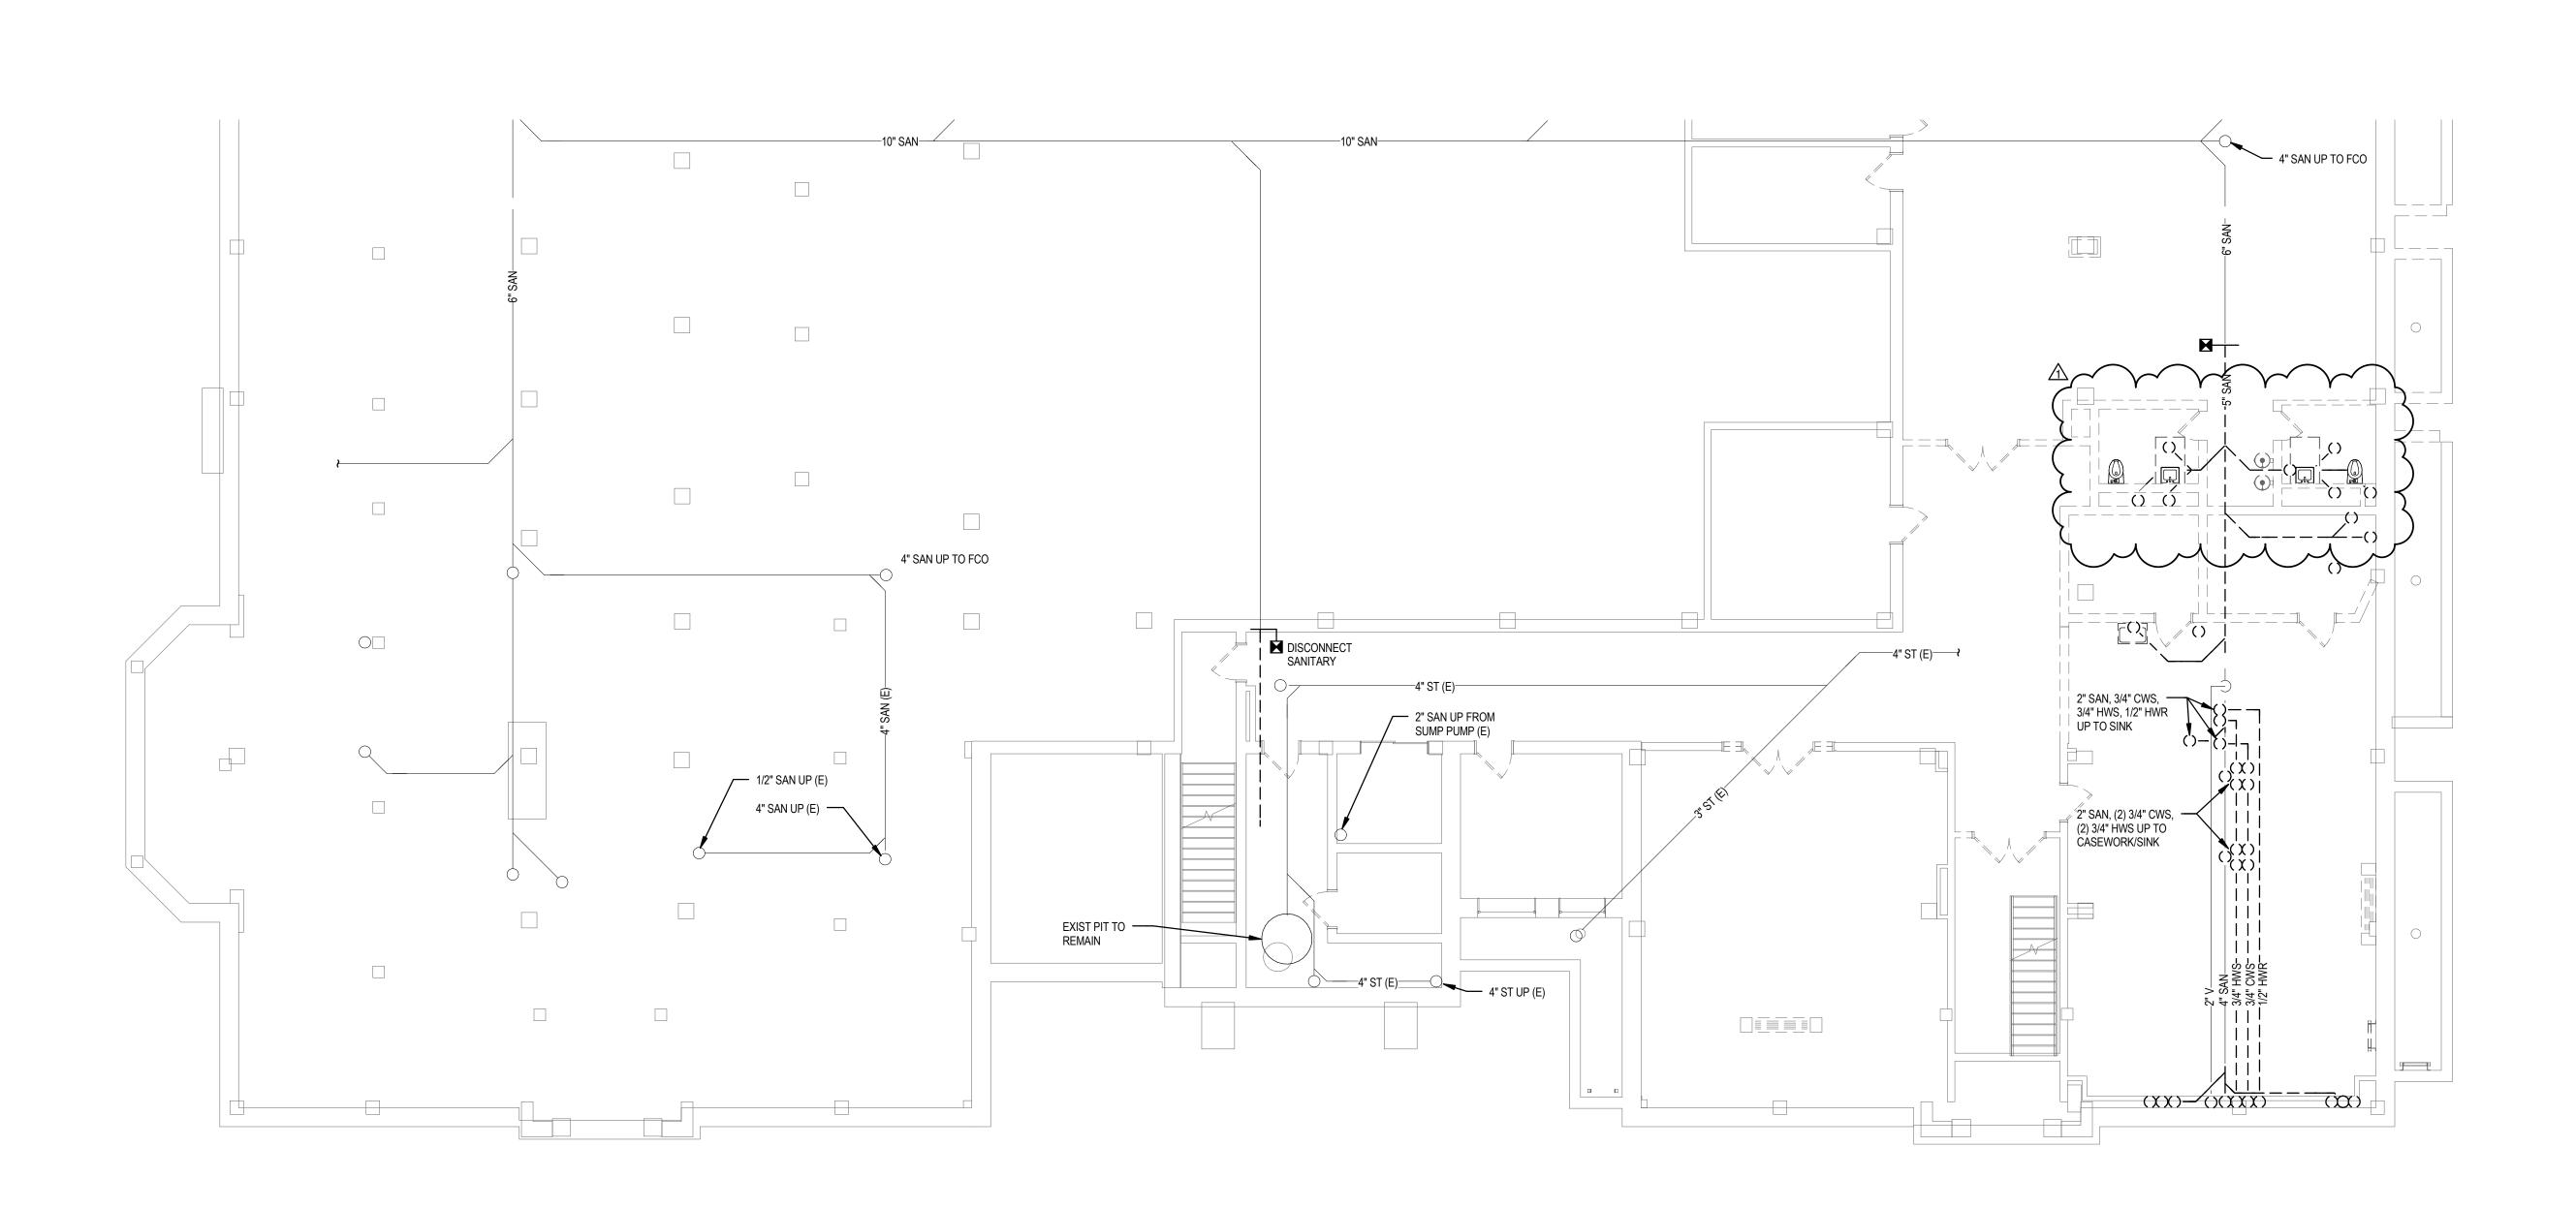

1 PLUMBING UNDERSLAB SOUTH DEMOLITION PLAN 1/8" = 1'-0"

### **GENERAL NOTES:**

1. ALL CUTTING AND PATCHING ASSOCIATED WITH THE PLUMBING SCOPE OF WORK SHALL BE COMPLETED BY THE PLUMBING CONTRACTOR.

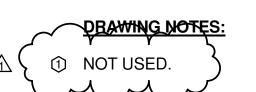










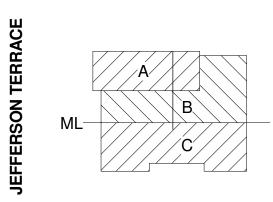



SED # 26-16-00-01-0-004-024 DWT SED # 26-16-00-01-7-999-020

Rochester Schools Modernization Program
- Phase 2c

George M. Forbes - Renovation, Alterations and Addition

198 Dr Samuel McCree Way, Rochester NY, 14611

REV.#	DESCRIPTION	DATE
1	Revision 1	Date 1
	•	

### GEORGE MATHER FORBES SCHOOL NO.4


JOB NO.	171
SCALE	1/8" = 1'-0
ISSUE DATE	4/25/1
DRAWN BY	BCV
CHECKED BY	Checke
THIS IS A SINGLE SHEET OF A COHESIVE	

I HIS IS A SINGLE SHEET OF A COHESIVE
SET OF CONSTRUCTION DOCUMENTS
(INCLUDING DRAWINGS AND SPECIFICATIONS).
INTERPRETATION OF THE INFORMATION
AS PRESENTED SHOULD BE BASED ON
THE ENTIRE SET OF DOCUMENTS.

\_\_\_\_\_

PLUMBING PARTIAL DEMOLITION UNDERSLAB PLAN

PD-100.2

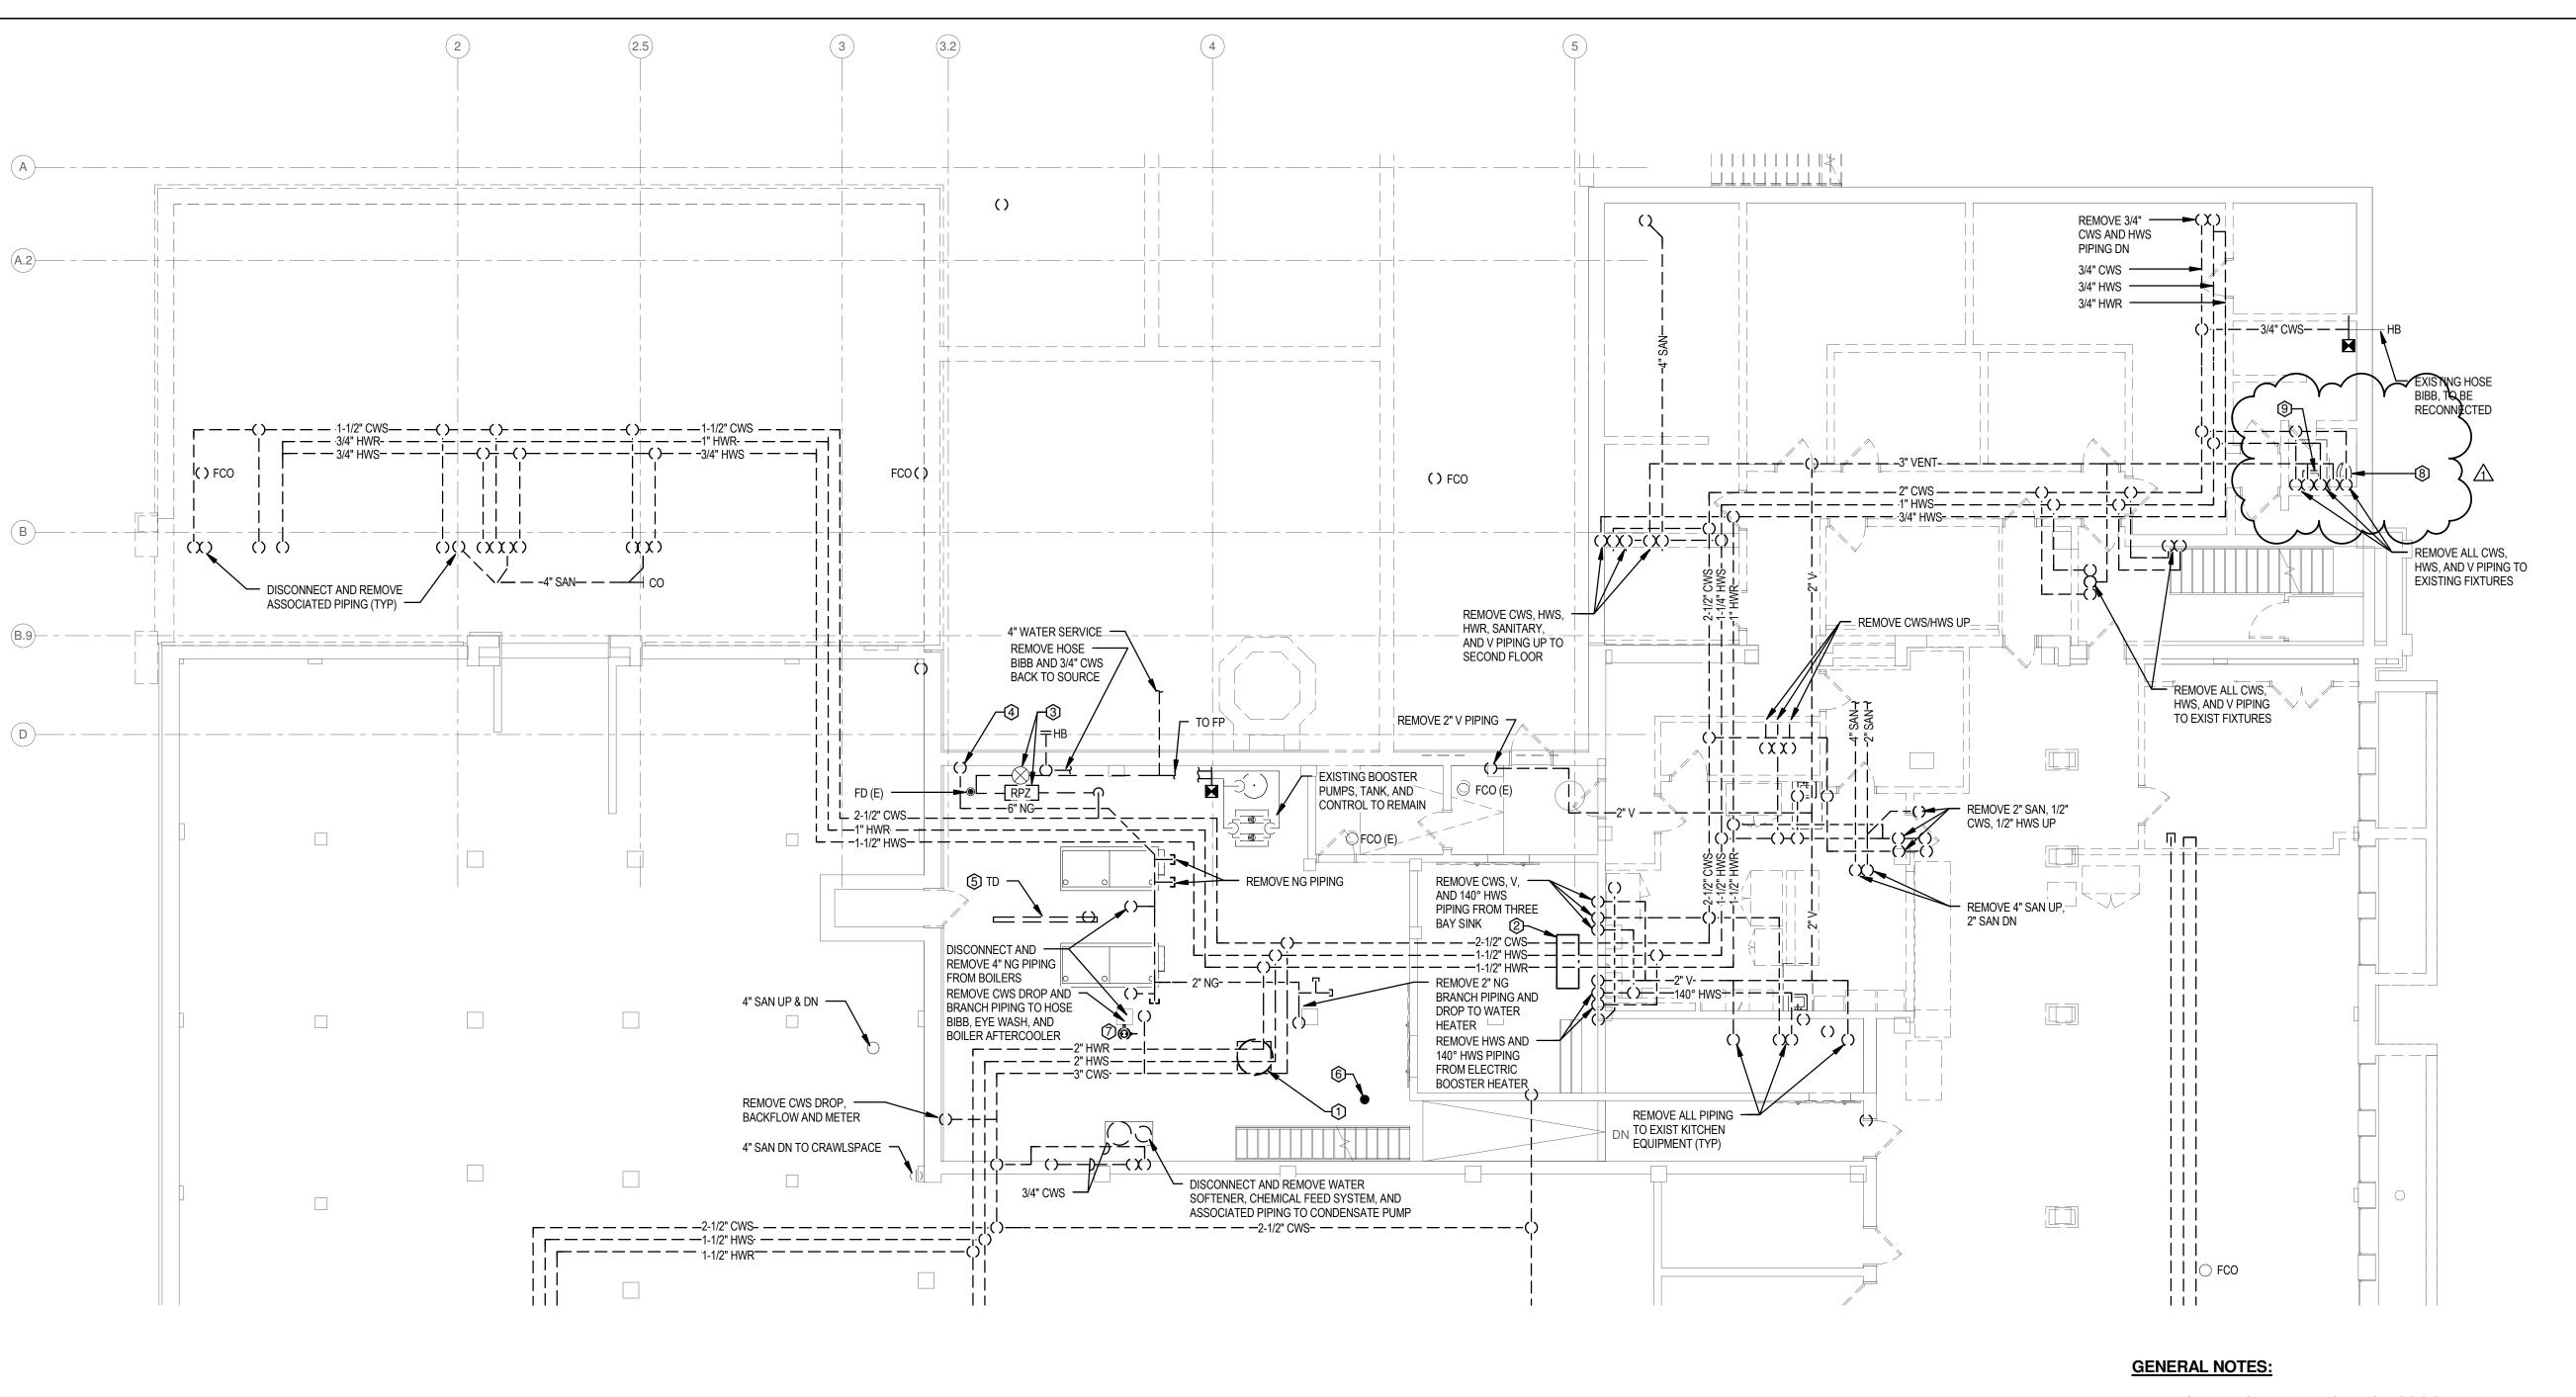

1 PLUMBING BASEMENT NORTH DEMOLITION PLAN 1/8" = 1'-0"

1. ALL CUTTING AND PATCHING ASSOCIATED WITH THE PLUMBING SCOPE OF WORK SHALL BE COMPLETED BY THE PLUMBING CONTRACTOR.

2. KITCHEN EQUIPMENT TO BE REMOVED BY OTHERS. PIPING TO KITCHEN EQUIPMENT UNDER P-CONTRACT.

#### **DRAWING NOTES:**

- DISCONNECT AND REMOVE DOMESTIC HOT WATER HEATER. REMOVE CWS / HWS / HWR / GAS / FLUE PIPING TO CEILING. MAINTAIN REMAINING PIPING FOR NEW CONNECTIONS.
- ② DISCONNECT AND REMOVE FLOOR MOUNT GREASE TRAP. EMPTY AND CLEAN BEFORE REMOVAL. REMOVE ASSOCIATED PIPING.
- ③ DISCONNECT AND REMOVE EXISTING WATER SERVICE AND PIPING. SAVE METER FOR REINSTALLATION. SEE FP DRAWINGS FOR FIRE SERVICE PIPING REMOVALS.
- DISCONNECT AND REMOVE EXISTING GAS SERVICE AND PIPING.
- ⑤ DISCONNECT AND REMOVE TRENCH DRAIN. MAINTAIN PIPING FOR NEW CONNECTION. FLOOR CUT AND PATCH BY OTHERS.
- © DISCONNECT AND REMOVE FLOOR DRAIN. PROVIDE WITH FLOOR CLEANOUT. FLOOR CUT AND PATCH BY OTHERS.
- DISCONNECT AND REMOVE EYE WASH AND ASSOCIATED
- ® DISCONNECT AND REMOVE FLOOR MOUNT WATER CLOSET / FLUSH VALVE. REMOVE CWS / SAN /VENT PIPING.
- DISCONNECT AND REMOVE LAVATORY / CARRIER / FAUCET.
   REMOVE CWS / HWS / SAN / VENT PIPING.




www.cjsarchitects.com







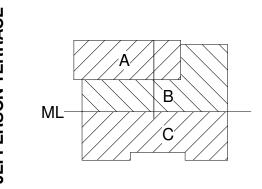



KEY PLAN

SED # 26-16-00-01-0-004-024 DWT SED # 26-16-00-01-7-999-020

Rochester Schools Modernization Program
- Phase 2c

George M. Forbes - Renovation, Alterations and Addition

198 Dr Samuel McCree Way, Rochester NY, 14611

REV.#	DESCRIPTION	DATE
1	Revision 1	Date 1
1	Revision 1	


#### GEORGE MATHER FORBES SCHOOL NO.4

JOB NO.	1711
SCALE	1/8" = 1'-0"
ISSUE DATE	4/25/18
DRAWN BY	BCW
CHECKED BY	Checker

THIS IS A SINGLE SHEET OF A COHESIVE SET OF CONSTRUCTION DOCUMENTS (INCLUDING DRAWINGS AND SPECIFICATIONS). INTERPRETATION OF THE INFORMATION AS PRESENTED SHOULD BE BASED ON THE ENTIRE SET OF DOCUMENTS.

PLUMBING PARTIAL
DEMOLITION
BASEMENT PLAN

PD-101.1

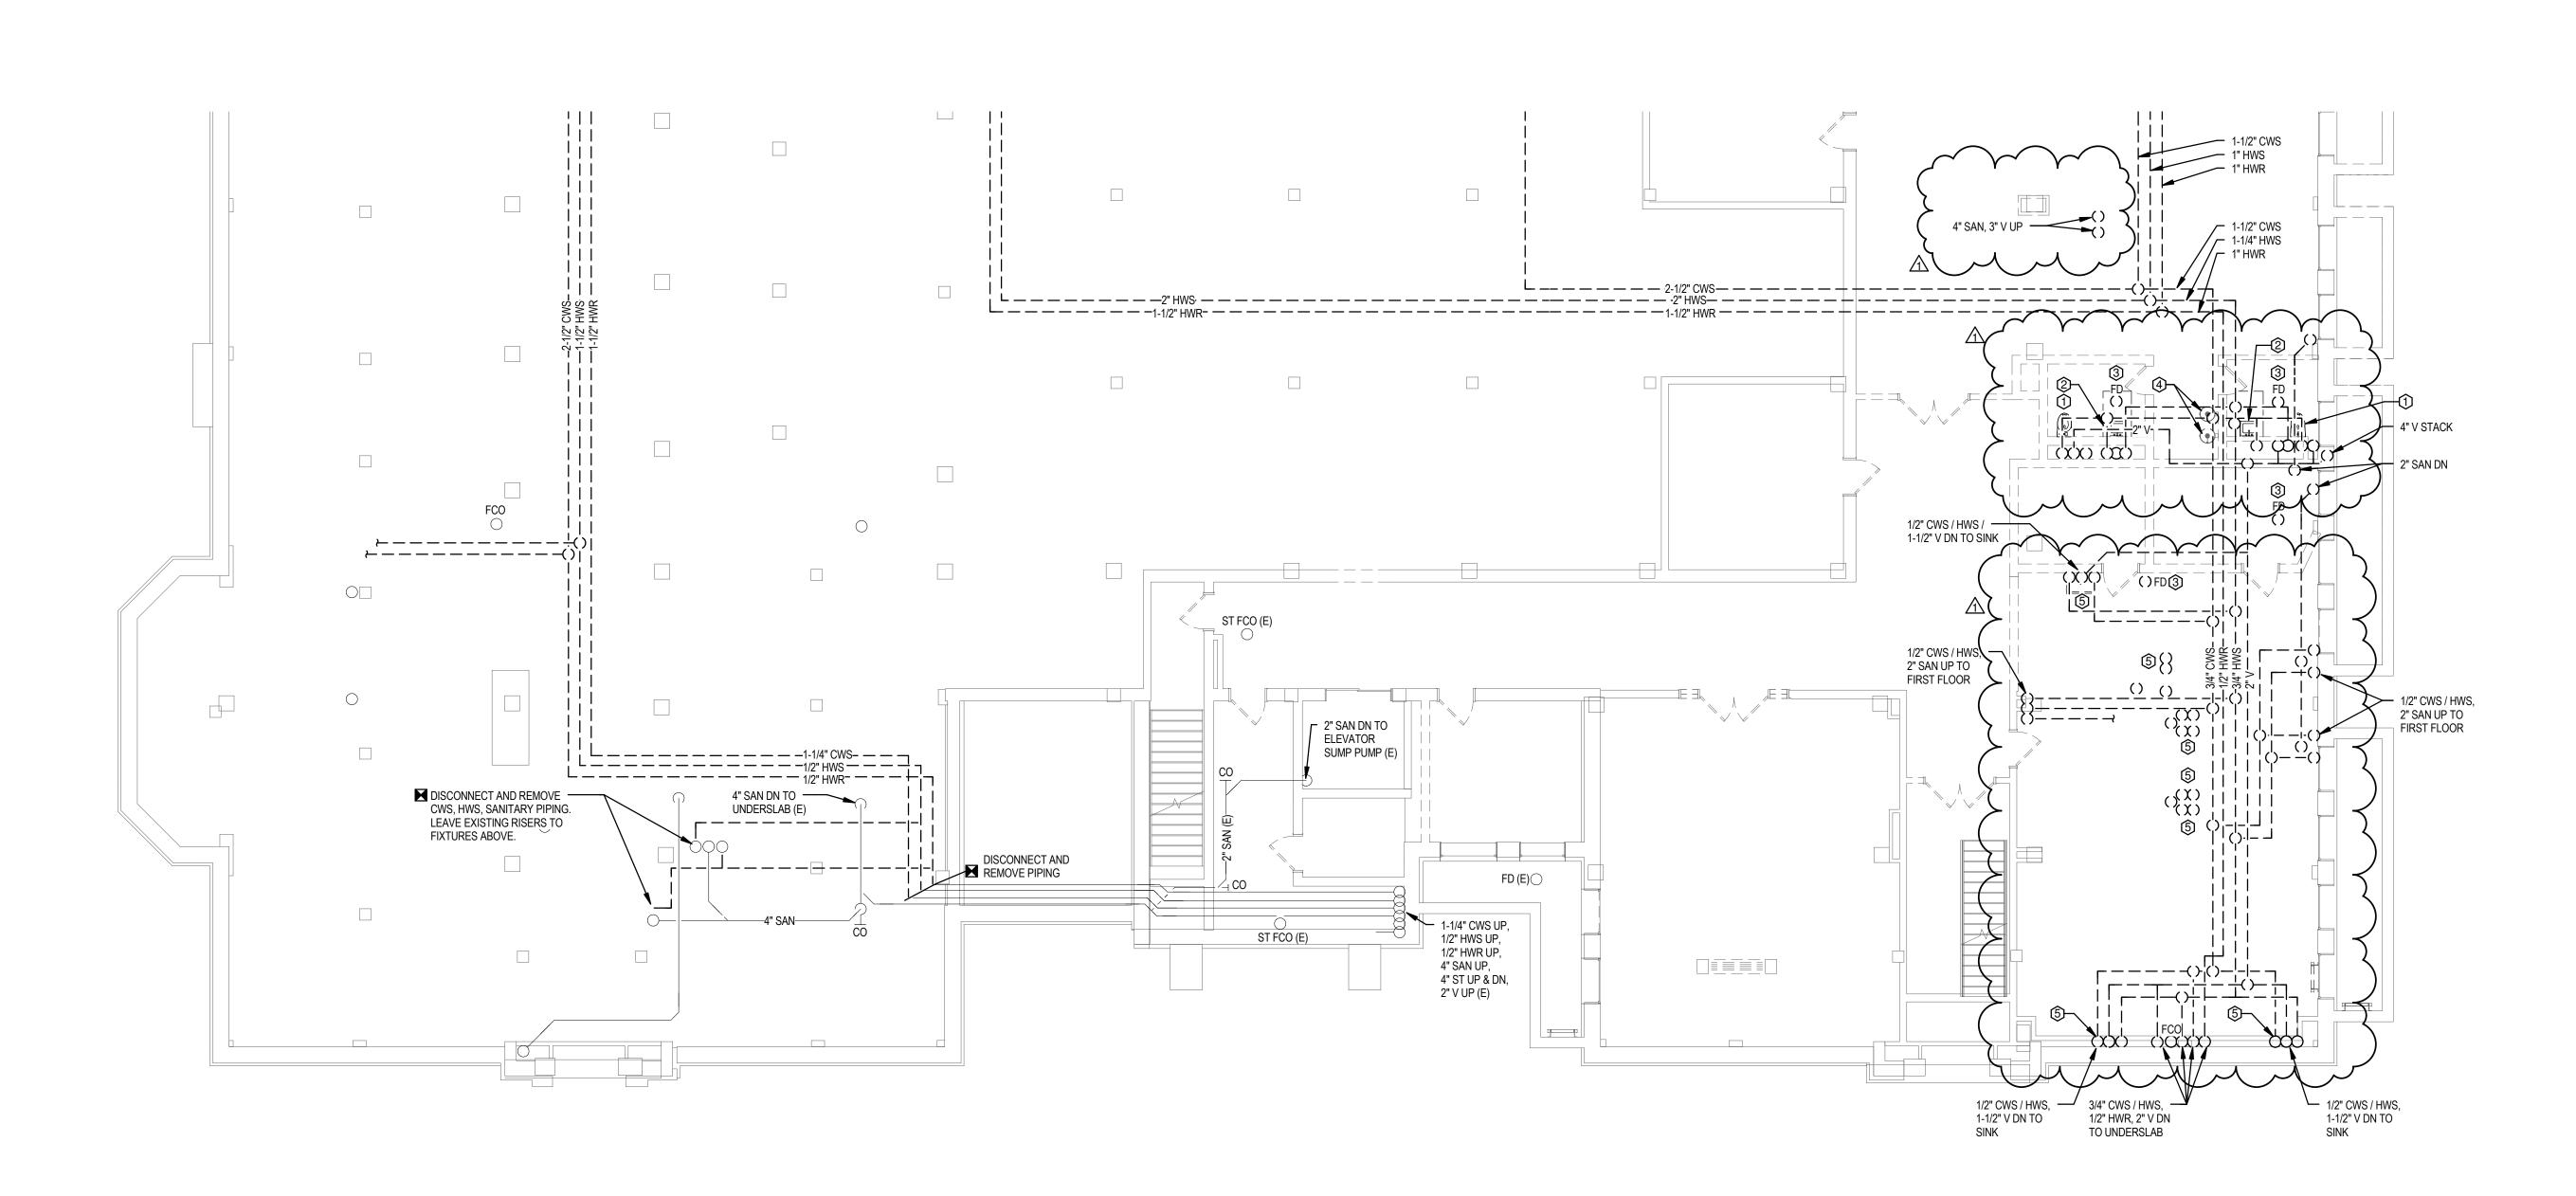

1 PLUMBING BASEMENT SOUTH DEMOLITION PLAN 1/8" = 1'-0"

#### **GENERAL NOTES:**

1. ALL CUTTING AND PATCHING ASSOCIATED WITH THE PLUMBING SCOPE OF WORK SHALL BE COMPLETED BY THE PLUMBING CONTRACTOR.

### DRAWING NOTES:

- ① DISCONNECT AND REMOVE FLOOR MOUNT WATER CLOSET / FLUSH VALVE. REMOVE CWS / SAN /VENT PIPING.
- ② DISCONNECT AND REMOVE LAVATORY / CARRIER / FAUCET. REMOVE CWS / HWS / SAN / VENT PIPING.
- ③ DISCONNECT AND REMOVE FLOOR DRAIN. PROVIDE WITH FLOOR CLEANOUT. FLOOR CUT AND PATCH BY OTHERS.
- DISCONNECT AND REMOVE DRINKING FOUNTAIN.
   REMOVE CWS / SAN / VENT TO WITHIN WALL.
- ⑤ DISCONNECT AND REMOVE SINK / FAUCET. REMOVE CWS / HWS / SAN / VENT PIPING.


ARCHITECTS

BUFFALO | ROCHESTER www.cjsarchitects.com







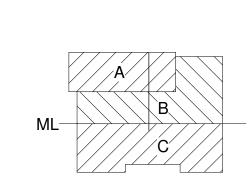



KEY PLAN

SED # 26-16-00-01-0-004-024 DWT SED # 26-16-00-01-7-999-020

Rochester Schools Modernization Program
- Phase 2c

George M. Forbes - Renovation, Alterations and Addition

198 Dr Samuel McCree Way, Rochester NY, 14611

DEV #	DESCRIPTION	DATE
REV.#	DESCRIPTION	DATE
1	Revision 1	Date 1

# GEORGE MATHER FORBES SCHOOL NO.4


JOB NO.	171
SCALE	1/8" = 1'-0
ISSUE DATE	4/25/1
DRAWN BY	BCV
CHECKED BY	Checke
THIS IS A SINGLE SHEET OF A COHESIVE	

ITHIS IS A SINGLE SHEET OF A COHESIVE SET OF CONSTRUCTION DOCUMENTS (INCLUDING DRAWINGS AND SPECIFICATIONS). INTERPRETATION OF THE INFORMATION AS PRESENTED SHOULD BE BASED ON THE ENTIRE SET OF DOCUMENTS.

IO TITLE

PLUMBING PARTIAL DEMOLITION BASEMENT PLAN

PD-101.2

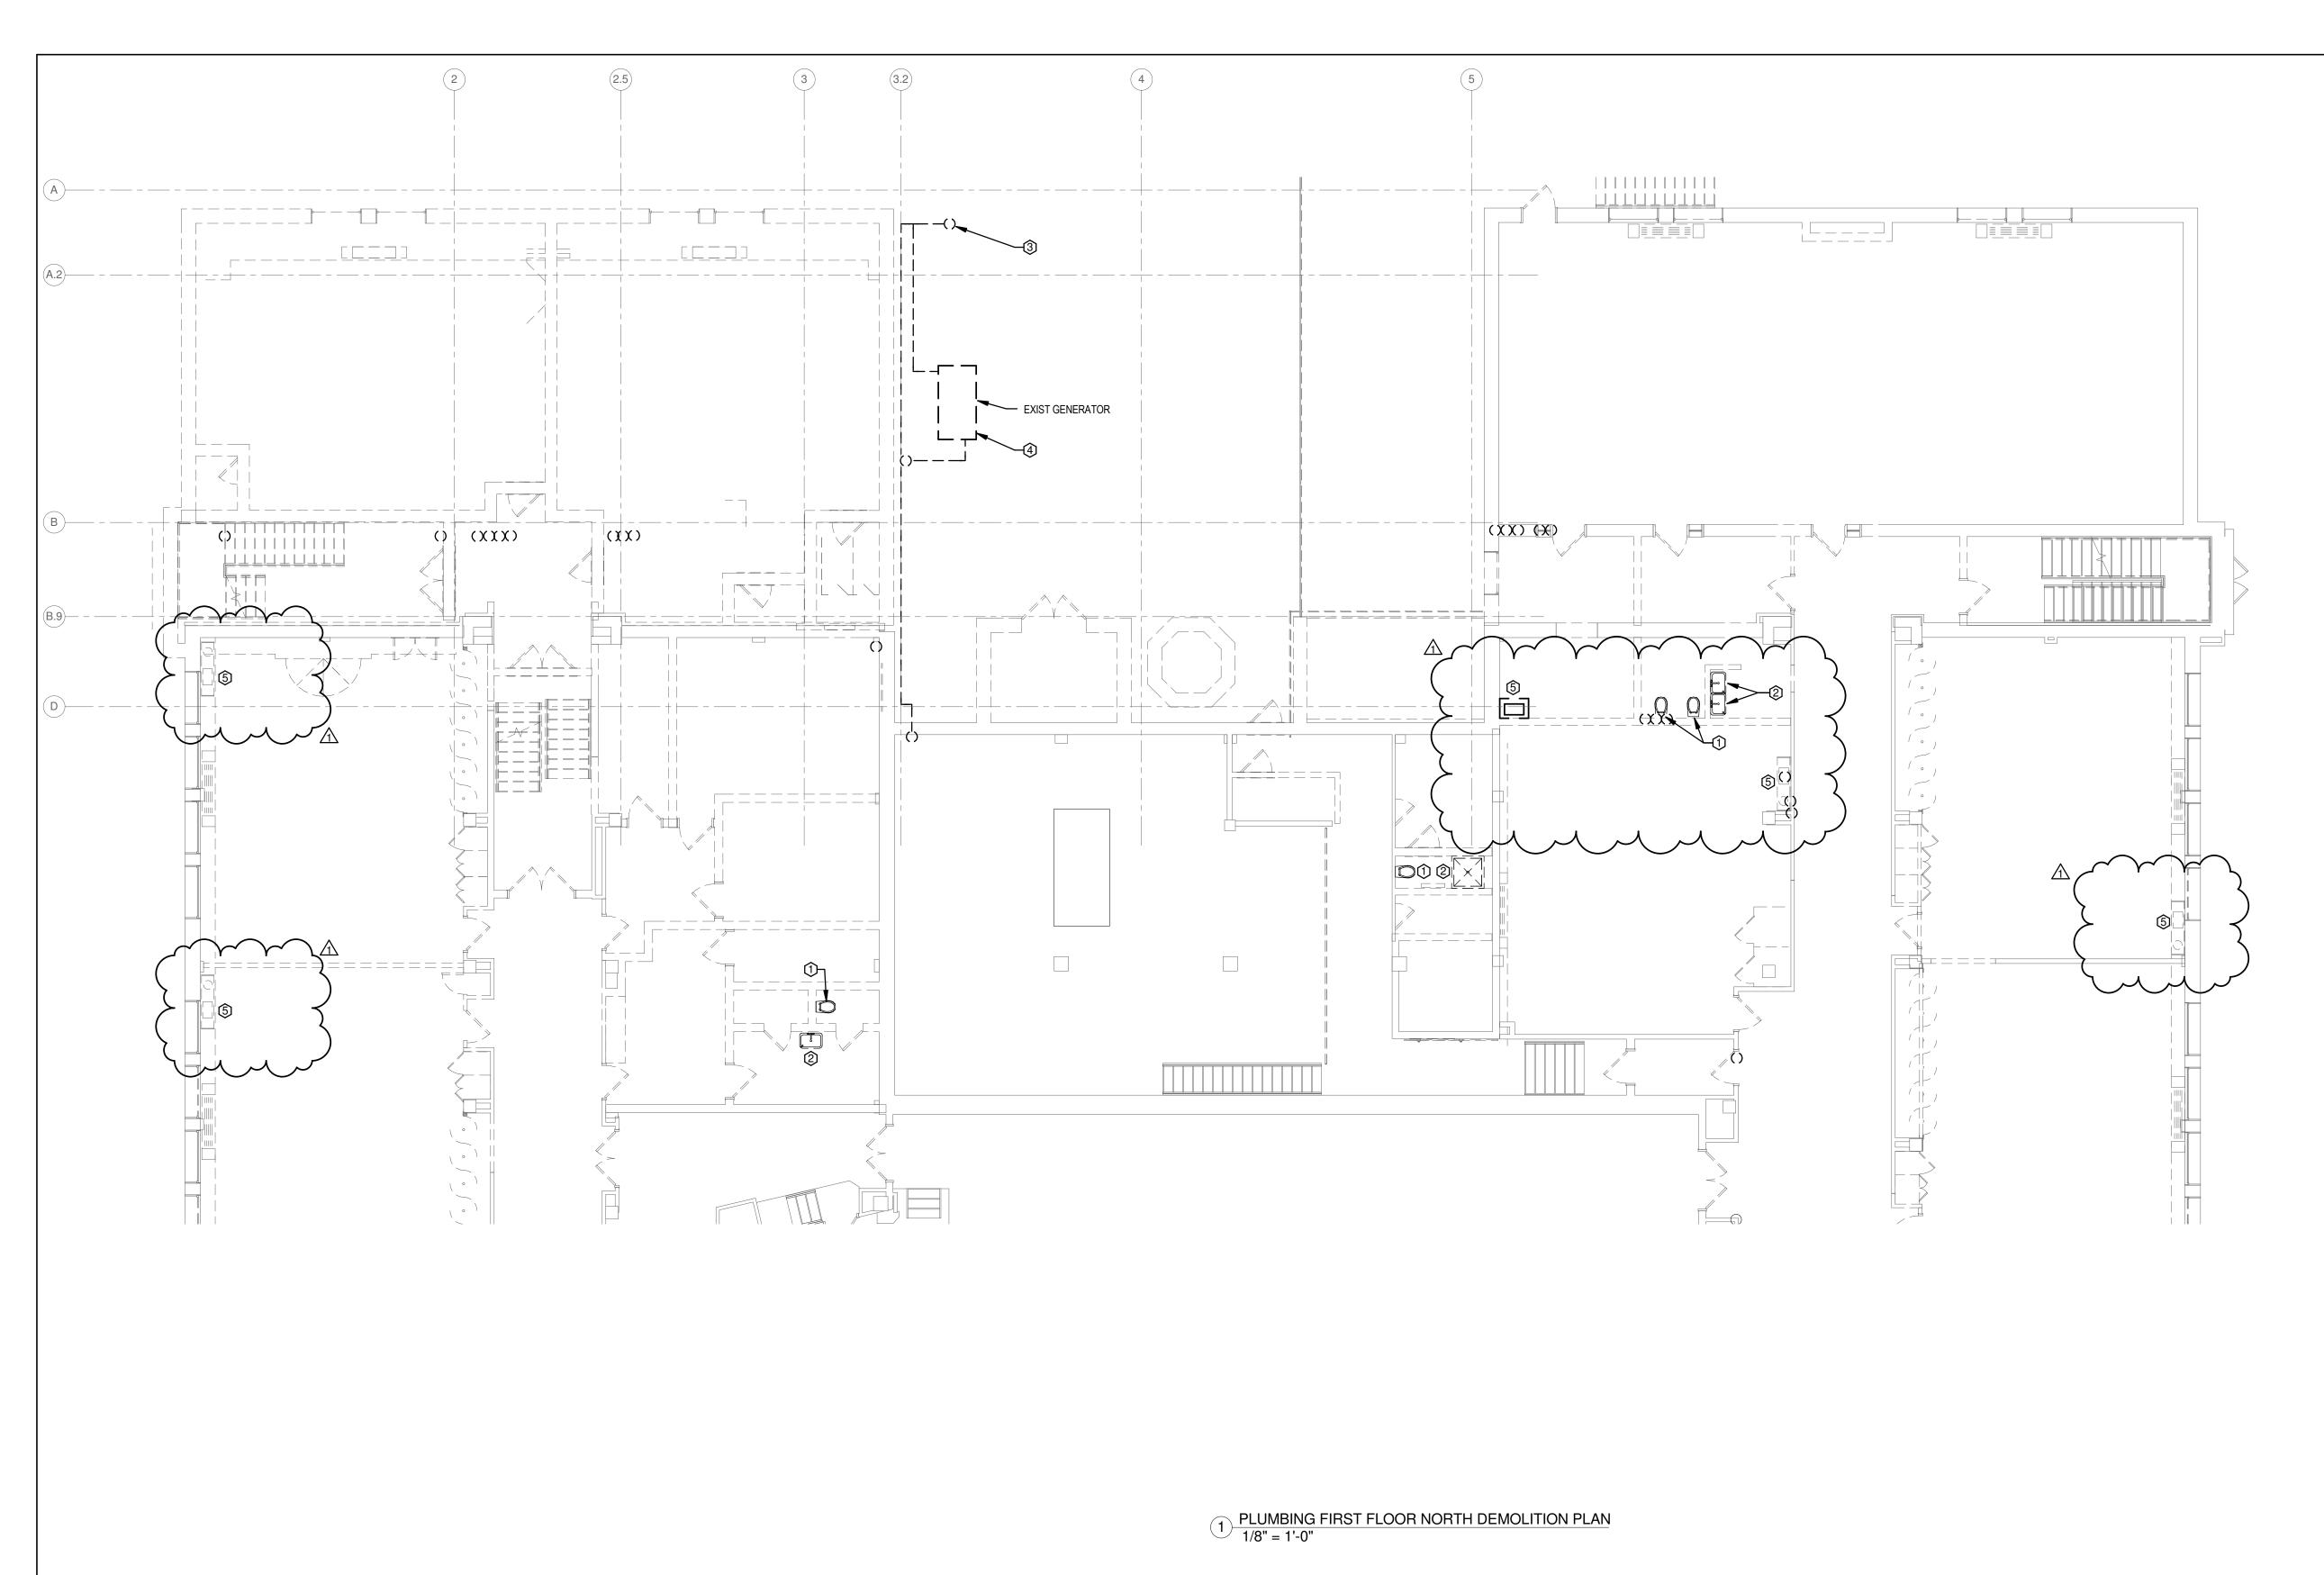

### **GENERAL NOTES:**

1. ALL CUTTING AND PATCHING ASSOCIATED WITH THE PLUMBING SCOPE OF WORK SHALL BE COMPLETED BY THE PLUMBING CONTRACTOR.

### DRAWING NOTES:


- ① DISCONNECT AND REMOVE FLOOR MOUNT WATER CLOSET / FLUSH VALVE. REMOVE CWS / SAN /VENT PIPING.
- ② DISCONNECT AND REMOVE LAVATORY / CARRIER / FAUCET. REMOVE CWS / HWS / SAN / VENT PIPING.
- ③ DISCONNECT AND REMOVE GAS PIPING TO BUILDING. MAINTAIN METER / REGULATOR FOR NEW LOCATION. COORDINATE GAS WORK WITH LOCAL GAS UTILITY.
- ① DISCONNECT AND REMOVE GAS PIPING TO GENERATOR GENERATOR REMOVAL BY OTHERS
- (5) DISCONNECT AND REMOVE SINK. REMOVE CWS / HWS / SAN / VENT TO WITHIN WALL.









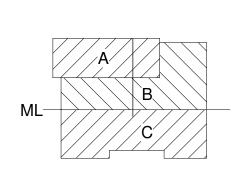



KEY PLAN

SED # 26-16-00-01-0-004-024 DWT SED # 26-16-00-01-7-999-020

Rochester Schools Modernization Program
- Phase 2c
George M. Forbes - Renovation, Alterations

and Addition

198 Dr Samuel McCree Way,

	Rochester NY, 14611	<b>3</b> ,
#	DESCRIPTION	DATE
	Revision 1	Date 1

• . //	DECOMM HON	57112
1	Revision 1	Date 1

### GEORGE MATHER FORBES SCHOOL NO.4


JOB NO.	171
SCALE	1/8" = 1'-0
ISSUE DATE	4/25/1
DRAWN BY	BCV
CHECKED BY	Checke
THIS IS A SINGLE SHEET OF A COHESIVE	

THIS IS A SINGLE SHEET OF A COHESIVE SET OF CONSTRUCTION DOCUMENTS (INCLUDING DRAWINGS AND SPECIFICATIONS). INTERPRETATION OF THE INFORMATION AS PRESENTED SHOULD BE BASED ON THE ENTIRE SET OF DOCUMENTS.

\_\_\_\_\_

PLUMBING PARTIAL DEMOLITION FIRST FLOOR PLAN

PD-102.1

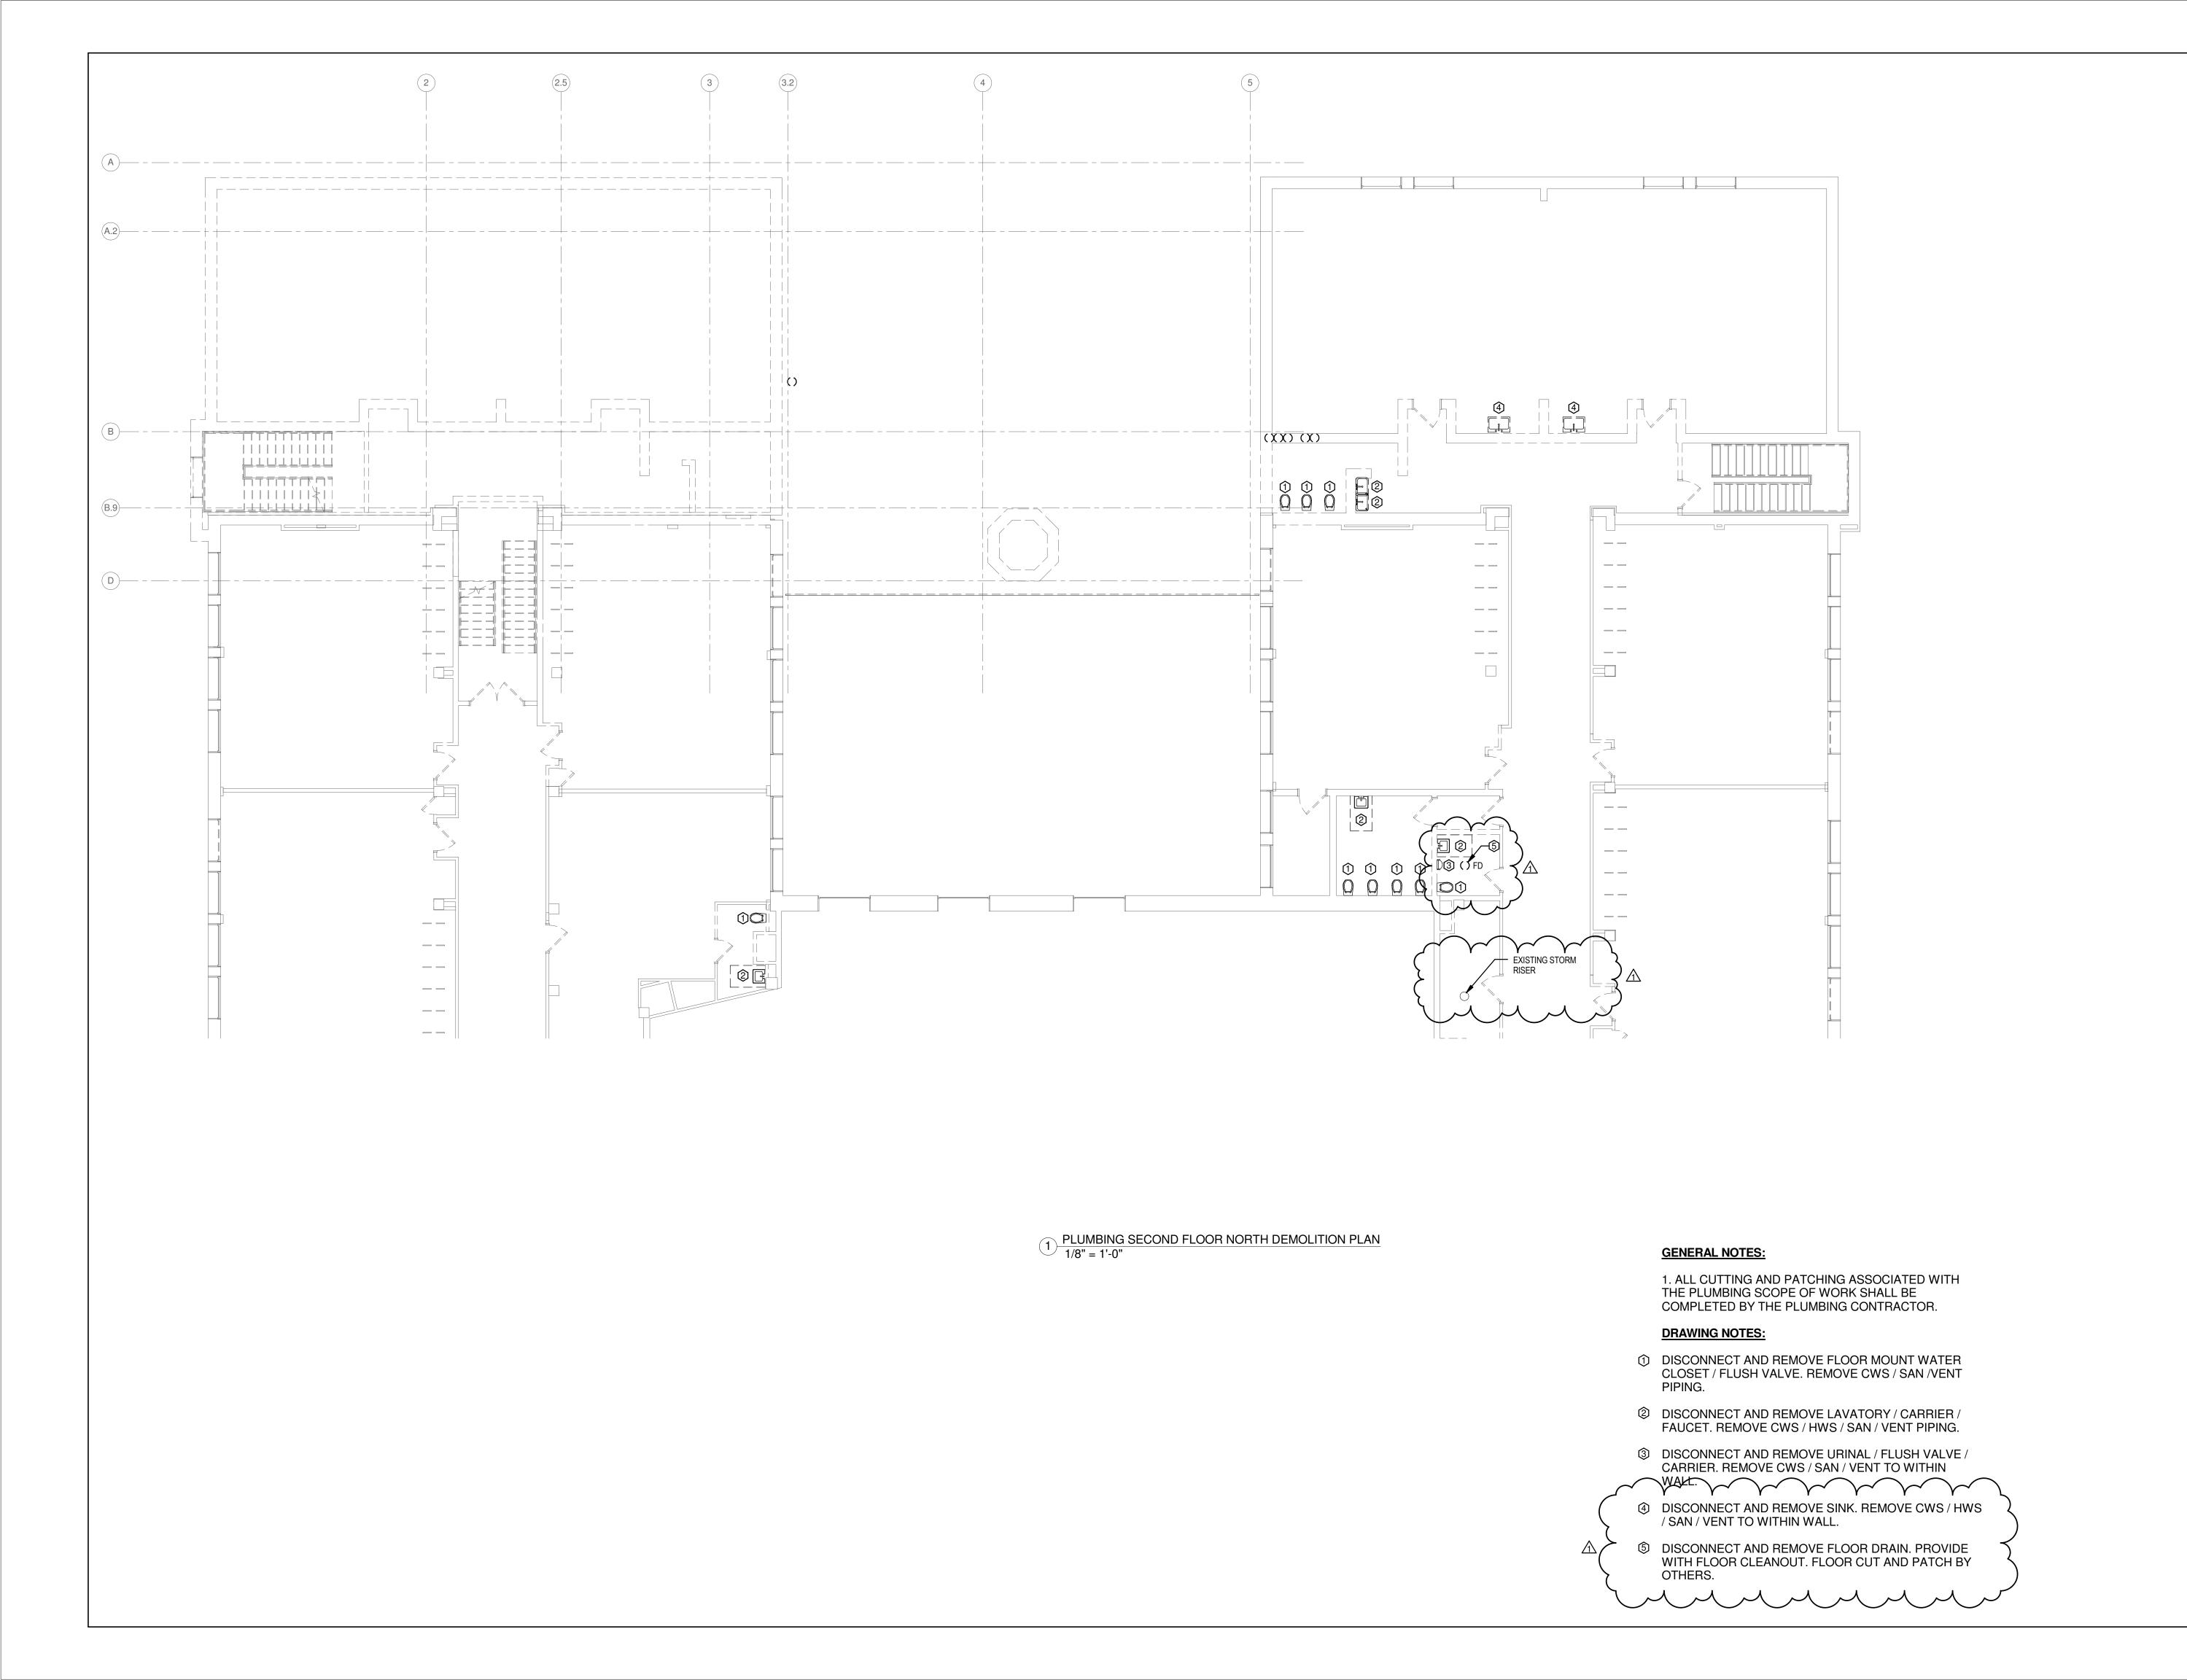










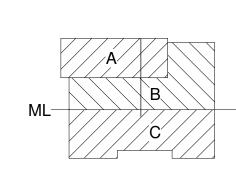

KEY PLAN

DR. SAMUEL MCCREE WAY

SED # 26-16-00-01-0-004-024 DWT SED # 26-16-00-01-7-999-020

Rochester Schools Modernization Program
- Phase 2c

George M. Forbes - Renovation, Alterations and Addition

198 Dr Samuel McCree Way, Rochester NY, 14611

REV.#	DESCRIPTION	DATE
1	Revision 1	Date 1

GEORGE MATHER FORBES SCHOOL NO.4


JOB NO.	1711
SCALE	1/8" = 1'-0"
ISSUE DATE	4/25/18
DRAWN BY	BCW
CHECKED BY	Checker
THIS IS A SINGLE SHEET OF A COHESIVE	

THIS IS A SINGLE SHEET OF A COHESIVE SET OF CONSTRUCTION DOCUMENTS (INCLUDING DRAWINGS AND SPECIFICATIONS). INTERPRETATION OF THE INFORMATION AS PRESENTED SHOULD BE BASED ON THE ENTIRE SET OF DOCUMENTS.

AWING TITLE

PLUMBING PARTIAL DEMOLITION SECOND FLOOR PLAN

PD-103.1

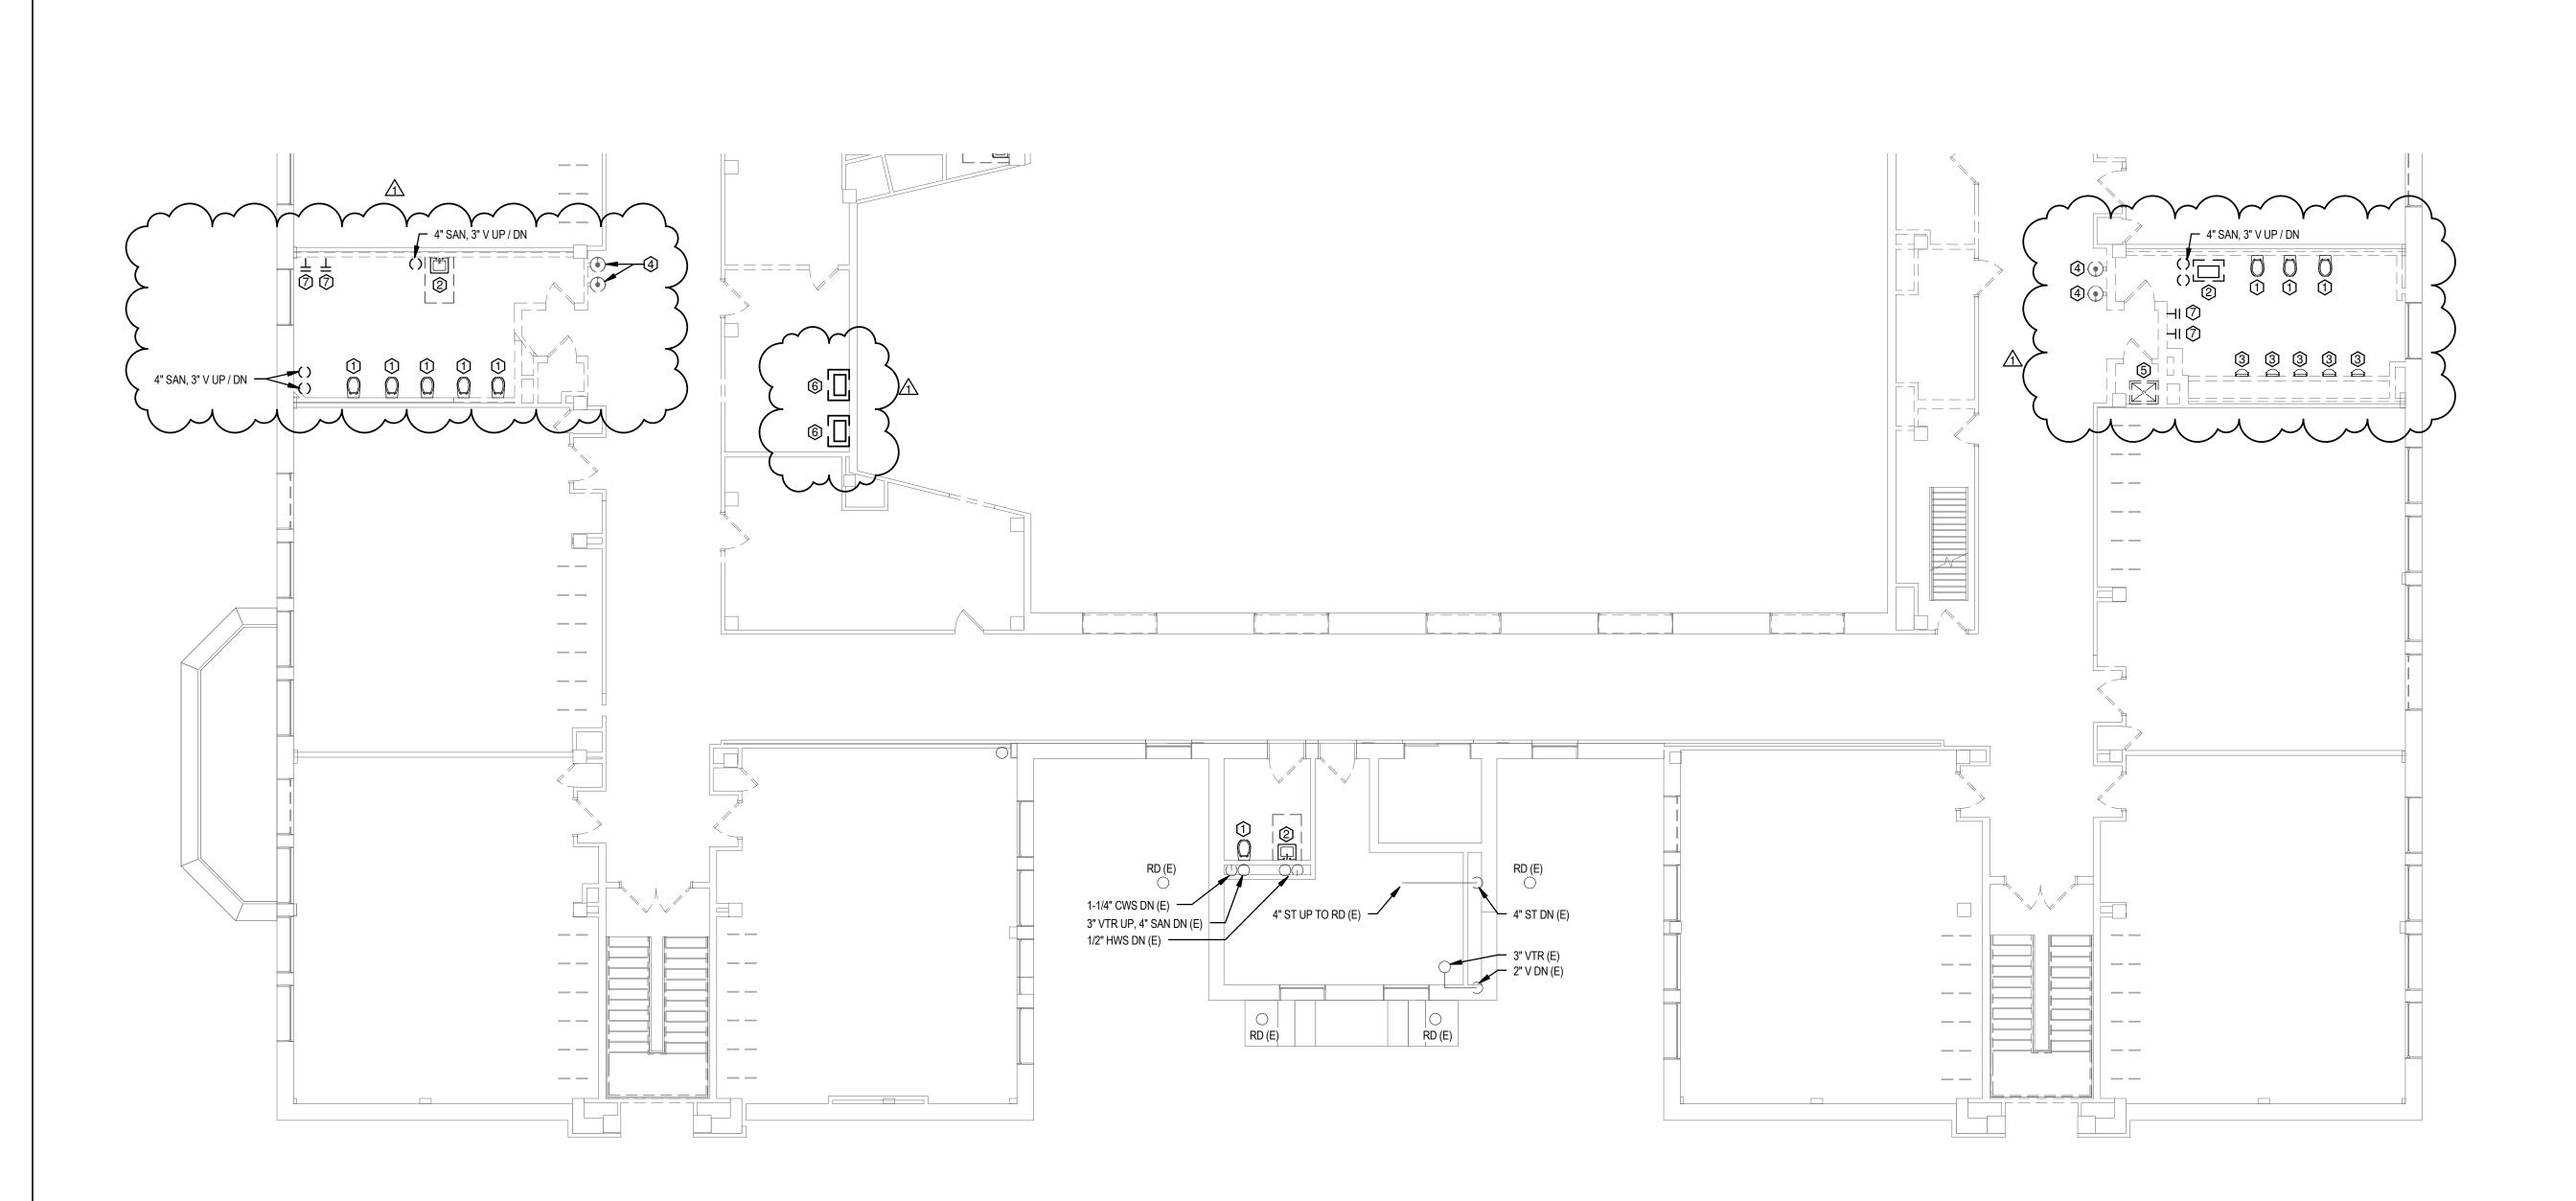

1 PLUMBING SECOND FLOOR SOUTH DEMOLITION PLAN 1/8" = 1'-0"

#### **GENERAL NOTES:**

1. ALL CUTTING AND PATCHING ASSOCIATED WITH THE PLUMBING SCOPE OF WORK SHALL BE COMPLETED BY THE PLUMBING CONTRACTOR.

### **DRAWING NOTES:**

- ① DISCONNECT AND REMOVE FLOOR MOUNT WATER CLOSET / FLUSH VALVE. REMOVE CWS / SAN /VENT
- ② DISCONNECT AND REMOVE LAVATORY / CARRIER / FAUCET. REMOVE CWS / HWS / SAN / VENT PIPING.
- ③ DISCONNECT AND REMOVE URINAL / FLUSH VALVE / CARRIER. REMOVE CWS / SAN / VENT PIPING.
- DISCONNECT AND REMOVE DRINKING FOUNTAIN.
   REMOVE CWS / SAN / VENT TO WITHIN WALL.
- ⑤ DISCONNECT AND REMOVE MOP SINK BASIN / FAUCET.

  REMOVE CWS7 HWS/SAN / VENT PIPING.
- © DISCONNECT AND REMOVE SINK. REMOVE CWS / HWS / SAN / VENT TO WITHIN WALL.
- DISCONNECT AND REMOVE HOSE BIBB. REMOVE CWS




BUFFALO | ROCHESTER www.cjsarchitects.com







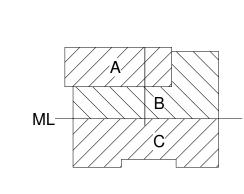



SED # 26-16-00-01-0-004-024

KEY PLAN

Rochester Schools Modernization Program
- Phase 2c

DWT SED # 26-16-00-01-7-999-020

George M. Forbes - Renovation, Alterations and Addition

198 Dr Samuel McCree Way, Rochester NY, 14611

Ī	REV.#	DESCRIPTION	DATE
	1	Revision 1	Date 1

GEORGE MATHER FORBES SCHOOL NO.4


JOB NO.	1711
SCALE	1/8" = 1'-0"
ISSUE DATE	4/25/18
DRAWN BY	BCW
CHECKED BY	Checker

THIS IS A SINGLE SHEET OF A COHESIVE SET OF CONSTRUCTION DOCUMENTS (INCLUDING DRAWINGS AND SPECIFICATIONS). INTERPRETATION OF THE INFORMATION AS PRESENTED SHOULD BE BASED ON THE ENTIRE SET OF DOCUMENTS.

\_\_\_\_\_

PLUMBING PARTIAL DEMOLITION SECOND FLOOR PLAN

PD-103.2

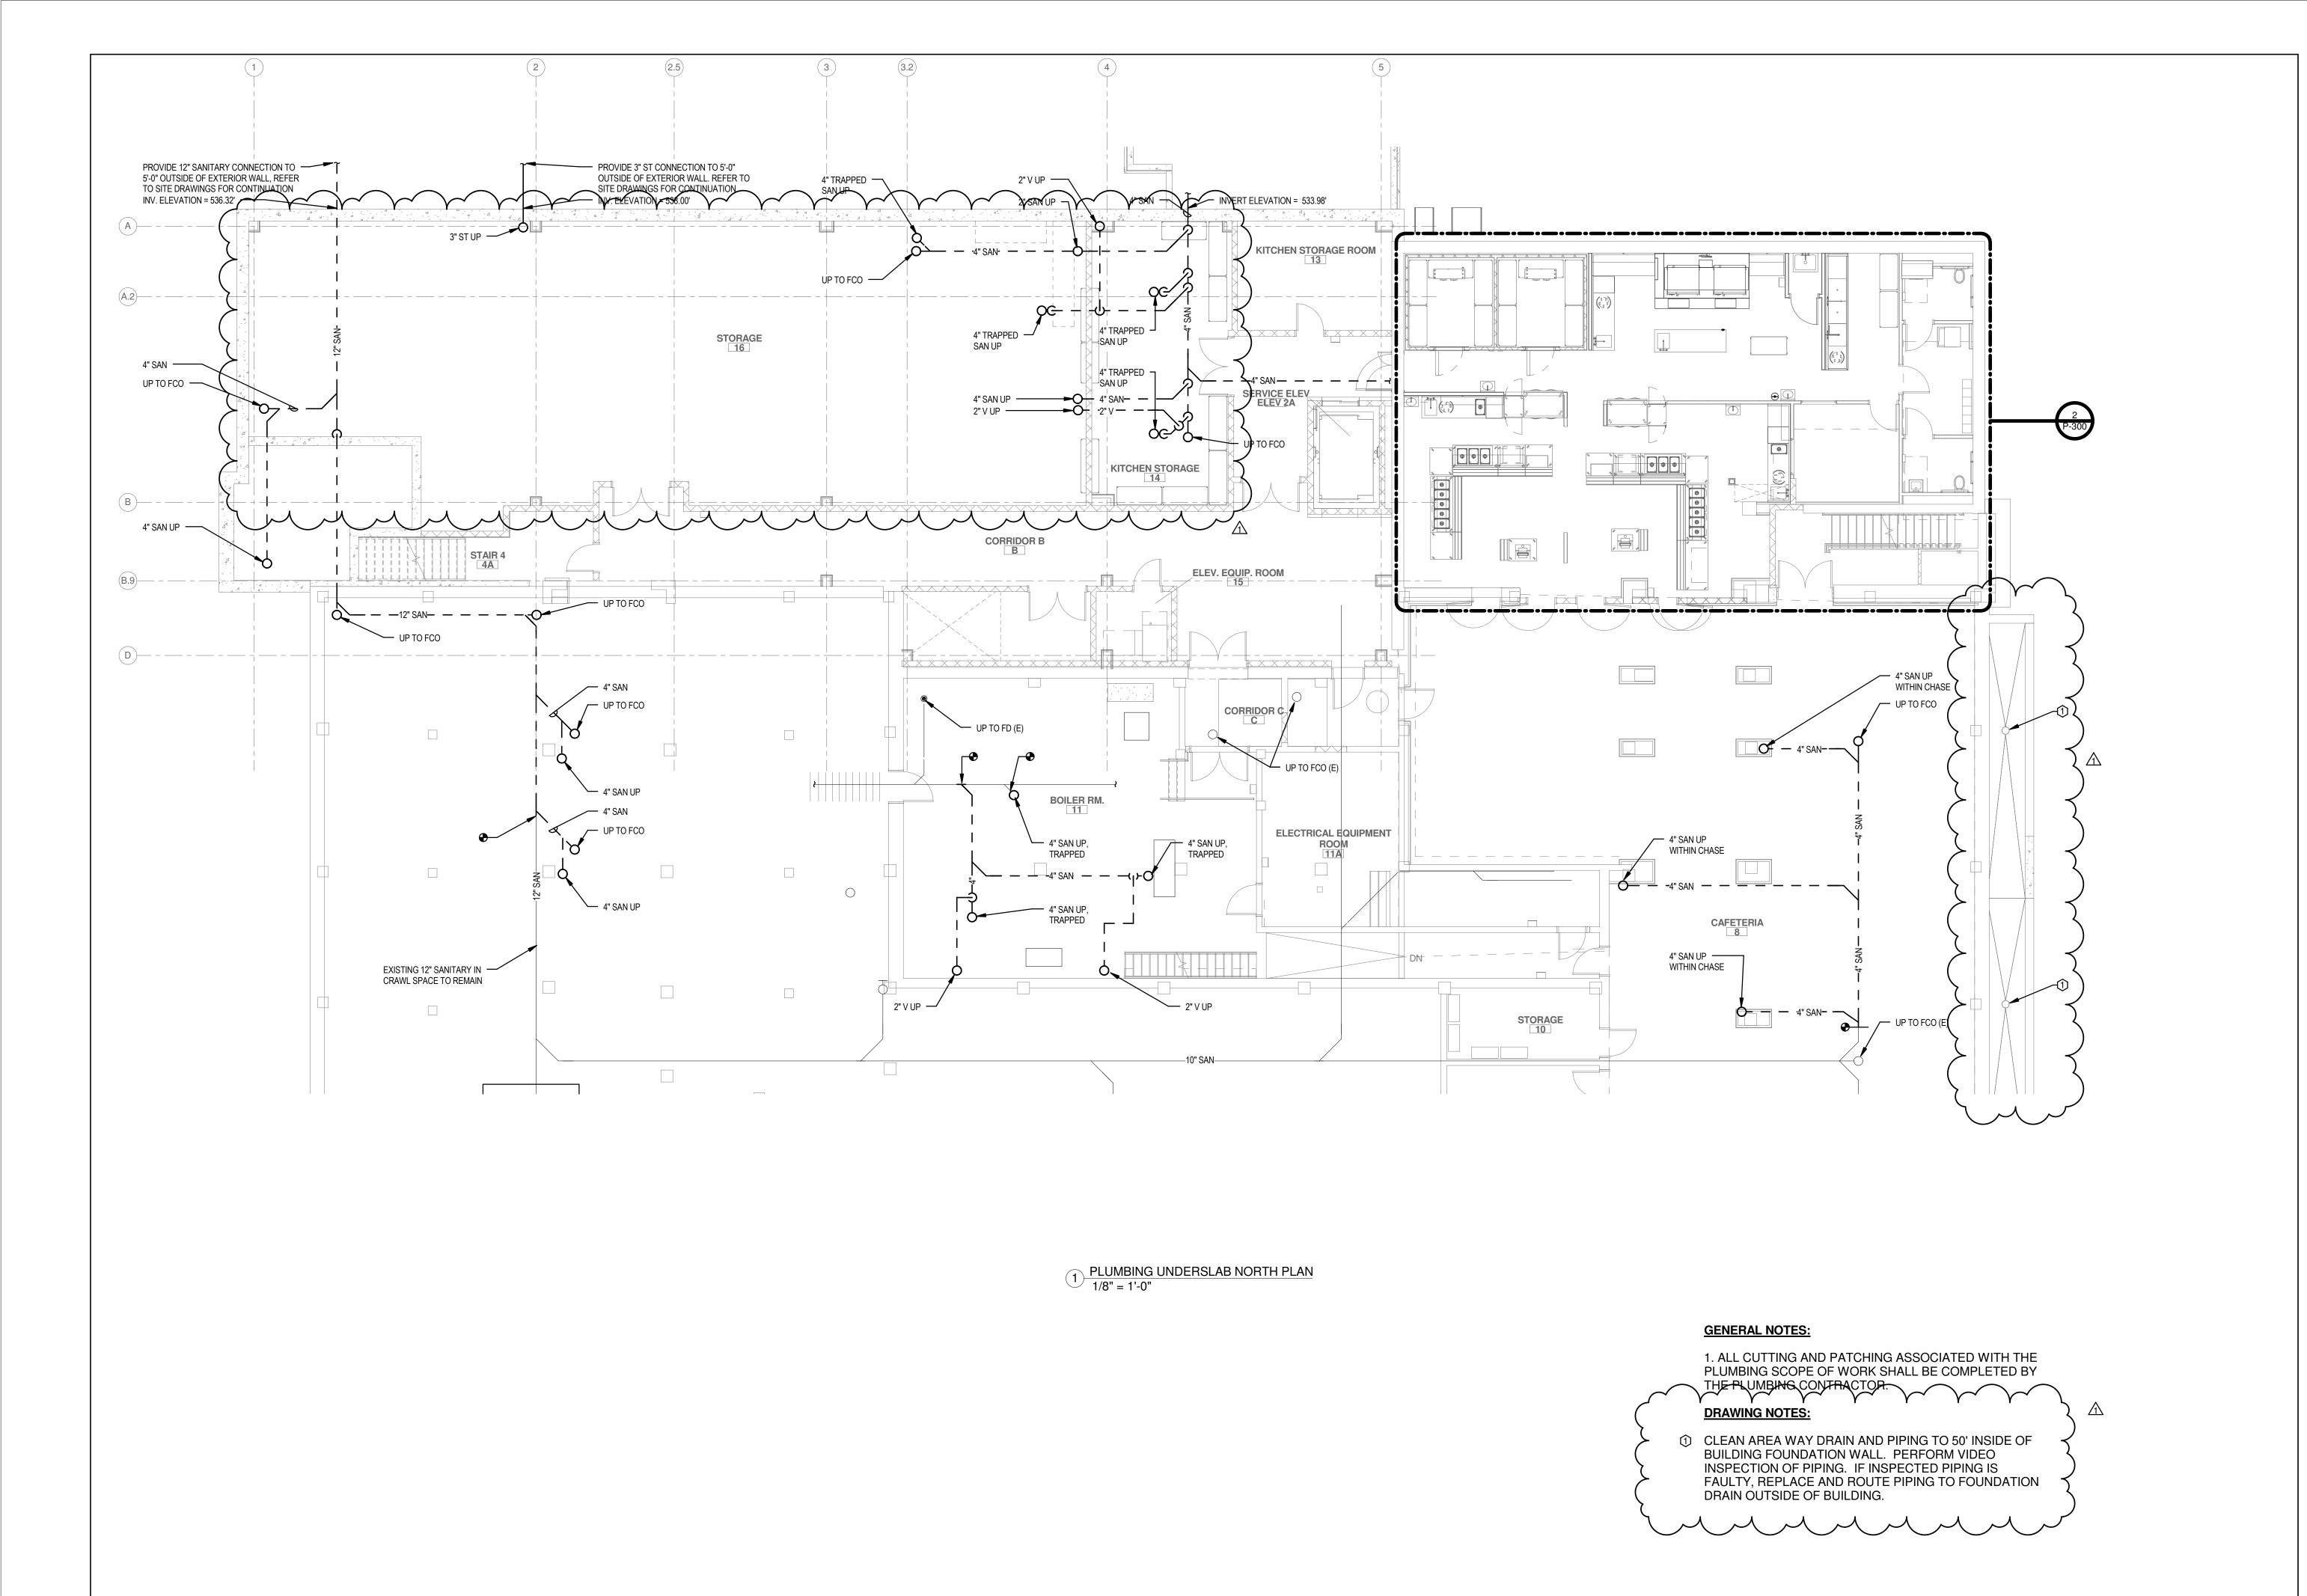










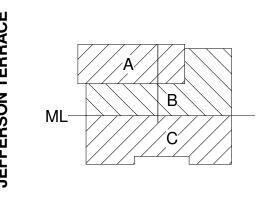

DR. SAMUEL MCCREE WAY
KEY PLAN

SED # 26-16-00-01-0-004-024 DWT SED # 26-16-00-01-7-999-020

Rochester Schools Modernization Program
- Phase 2c

George M. Forbes - Renovation, Alterations and Addition

198 Dr Samuel McCree Way, Rochester NY, 14611

REV.#	DESCRIPTION	DATE
1	Revision 1	Date 1

### GEORGE MATHER FORBES SCHOOL NO.4


JOB NO.	1711
SCALE	1/8" = 1'-0
ISSUE DATE	4/25/18
DRAWN BY	BCW
CHECKED BY	Checke
THIS IS A SINGLE SHEET OF A COHESIVE	

THIS IS A SINGLE SHEET OF A COHESIVE SET OF CONSTRUCTION DOCUMENTS (INCLUDING DRAWINGS AND SPECIFICATIONS). INTERPRETATION OF THE INFORMATION AS PRESENTED SHOULD BE BASED ON THE ENTIRE SET OF DOCUMENTS.

DRAWING TITLE

UNDERSLAB
PLUMBING PARTIAL
FLOOR PLAN

P-100.1

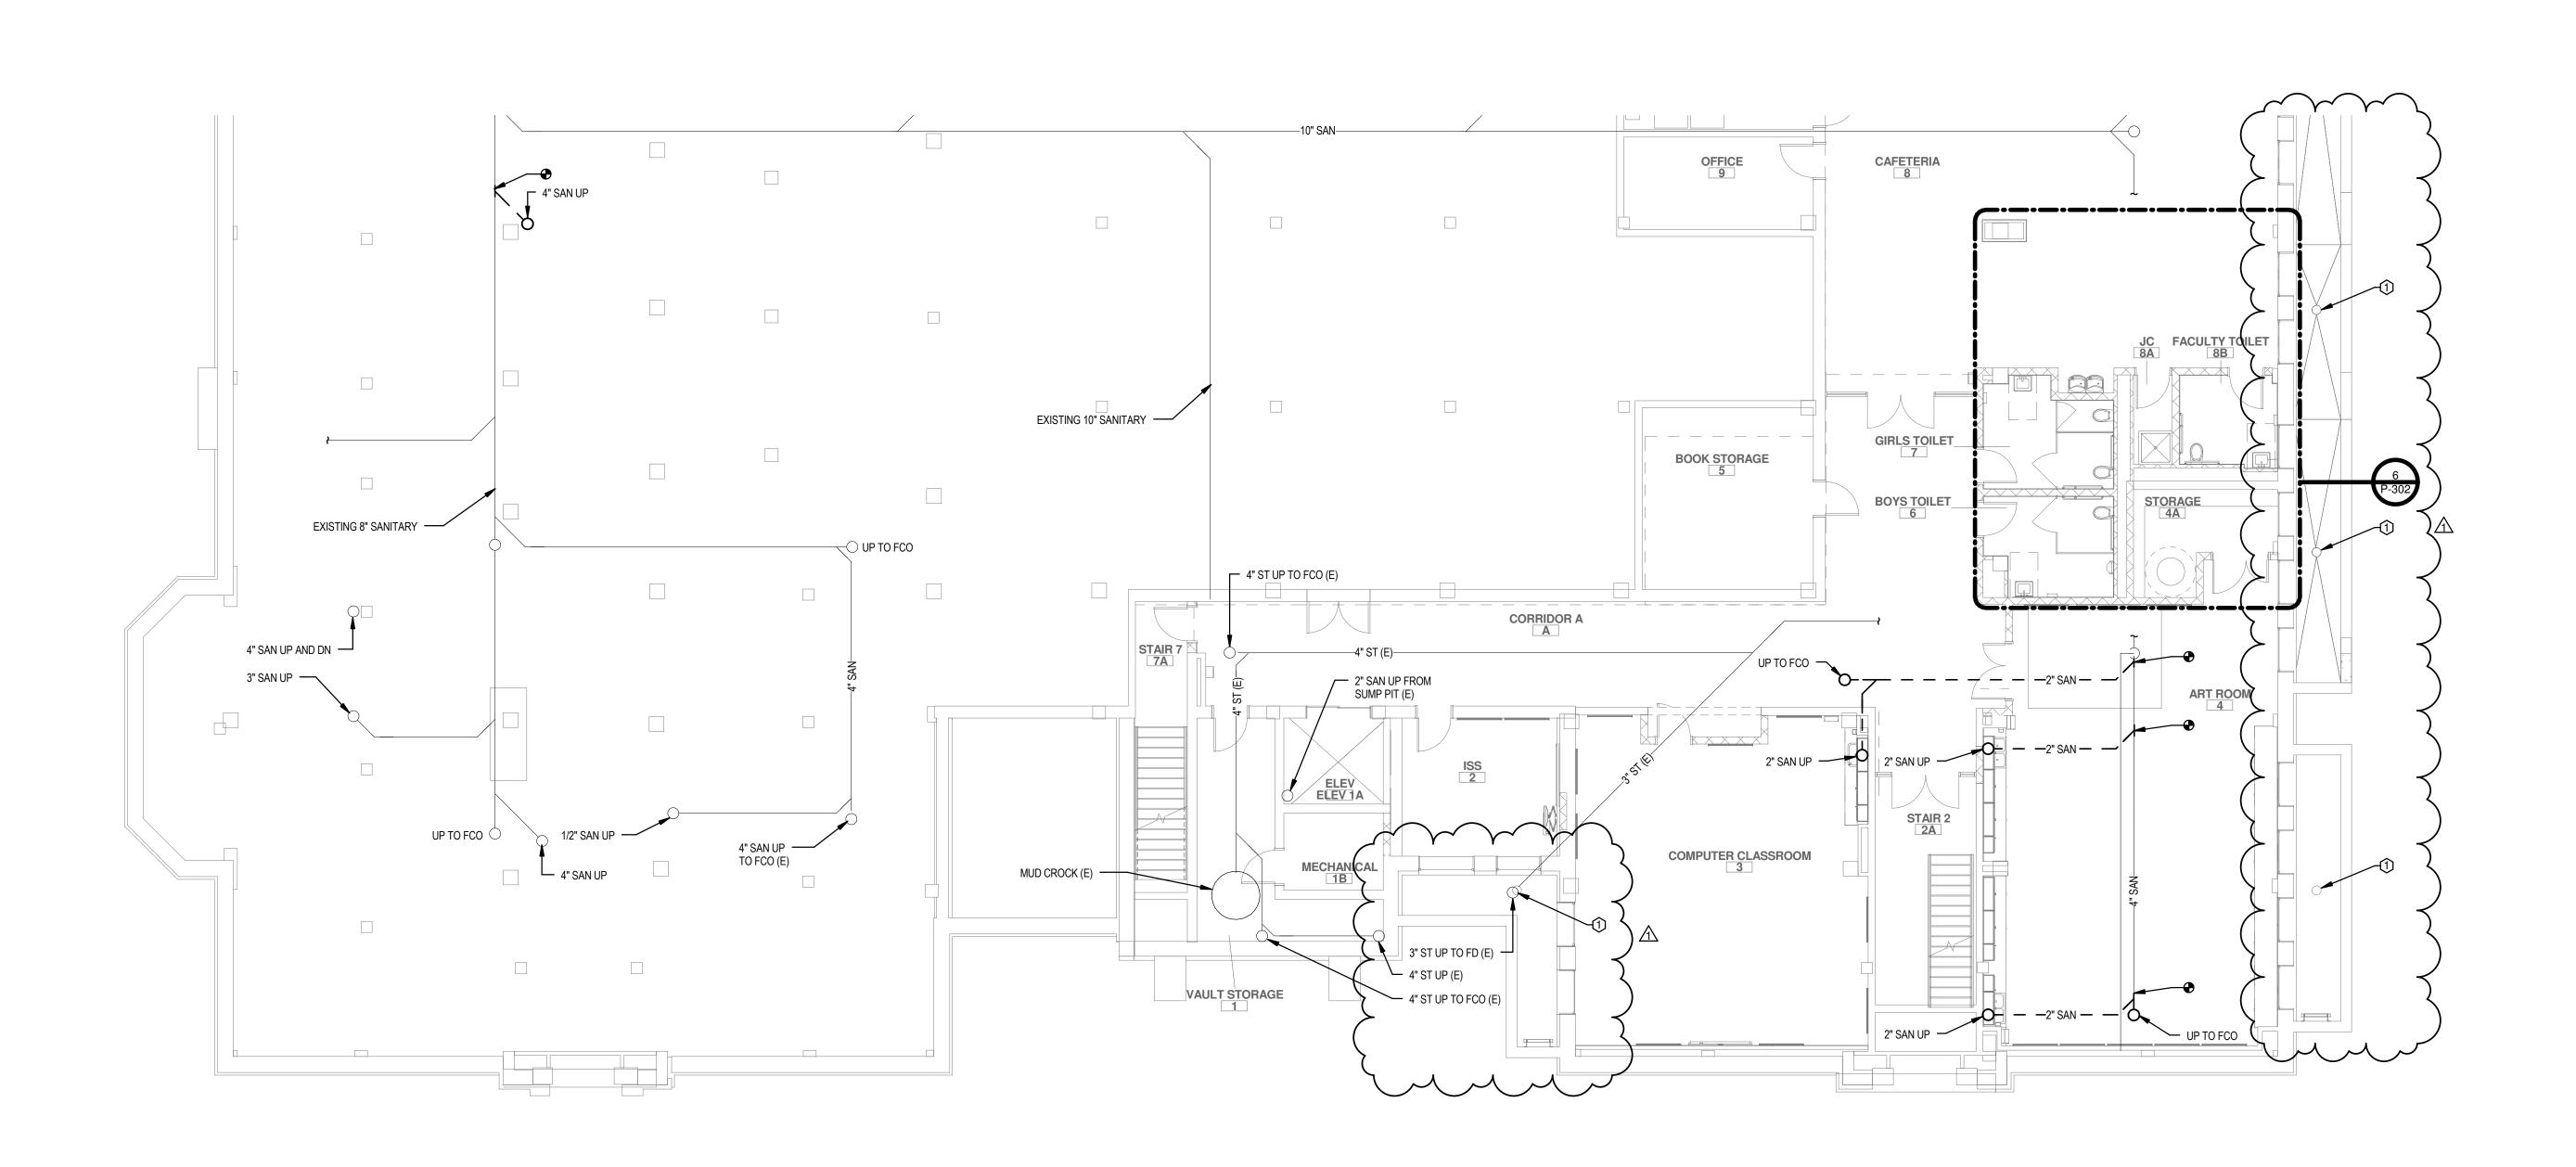

1 PLUMBING UNDERSLAB SOUTH PLAN 1/8" = 1'-0"

### **GENERAL NOTES:**

1. ALL CUTTING AND PATCHING ASSOCIATED WITH THE PLUMBING SCOPE OF WORK SHALL BE COMPLETED BY

#### **DRAWING NOTES:**


① CLEAN AREA WAY DRAIN AND PIPING TO 50' INSIDE OF BUILDING FOUNDATION WALL. PERFORM VIDEO INSPECTION OF PIPING. IF INSPECTED PIPING IS FAULTY, REPLACE AND ROUTE PIPING TO FOUNDATION DRAIN OUTSIDE OF BUILDING.









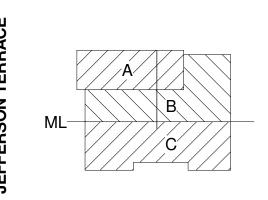



SED # 26-16-00-01-0-004-024 DWT SED # 26-16-00-01-7-999-020

Rochester Schools Modernization Program
- Phase 2c

George M. Forbes - Renovation, Alterations and Addition

198 Dr Samuel McCree Way, Rochester NY, 14611

REV.#	DESCRIPTION	DATE
1	Revision 1	Date 1
1	Revision 1	

### GEORGE MATHER FORBES SCHOOL NO.4


JOB NO.	171
SCALE	1/8" = 1'-0
ISSUE DATE	4/25/1
DRAWN BY	BCV
CHECKED BY	Checke
THIS IS A SINGLE SHEET OF A COHESIVE	

THIS IS A SINGLE SHEET OF A COHESIVE SET OF CONSTRUCTION DOCUMENTS (INCLUDING DRAWINGS AND SPECIFICATIONS). INTERPRETATION OF THE INFORMATION AS PRESENTED SHOULD BE BASED ON THE ENTIRE SET OF DOCUMENTS.

DRAWING TITLE

UNDERSLAB
PLUMBING PARTIAL
FLOOR PLAN

P-100.2

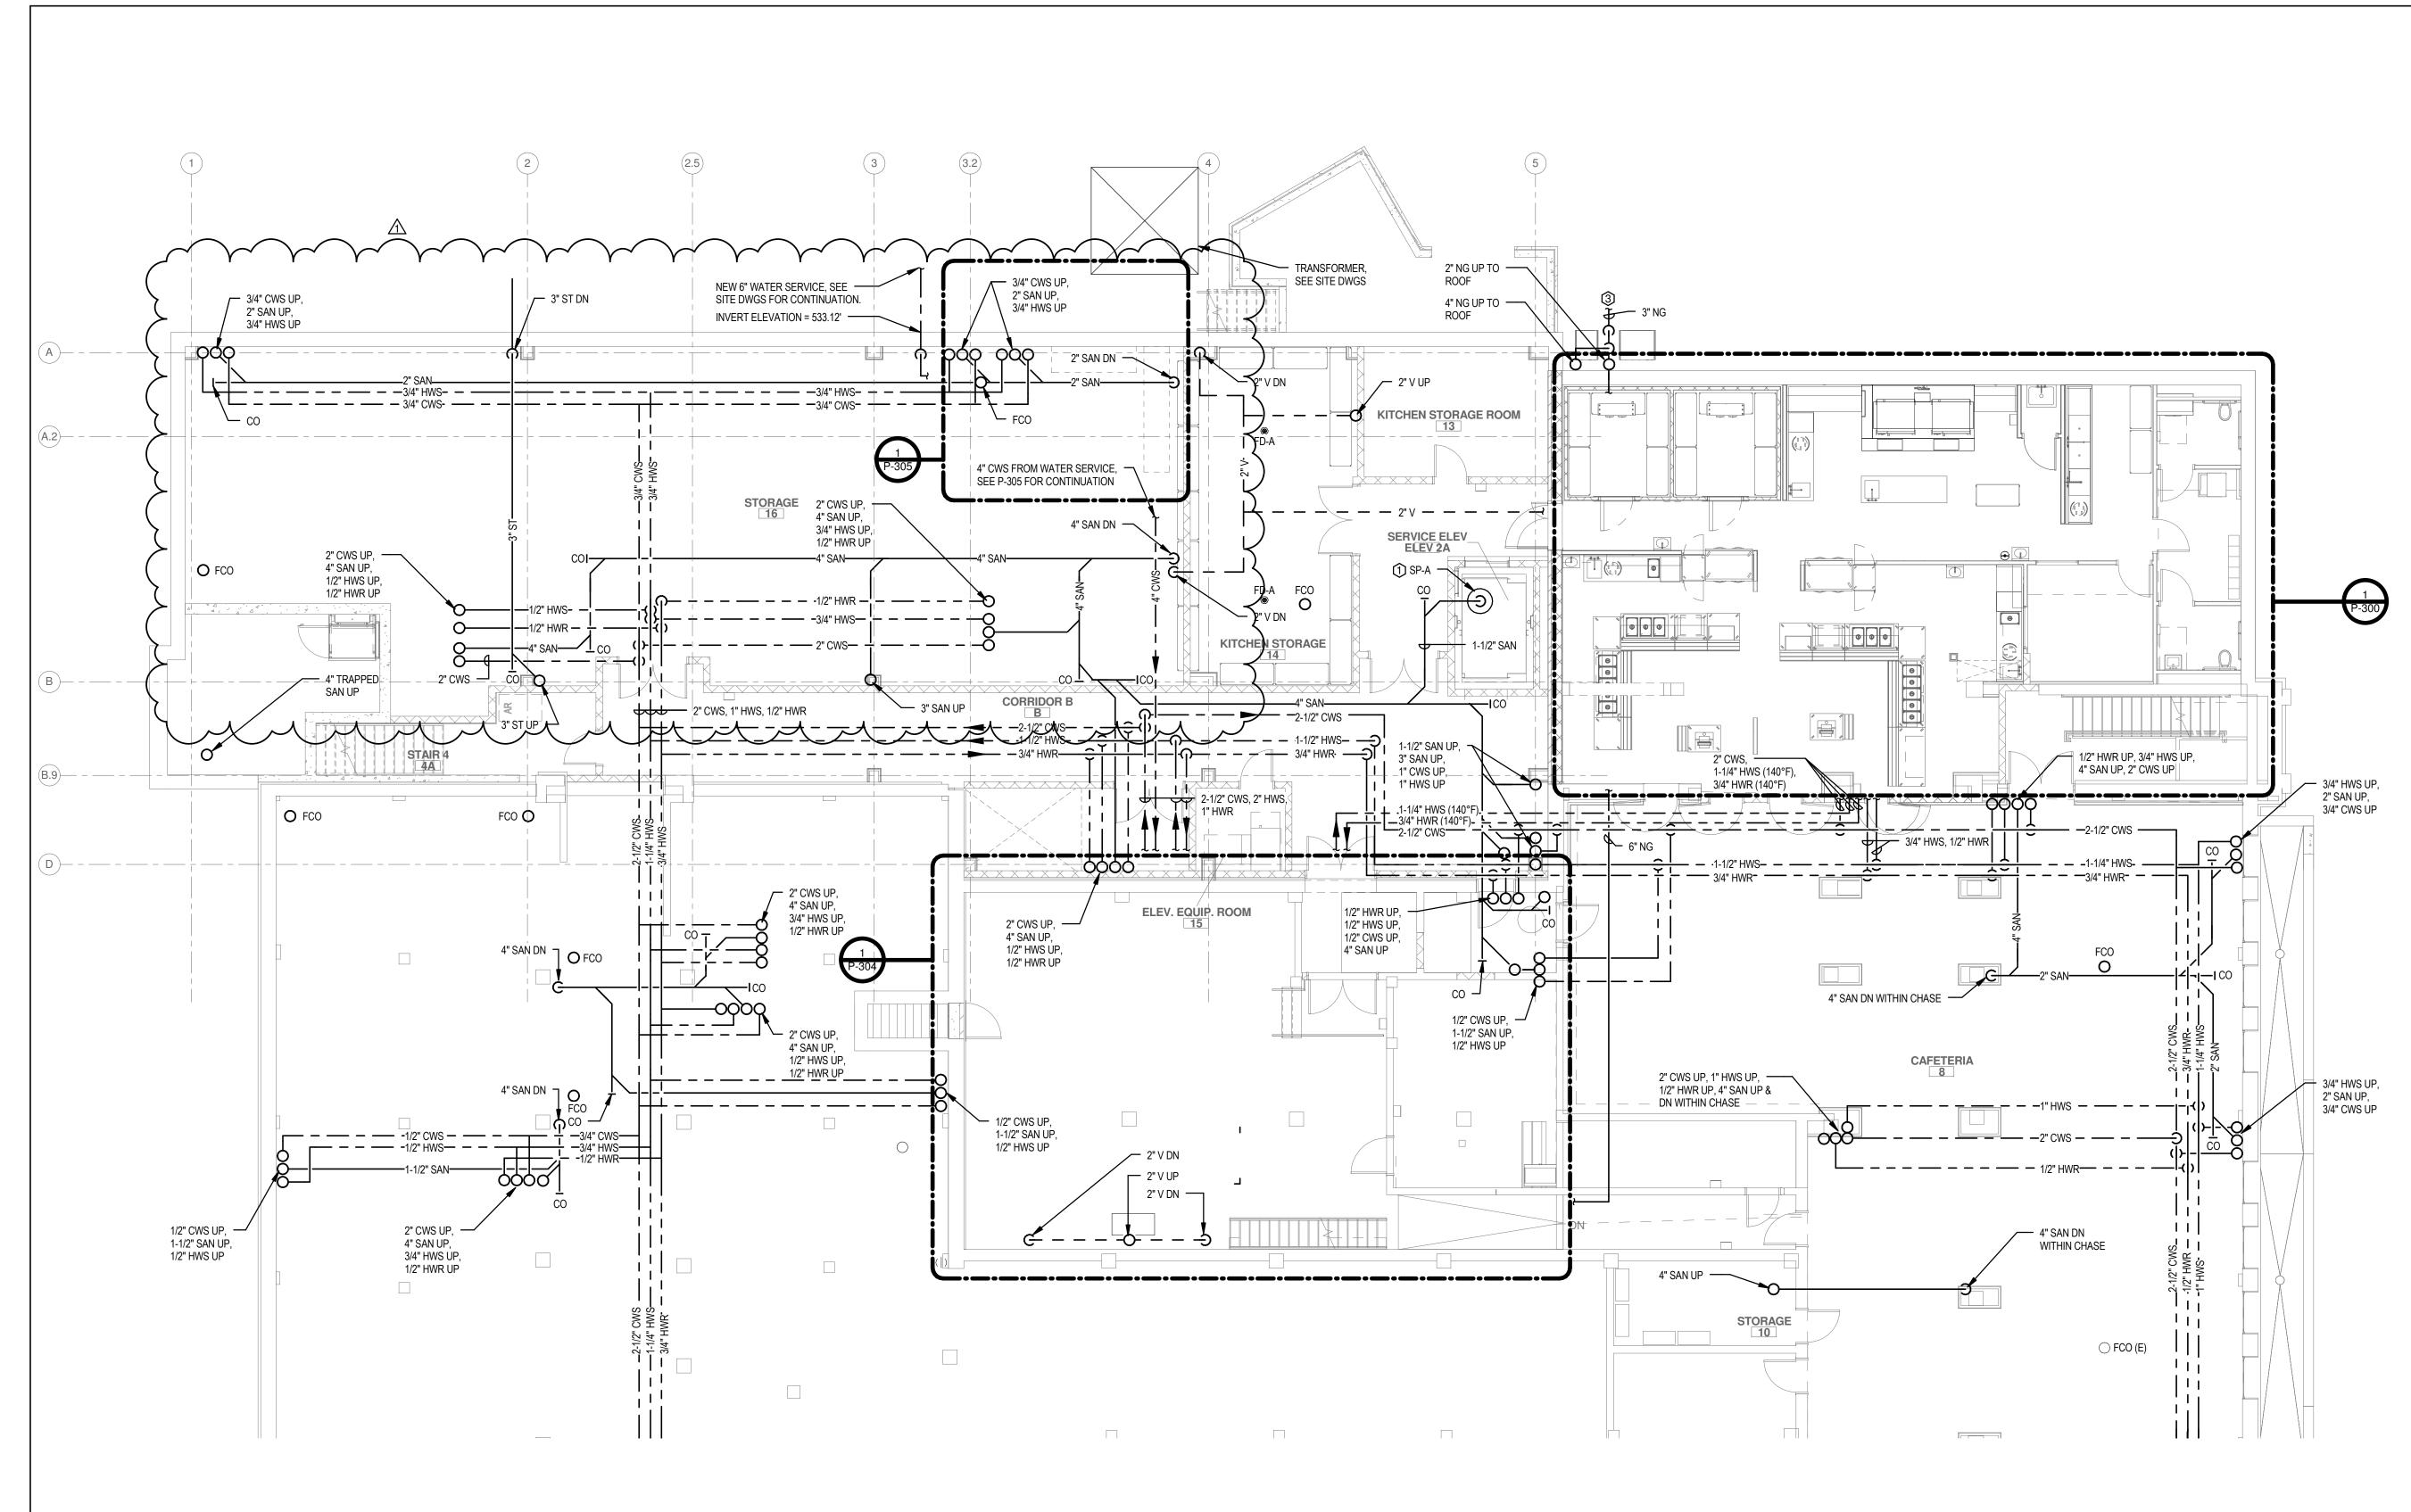

1 PLUMBING BASEMENT NORTH PLAN 1/8" = 1'-0"

### **GENERAL NOTES:**

1. ALL CUTTING AND PATCHING ASSOCIATED WITH THE PLUMBING SCOPE OF WORK SHALL BE COMPLETED BY THE PLUMBING CONTRACTOR.

#### **DRAWING NOTES:**


- ① PROVIDE SUMP PUMP / OIL GUARD IN SUMP PIT. SEE DETAIL ON P-402.
- ② NOT USED.
- ③ PROVIDE GAS SERVICE, SEE DETAIL 5 / P-402.









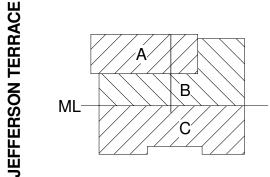

KEY PLAN



SED # 26-16-00-01-0-004-024 DWT SED # 26-16-00-01-7-999-020

Rochester Schools Modernization Program
- Phase 2c

George M. Forbes - Renovation, Alterations and Addition

198 Dr Samuel McCree Way, Rochester NY, 14611

REV.#	DESCRIPTION	DATE
1	Revision 1	Date

## GEORGE MATHER FORBES SCHOOL NO.4


JOB NO.	1711
SCALE	1/8" = 1'-0"
ISSUE DATE	4/25/18
DRAWN BY	BCW
CHECKED BY	Checker
THIS IS A SINGLE SHEET OF A COHESIVE	

THIS IS A SINGLE SHEET OF A COHESIVE
SET OF CONSTRUCTION DOCUMENTS
(INCLUDING DRAWINGS AND SPECIFICATIONS).
INTERPRETATION OF THE INFORMATION
AS PRESENTED SHOULD BE BASED ON
THE ENTIRE SET OF DOCUMENTS.

DRAWING TITLE

BASEMENT
PLUMBING PARTIAL
FLOOR PLAN

P-101.1

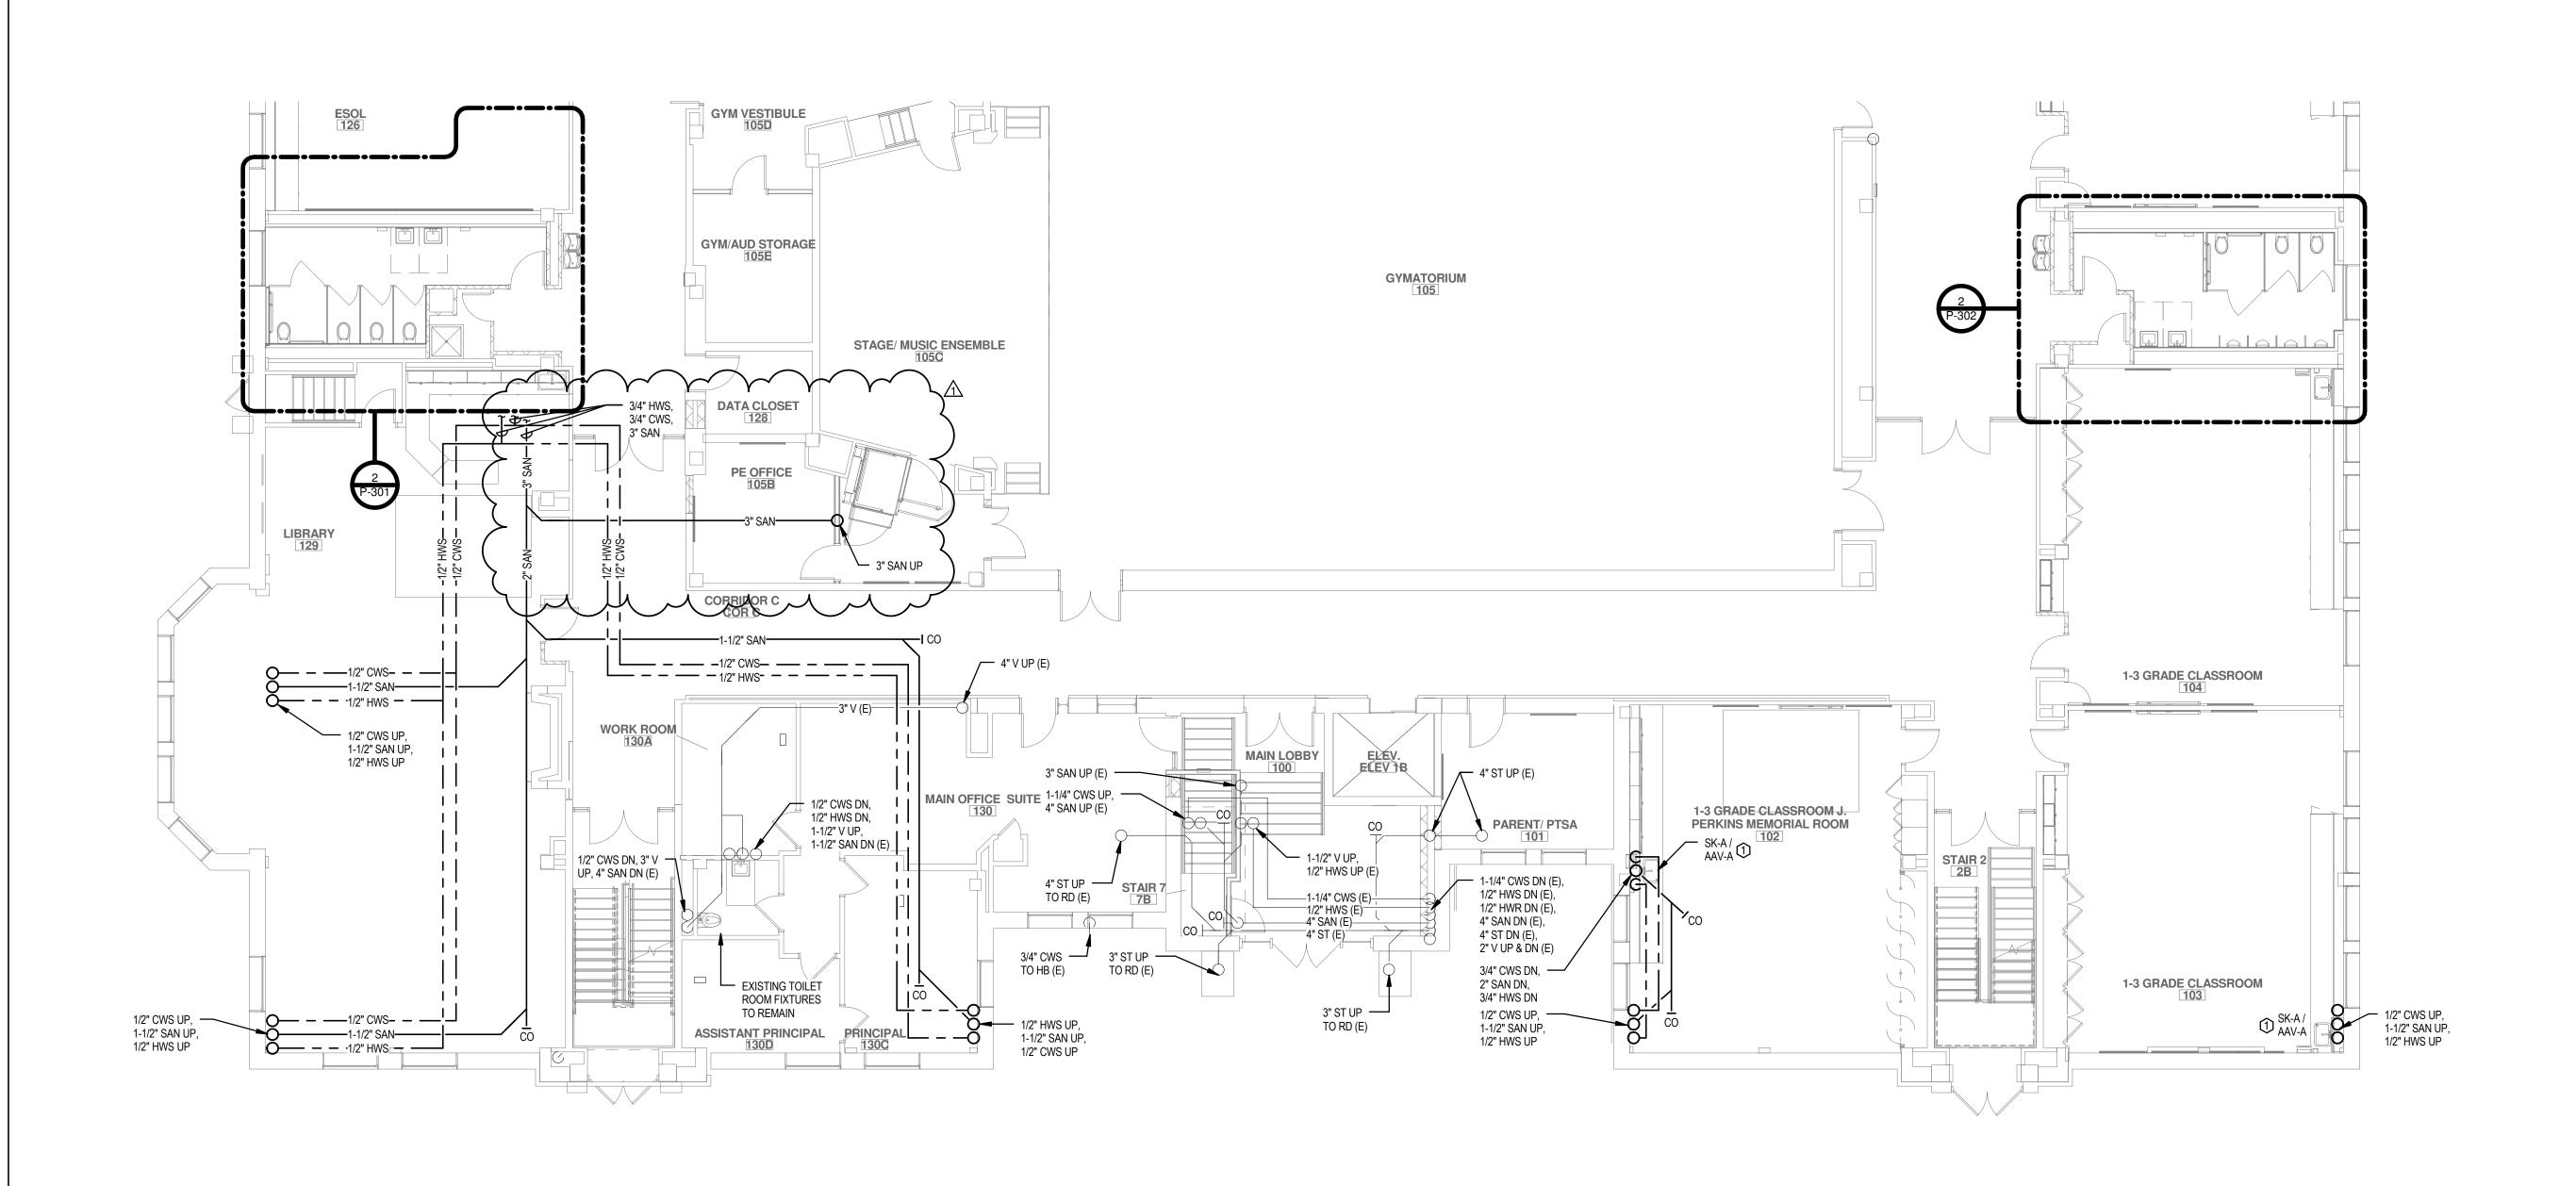

1 PLUMBING FIRST FLOOR SOUTH PLAN 1/8" = 1'-0"

### **GENERAL NOTES:**

1. ALL CUTTING AND PATCHING ASSOCIATED WITH THE PLUMBING SCOPE OF WORK SHALL BE COMPLETED BY THE PLUMBING CONTRACTOR.

#### **DRAWING NOTES:**


① PROVIDE SINK (SK-A) AND AIR ADMITTANCE VALVE (AAV-A). PROVIDE 1/2" CWS / 1/2" HWS / 1-1/2" SAN CONNECTIONS.









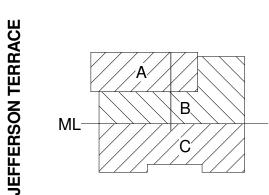

KEY PLAN



SED # 26-16-00-01-0-004-024 DWT SED # 26-16-00-01-7-999-020

Rochester Schools Modernization Program
- Phase 2c

George M. Forbes - Renovation, Alterations and Addition

198 Dr Samuel McCree Way, Rochester NY, 14611

REV.#	DESCRIPTION	DATE
1	Revision 1	Date 1
		•

### GEORGE MATHER FORBES SCHOOL NO.4


JC	OB NO.	171
SC	CALE	1/8" = 1'-0
IS	SUE DATE	4/25/1
DF	RAWN BY	BCV
Cł	HECKED BY	Checke
	THIS IS A SINGLE SHEET OF A COHESIVE	

THIS IS A SINGLE SHEET OF A COHESIVE SET OF CONSTRUCTION DOCUMENTS (INCLUDING DRAWINGS AND SPECIFICATIONS). INTERPRETATION OF THE INFORMATION AS PRESENTED SHOULD BE BASED ON THE ENTIRE SET OF DOCUMENTS.

\_\_\_\_

FIRST FLOOR
PLUMBING PARTIAL
FLOOR PLAN

P-102.2

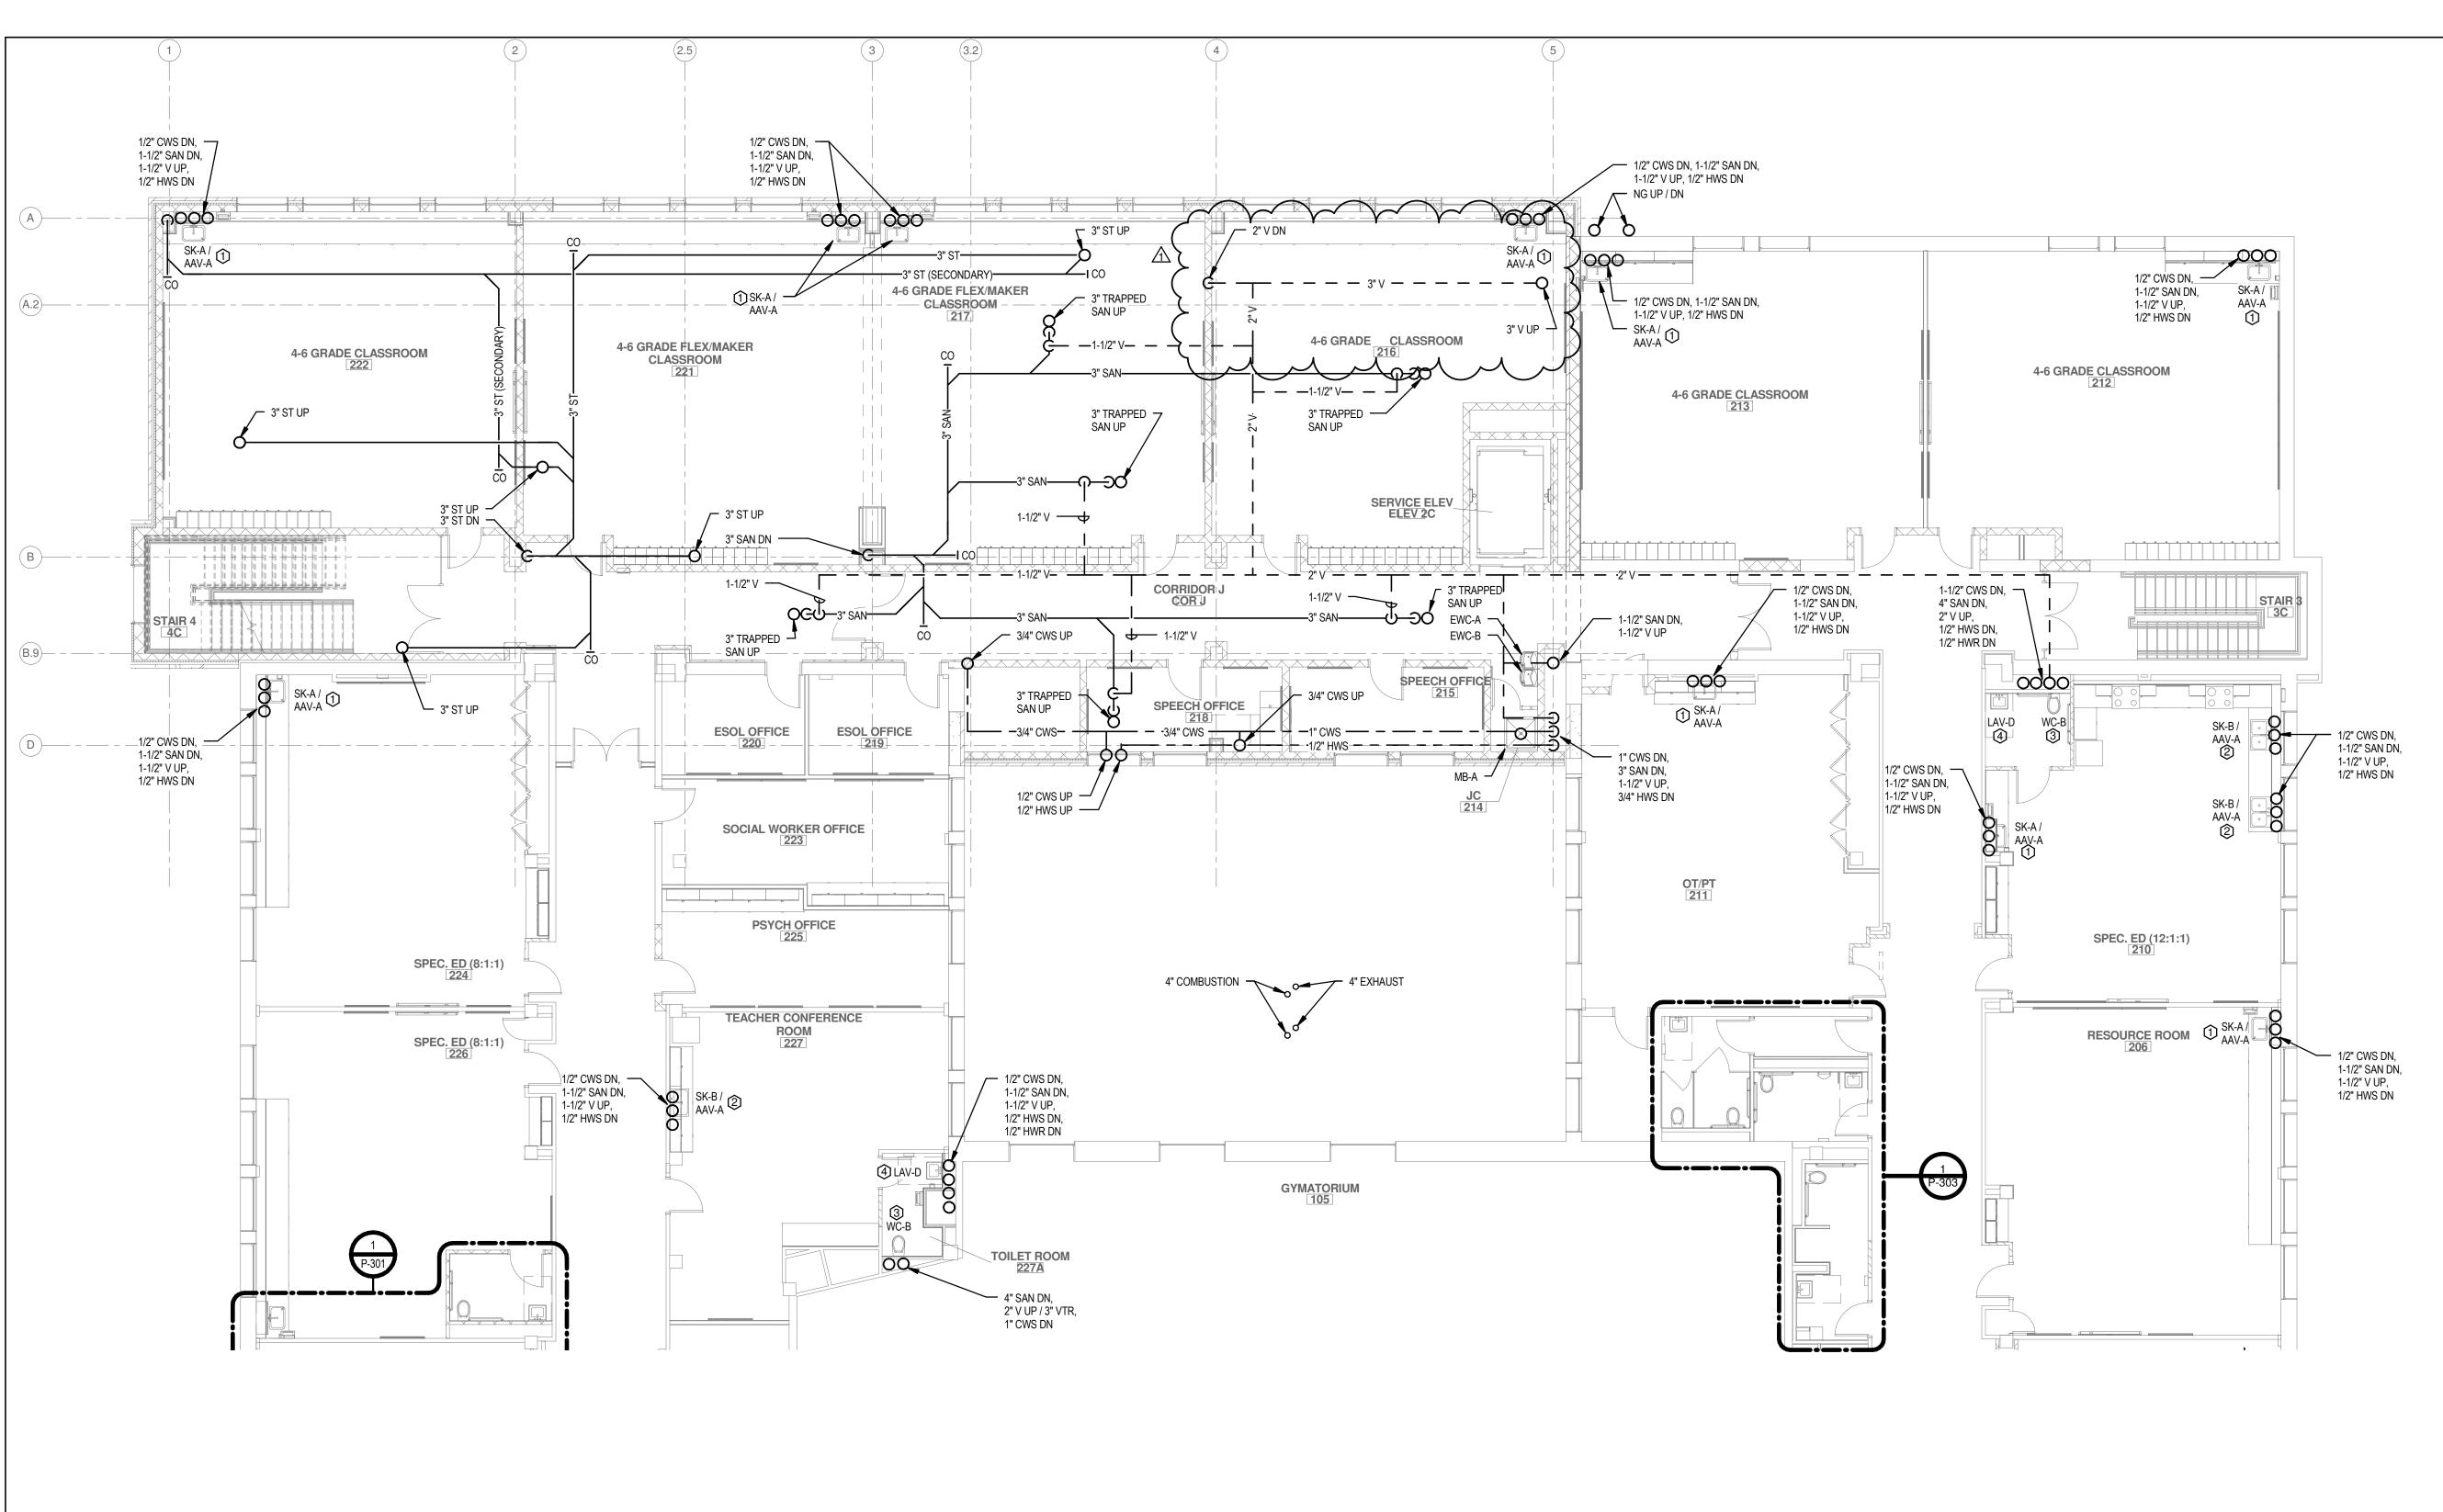

1 PLUMBING SECOND FLOOR NORTH PLAN 1/8" = 1'-0"

### **GENERAL NOTES:**

1. ALL CUTTING AND PATCHING ASSOCIATED WITH THE PLUMBING SCOPE OF WORK SHALL BE COMPLETED BY THE PLUMBING CONTRACTOR.

### DRAWING NOTES:


- ① PROVIDE SINK (SK-A) AND AIR ADMITTANCE VALVE (AAV-A). PROVIDE 1/2" CWS / 1/2" HWS / 1-1/2" SAN CONNECTIONS.
- ② PROVIDE SINK (SK-B) AND AIR ADMITTANCE VALVE (AAV-A). PROVIDE 1/2" CWS / 1/2" HWS / 1-1/2" SAN CONNECTIONS.
- ③ PROVIDE WATER CLOSET (WC-B). PROVIDE 1" CWS / 4" SAN / 2" V CONNECTIONS. SEE RISER DIAGRAMS FOR PIPING WITHIN CHASE.
- PROVIDE LAVATORY (LAV-D). PROVIDE 1/2" CWS / 1/2" HWS / 1-1/2" SAN / 1-1/2" V CONNECTIONS. SEE RISER DIAGRAMS FOR PIPING WITHIN CHASE.









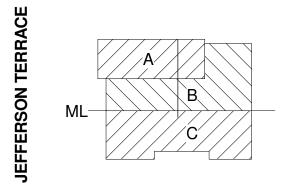

KEY PLAN



SED # 26-16-00-01-0-004-024 DWT SED # 26-16-00-01-7-999-020

Rochester Schools Modernization Program
- Phase 2c

George M. Forbes - Renovation, Alterations and Addition

198 Dr Samuel McCree Way, Rochester NY, 14611

REV.#	DESCRIPTION	DATE
1	Revision 1	Date 1
		•

#### GEORGE MATHER FORBES SCHOOL NO.4


JOB NO.	171
SCALE	1/8" = 1'-0
ISSUE DATE	4/25/1
DRAWN BY	BCV
CHECKED BY	Checke
THIS IS A SINGLE SHEET OF A COHESIVE	

THIS IS A SINGLE SHEET OF A COHESIVE
SET OF CONSTRUCTION DOCUMENTS
(INCLUDING DRAWINGS AND SPECIFICATIONS).
INTERPRETATION OF THE INFORMATION
AS PRESENTED SHOULD BE BASED ON
THE ENTIRE SET OF DOCUMENTS.

DRAWING TITLE

SECOND FLOOR PLUMBING PARTIAL FLOOR PLAN

P-103.1

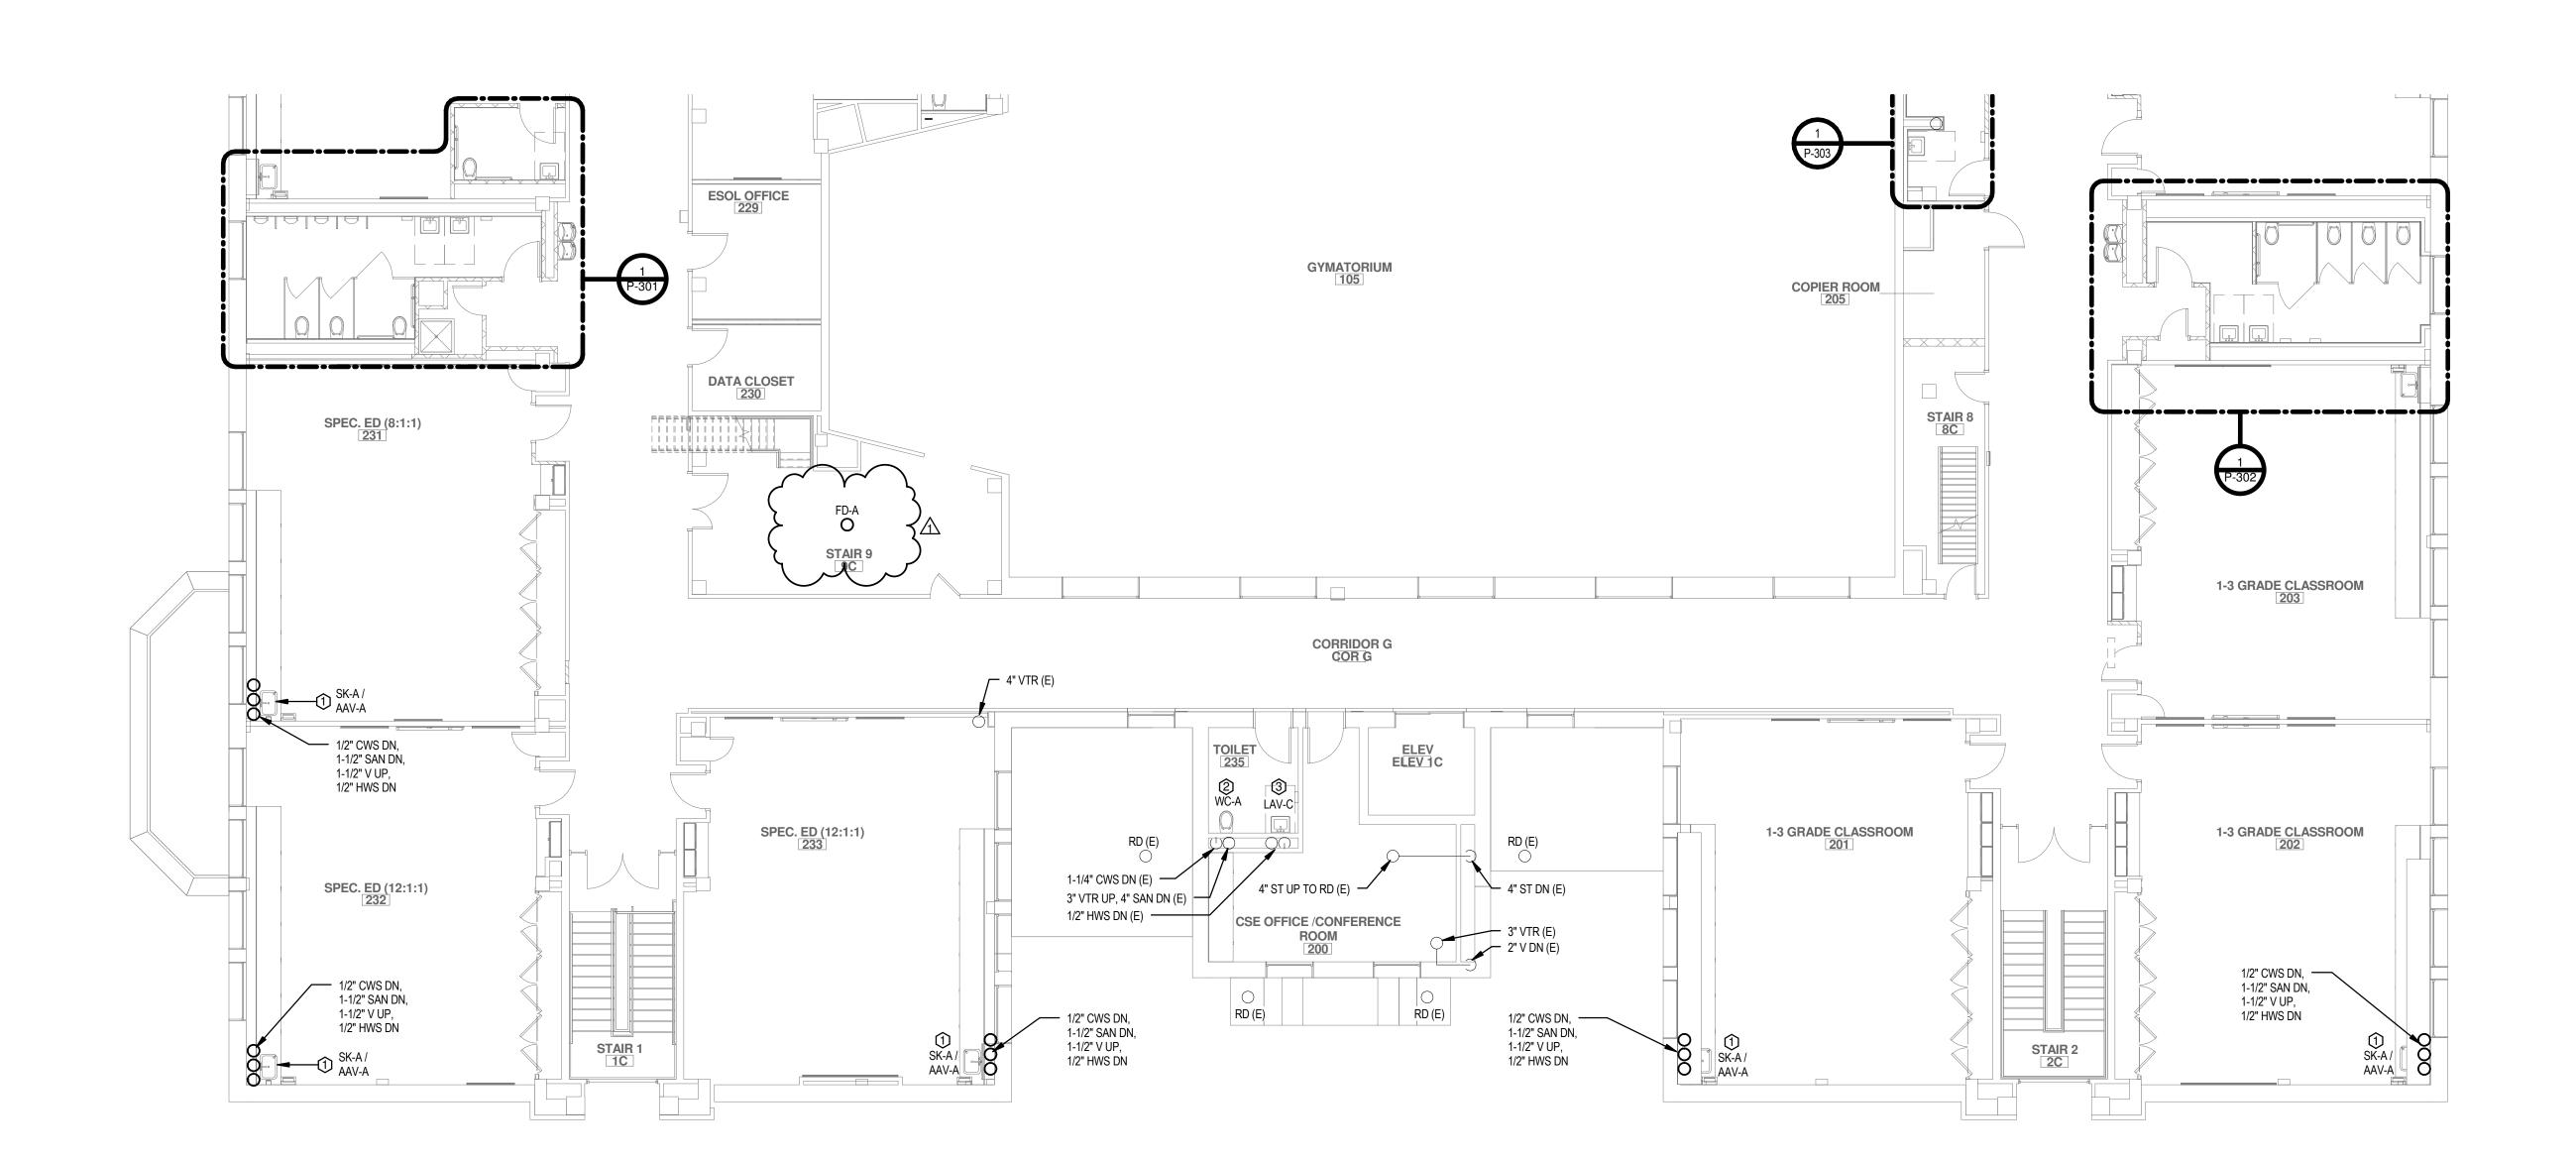

1 PLUMBING SECOND FLOOR SOUTH PLAN 1/8" = 1'-0"

### **GENERAL NOTES:**

1. ALL CUTTING AND PATCHING ASSOCIATED WITH THE PLUMBING SCOPE OF WORK SHALL BE COMPLETED BY THE PLUMBING CONTRACTOR.

#### **DRAWING NOTES:**


- ① PROVIDE SINK (SK-A) AND AIR ADMITTANCE VALVE (AAV-A). PROVIDE 1/2" CWS / 1/2" HWS / 1-1/2" SAN CONNECTIONS.
- PROVIDE WATER CLOSET (WC-A). PROVIDE 1" CWS / 4" SAN / 2" V CONNECTIONS TO EXISTING PIPE WITHIN CHASE.
- ③ PROVIDE LAVATORY (LAV-C). PROVIDE 1/2" CWS / 1/2" HWS / 1-1/2" SAN / 1-1/2" V CONNECTIONS TO EXISTING PIPE WITHIN CHASE.









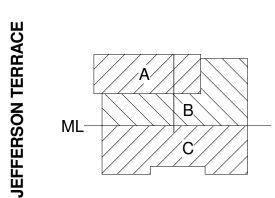

KEY PLAN



SED # 26-16-00-01-0-004-024 DWT SED # 26-16-00-01-7-999-020

Rochester Schools Modernization Program
- Phase 2c

George M. Forbes - Renovation, Alterations and Addition

198 Dr Samuel McCree Way, Rochester NY, 14611

REV.#	DESCRIPTION	DATE
1	Revision 1	Date 1

### GEORGE MATHER FORBES SCHOOL NO.4


JOB NO.	171
SCALE	1/8" = 1'-0
ISSUE DATE	4/25/1
DRAWN BY	BCV
CHECKED BY	Checke
THIS IS A SINGLE SHEET OF A COHESIVE	

THIS IS A SINGLE SHEET OF A COHESIVE SET OF CONSTRUCTION DOCUMENTS (INCLUDING DRAWINGS AND SPECIFICATIONS). INTERPRETATION OF THE INFORMATION AS PRESENTED SHOULD BE BASED ON THE ENTIRE SET OF DOCUMENTS.

DRAWING TITLE

SECOND FLOOR PLUMBING PARTIAL FLOOR PLAN

P-103.2

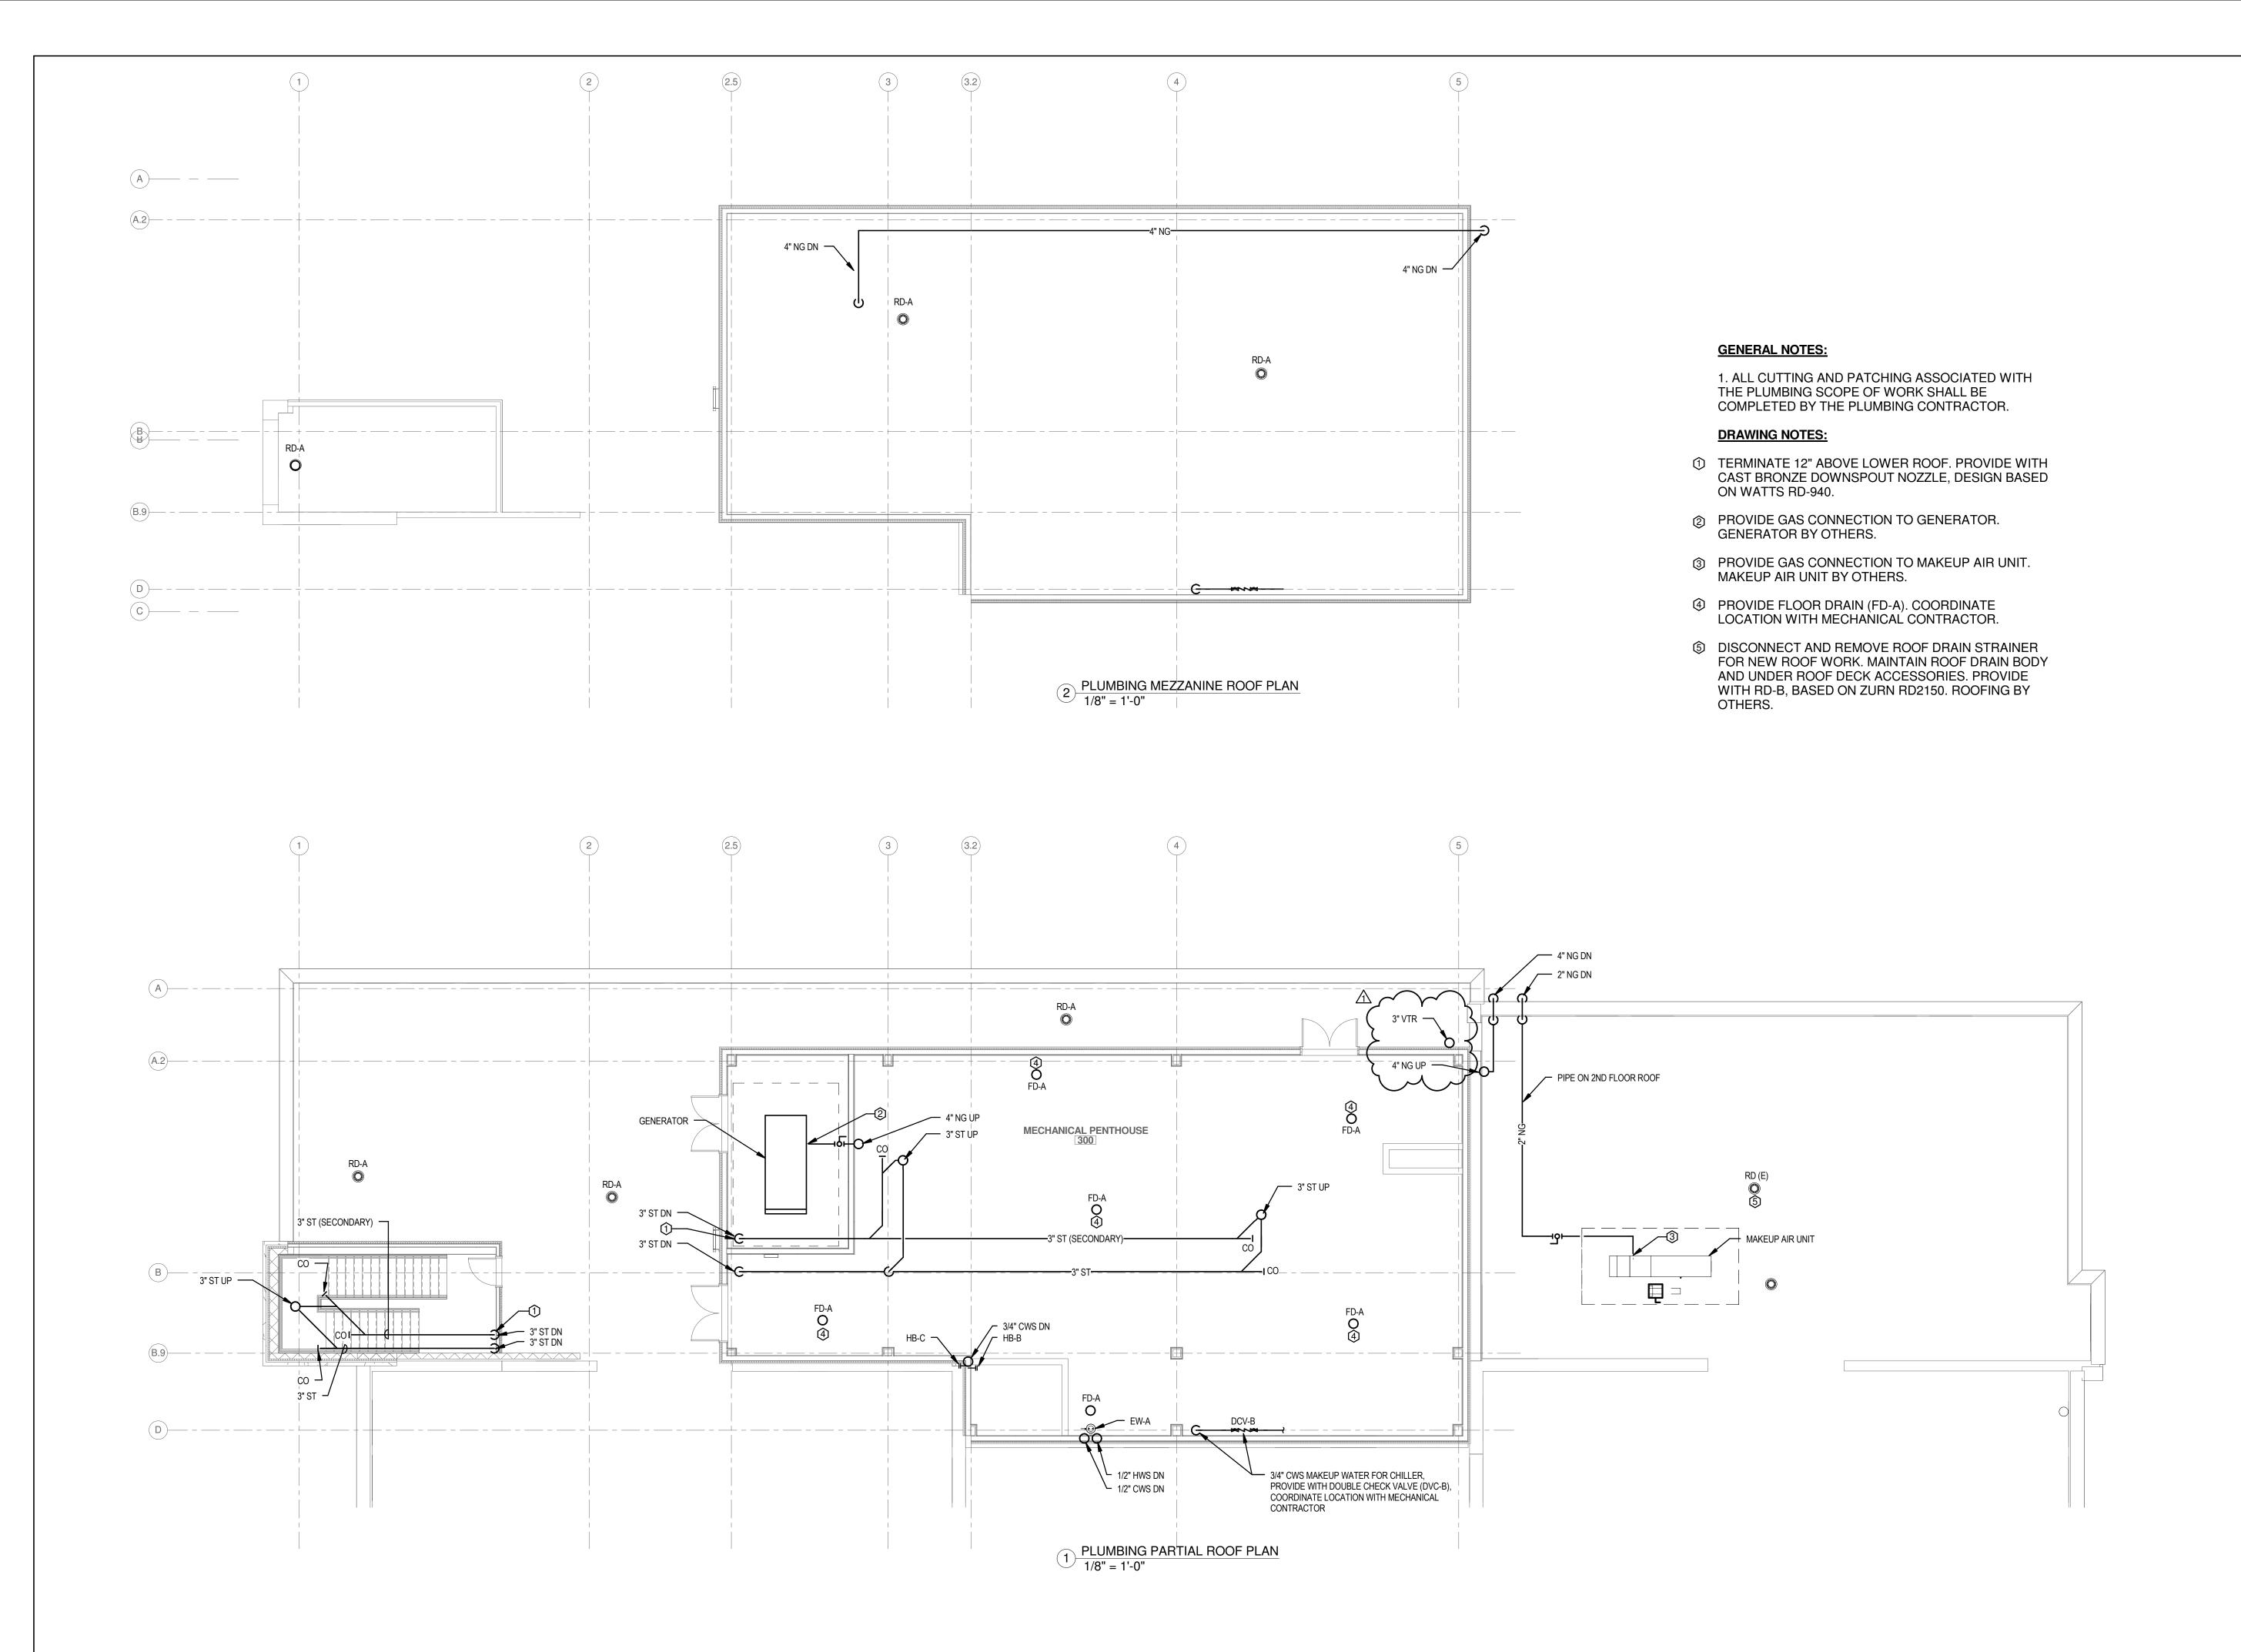



BUFFALO | ROCHESTER www.cjsarchitects.com







ML B



KEY PLAN

SED # 26-16-00-01-0-004-024 DWT SED # 26-16-00-01-7-999-020

Rochester Schools Modernization Program
- Phase 2c

George M. Forbes - Renovation, Alterations and Addition

198 Dr Samuel McCree Way, Rochester NY, 14611

REV.#	DESCRIPTION	DATE
1	Revision 1	Date 1

### GEORGE MATHER FORBES SCHOOL NO.4


JOB NO.	171
SCALE	1/8" = 1'-0
ISSUE DATE	4/25/1
DRAWN BY	BCV
CHECKED BY	Checke
THIS IS A SINGLE SHEET OF A COHESIVE	

THIS IS A SINGLE SHEET OF A COHESIVE SET OF CONSTRUCTION DOCUMENTS (INCLUDING DRAWINGS AND SPECIFICATIONS). INTERPRETATION OF THE INFORMATION AS PRESENTED SHOULD BE BASED ON THE ENTIRE SET OF DOCUMENTS.

DRAWING TITLE

ROOF PLUMBING PARTIAL PLAN

P-104

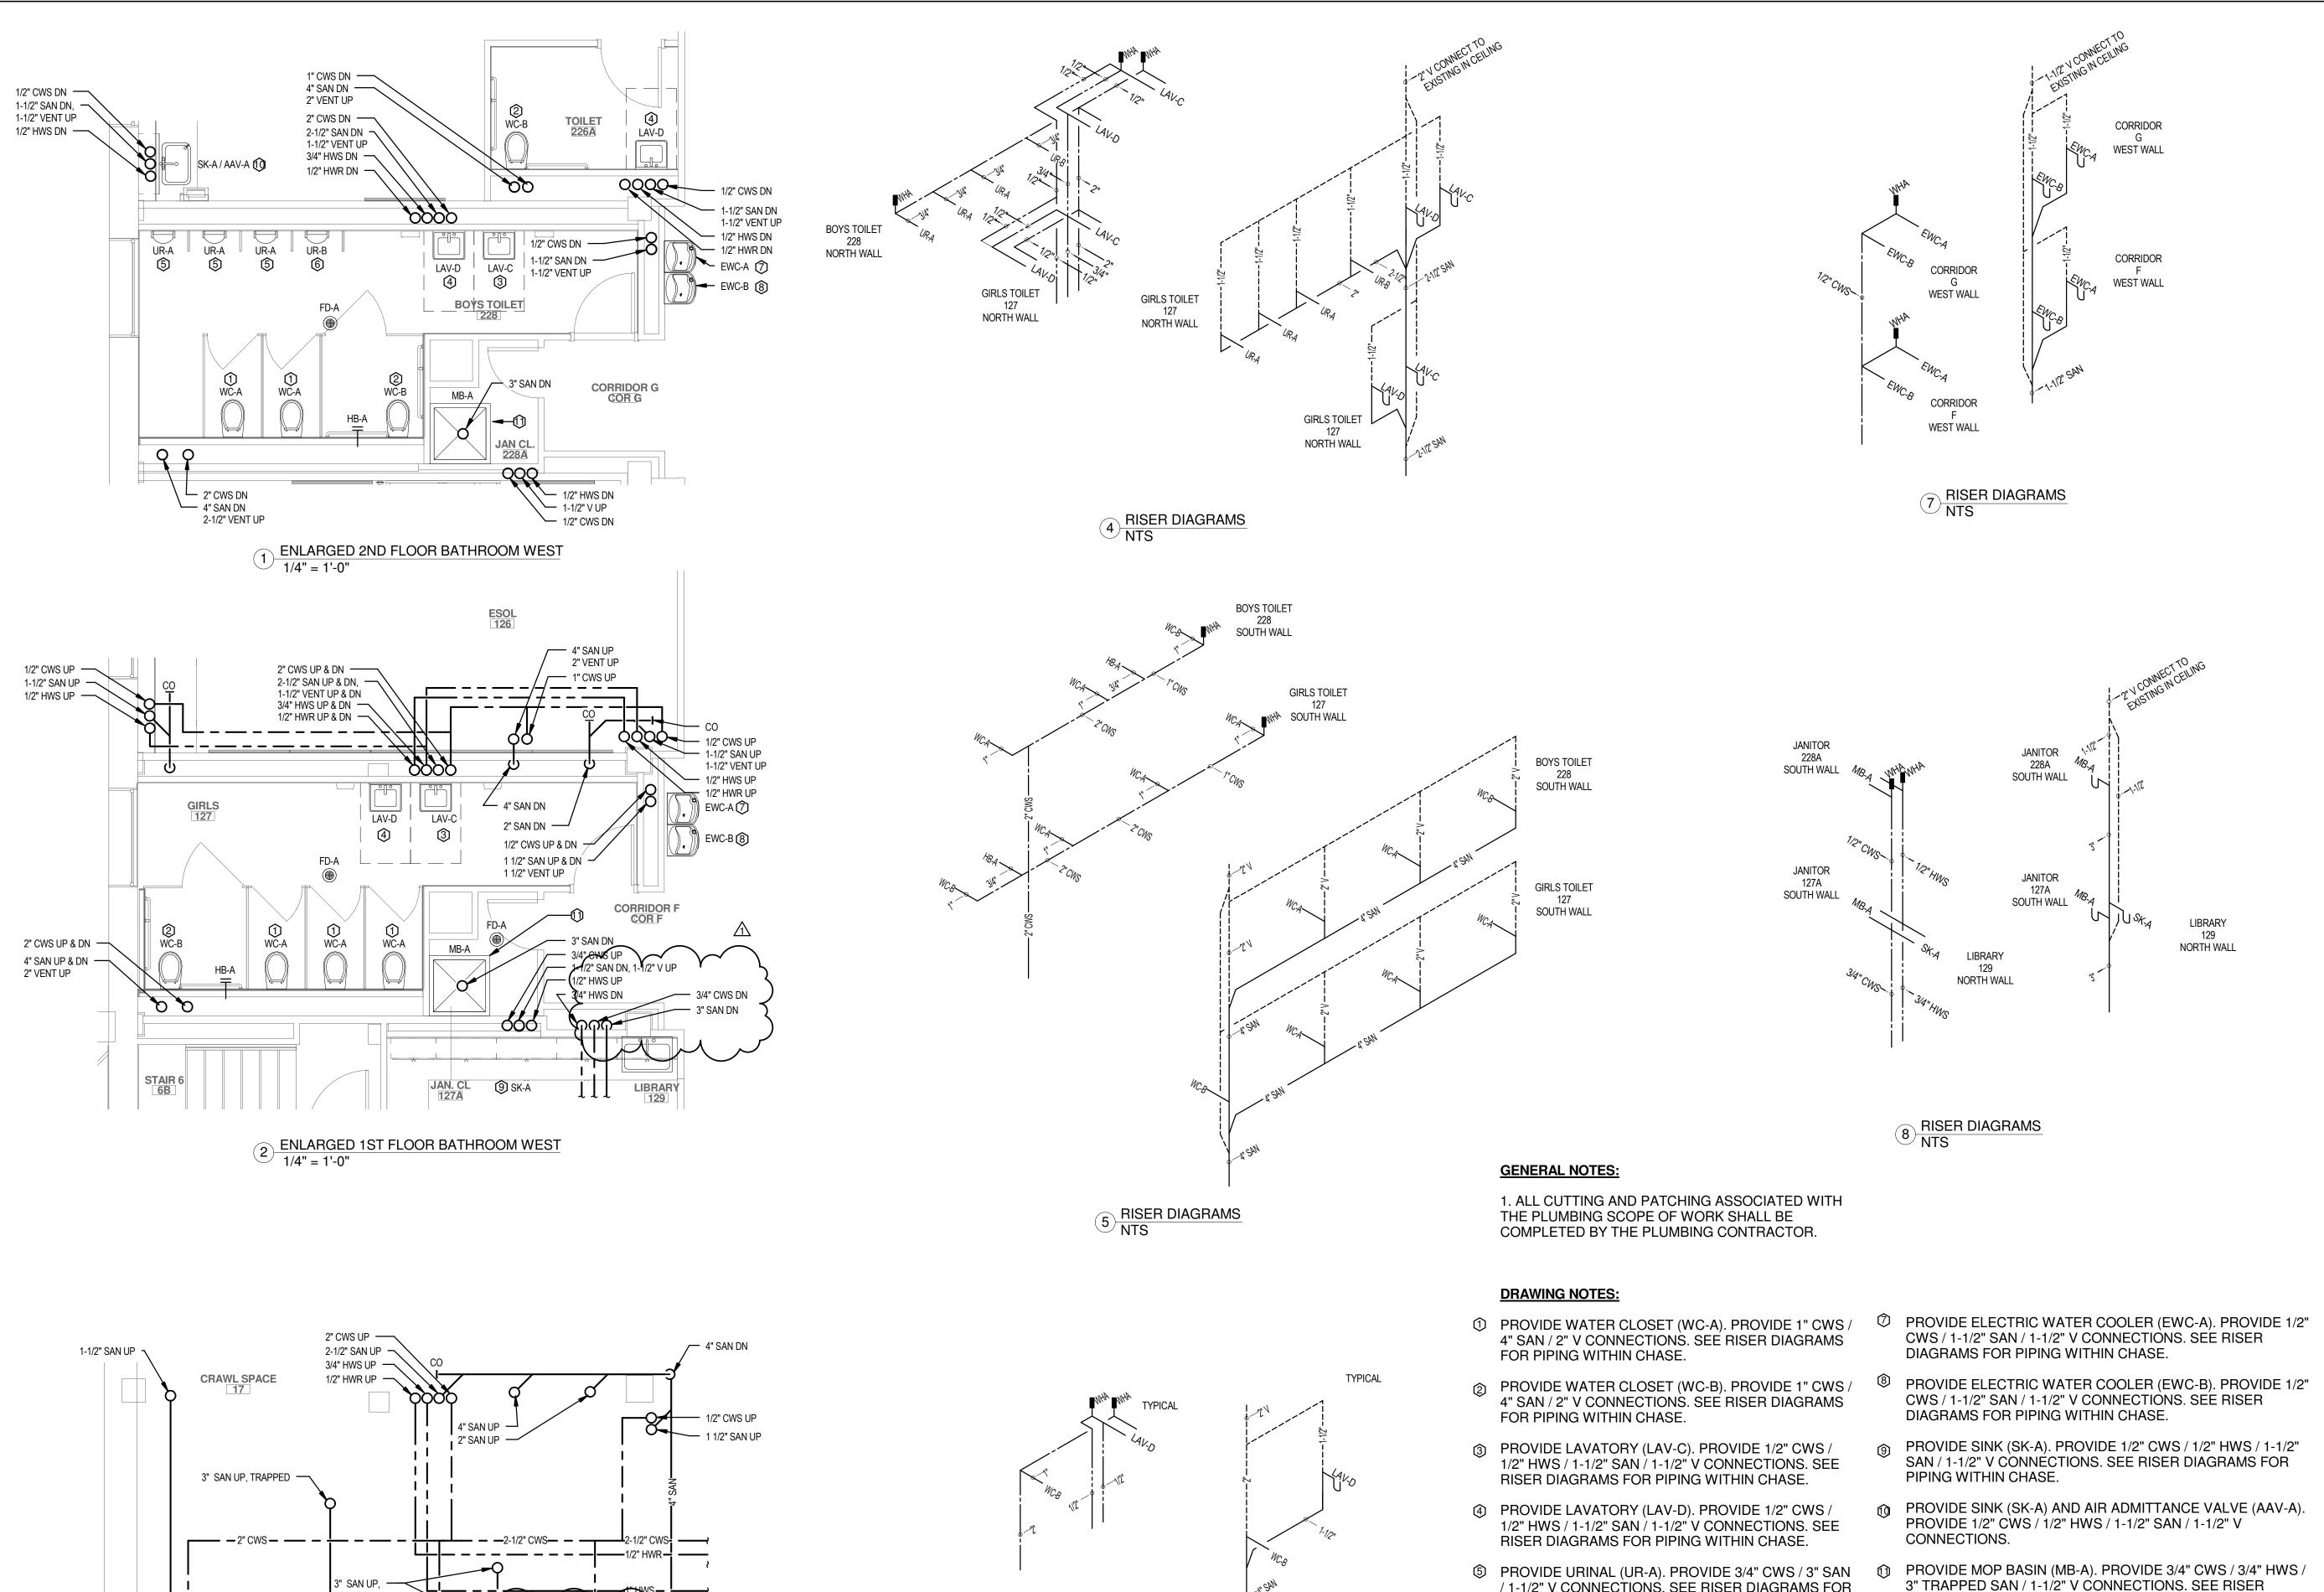

6 RISER DIAGRAMS NTS

- 2" CWS UP ➤ 4" SAN UP

3/4" CWS UP —

1-1/2" SAN UP -

3/4" HWS UP —

3 ENLARGED UNDER 1ST FLOOR BATHROOM WEST 1/4" = 1'-0"

3/4" HWS UP -

3/4" CWS UP --

3" SAN UP ——

/ 1-1/2" V CONNECTIONS. SEE RISER DIAGRAMS FOR

© PROVIDE URINAL (UR-B). PROVIDE 3/4" CWS / 3" SAN / 1-1/2" V CONNECTIONS. SEE RISER DIAGRAMS FOR

PIPING WITHIN CHASE.

PIPING WITHIN CHASE.

DIAGRAMS FOR PIPING WITHIN CHASE.




BUFFALO | ROCHESTER www.cjsarchitects.com





main: 585.388.2060 • fax: 585.388.2070



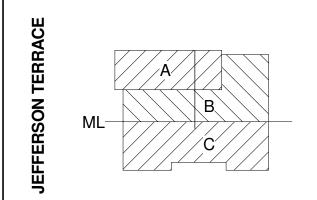

DR. SAMUEL MCCREE WAY KEY PLAN

> SED # 26-16-00-01-0-004-024 DWT SED # 26-16-00-01-7-999-020

Rochester Schools Modernization Program - Phase 2c

George M. Forbes - Renovation, Alterations and Addition

> 198 Dr Samuel McCree Way, Rochester NY, 14611

	REV.#	DESCRIPTION	DATE
	1	Revision 1	Date 1


GEORGE MATHER FORBES SCHOOL NO.4

JOB NO.	171
SCALE	1/4" = 1'-0
ISSUE DATE	4/25/1
DRAWN BY	BCV
CHECKED BY	Checke
THIS IS A SINGLE SHEET OF A COHESIVE	

SET OF CONSTRUCTION DOCUMENTS
(INCLUDING DRAWINGS AND SPECIFICATIONS).
INTERPRETATION OF THE INFORMATION
AS PRESENTED SHOULD BE BASED ON
THE ENTIRE SET OF DOCUMENTS.

DRAWING TITLE **ENLARGED** BATHROOM PLAN -WEST

P-301

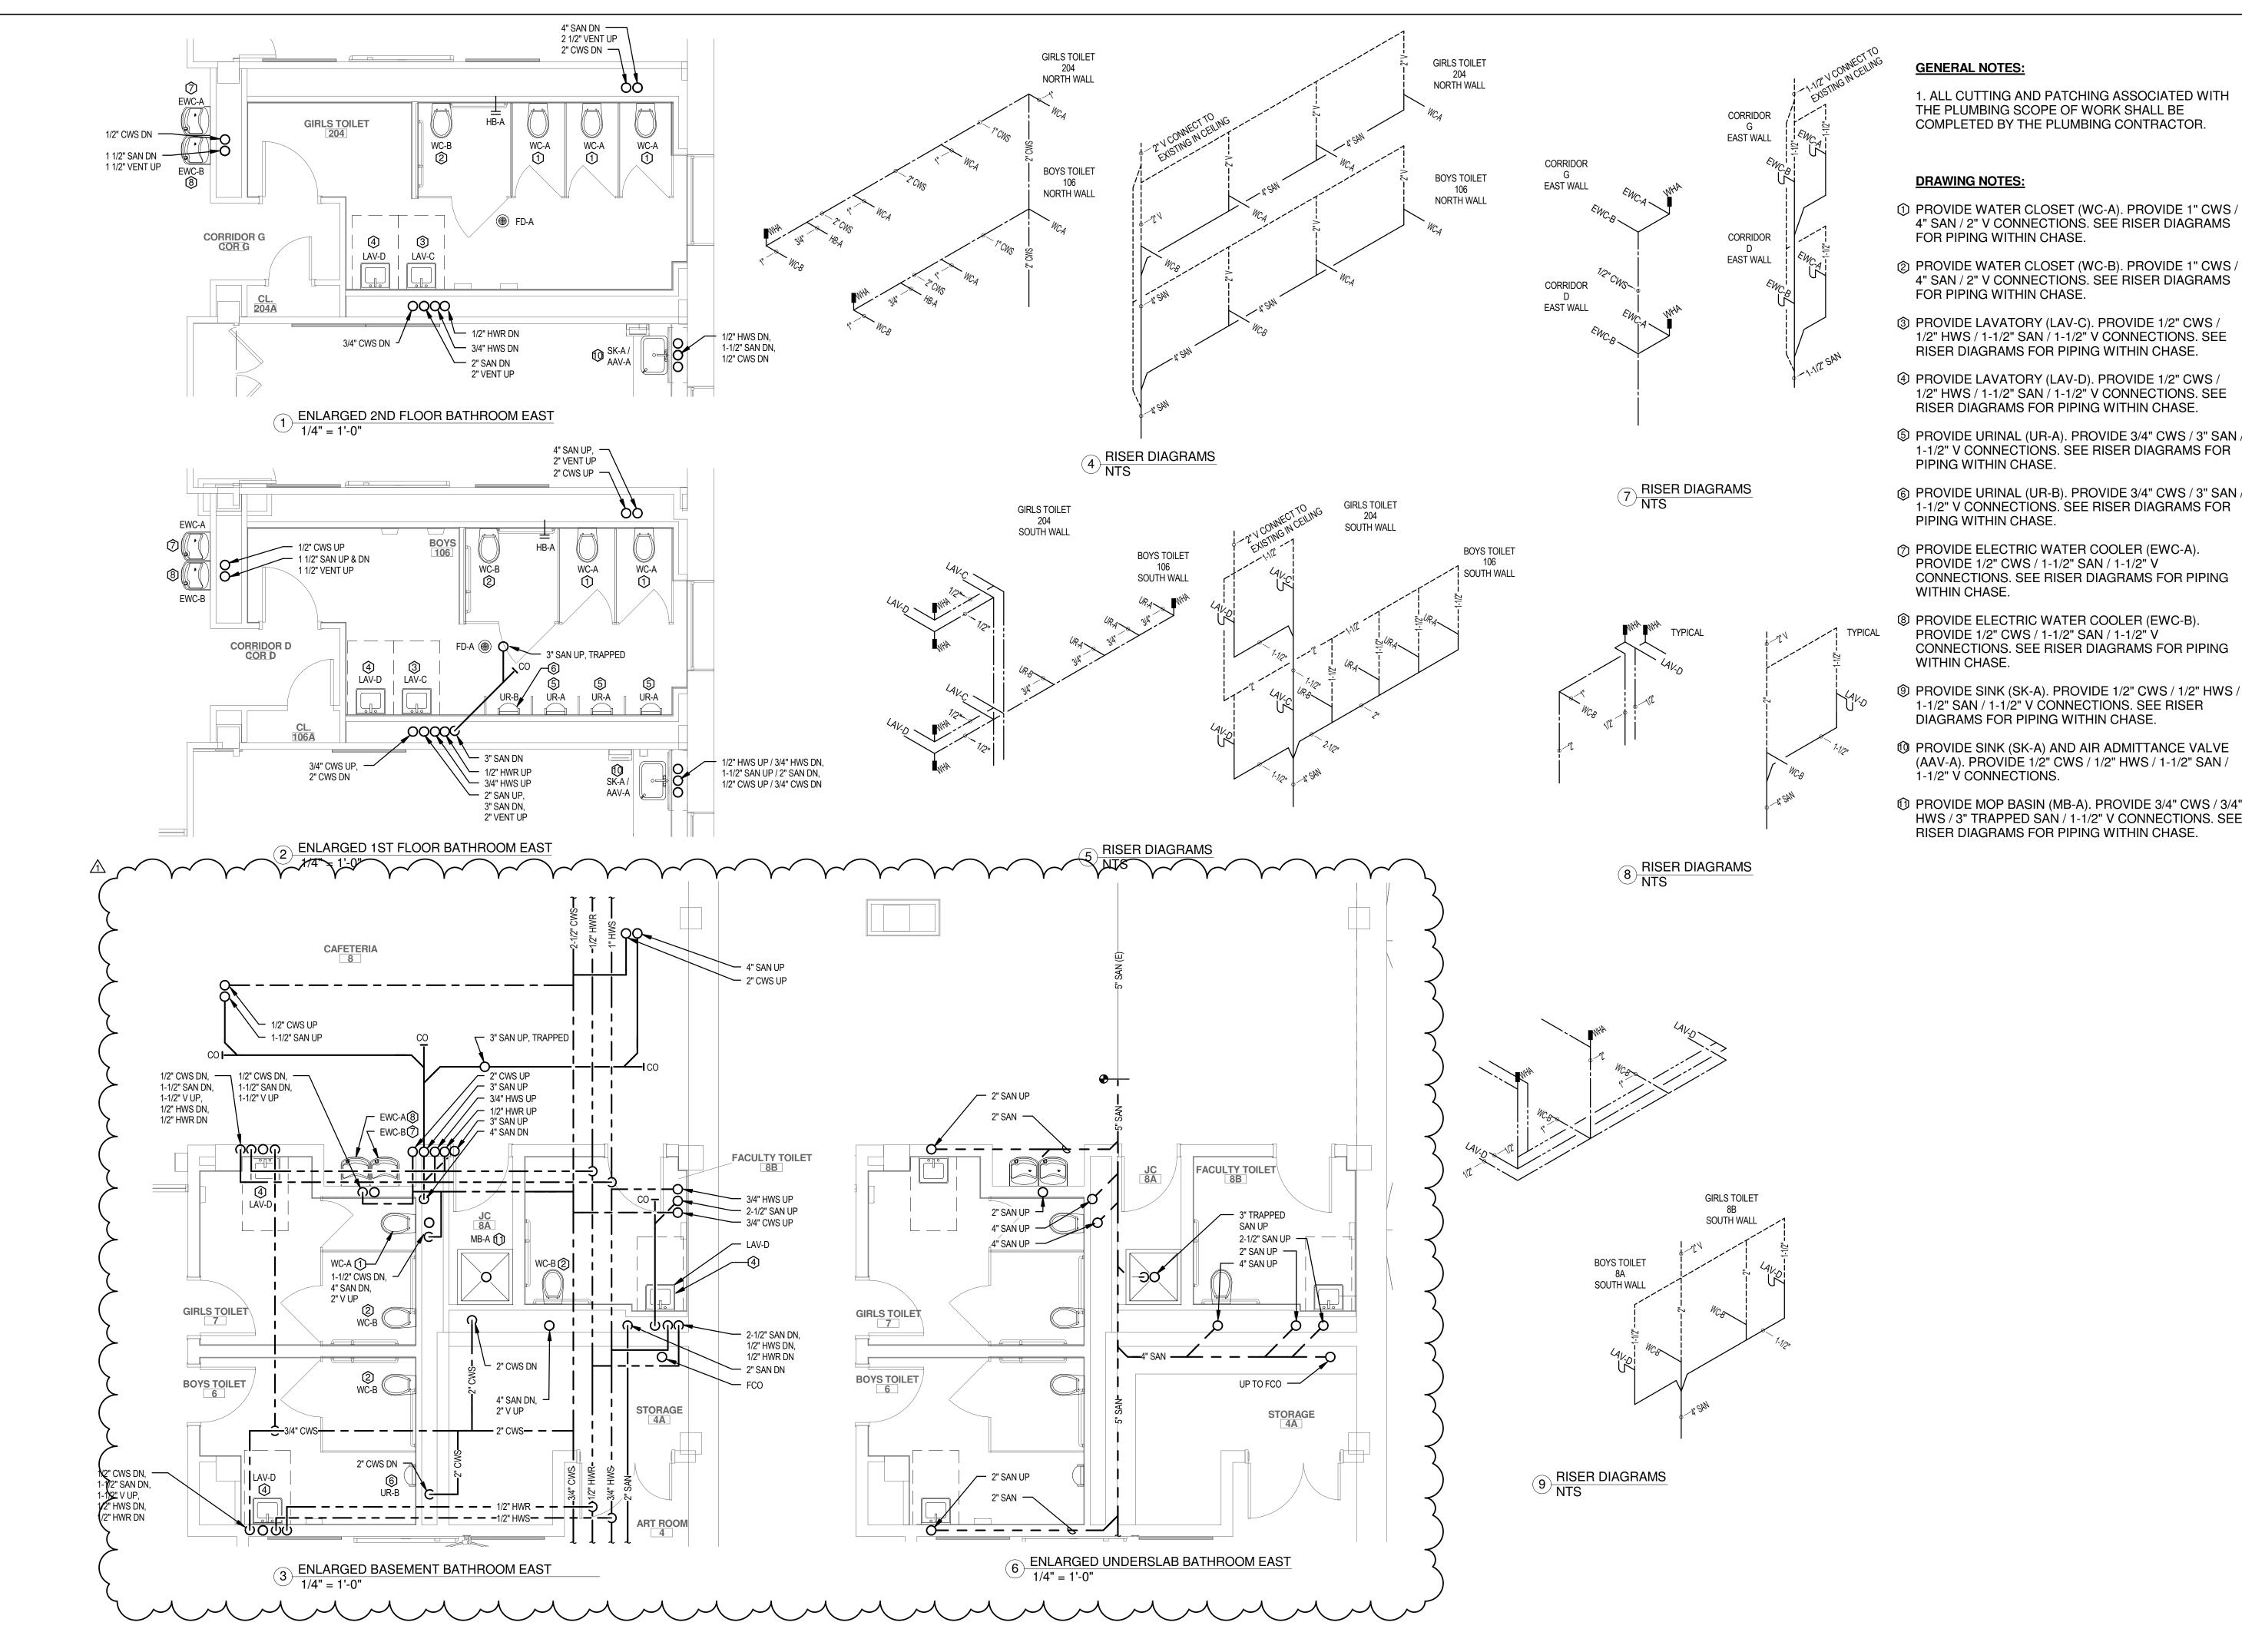

1. ALL CUTTING AND PATCHING ASSOCIATED WITH THE PLUMBING SCOPE OF WORK SHALL BE

- ① PROVIDE WATER CLOSET (WC-A). PROVIDE 1" CWS / 4" SAN / 2" V CONNECTIONS. SEE RISER DIAGRAMS
- ② PROVIDE WATER CLOSET (WC-B). PROVIDE 1" CWS / 4" SAN / 2" V CONNECTIONS. SEE RISER DIAGRAMS
- ③ PROVIDE LAVATORY (LAV-C). PROVIDE 1/2" CWS / 1/2" HWS / 1-1/2" SAN / 1-1/2" V CONNECTIONS. SEE RISER DIAGRAMS FOR PIPING WITHIN CHASE.
- ④ PROVIDE LAVATORY (LAV-D). PROVIDE 1/2" CWS / 1/2" HWS / 1-1/2" SAN / 1-1/2" V CONNECTIONS. SEE
- 1-1/2" V CONNECTIONS. SEE RISER DIAGRAMS FOR
- 1-1/2" V CONNECTIONS. SEE RISER DIAGRAMS FOR
- CONNECTIONS. SEE RISER DIAGRAMS FOR PIPING
- CONNECTIONS. SEE RISER DIAGRAMS FOR PIPING
- 1-1/2" SAN / 1-1/2" V CONNECTIONS. SEE RISER
- (AAV-A). PROVIDE 1/2" CWS / 1/2" HWS / 1-1/2" SAN /
- HWS / 3" TRAPPED SAN / 1-1/2" V CONNECTIONS. SEE RISER DIAGRAMS FOR PIPING WITHIN CHASE.




BUFFALO | ROCHESTER www.cjsarchitects.com







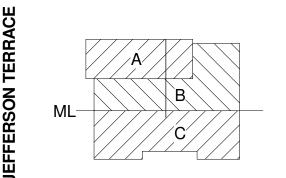

DR. SAMUEL MCCREE WAY

KEY PLAN

SED # 26-16-00-01-0-004-024 DWT SED # 26-16-00-01-7-999-020

Rochester Schools Modernization Program - Phase 2c

George M. Forbes - Renovation, Alterations and Addition

> 198 Dr Samuel McCree Way, Rochester NY, 14611

EV. #	DESCRIPTION	DATE
1	Revision 1	Date 1


GEORGE MATHER FORBES SCHOOL NO.4

JOB NO.	171
SCALE	1/4" = 1'-0
ISSUE DATE	4/25/1
DRAWN BY	BCV
CHECKED BY	Checke
THIS IS A SINGLE SHEET OF A COHESIVE	

SET OF CONSTRUCTION DOCUMENTS
(INCLUDING DRAWINGS AND SPECIFICATIONS) INTERPRETATION OF THE INFORMATION AS PRESENTED SHOULD BE BASED ON THE ENTIRE SET OF DOCUMENTS.

DRAWING TITLE **ENLARGED** BATHROOM PLAN -**EAST** 

P-302

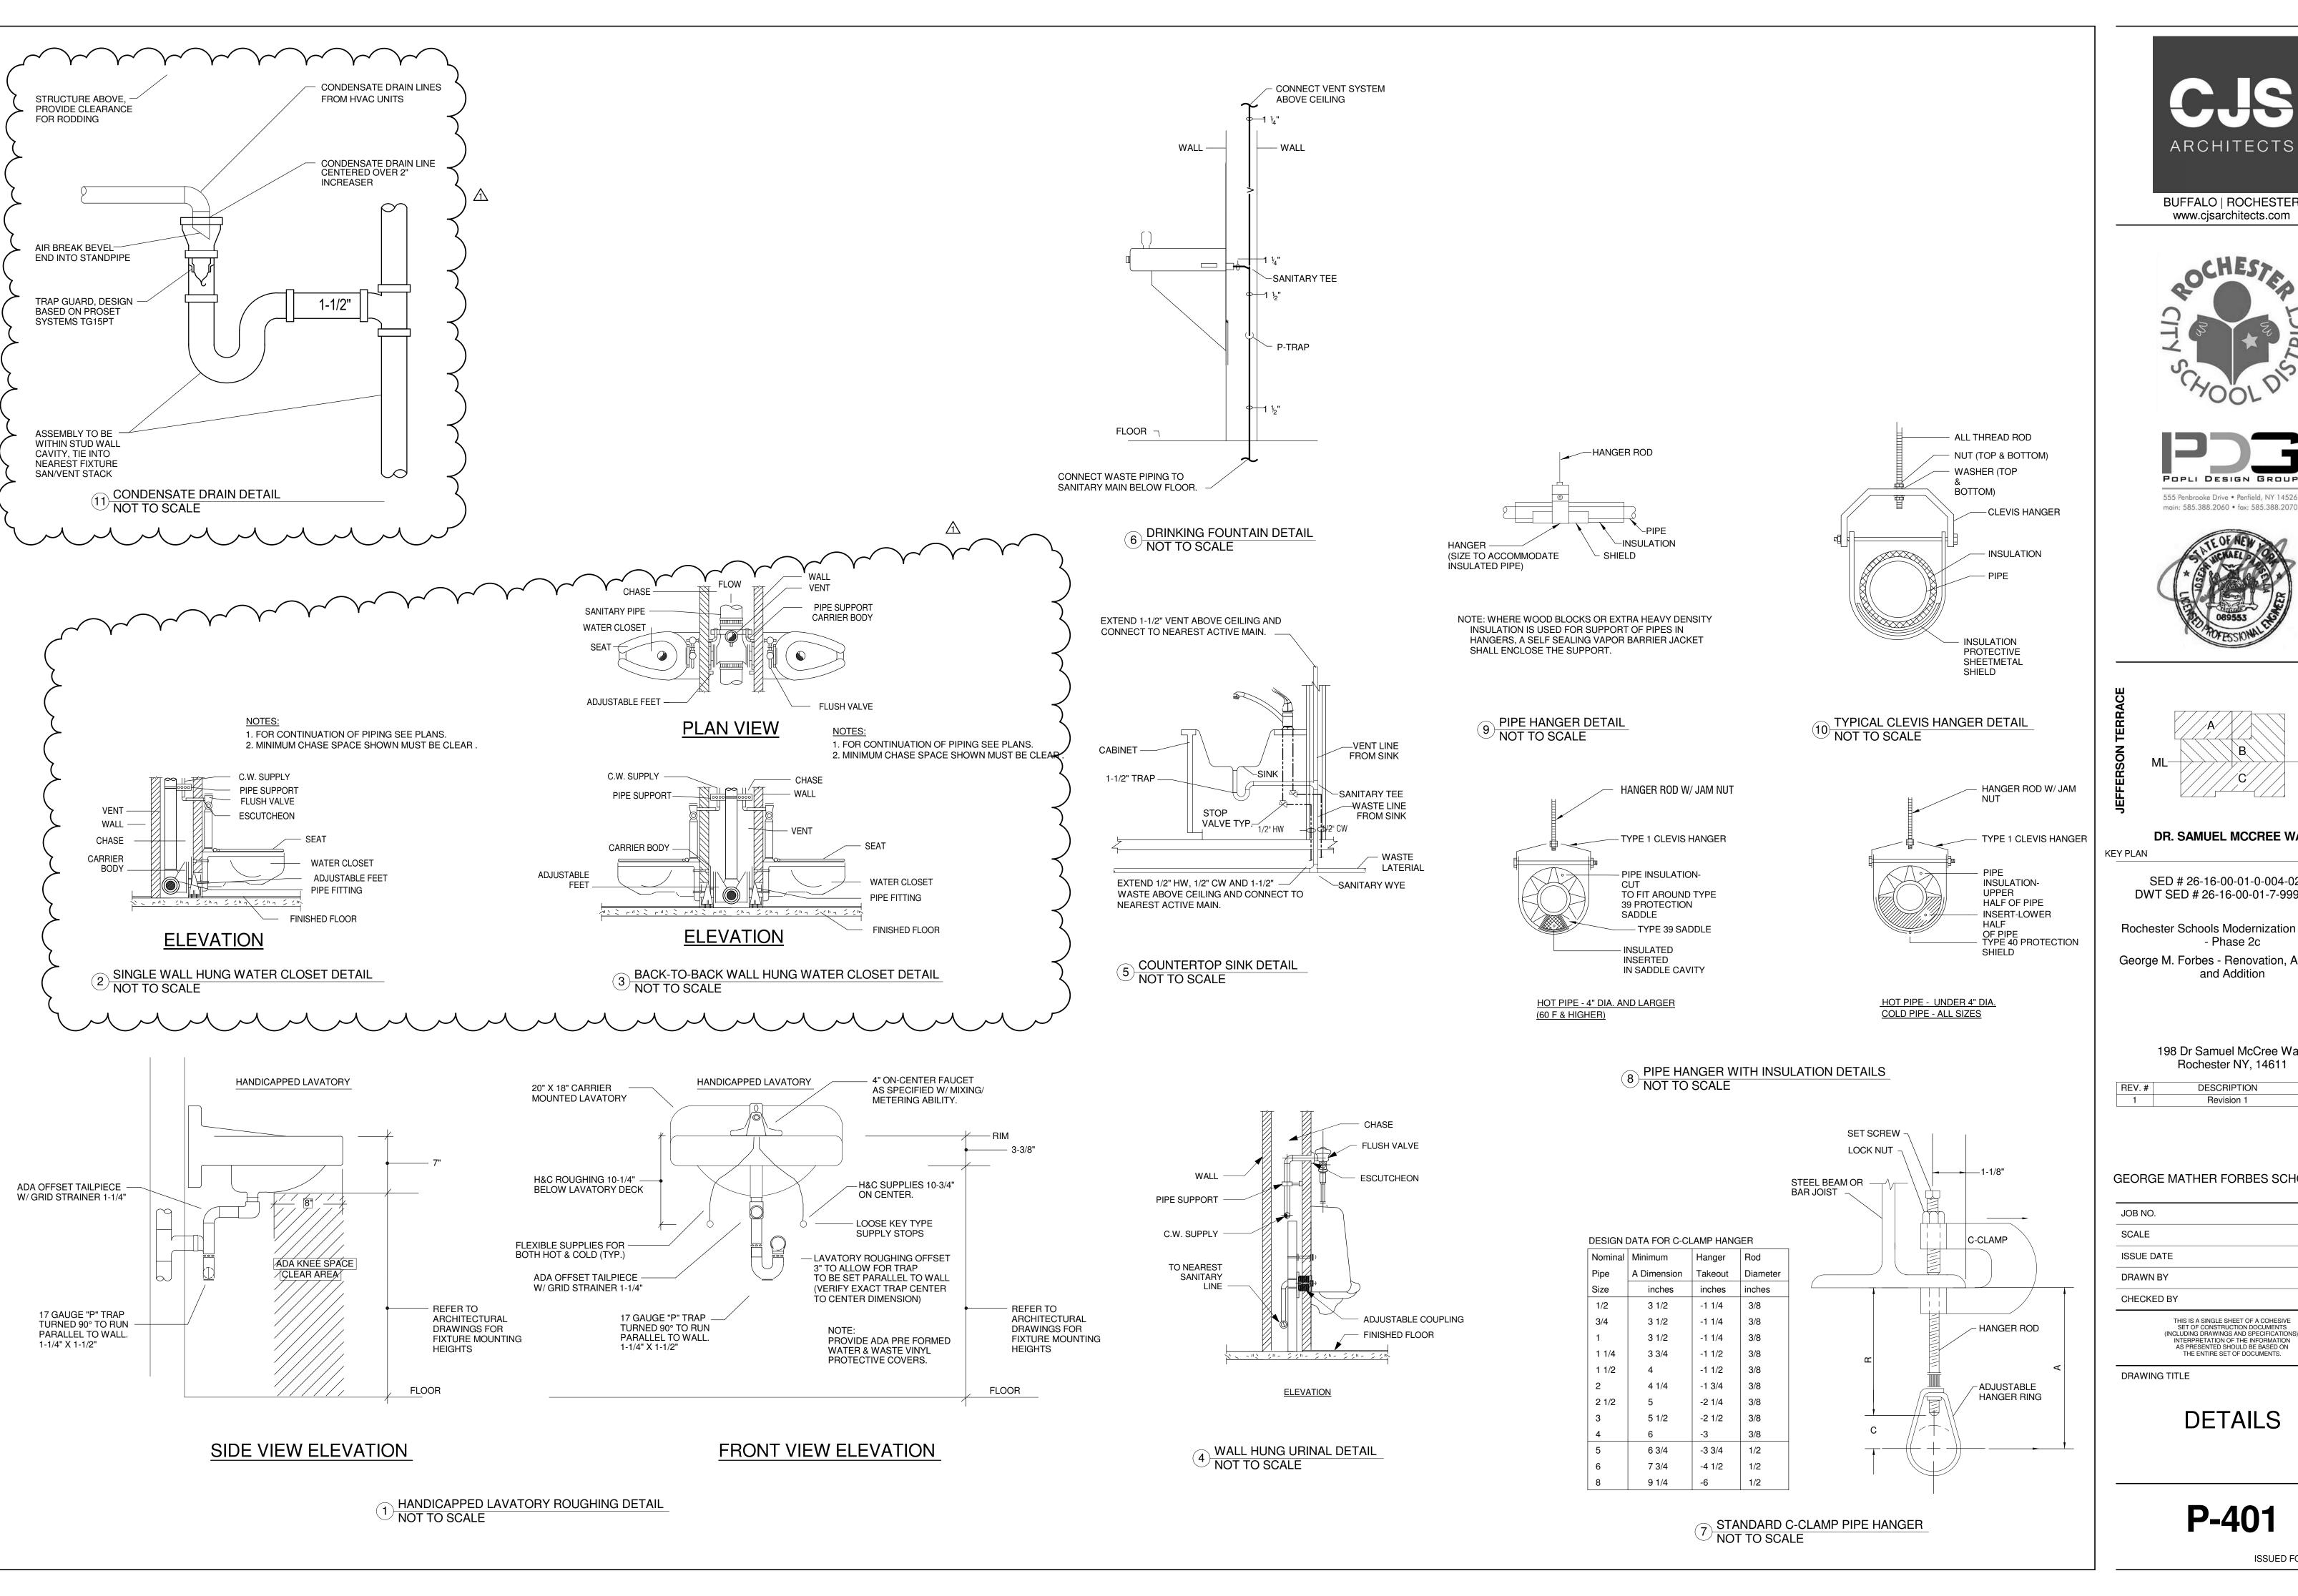


ARCHITECTS BUFFALO | ROCHESTER



www.cjsarchitects.com





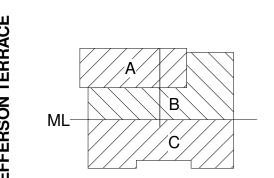

# DR. SAMUEL MCCREE WAY

SED # 26-16-00-01-0-004-024 DWT SED # 26-16-00-01-7-999-020

Rochester Schools Modernization Program - Phase 2c

George M. Forbes - Renovation, Alterations and Addition

> 198 Dr Samuel McCree Way, Rochester NY, 14611

	REV.#	DESCRIPTION	DATE
	1	Revision 1	Date 1

GEORGE MATHER FORBES SCHOOL NO.4


JOB NO.	1711
SCALE	
ISSUE DATE	4/25/18
DRAWN BY	BCW
CHECKED BY	Checker
THIS IS A SINGLE SHEET OF A COHESIVE SET OF CONSTRUCTION DOCUMENTS (INCLUDING DRAWINGS AND SPECIFICATIONS).	

INTERPRETATION OF THE INFORMATION
AS PRESENTED SHOULD BE BASED ON
THE ENTIRE SET OF DOCUMENTS.

DRAWING TITLE

**DETAILS** 

P-401

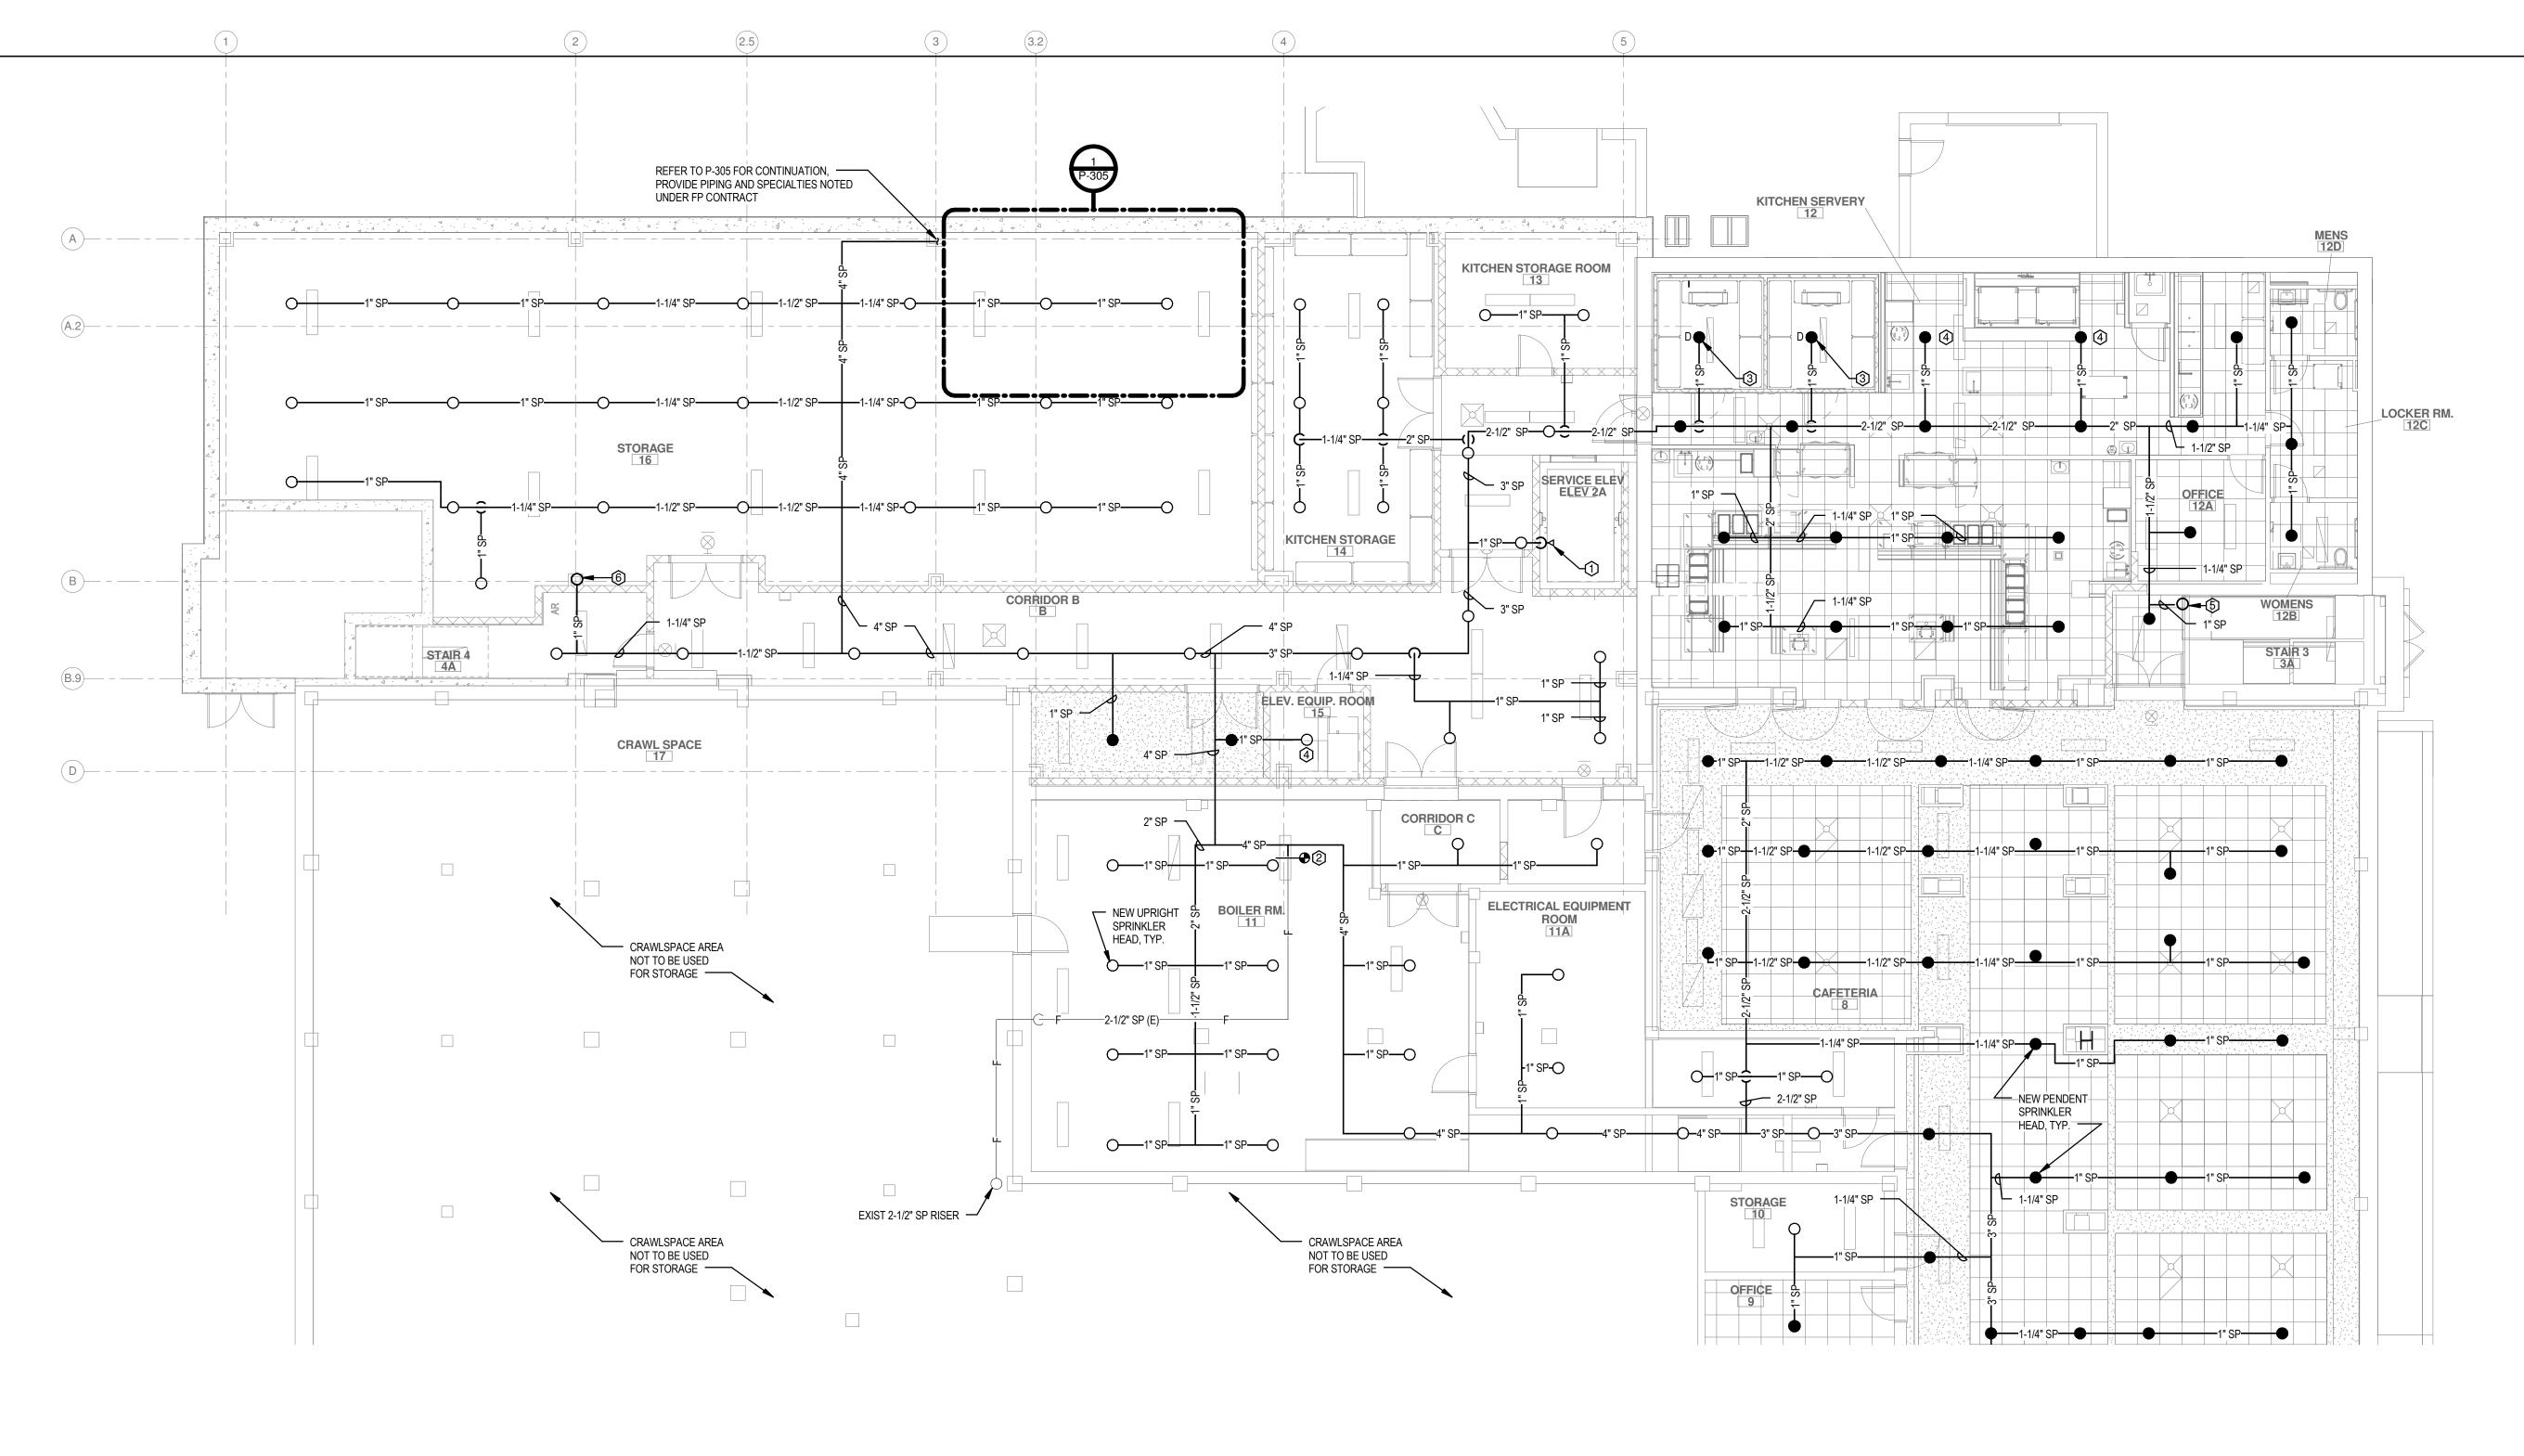

1) FIRE PROTECTION BASEMENT CEILING PLAN NORTH 1/8" = 1'-0"

### **GENERAL NOTES:**

1. CEILING GRIDS, LIGHTS, AND DIFFUSERS SHOWN FOR REFERENCE ONLY. REFER TO ARCHITECTURAL DRAWINGS FOR FINAL CEILING TYPES, HEIGHTS, AND GRIDS. REFER TO ELECTRICAL AND MECHANICAL DRAWINGS FOR FINAL LIGHTING AND DIFFUSER LOCATIONS.

#### **DRAWING NOTES:**

- ① PROVIDE 1" SPRINKLER TO SIDEWALL HEAD NO MORE THAN 2' ABOVE BOTTOM OF ELEVATOR PIT. SUMP PUMP BY "P" CONTRACT.
- ② PROVIDE CONNECTION TO EXISTING 2-1/2"

  SPRINKLER PIPING
- ③ PROVIDE DRY PIPE SPRINKLER HEAD WITHIN
  FREEZER / COOLER AREAS. TYCO DS-1 DRY HEAD OR
  EQUIVALENT. ALL MAINS AND BRANCH PIPING TO BE
  CONCEALED WITHIN HEATED SPACE.
- PROVIDE INTERMEDIATE TEMPERATURE SPRINKLER HEAD.
- © ROUTE 1" SPRINKLER RISER IN CORNER OF STAIRWELL, MAINTAIN CLEARANCE OF HAND RAILS AND STAIR TREADS. SEE FP-101 FOR CONTINUATION.
- © ROUTE 1" SPRINKLER PIPE UP IN CHASE, SEE FP-101 FOR CONTINUATION.



www.cjsarchitects.com





main: 585.388.2060 • fax: 585.388.2070



ML B

DR. SAMUEL MCCREE WAY
KEY PLAN

SED # 26-16-00-01-0-004-024 DWT SED # 26-16-00-01-7-999-020

Rochester Schools Modernization Program
- Phase 2c

George M. Forbes - Renovation, Alterations

and Addition

198 Dr Samuel McCree Way, Rochester NY, 14611

Ī	REV.#	DESCRIPTION	DATE
	1	Revision 1	Date 1


GEORGE MATHER FORBES SCHOOL NO.4

	JOB NO.	1711
	SCALE	1/8" = 1'-0
	ISSUE DATE	4/25/18
	DRAWN BY	BCW
	CHECKED BY	Checke
	THIS IS A SINGLE SHEET OF A COHESIVE	


I HIS IS A SINGLE SHEET OF A COHESIVE
SET OF CONSTRUCTION DOCUMENTS
(INCLUDING DRAWINGS AND SPECIFICATIONS).
INTERPRETATION OF THE INFORMATION
AS PRESENTED SHOULD BE BASED ON
THE ENTIRE SET OF DOCUMENTS.

BASEMENT FIRE
PROTECTION
PARTIAL FLOOR PLAN

FP-100.1

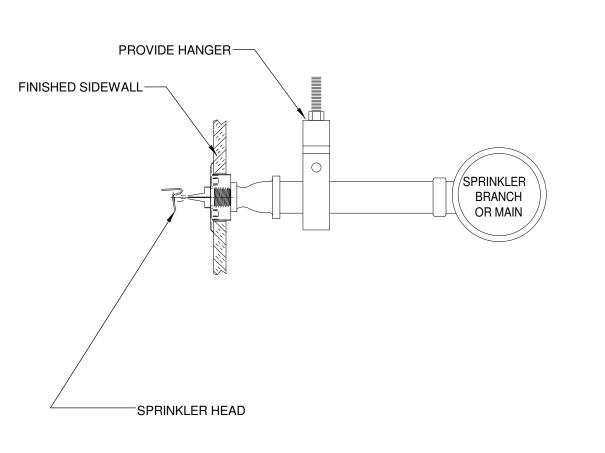

1 SIDEWALL SPRINKLER HEAD DETAIL NOT TO SCALE

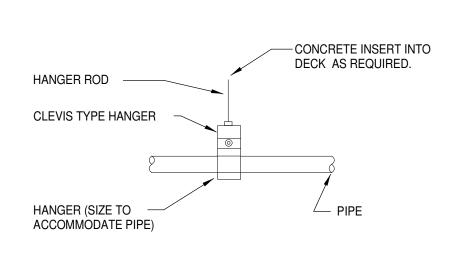

4 PIPE HANGER DETAIL NOT TO SCALE

PRODUCT LEGEND

1 1" NIPPLE (INLET)

3 ADAPTER RING

2 NUT

4 COLLAR

48", 60", & 72")


9 CENTER BRACKET ASSEMBLY

11 END BRACKET ASSEMBLY 12 SHEET METAL SCREW


FIRELOCK (1" FMPT)

6 COLLAR 7 NUT

LENGTHS)

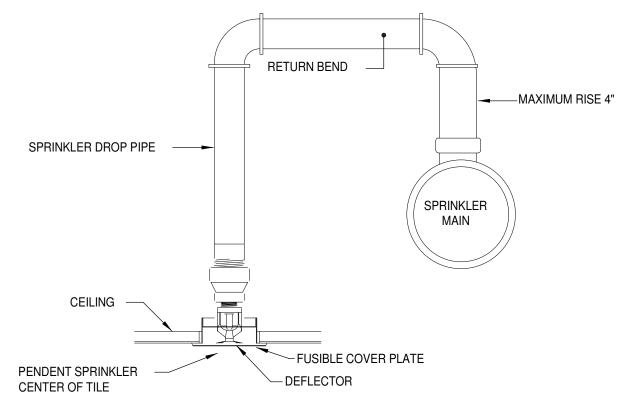

2 CONCEALED PENDENT SPRINKLER HEAD DETAIL NOT TO SCALE

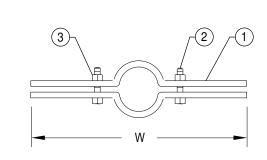



**COMPONENTS:** 1. PIPE CLAMP (2 PIECES) 2. SQUARE HEAD BOLT 3. HEX NUT


DESIGN DATA FOR RISER CLAMPS

NOMINAL PIPE	W DIMENSION	STEEL SIZE	BOLT SIZE
SIZE	INCHES	INCHES	INCHES
2 1/2	11 1/4	1/4" x 1-1/4"	3/8" x 1-1/2"
3	12	1/4" x 1-1/4"	3/8" x 1-1/2"
4	13 1/2	1/4" x 1-1/2"	1/2" x 1-1/2"
5	14 1/2	1/4" x 2"	1/2" x 1-1/2"
6	15 1/2	1/4" x 2"	1/2" x 1-1/2"
8	18 1/2	3/8" x 2"	5/8" x 2-1/2"


5 PIPE RISER CLAMP DETAIL NOT TO SCALE

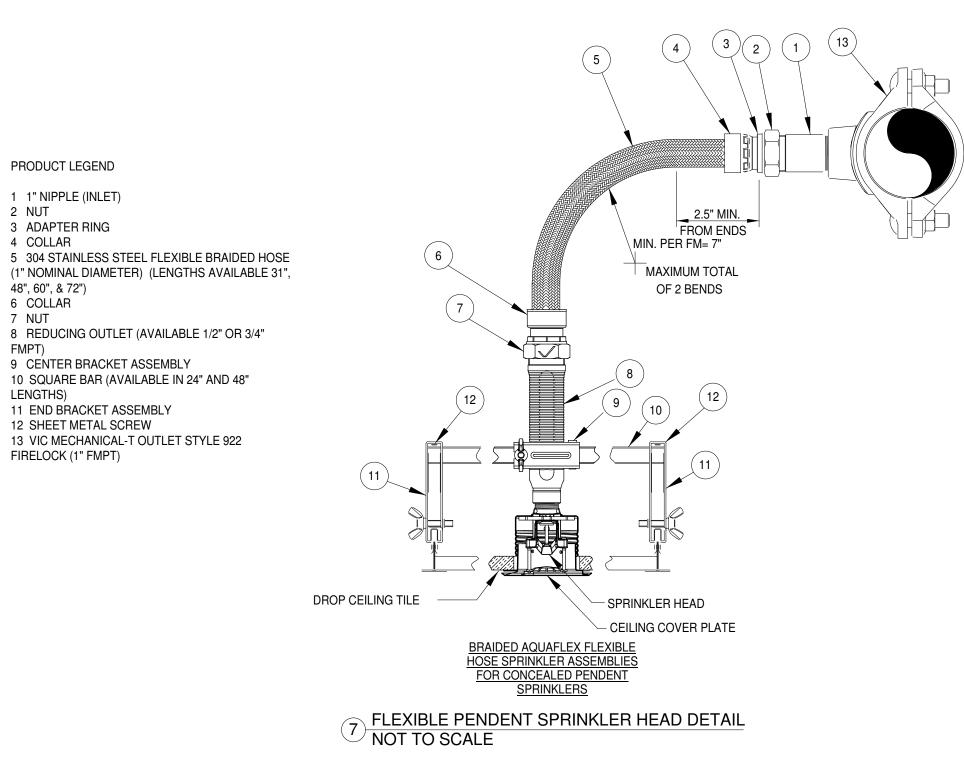

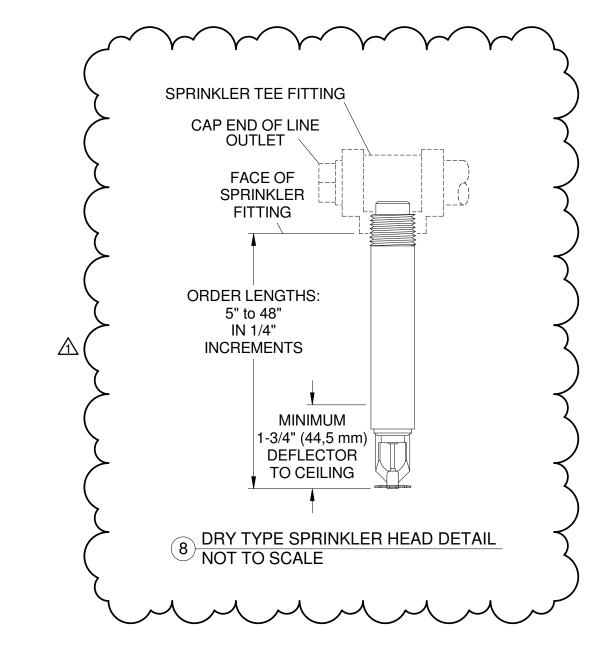

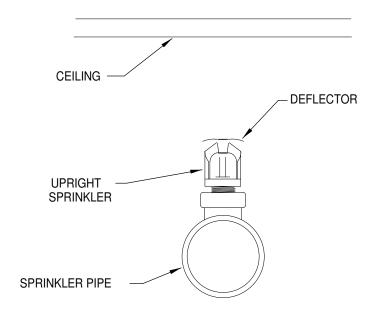

# 3 UPRIGHT SPRINKLER HEAD DETAIL NOT TO SCALE

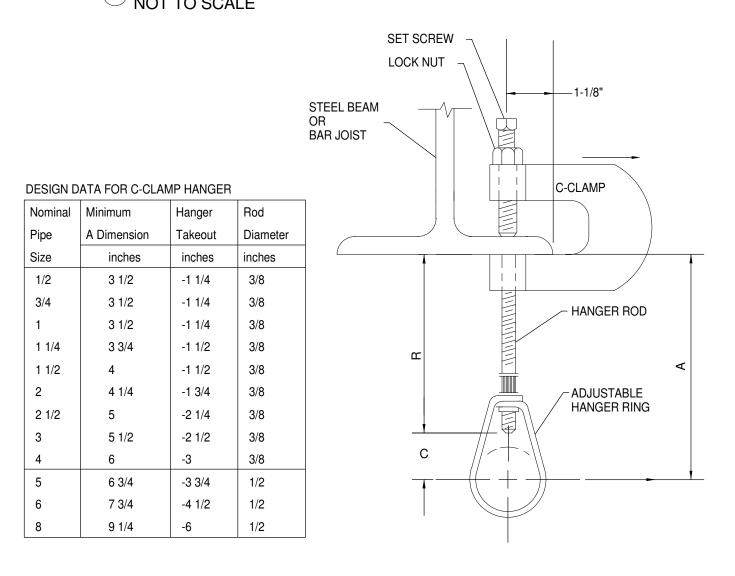

6 STANDARD C-CLAMP PIPE HANGER NOT TO SCALE


POST INDICATOR VALVE SCHEDULE					
TAG	FIXTURE TYPE	SIZE	MANUFACTURER	MODEL	COMMENTS
PIV-A	POST INDICATOR VALVE	4"	KENNEDY VALVE	G300E	BUTTERFLY TYPE









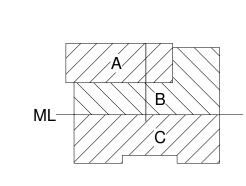



SED # 26-16-00-01-0-004-024

KEY PLAN

DWT SED # 26-16-00-01-7-999-020 Rochester Schools Modernization Program

- Phase 2c George M. Forbes - Renovation, Alterations and Addition

198 Dr Samuel McCree Way, Rochester NY, 14611

REV.#	DESCRIPTION	DATE
1	Revision 1	Date 1

#### GEORGE MATHER FORBES SCHOOL NO.4


JOB NO.	171
SCALE	
ISSUE DATE	4/25/1
DRAWN BY	BCV
CHECKED BY	Checke
THIS IS A SINGLE SHEET OF A COHESIVE	

THIS IS A SINGLE SHEET OF A COHESIVE SET OF CONSTRUCTION DOCUMENTS (INCLUDING DRAWINGS AND SPECIFICATIONS). INTERPRETATION OF THE INFORMATION AS PRESENTED SHOULD BE BASED ON THE ENTIRE SET OF DOCUMENTS.

DRAWING TITLE

## SCHEDULES AND **DETAILS**

**FP-400** 

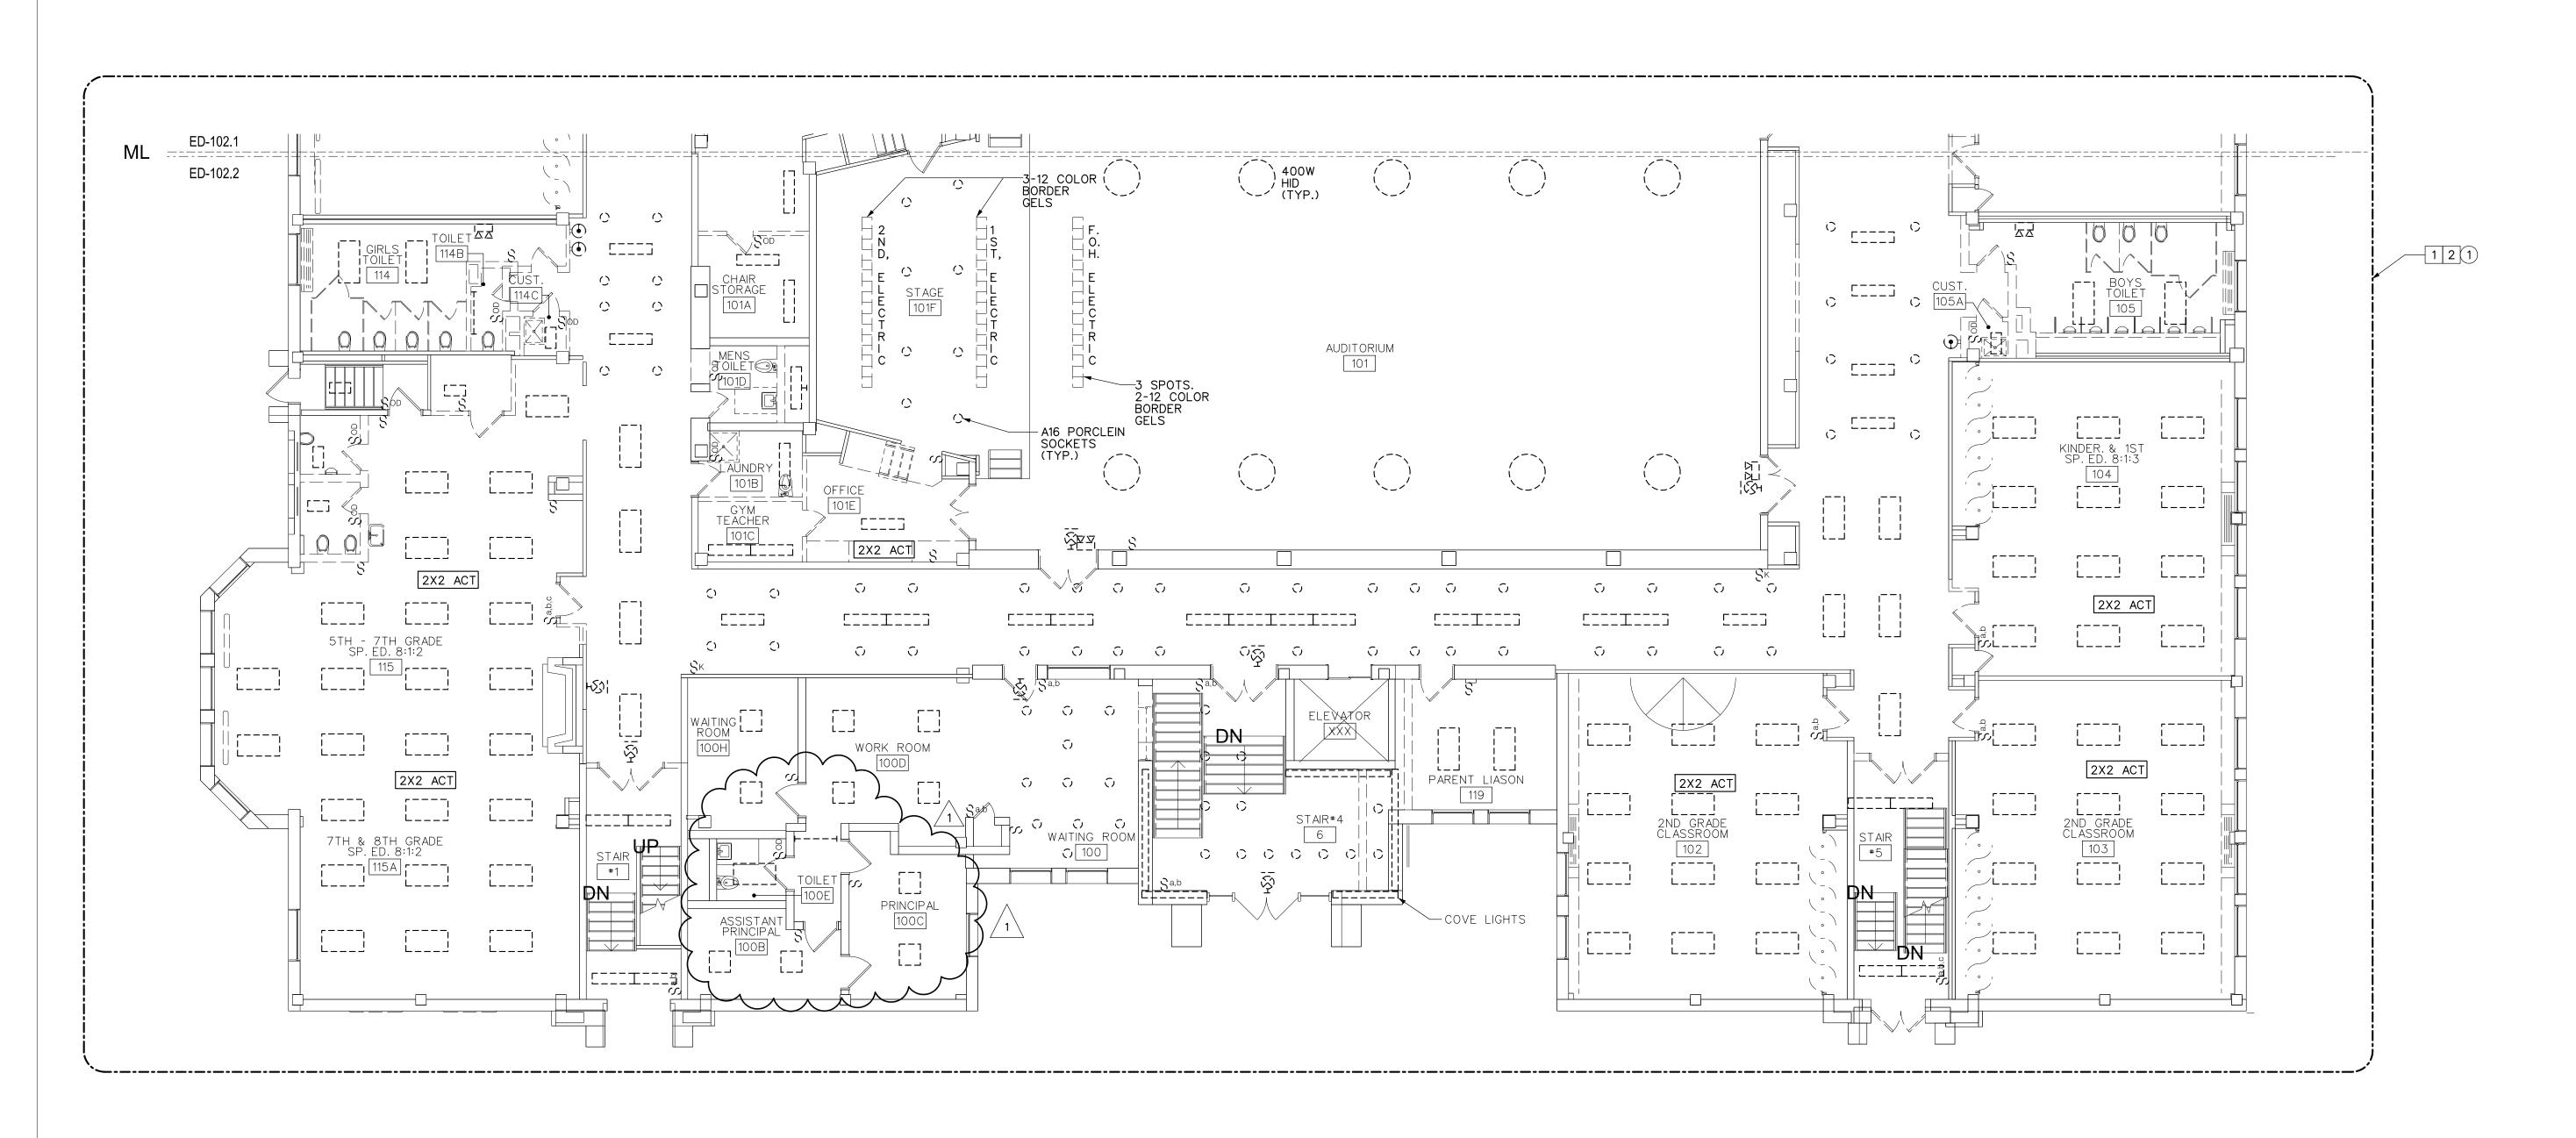



#### **GENERAL NOTES:**

A. REFER TO DRAWING E-000 FOR GENERAL NOTES THAT PERTAIN TO ALL ELECTRICAL DRAWINGS.

### **DEMOLITION NOTES:**

- DISCONNECT AND REMOVE ALL EXISTING LIGHTING, SWITCHING AND ASSOCIATED BRANCH CIRCUITNG BACK TO SOURCE; UNLESS NOTED OTHERWISE.
- MAINTAIN ALL EXISTING EXIT LIGHT FIXTURES FOR CONSTRUCTION. DISCONNECT AND REMOVE AFTER COMPLETION. COORDINATE WITH CONSTRUCTION MANAGER

### **DRAWING NOTES:**

1) PROVIDE ALL REQUIRED TEMPORARY LIGHTING AND BRANCH CIRCUITING FOR CONSTRUCTION. LIGHTING LEVELS SHALL BE A MINIMUM OF 15FC IN AREAS OF CONSTRUCTION.







Mechanical/Electrical Engineering Consultants

Rochester | Buffalo | Syracuse | Schenectady

150 N. CHESTNUT ST. ROCHESTER, NY 14604

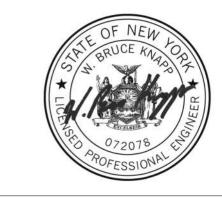

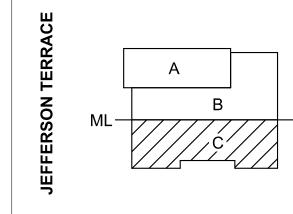

DR. SAMUEL MCCREE WAY

SED # 26-16-00-01-0-004-024 DWT SED # 26-16-00-01-7-999-020

Rochester Schools Modernization Program
-Phase 2c
George M. Forbes- Renovation, Alterations
and Addition

198 Dr Samuel McCree Way, Rochester, NY 14611


REV.#	DESCRIPTION	DATE
1	ADDENDUM 1	4/25/18

JOB NO.	171
SCALE	AS NOTE
ISSUE DATE	4/9/1
DRAWN BY	IJN/DJ
CHECKED BY	DJI
THIS IS A SINGLE SHEET OF A COHESIVE SET OF CONSTRUCTION DOCUMENTS (INCLUDING DRAWINGS AND SPECIFICATIONS) INTERPRETATION OF THE INFORMATION AS PRESENTED SHOULD BE BASED ON THE ENTIRE SET OF DOCUMENTS.	
	SCALE  ISSUE DATE  DRAWN BY  CHECKED BY  THIS IS A SINGLE SHEET OF A COHESIVE SET OF CONSTRUCTION DOCUMENTS (INCLUDING DRAWINGS AND SPECIFICATIONS) INTERPRETATION OF THE INFORMATION AS PRESENTED SHOULD BE BASED ON

DRAWING TITLE

FIRST FLOOR DEMOLITION PLAN -LIGHTING

ED-102.2

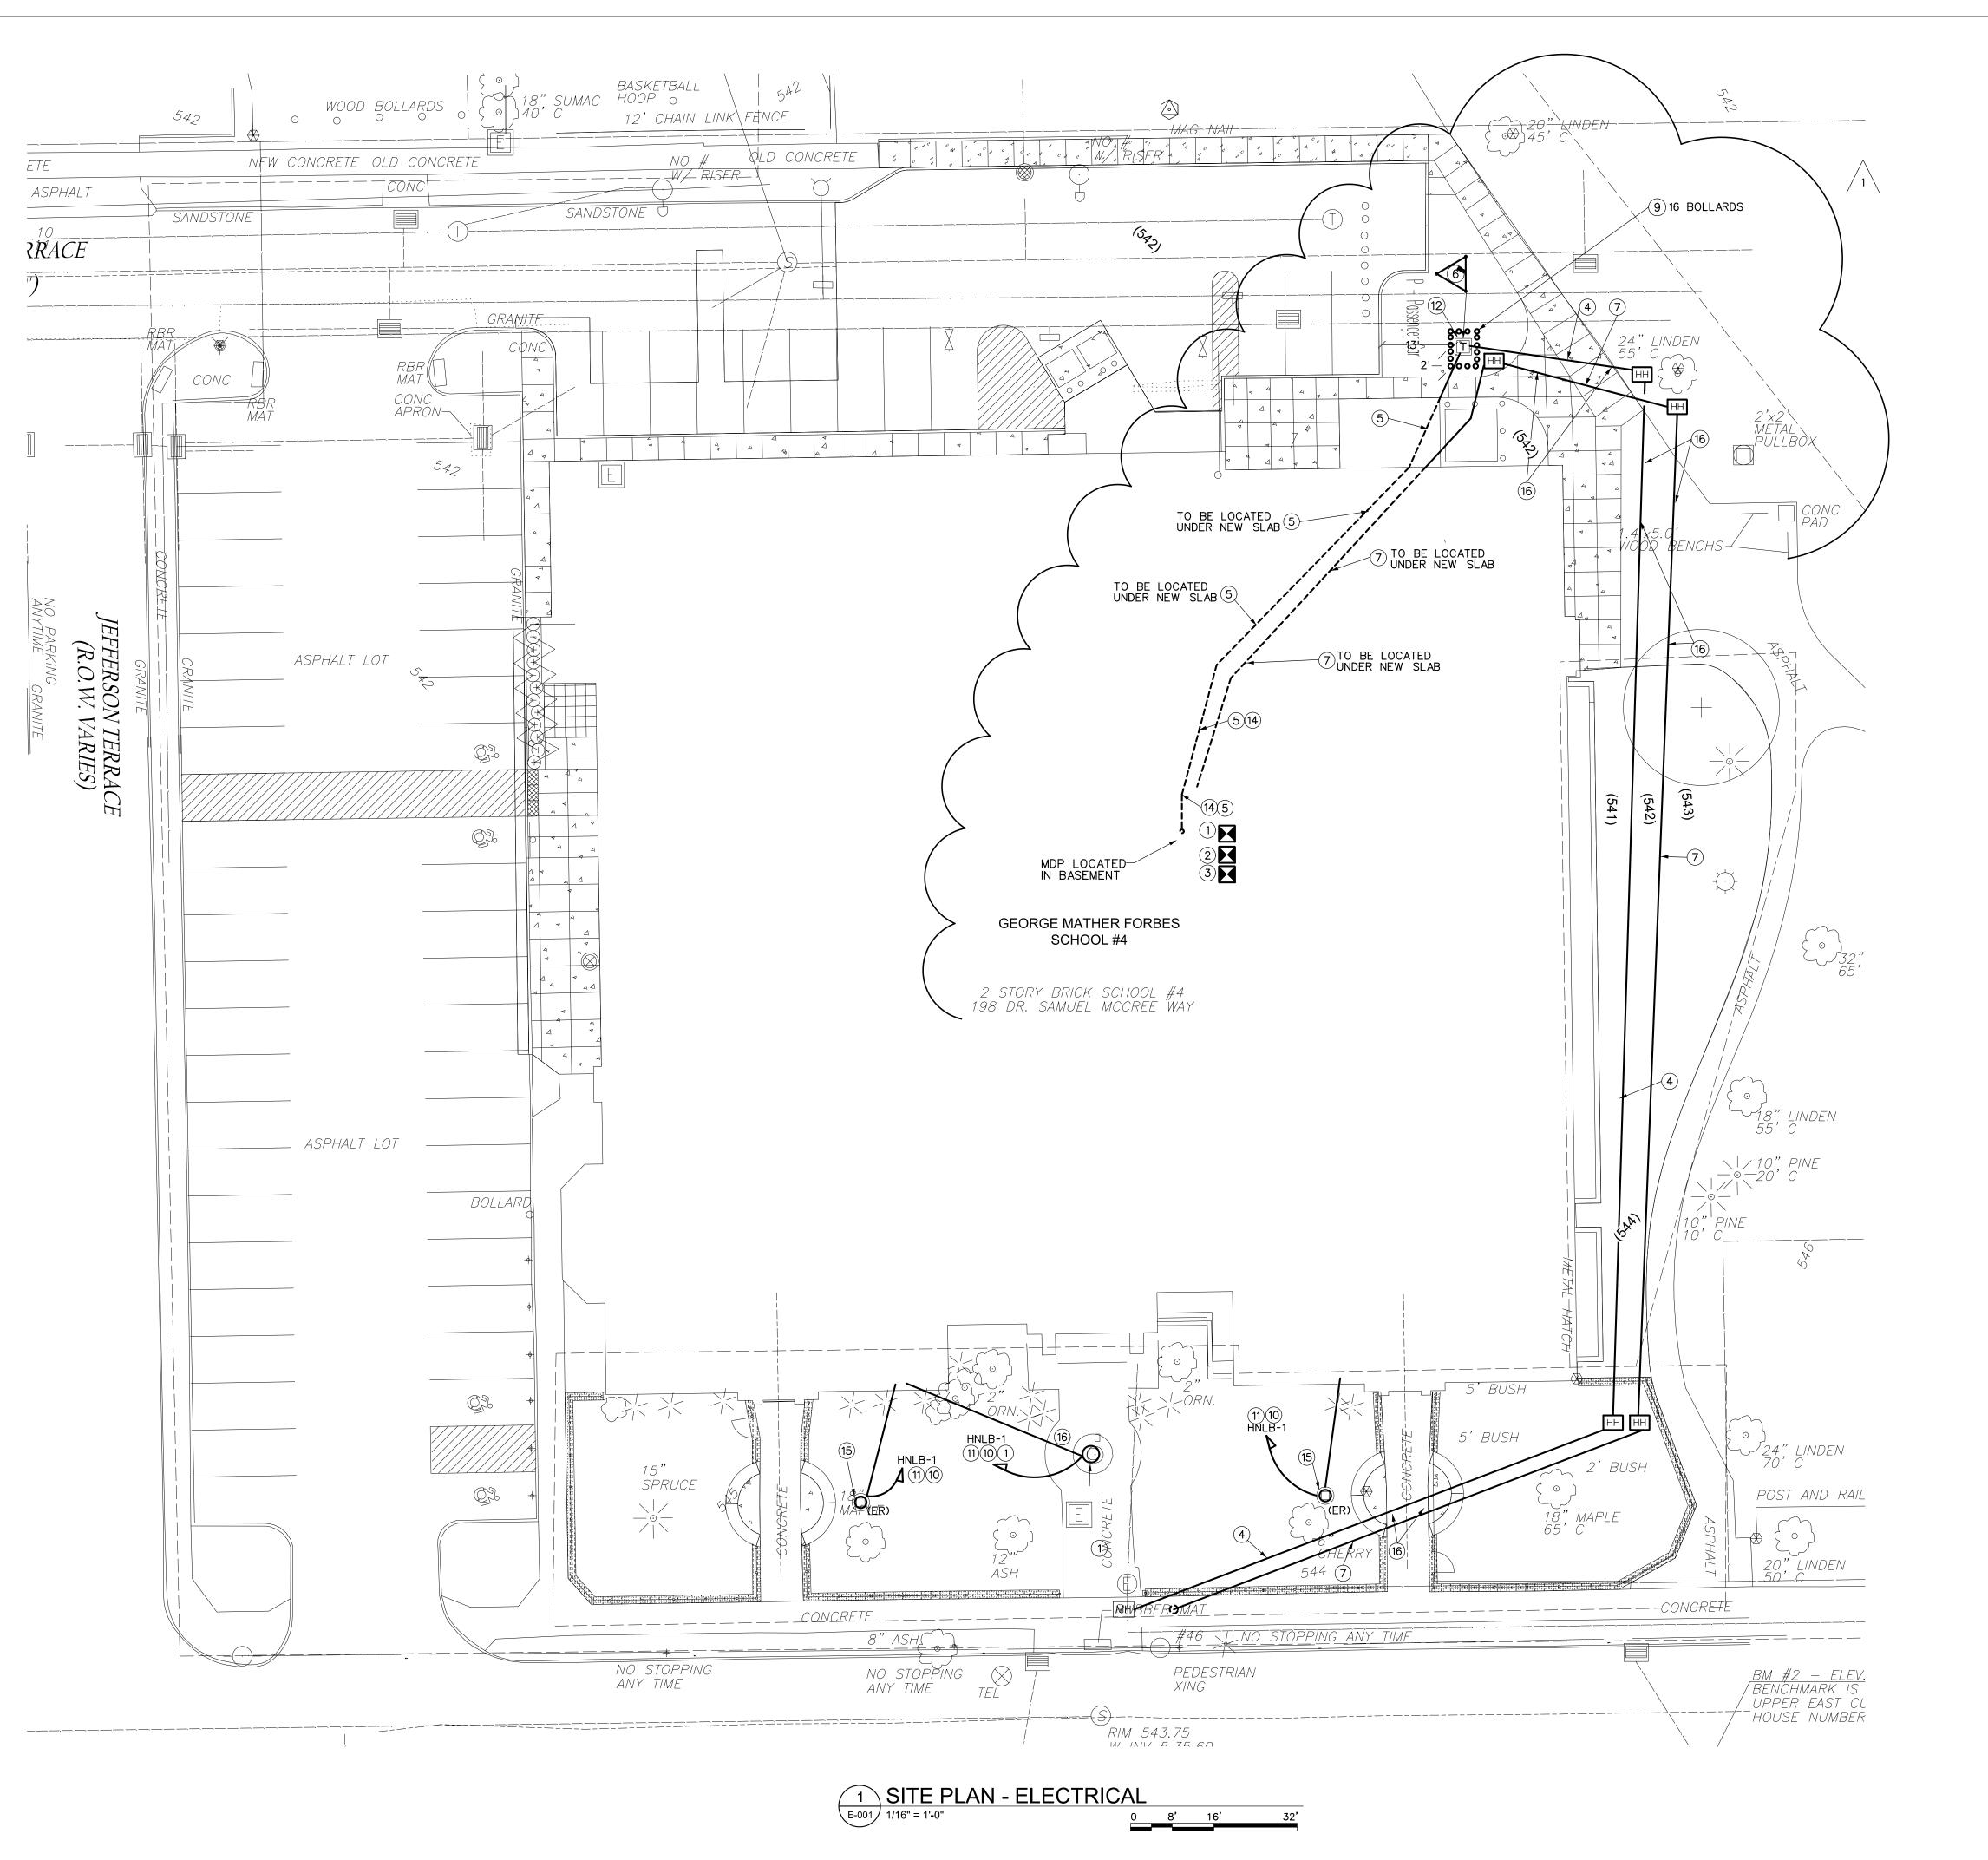

#### **GENERAL NOTES:**

- A. REFER TO DRAWING E-000 FOR GENERAL NOTES THAT PERTAIN TO ALL ELECTRICAL DRAWINGS.
- B. IT IS THE RESPONSIBILITY OF THE ELECTRICAL CONTRACTOR TO PROVIDE ALL SITE SUB GRADE WORK AS SPECIFIED. THIS INCLUDES, BUT IS NOT LIMITED TO DIGGING TRENCHES, BACK FILLING AND COMPACTION. ALL FINISH GRADE WORK SUCH AS SEEDING, ALL ASPHALT AND CONCRETE PATCHING SHALL BE DONE BY THE SITE CONTRACTOR. REFER TO SITE DRAWINGS AND DETAILS FOR TRENCHING, BACK FILLING, COMPACTION AND FINISH WORK REQUIREMENTS.
- C. IDENTIFY, FLAG AND PROTECT ALL EXISTING UTILITIES, OIL AND PROPANE PIPING PRIOR TO
- D. REFER TO SITE CONSULTANT DRAWINGS FOR ADDITIONAL INFORMATION ON SITE LIGHTING FIXTURE SCHEDULE, POLE DETAILS, ETC. SITE LIGHTING, POLES AND BASES BY SITE CONTRACTOR.
- E. COORDINATE ALL SITE LIGHTING, HANDHOLE, ROUTES AND EXISTING UTILITIES WITH SITE DRAWINGS PRIOR TO WORK.
- F. ALL BUILDING MOUNTED AND SITE LIGHTING SHALL BE CONNECTED THROUGH BUILDING WIDE ENERGY MANAGEMENT SYSTEM (DDC).
- G. ROUTE ALL SITE LIGHTING POWER BACK TO BUILDING AS INDICATED. COORDINATE ALL ROUTES WITH EXISTING AND NEW UTILITIES PRIOR TO ROUTING.
- H. ALL SITE LIGHTING, POLES AND BASES SHALL BE BY THIS CONTRACTOR.
- REFER TO DRAWING E-002 FOR BUILDING MOUNTED

### **DRAWING NOTES:**

- ALTERNATE WORK:
  PROVIDE FLAG POLE LIGHT FIXTURE. FIXTURE IS TO BE
  MOUNTED ONTO FLAGPOLE. FLAGPOLE LIGHTING SHALL BE
  "POLELED BASIC" LIGHTING. COORDINATE MOUNTING WITH
  G.C. AND MANUFACTUER OF LIGHTING. VERIFY DIAMETER OF
  FLAGPOLE PRIOR TO ORDERING FLAGPOLE LIGHTING.
  PROVIDE 4 POLE LIGHTING CONTACTOR FOR ONE 'c'
  FIXTURES. MOUNT CONTACTOR IN ELECT. ROOM 11A AND
  CONNECT TO BUILDING MANAGEMENT SYSTEM. PROVIDE 2-\*8,
  1-\*8EG, 1"C TO PANELBOARD. CIRCUIT AS NOTED.
- PROVIDE 12 POLE LIGHTING CONTACTOR FOR ZONE 'a' FIXTURES. MOUNT CONTACTOR IN ELECT. ROOM 11A AND CONNECT TO BUILDING MANAGEMENT SYSTEM. PROVIDE 2-\*8, 1-\*8EG, 1"C TO PANELBOARD. CIRCUIT AS NOTED.
- PROVIDE 12 POLE LIGHTING CONTACTOR FOR ZONE 'b' FIXTURES. MOUNT CONTACTOR IN ELECT. ROOM 11A AND CONNECT TO BUILDING MANAGEMENT SYSTEM. PROVIDE 2-\*8, 1-\*8EG, 1"C TO PANELBOARD. CIRCUIT
- PROVIDE PRIMARY SERVICE ENTRANCE UNDERGROUND DUCTBANK CONCRETE ENCASED AT 36 INCHES BELOW GRADE FROM UTILITY POLE TO TRANSFORMER. PROVIDE COMPACTED BACKFILL AS REQUIRED. REFER TO SITE SPECIFICATIONS FOR COMPACTION REQUIREMENTS. REFER TO ONE-LINE DIAGRAM ON DRAWINGS FOR SIZES AND ADDITIONAL WORK. COORDINATE ROUTING WITH SITE DRAWINGS.
- PROVIDE SECONDARY SERVICE ENTRANCE UNDERGROUND DUCTBANK CONCRETE ENCASED AT 24 INCHES BELOW GRADE FROM TRANSFORMER TO SCHOOL POWER DISTRIBUTION SYSTEM. PROVIDE COMPACTED BACKFILL AS REQUIRED. REFER TO SITE SPECIFICATIONS FOR COMPACTION REQUIREMENTS. REFER TO ONE-LINE DIAGRAM ON DRAWINGS FOR SIZES AND ADDITIONAL WORK. COORDINATE ROUTING WITH SITE DRAWINGS.
- 6 PROVIDE ELECTRODE GROUND GRID PER DETAIL DRAWINGS
- PROVIDE COMMUNICATIONS DUCTBANK CONCRETE ENCASED AT 24 INCHES BELOW GRADE TO SCHOOL WITH THREE (3) EMPTY 4" CONDUITS WITH PULL STRINGS TO ACCOMMODATE TELECOMMUNICATIONS EQUIPMENT. PROVIDE COMPACTED BACKFILL AS REQUIRED. REFER TO SITE SPECIFICATIONS FOR COMPACTION REQUIREMENTS. COORDINATE ROUTING WITH SITE DRAWINGS.
- 8 PROVIDE THREE (3) HANDHOLES TO ACCOMMODATE SITE LIGHTING BRANCH CIRCUITING. COORDINATE LOCATIONS IN FIELD WITH ENGINEER.
- PROVIDE PROTECTIVE BOLLARDS, QUANTITY AND LOCATION AS REQUIRED BY RG AND E.
- CONNECT THRU LIGHTING CONTACTOR TO BE CONTROLLED BY DDC SYSTEM. PROVIDE ALL WIRING REQUIRED TO GO THRU DDC SYSTEM. PROVIDE COORDINATION OF ZONING WITH OWNER'S REPRESENTATIVE TO DETERMINE ZONE'S OF BUILDING AND POLE MOUNTED LIGHTING.
- PROVIDE ONE (1) SET OF FEEDER, SIZE AS INDICATED, DIRECT BURIED BACK TO POWER PANEL AS INDICATED FOR FIXTURES NOTED.
- PROVIDE PAD MOUNTED TRANSFORMER FOUNDATION PAD/VAULT PER DETAIL ON DRAWING E-701.
- 13 STUB UP INTO INSIDE OF BUILDING FROM UNDERGROUND.
- PROVIDE SAW CUTTING OF EXISTING FLOOR TO ACCOMMODATE SECONDARY FEEDER INTO MDP. PROVIDE ALL PATCHING TO MATCH OF FLOOR.
- RELOCATE EXISTING POLE, AND LUMINAIRE TO NEW LOCATION. PROVIDE NEW POLE BASE. BASE SHALL MATCH EXISTING POLE BOLT PATTERN. PROVIDE LED RETEROFIT KIT AT EXISITNG POLE. PROVIDE FIELD VERIFICATION TO DETERMINE RETROFIT KIT REQUIREMENTS.
- PROVIDE SAWCUTTING AND PATCHING TO MATCH OF EXISTING ASPHALT/CONCRETE WALKWAYS TO ACCOMMODATE ELECTRICAL SERVICE WORK.



BUFFALO | ROCHESTER www.cjsarchitects.com



ME ENGINEERING


Mechanical/Electrical Engineering Consultants

Rochester | Buffalo | Syracuse | Schenectady

150 N. CHESTNUT ST.
ROCHESTER. NY 14604

WWW.meengineering.com



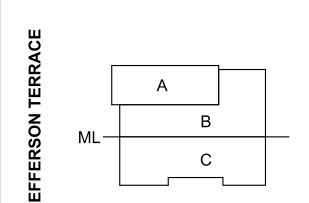

DR. SAMUEL MCCREE WAY

SED # 26-16-00-01-0-004-024

DWT SED # 26-16-00-01-7-999-020

Rochester Schools Modernization Program
-Phase 2c
George M. Forbes- Renovation, Alterations
and Addition

198 Dr Samuel McCree Way, Rochester, NY 14611

REV. # DESCRIPTION DATE
1 ADDENDUM 1 4/25/18


JOB NO. 1711
SCALE AS NOTED
ISSUE DATE 4/9/18
DRAWN BY IJN/DJP
CHECKED BY DJP

THIS IS A SINGLE SHEET OF A COHESIVE SET OF CONSTRUCTION DOCUMENTS (INCLUDING DRAWINGS AND SPECIFICATIONS). INTERPRETATION OF THE INFORMATION AS PRESENTED SHOULD BE BASED ON THE ENTIRE SET OF DOCUMENTS.

DRAWING TITLE

SITE PLAN -ELECTRICAL

E-001

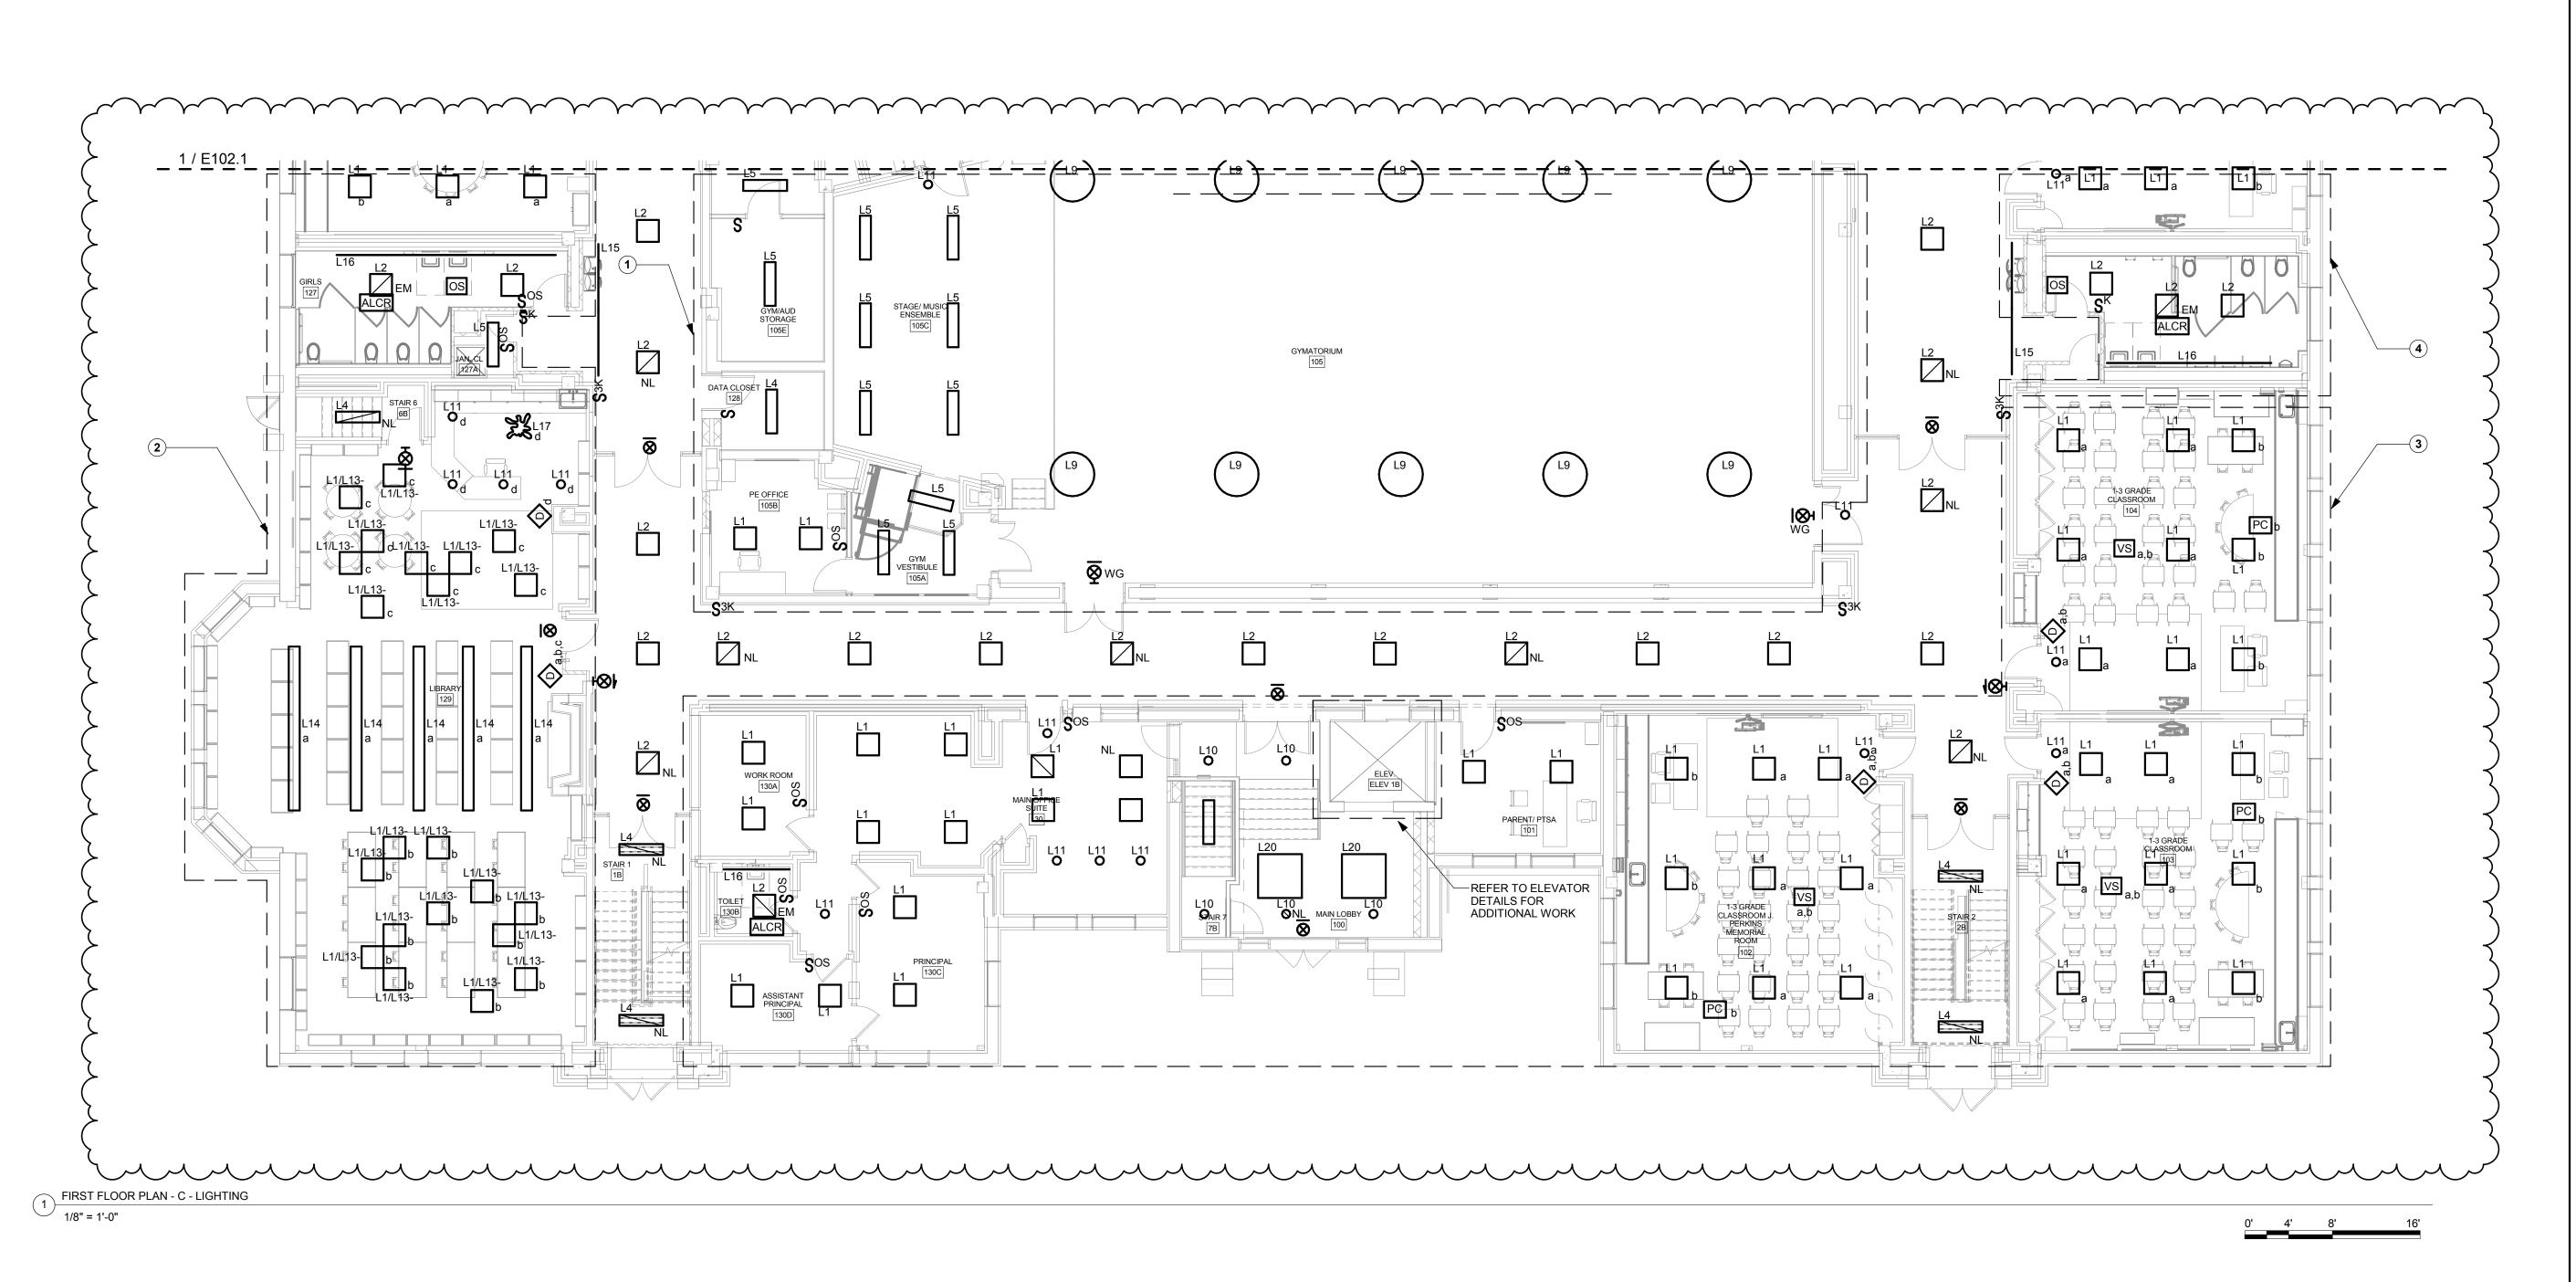

### E102.2 GENERAL NOTES

- REFER TO DRAWING E-000 FOR GENERAL NOTES THAT PERTAIN TO ALL ELECTRICAL DRAWINGS.
- PROVIDE 277V UNSWITCHED EMERGENCY LIGHTING BRANCH CIRCUIT(S) AND HOME RUNS FOR EXIT LIGHT FIXTURES ON THIS DRAWING FROM PANEL HELSPH-1 LOCATED IN PENTHOUSE UNLESS OTHERWISE NOTED. CIRCUIT NUMBER SHALL BE DESIGNATED AS #7. PROVIDE BRANCH CIRCUIT USING 2-#10, 1-#10EG, 3/4"C.
- PROVIDE 277V UNSWITCHED EMERGENCY LIGHTING BRANCH CIRCUIT(S) AND HOME RUNS FOR LIGHT FIXTURES DENOTED AS BEING CONNECTED TO AN EMERGENCY LIFE SAFETY CIRCUIT 'NL' ON THIS DRAWING FROM PANEL HELSPH-1 LOCATED IN PENTHOUSE UNLESS OTHERWISE NOTED. CIRCUIT NUMBER SHALL BE DESIGNATED AS #9. PROVIDE BRANCH CIRCUIT USING 2-#10, 1-#10EG, 3/4"C.
- PROVIDE 277V NORMAL LIGHTING BRANCH CIRCUIT(S) AND HOME RUNS FOR LIGHT FIXTURES IN CORRIDOR FROM PANEL HNL1-1LOCATED IN MEZZ. 111 UNLESS OTHERWISE NOTED. CIRCUIT NUMBER SHALL BE DESIGNATED AS #2. PROVIDE BRANCH CIRCUIT USING 2-#10, 1-#10EG, 3/4"C.
- PROVIDE 277V UNSWITCHED EMERGENCY LIGHTING BRANCH CIRCUIT(S) AND HOME RUNS FOR LIGHT FIXTURES DENOTED AS BEING CONNECTED TO AN EMERGENCY LIFE SAFETY CIRCUIT 'EM' ON THIS DRAWING FROM PANEL HELSPH-1 LOCATED IN PENTHOUSE UNLESS OTHERWISE NOTED. CIRCUIT NUMBER SHALL BE DESIGNATED AS #11. PROVIDE BRANCH CIRCUIT USING 2-#10, 1-#10EG, 3/4"C.
- F. REFER TO POWER & SS DRAWINGS FOR PANELBOARD LOCATIONS.

### E102.2 DRAWING NOTES

- PROVIDE 277V NORMAL POWER LIGHTING BRANCH CIRCUIT(S) AND HOME RUNS FOR LIGHT FIXTURES IN THIS AREA FROM PANEL HNL1-1 LOCATED IN MEZZ. 111 UNLESS OTHERWISE NOTED. CIRCUIT NUMBER SHALL BE DESIGNATED AS #4.
- PROVIDE BRANCH CIRCUIT USING 2-#10, 1-#10EG, 3/4"C.

  PROVIDE 277V NORMAL POWER LIGHTING BRANCH CIRCUIT(S) AND HOME RUNS FOR LIGHT FIXTURES IN THIS AREA FROM PANEL HNL1-1 LOCATED IN MEZZ. 111 UNLESS OTHERWISE NOTED. CIRCUIT NUMBER SHALL BE DESIGNATED AS #6.
- PROVIDE 277V NORMAL POWER LIGHTING BRANCH CIRCUIT(S) AND HOME RUNS FOR LIGHT FIXTURES IN THIS AREA FROM PANEL HNL1-1 LOCATED IN MEZZ. 111 UNLESS OTHERWISE NOTED. CIRCUIT NUMBER SHALL BE DESIGNATED AS #8. PROVIDE BRANCH CIRCUIT USING 2-#10, 1-#10EG, 3/4"C.

PROVIDE BRANCH CIRCUIT USING 2-#10, 1-#10EG, 3/4"C.

PROVIDE 277V NORMAL POWER LIGHTING BRANCH CIRCUIT(S) AND HOME RUNS FOR LIGHT FIXTURES IN THIS AREA FROM PANEL HNL1-1 LOCATED IN MEZZ. 111 UNLESS OTHERWISE NOTED. CIRCUIT NUMBER SHALL BE DESIGNATED AS #10. PROVIDE BRANCH CIRCUIT USING 2-#10, 1-#10EG, 3/4"C.






ME ENGINEERING

Mechanical/Electrical Engineering Consultants

Rochester | Buffalo | Syracuse | Schenectady

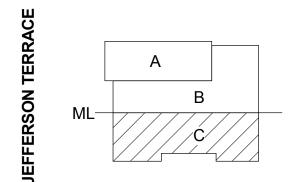

OR SAMUEL MCCREE WAY

DR. SAMUEL MCCREE WAY
KEY PLAN

SED # 26-16-00-01-0-004-024 DWT SED # 26-16-00-01-7-999-020

Rochester Schools Modernization Program
-Phase 2c

George M. Forbes- Renovation, Alterations and Addition

198 Dr Samuel McCree Way, Rochester, NY 14611

REV.#	DESCRIPTION	DATE
1	ADDENDUM 1	04/25/18

JOB NO.	17
SCALE	AS NOTE
ISSUE DATE	4/9/
DRAWN BY	Auth
CHECKED BY	Check

THIS IS A SINGLE SHEET OF A COHESIVE SET OF CONSTRUCTION DOCUMENTS (INCLUDING DRAWINGS AND SPECIFICATIONS). INTERPRETATION OF THE INFORMATION AS PRESENTED SHOULD BE BASED ON THE ENTIRE SET OF DOCUMENTS.

DRAWING TITLE

FIRST FLOOR PLAN -C - LIGHTING

E102.2


#### **DRAWING NOTES:**

- PROVIDE 12 POLE LIGHTING CONTACTOR FOR ZONE 'a' FIXTURES. MOUNT CONTACTOR IN ELECT. ROOM xxx AND CONNECT TO BUILDING MANAGEMENT SYSTEM. PROVIDE 2-\*8, 1-\*8EG, 1"C TO PANELBOARD. CIRCUIT
- PROVIDE 12 POLE LIGHTING CONTACTOR FOR ZONE 'b' FIXTURES. MOUNT CONTACTOR IN ELECT. ROOM xxxx AND CONNECT TO BUILDING MANAGEMENT SYSTEM. PROVIDE 2-\*8, 1-\*8EG, 1"C TO PANELBOARD. CIRCUIT AS NOTED.


#### **GENERAL NOTES:**

- A. REFER TO DRAWING E-000 FOR GENERAL NOTES THAT PERTAIN TO ALL ELECTRICAL DRAWINGS.
- B. REFER TO DRAWING E001 FOR ADDITIONAL INFORMATION ON WORK RELATED TO SITE LIGHTING.
- PROVIDE 277V EMERGENCY POWER LIGHTING BRANCH CIRCUIT(S) AND HOME RUNS FOR EXTERIOR LIGHT FIXTURES SHOWN FROM PANEL HELSPH-1 LOCATED IN PENTHOUSE UNLESS OTHERWISE NOTED. CIRCUIT NUMBER SHALL BE DESIGNATED AS NOTED.
- PROVIDE 277V NORMAL POWER LIGHTING BRANCH CIRCUIT(S) AND HOME RUNS FOR EXTERIOR LIGHT FIXTURES SHOWN FROM PANEL HNLB-1. LOCATED IN ROOM 11A UNLESS OTHERWISE NOTED. CIRCUIT NUMBER SHALL BE DESIGNATED AS NOTED.
- E. ALL LIGHTING BRANCH CIRCUITING SHALL BE 2\*8, 1\*10 EG., 3/4"C UNLESS NOTED OTHERWISE.
- ALL BUILDING NON-EMERGENCY BUILDING MOUNTED SITE LIGHTING SHALL BE CONNECTED THROUGH BUILDING WIDE ENERGY MANAGEMENT SYSTEM (DDC).
- ALL EXTERIOR BUILDING MOUNTED FIXTURES THAT HAVE THE DESIGNATION 'EM' SHALL HAVE AN EMERCENCY PACK



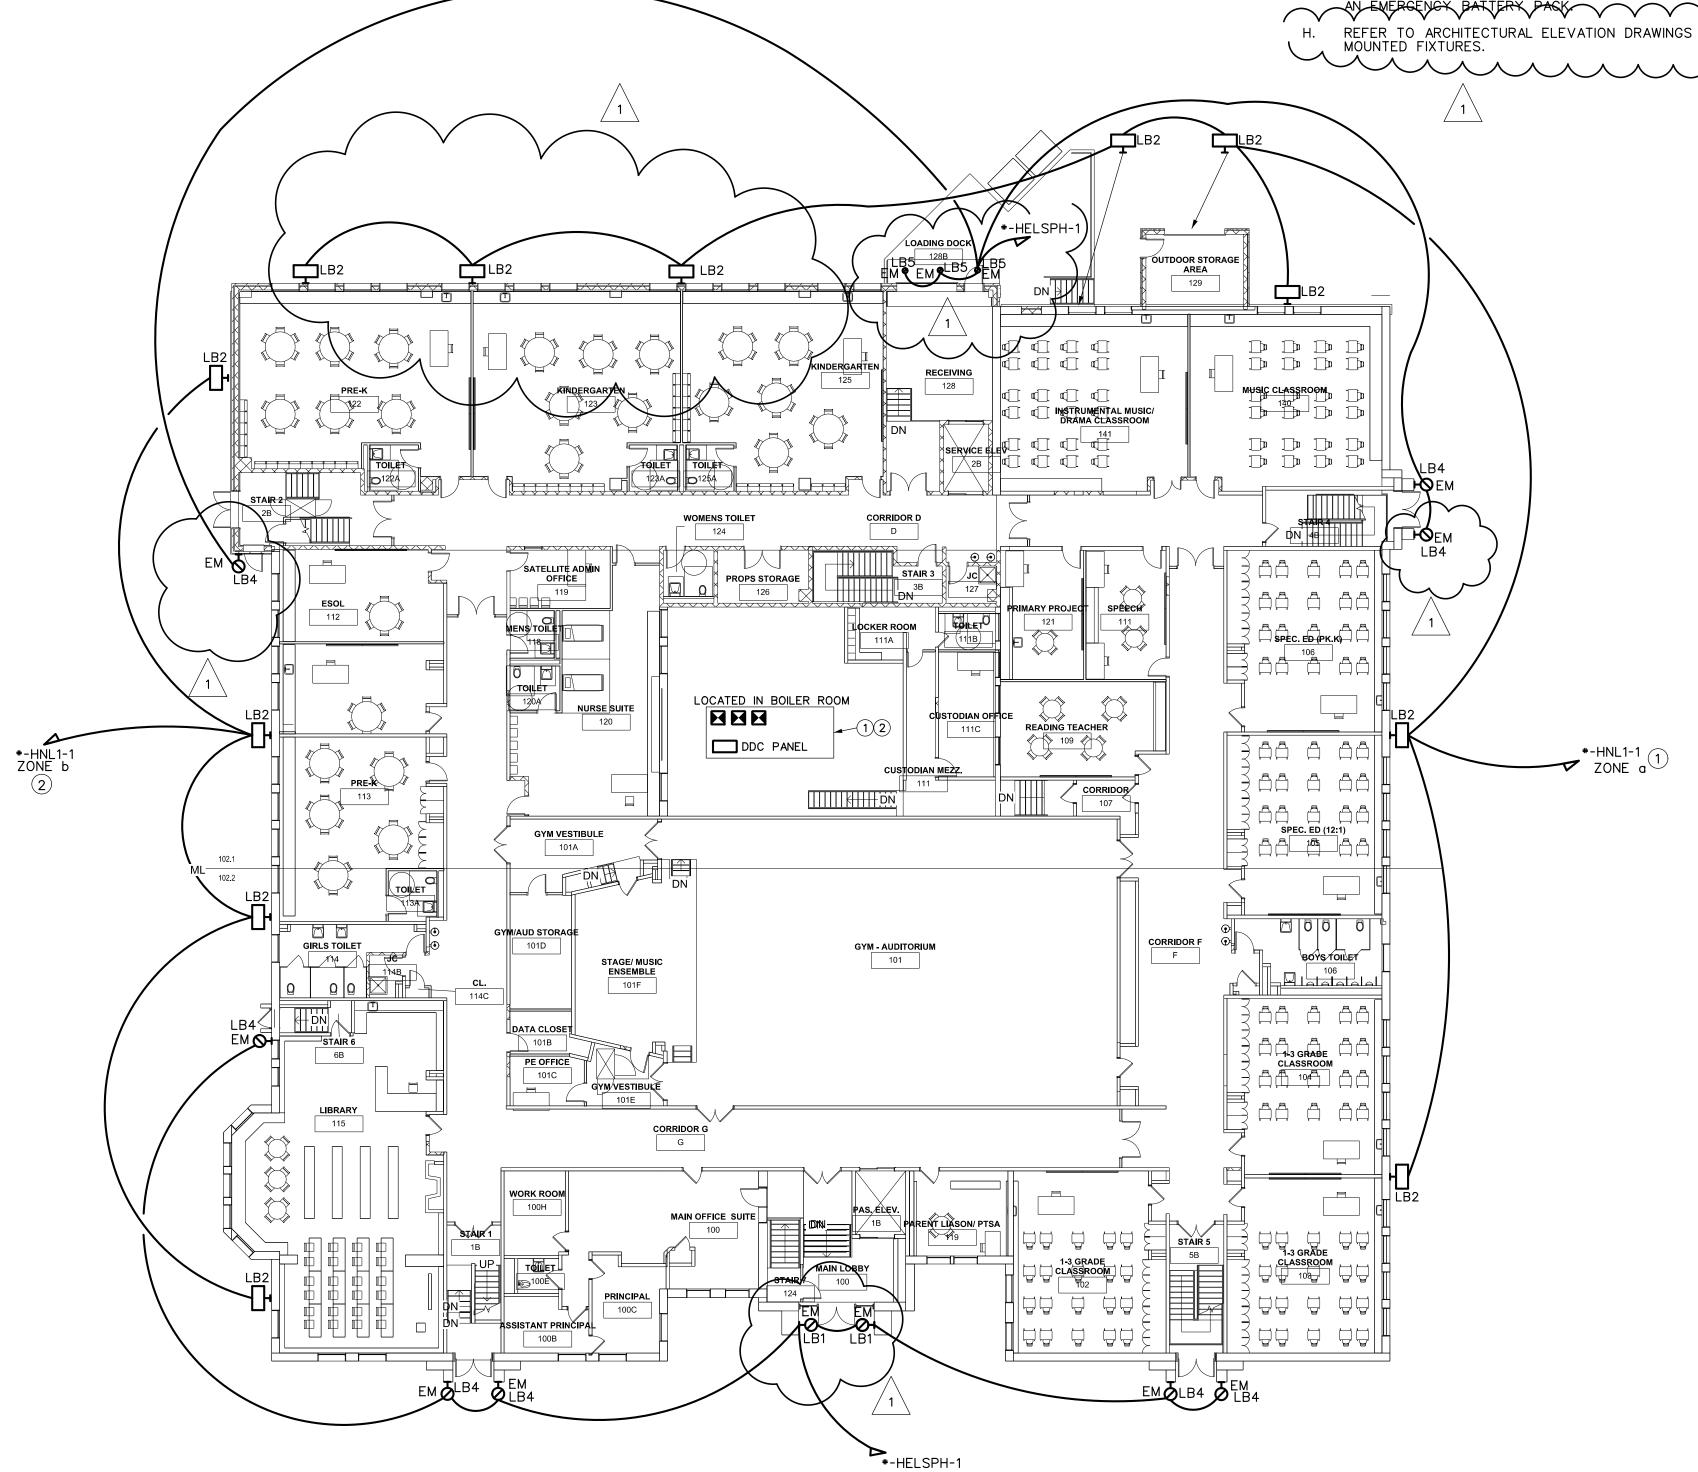



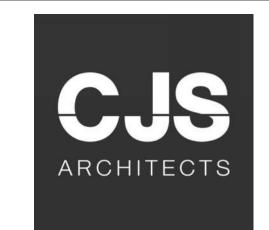

BUFFALO | ROCHESTER www.cjsarchitects.com



**ENGINEERING** 

Mechanical/Electrical Engineering Consultants Rochester | Buffalo | Syracuse | Schenectady



DR. SAMUEL MCCREE WAY

KEY PLAN SED # 26-16-00-01-0-004-024

DWT SED# 26-16-00-01-7-999-020

Rochester Schools Modernization Program -Phase 2c George M. Forbes- Renovation, Alterations and Addition

> 198 Dr Samuel McCree Way, Rochester, NY 14611

REV.# DESCRIPTION DATE 4/25/18 ADDENDUM 1


JOB NO.	17
SCALE	AS NOTE
ISSUE DATE	4/9/1
DRAWN BY	JL
CHECKED BY	DJ

THIS IS A SINGLE SHEET OF A COHESIVE SET OF CONSTRUCTION DOCUMENTS (INCLUDING DRAWINGS AND SPECIFICATIONS). INTERPRETATION OF THE INFORMATION
AS PRESENTED SHOULD BE BASED ON
THE ENTIRE SET OF DOCUMENTS.

DRAWING TITLE

# **BUILDING MOUNTED** LIGHTING

E-002

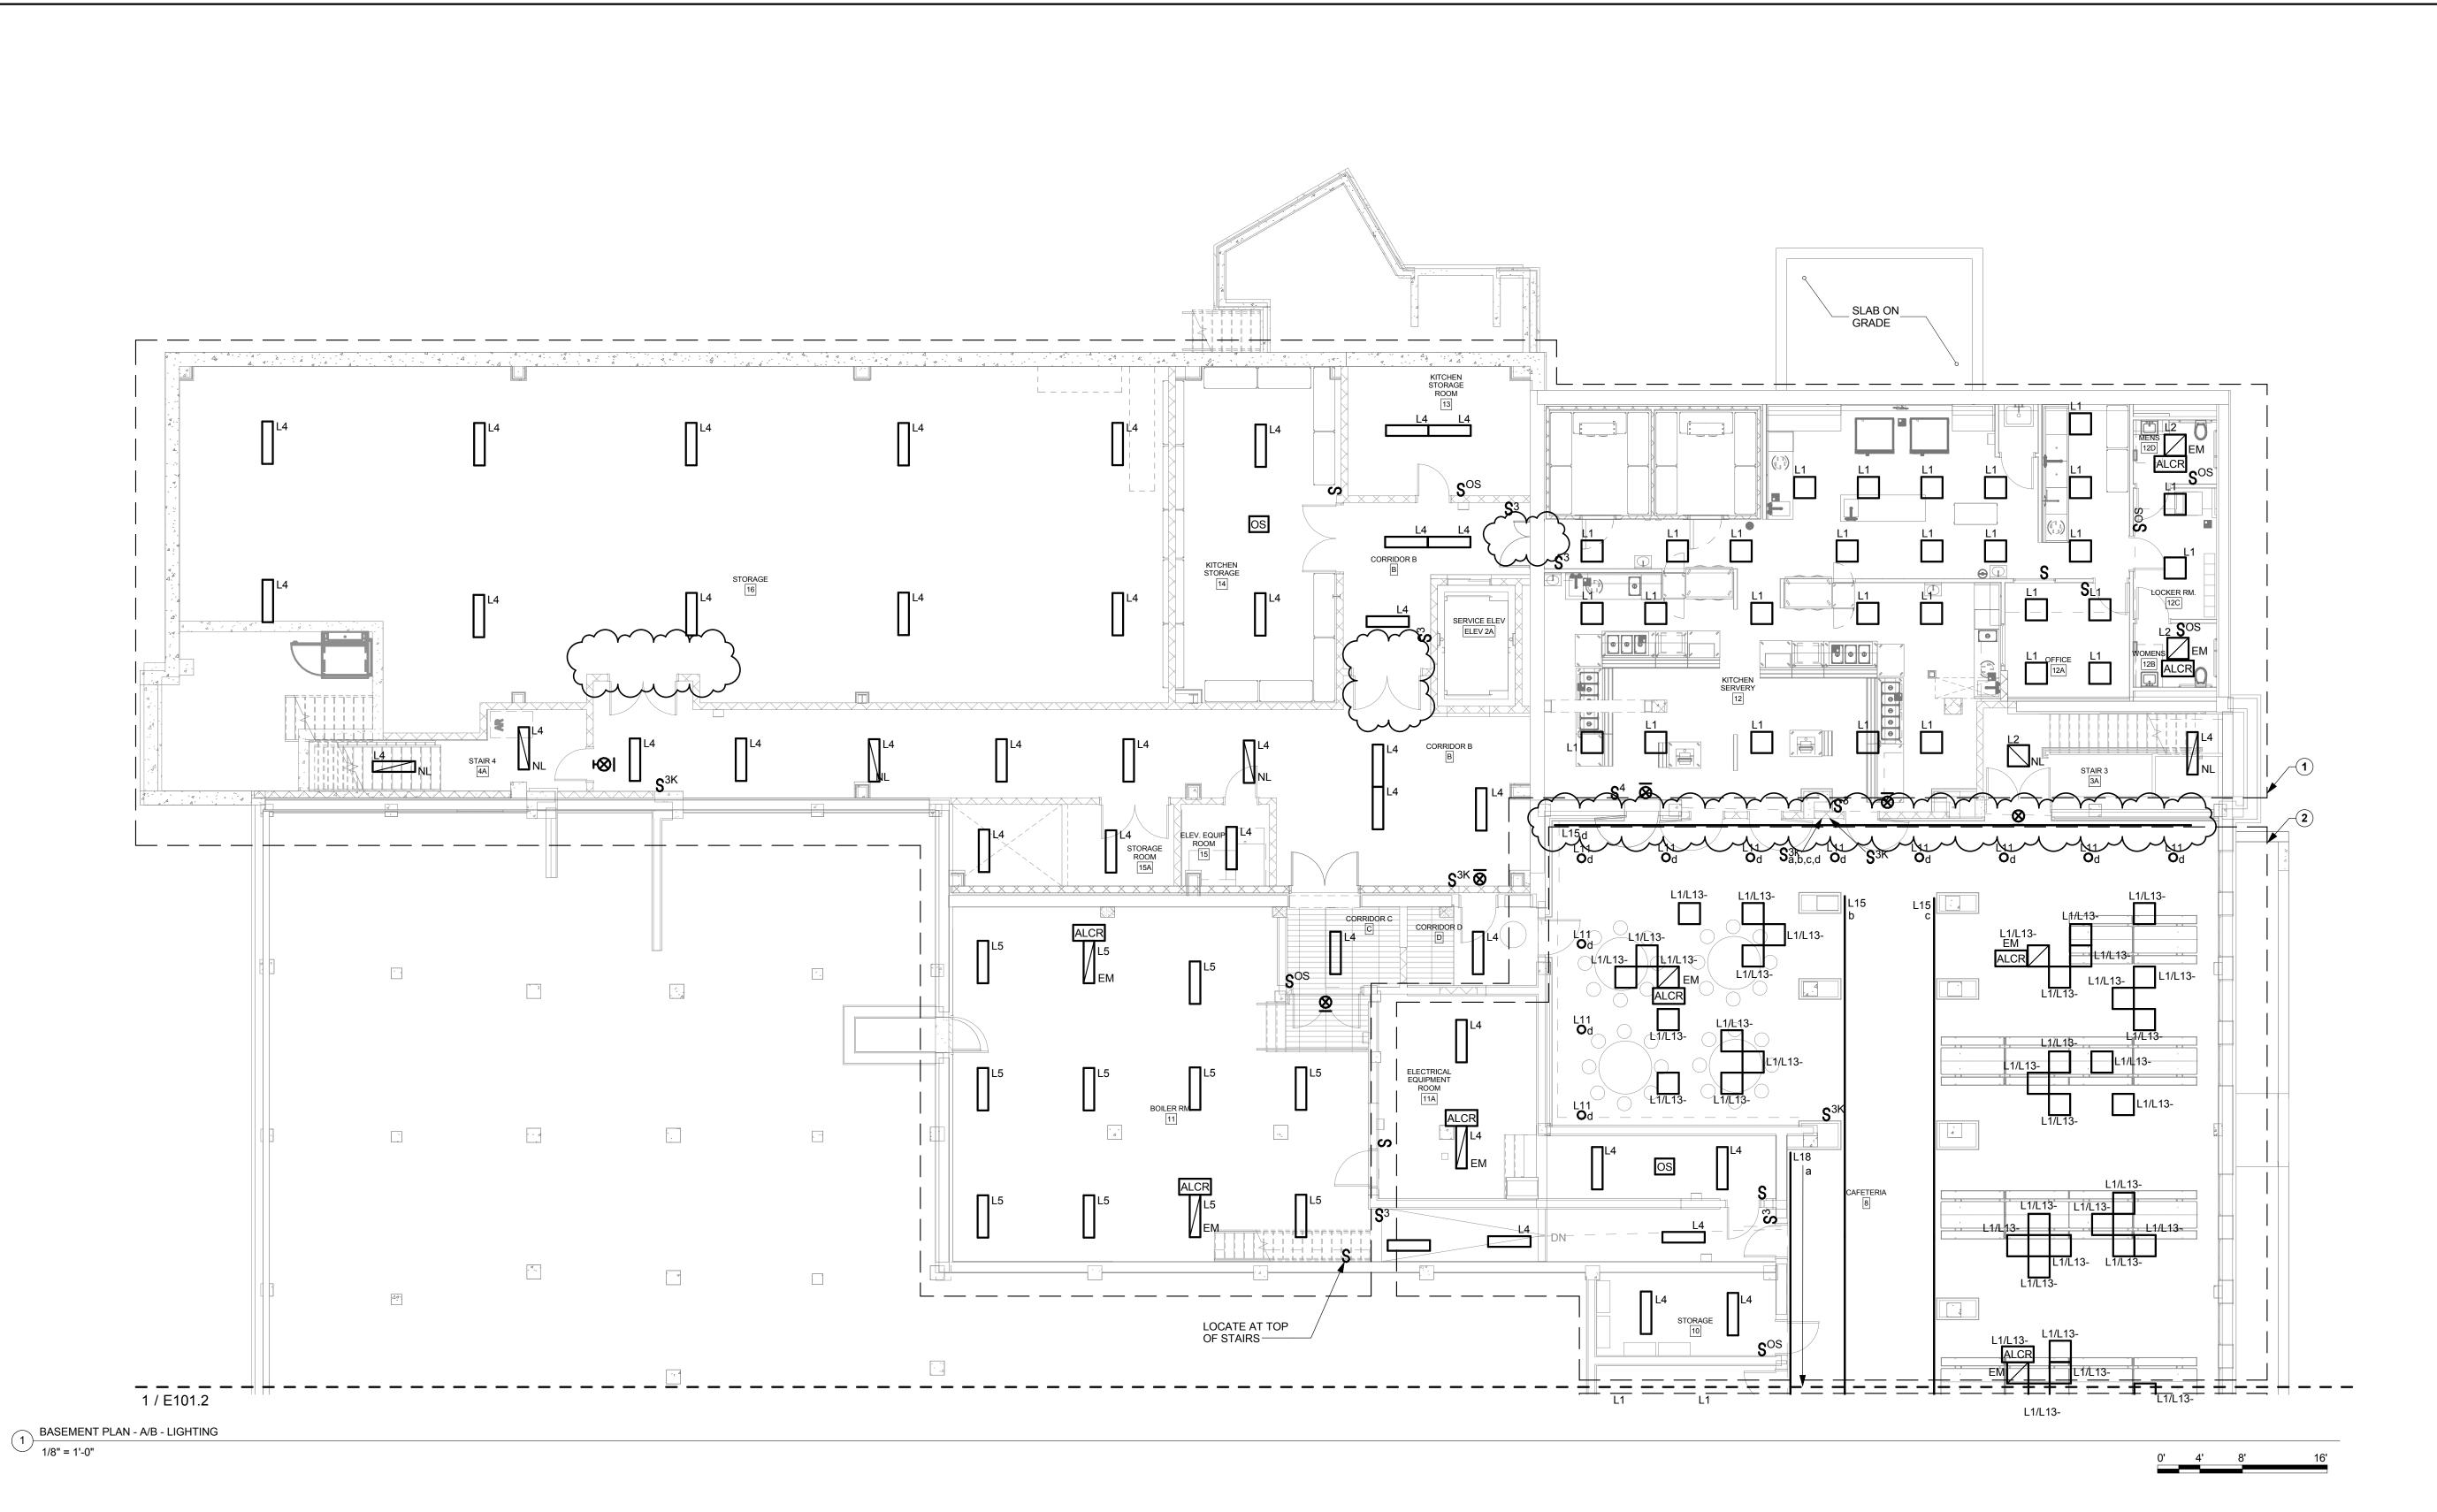

# E101.1 GENERAL NOTES

- A. REFER TO DRAWING E000 FOR GENERAL NOTES THAT PERTAIN TO ALL ELECTRICAL
- B. PROVIDE 277V UNSWITCHED EMERGENCY LIGHTING BRANCH CIRCUIT(S) AND HOME RUNS FOR EXIT LIGHT FIXTURES ON THIS DRAWING FROM PANEL HELSPH-1 LOCATED IN PENTHOUSE UNLESS OTHERWISE NOTED. CIRCUIT NUMBER SHALL BE DESIGNATED AS #14. PROVIDE BRANCH CIRCUIT USING 2-#10, 1-#10EG, 3/4"C
- C. PROVIDE 277V UNSWITCHED EMERGENCY LIGHTING BRANCH CIRCUIT(S) AND HOME RUNS FOR LIGHT FIXTURES DENOTED AS BEING CONNECTED TO AN EMERGENCY LIFE SAFETY CIRCUIT 'NL' ON THIS DRAWING FROM PANEL HELSPH-1 LOCATED IN ROOM PENTHOUSE UNLESS OTHERWISE NOTED. CIRCUIT NUMBER SHALL BE DESIGNATED AS #16. PROVIDE BRANCH CIRCUIT USING 2-#10, 1-#10EG, 3/4"C.
- D. REFER TO POWER & SS DRAWINGS FOR PANELBOARD LOCATIONS.

#### **E101.1 DRAWING NOTES**

- PROVIDE 277V NORMAL POWER LIGHTING BRANCH CIRCUIT(S) AND HOME RUNS FOR LIGHT FIXTURES IN THIS AREA FROM PANEL HNLB-1 LOCATED IN ELECTRICAL ROOM 11A UNLESS OTHERWISE NOTED. CIRCUIT NUMBER SHALL BE DESIGNATED AS #1. PROVIDE BRANCH CIRCUIT USING 2-#10, 1-#10EG, 3/4"C.
- PROVIDE 277V NORMAL POWER LIGHTING BRANCH CIRCUIT(S) AND HOME RUNS FOR LIGHT FIXTURES IN THIS AREA FROM PANEL HNLB-1 LOCATED IN ELECTRICAL ROOM 11A UNLESS OTHERWISE NOTED. CIRCUIT NUMBER SHALL BE DESIGNATED AS #2. PROVIDE BRANCH CIRCUIT USING 2-#10, 1-#10EG, 3/4"C.






Mechanical/Electrical Engineering Consultants
Rochester | Buffalo | Syracuse | Schenectady

150 N. CHESTNUT ST.
ROCHESTER, NY 14604

S85.288.5590
www.meengineering.com

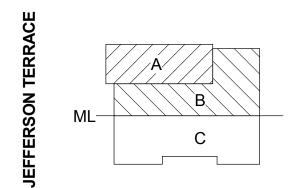

DR. SAMUEL MCCREE WAY

SED # 26-16-00-01-0-004-024 DWT SED #

Rochester Schools Modernization Program

26-16-00-01-7-999-020

-Phase 2c George M. Forbes- Renovation, Alterations and Addition

> 198 Dr Samuel McCree Way, Rochester, NY 14611

REV.#	DESCRIPTION	DATE
1	ADDENDUM 1	04/25/18


JOB NO.	17
SCALE	AS NOTE
ISSUE DATE	4/9/
DRAWN BY	Auth
CHECKED BY	Check

THIS IS A SINGLE SHEET OF A COHESIVE SET OF CONSTRUCTION DOCUMENTS (INCLUDING DRAWINGS AND SPECIFICATIONS). INTERPRETATION OF THE INFORMATION AS PRESENTED SHOULD BE BASED ON THE ENTIRE SET OF DOCUMENTS.

DRAWING TITLE

BASEMENT PLAN -A/B - LIGHTING

E101.1

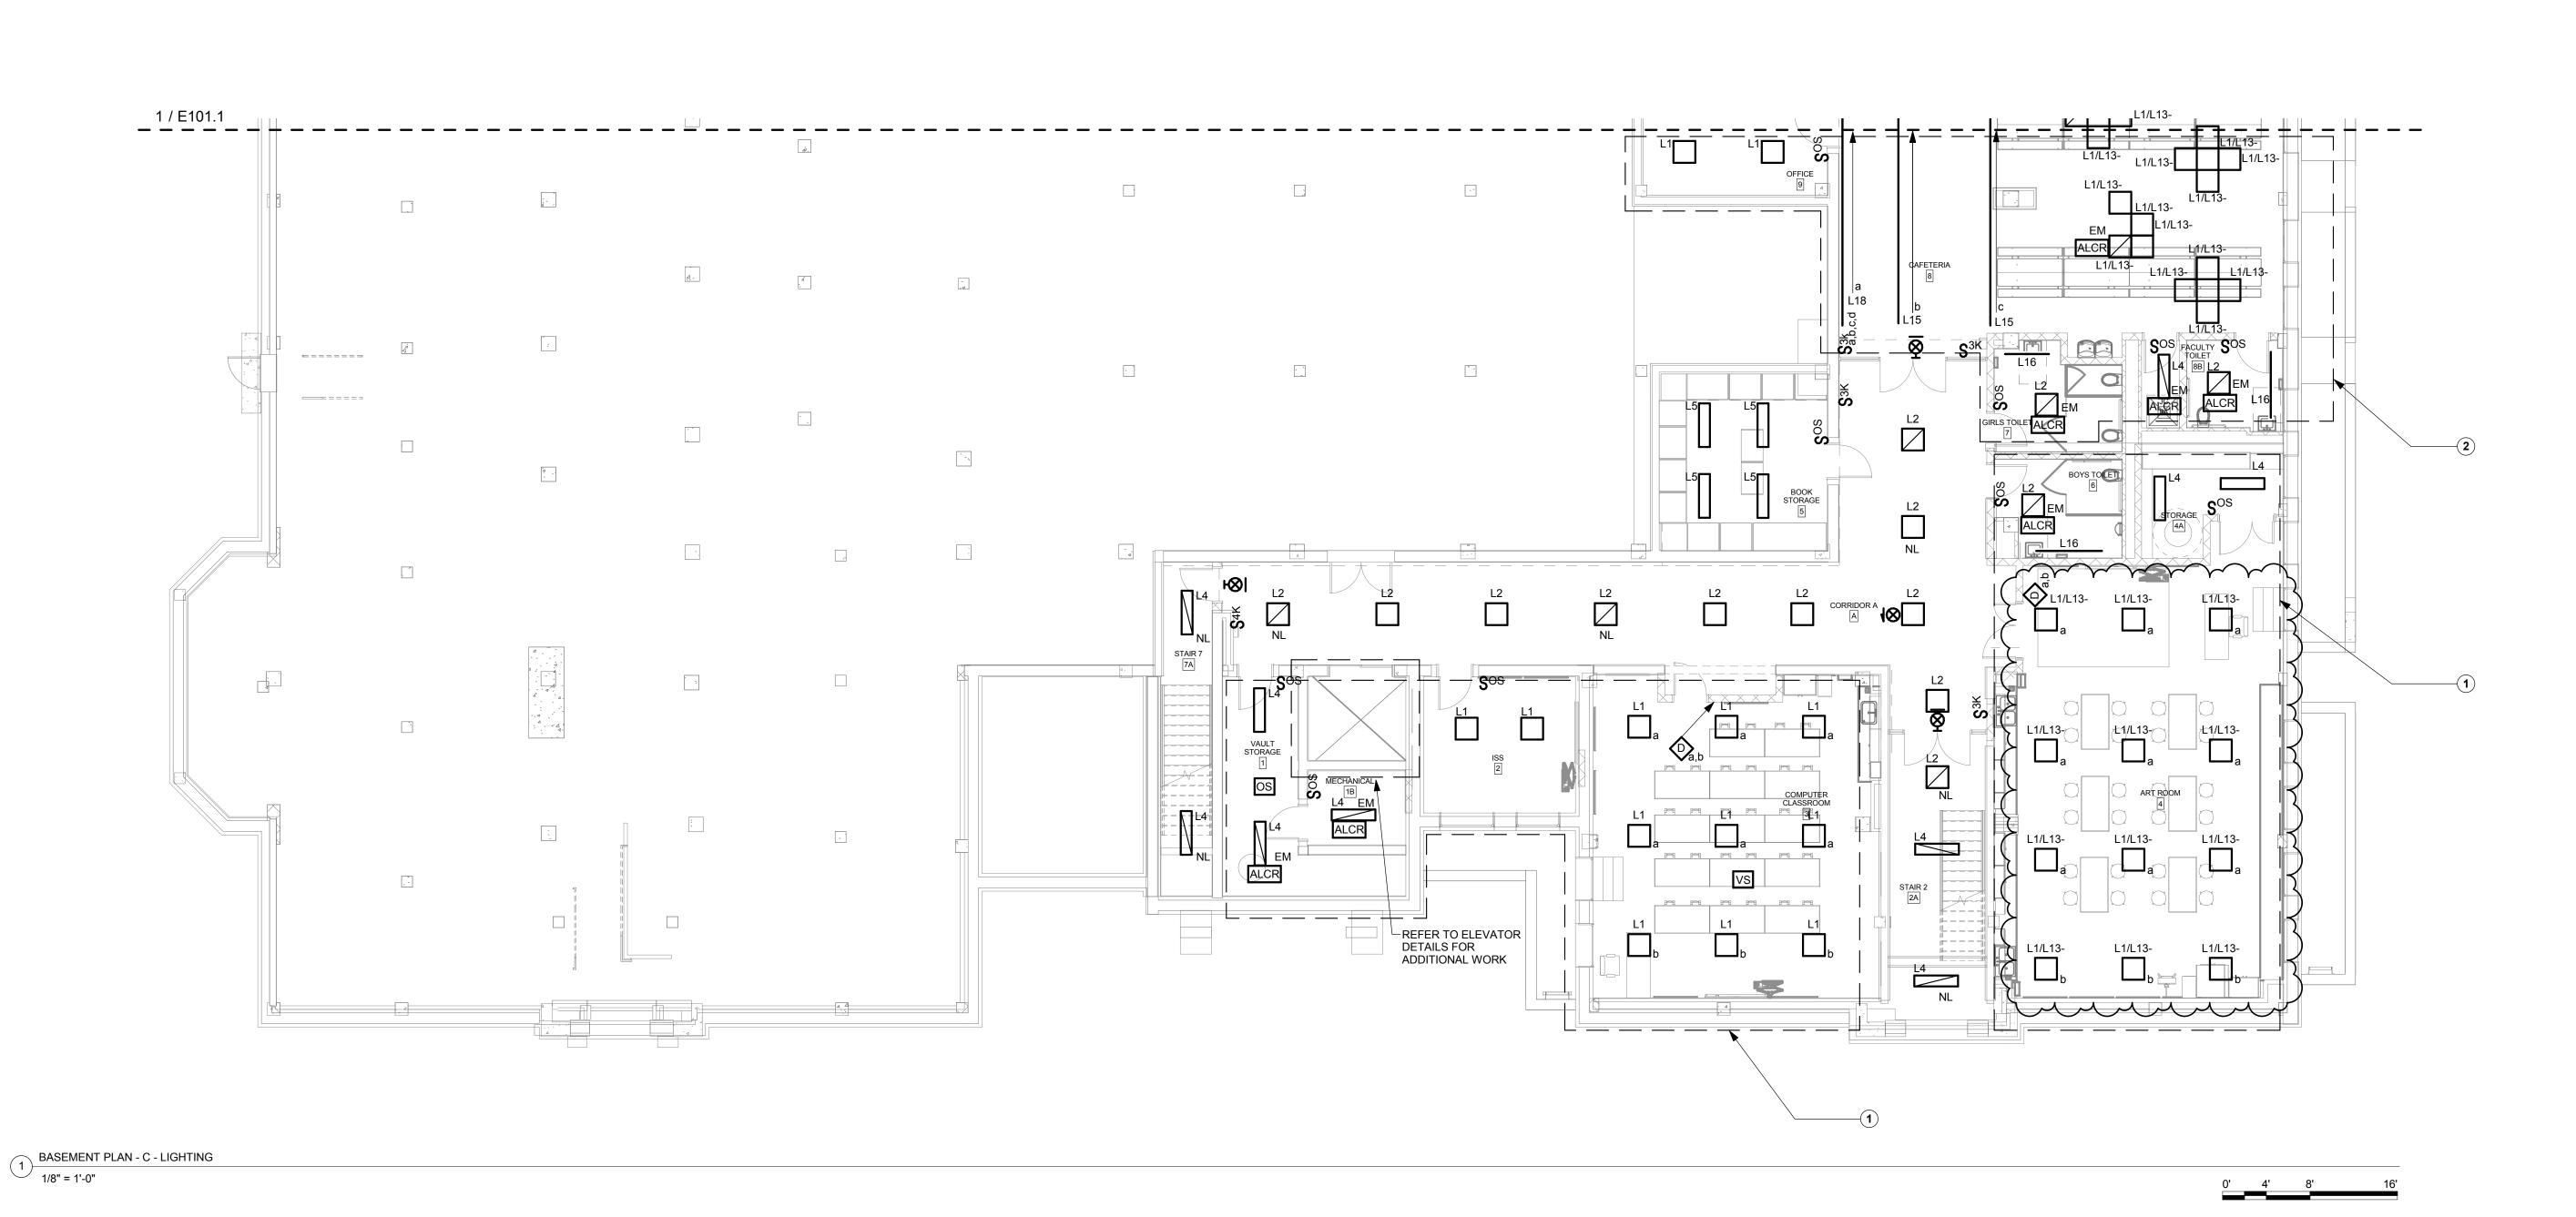

**E101.2 GENERAL NOTES** 

**ELECTRICAL DRAWINGS.** 

BRANCH CIRCUIT USING 2-#10, 1-#10EG, 3/4"C.

E. REFER TO POWER & SS DRAWINGS FOR PANELBOARD LOCATIONS.

REFER TO DRAWING E-000 FOR GENERAL NOTES THAT PERTAIN TO ALL

PROVIDE 277V UNSWITCHED EMERGENCY LIGHTING BRANCH CIRCUIT(S) AND HOME

LOCATED IN PENTHOUSE UNLESS OTHERWISE NOTED. CIRCUIT NUMBER SHALL BE

PROVIDE 277V UNSWITCHED EMERGENCY LIGHTING BRANCH CIRCUIT(S) AND HOME

RUNS FOR LIGHT FIXTURES DENOTED AS BEING CONNECTED TO AN EMERGENCY LIFE SAFETY CIRCUIT 'NL' ON THIS DRAWING FROM PANEL HELSPH-1 LOCATED IN

PROVIDE 277V NORMAL LIGHTING BRANCH CIRCUIT(S) AND HOME RUNS FOR LIGHT FIXTURES IN CORRIDOR FROM PANEL HNLB-1 LOCATED IN ROOM 11A UNLESS OTHERWISE NOTED. CIRCUIT NUMBER SHALL BE DESIGNATED AS #10. PROVIDE

RUNS FOR EXIT LIGHT FIXTURES ON THIS DRAWING FROM PANEL HELSPH-1

DESIGNATED AS #20. PROVIDE BRANCH CIRCUIT USING 2-#10, 1-#10EG, 3/4"C

ROOM PENTHOUSE UNLESS OTHERWISE NOTED. CIRCUIT NUMBER SHALL BE DESIGNATED AS #22. PROVIDE BRANCH CIRCUIT USING 2-#10, 1-#10EG, 3/4"C.

#### **E101.2 DRAWING NOTES**


PROVIDE 277V NORMAL POWER LIGHTING BRANCH CIRCUIT(S) AND HOME RUNS FOR LIGHT FIXTURES IN THIS AREA FROM PANEL HNLB-1 LOCATED IN ELECTRICAL ROOM 11A UNLESS OTHERWISE NOTED. CIRCUIT NUMBER SHALL BE DESIGNATED

- PROVIDE 277V NORMAL POWER LIGHTING BRANCH CIRCUIT(S) AND HOME RUNS FOR LIGHT FIXTURES IN THIS AREA FROM PANEL HNLB-1 LOCATED IN ELECTRICAL ROOM 11A UNLESS OTHERWISE NOTED. CIRCUIT NUMBER SHALL BE DESIGNATED AS #3. PROVIDE BRANCH CIRCUIT USING 2-#10, 1-#10EG, 3/4"C.
- AS #4. PROVIDE BRANCH CIRCUIT USING 2-#10, 1-#10EG, 3/4"C.





**ENGINEERING** Mechanical/Electrical Engineering Consultants Rochester | Buffalo | Syracuse | Schenectady 150 N. CHESTNUT ST. ROCHESTER, NY 14604

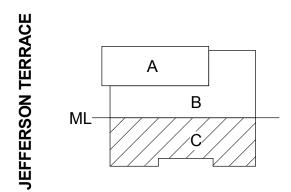

**KEY PLAN** 

DR. SAMUEL MCCREE WAY

SED # 26-16-00-01-0-004-024 DWT SED#

26-16-00-01-7-999-020

Rochester Schools Modernization Program -Phase 2c

George M. Forbes- Renovation, Alterations and Addition

> 198 Dr Samuel McCree Way, Rochester, NY 14611

REV.#	DESCRIPTION	DATE
1	ADDENDUM 1	04/25/1


JOB NO.	17 <sup>-</sup>
SCALE	AS NOTE
ISSUE DATE	4/9/
DRAWN BY	Auth
CHECKED BY	Check
THIS IS A SINGLE SHEET OF A COHESIVE	

THIS IS A SINGLE SHEET OF A COHESIVE SET OF CONSTRUCTION DOCUMENTS (INCLUDING DRAWINGS AND SPECIFICATIONS). INTERPRETATION OF THE INFORMATION AS PRESENTED SHOULD BE BASED ON THE ENTIRE SET OF DOCUMENTS.

DRAWING TITLE

BASEMENT PLAN - C - LIGHTING

E101.2

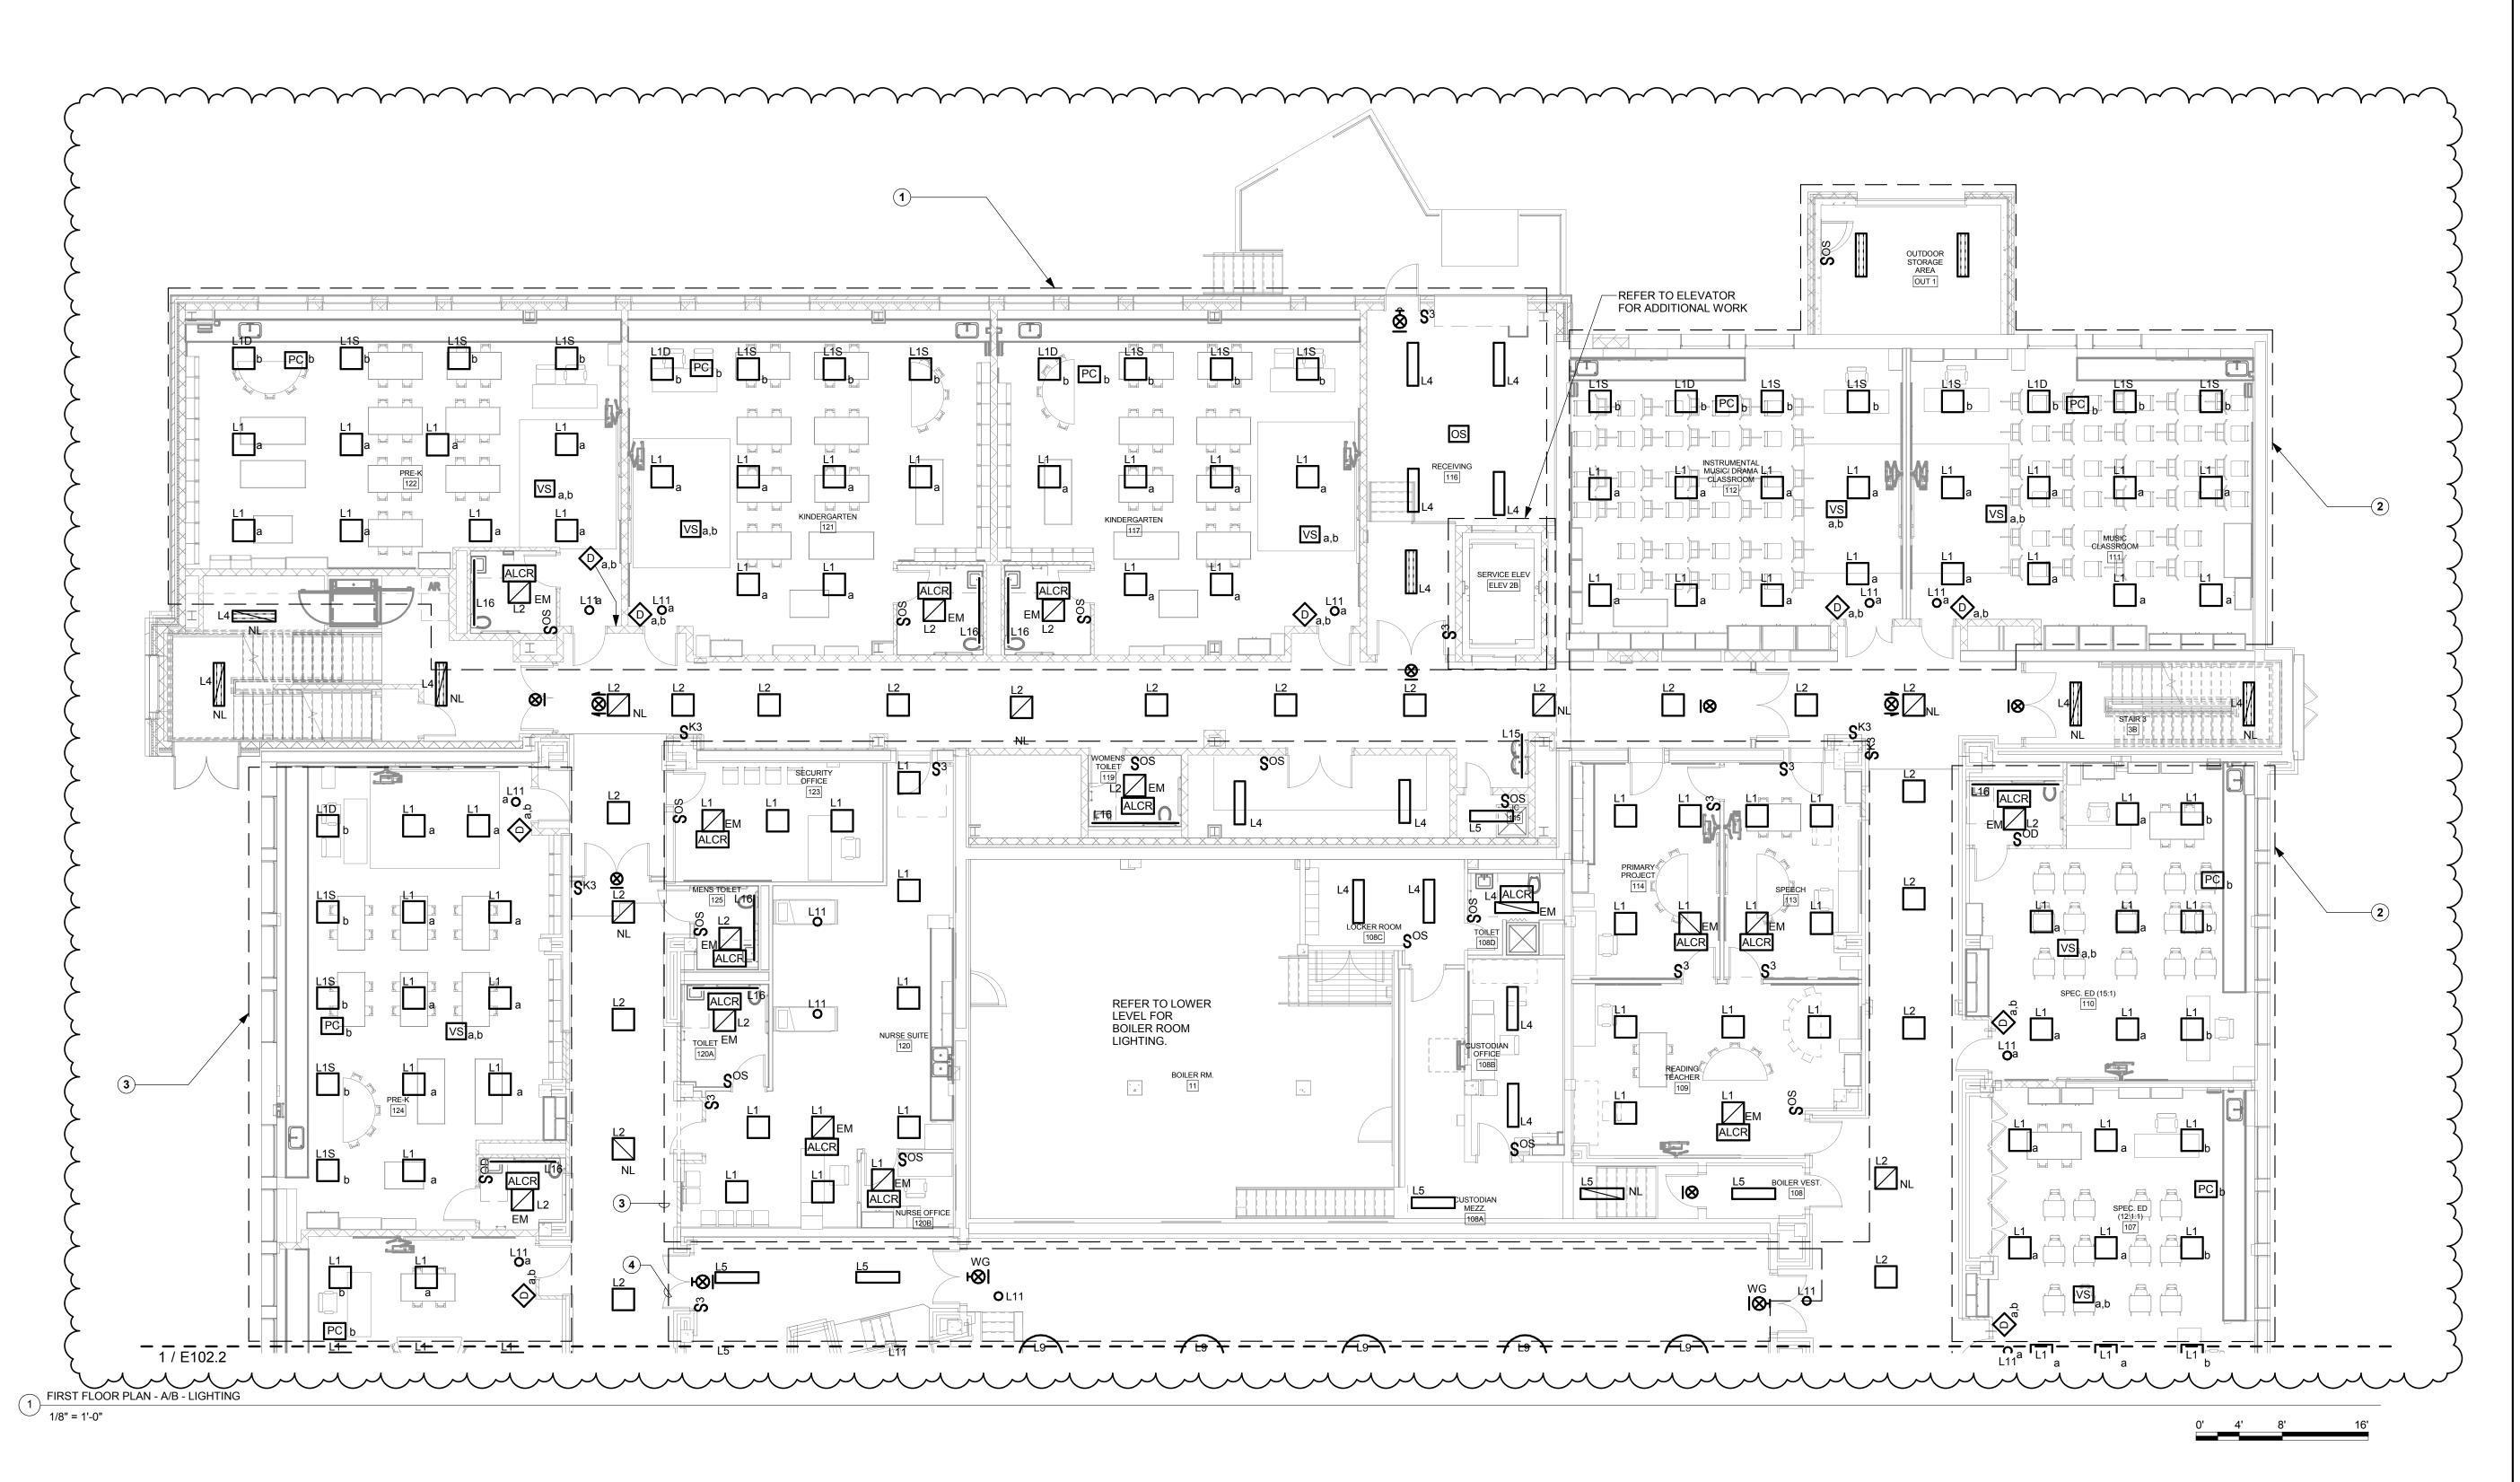

#### **E102.1 GENERAL NOTES**

- A. REFER TO DRAWING E-000 FOR GENERAL NOTES THAT PERTAIN TO ALL ELECTRICAL DRAWINGS.
- PROVIDE 277V UNSWITCHED EMERGENCY LIGHTING BRANCH CIRCUIT(S) AND HOME RUNS FOR EXIT LIGHT FIXTURES ON THIS DRAWING FROM PANEL HELSPH-1 LOCATED IN PENTHOUSE UNLESS OTHERWISE NOTED. CIRCUIT NUMBER SHALL BE
- DESIGNATED AS #1. PROVIDE BRANCH CIRCUIT USING 2-#10, 1-#10EG, 3/4"C.

  PROVIDE 277V UNSWITCHED EMERGENCY LIGHTING BRANCH CIRCUIT(S) AND HOME RUNS FOR LIGHT FIXTURES DENOTED AS BEING CONNECTED TO AN EMERGENCY LIFE SAFETY CIRCUIT 'NL' ON THIS DRAWING FROM PANEL HELSPH-1 LOCATED IN PENTHOUSE UNLESS OTHERWISE NOTED. CIRCUIT NUMBER SHALL BE DESIGNATED AS #3. PROVIDE BRANCH CIRCUIT USING 2-#10, 1-#10EG, 3/4"C.
- PROVIDE 277V NORMAL LIGHTING BRANCH CIRCUIT(S) AND HOME RUNS FOR LIGHT FIXTURES IN CORRIDOR FROM PANEL HNL1-1 LOCATED IN MEZZ. 111 UNLESS OTHERWISE NOTED. CIRCUIT NUMBER SHALL BE DESIGNATED AS #1. PROVIDE BRANCH CIRCUIT USING 2-#10, 1-#10EG, 3/4"C.
- PROVIDE 277V UNSWITCHED EMERGENCY LIGHTING BRANCH CIRCUIT(S) AND HOME RUNS FOR LIGHT FIXTURES DENOTED AS BEING CONNECTED TO AN EMERGENCY LIFE SAFETY CIRCUIT 'EM' ON THIS DRAWING FROM PANEL HELSPH-1 LOCATED IN PENTHOUSE UNLESS OTHERWISE NOTED. CIRCUIT NUMBER SHALL BE DESIGNATED AS #5. PROVIDE BRANCH CIRCUIT USING 2-#10, 1-#10EG, 3/4"C.
- F. REFER TO POWER & SS DRAWINGS FOR PANELBOARD LOCATIONS.

#### **E102.1 DRAWING NOTES**

- PROVIDE 277V NORMAL POWER LIGHTING BRANCH CIRCUIT(S) AND HOME RUNS FOR LIGHT FIXTURES IN THIS AREA FROM PANEL HNL1-1 LOCATED IN MEZZ. 111 UNLESS OTHERWISE NOTED. CIRCUIT NUMBER SHALL BE DESIGNATED AS #3. PROVIDE BRANCH CIRCUIT USING 2-#10, 1-#10EG, 3/4"C.
- PROVIDE 277V NORMAL POWER LIGHTING BRANCH CIRCUIT(S) AND HOME RUNS FOR LIGHT FIXTURES IN THIS AREA FROM PANEL HNL1-1 LOCATED IN MEZZ. 111 UNLESS OTHERWISE NOTED. CIRCUIT NUMBER SHALL BE DESIGNATED AS #5. PROVIDE BRANCH CIRCUIT USING 2-#10, 1-#10EG, 3/4"C.
- PROVIDE 277V NORMAL POWER LIGHTING BRANCH CIRCUIT(S) AND HOME RUNS FOR LIGHT FIXTURES IN THIS AREA FROM PANEL HNL1-1 LOCATED IN MEZZ. 111 UNLESS OTHERWISE NOTED. CIRCUIT NUMBER SHALL BE DESIGNATED AS #7. PROVIDE BRANCH CIRCUIT USING 2-#10, 1-#10EG, 3/4"C.
- PROVIDE 277V NORMAL POWER LIGHTING BRANCH CIRCUIT(S) AND HOME RUNS FOR LIGHT FIXTURES IN THIS AREA FROM PANEL HNL1-1 LOCATED IN MEZZ. 111 UNLESS OTHERWISE NOTED. CIRCUIT NUMBER SHALL BE DESIGNATED AS #9. PROVIDE BRANCH CIRCUIT USING 2-#10, 1-#10EG, 3/4"C.






www.cjsarchitects.com

ME ENGINEERING

Rochester | Buffalo | Syracuse | Schenectady

150 N. CHESTNUT ST. 585.288.55
ROCHESTER, NY 14604 www.meengineering.cc

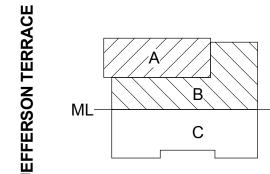

DR. SAMUEL MCCREE WAY

SED # 26-16-00-01-0-004-024

Rochester Schools Modernization Program
-Phase 2c
George M. Forbes- Renovation, Alterations

and Addition

DWT SED#

26-16-00-01-7-999-020

198 Dr Samuel McCree Way, Rochester, NY 14611

REV.#	DESCRIPTION	DATE
1	ADDENDUM 1	04/25/18
-		


JOB NO.	1711
SCALE	AS NOTED
ISSUE DATE	4/9/18
DRAWN BY	Author
CHECKED BY	Checker

THIS IS A SINGLE SHEET OF A COHESIVE SET OF CONSTRUCTION DOCUMENTS (INCLUDING DRAWINGS AND SPECIFICATIONS). INTERPRETATION OF THE INFORMATION AS PRESENTED SHOULD BE BASED ON THE ENTIRE SET OF DOCUMENTS.

DRAWING TITLE

FIRST FLOOR PLAN -A/B - LIGHTING

E102.1

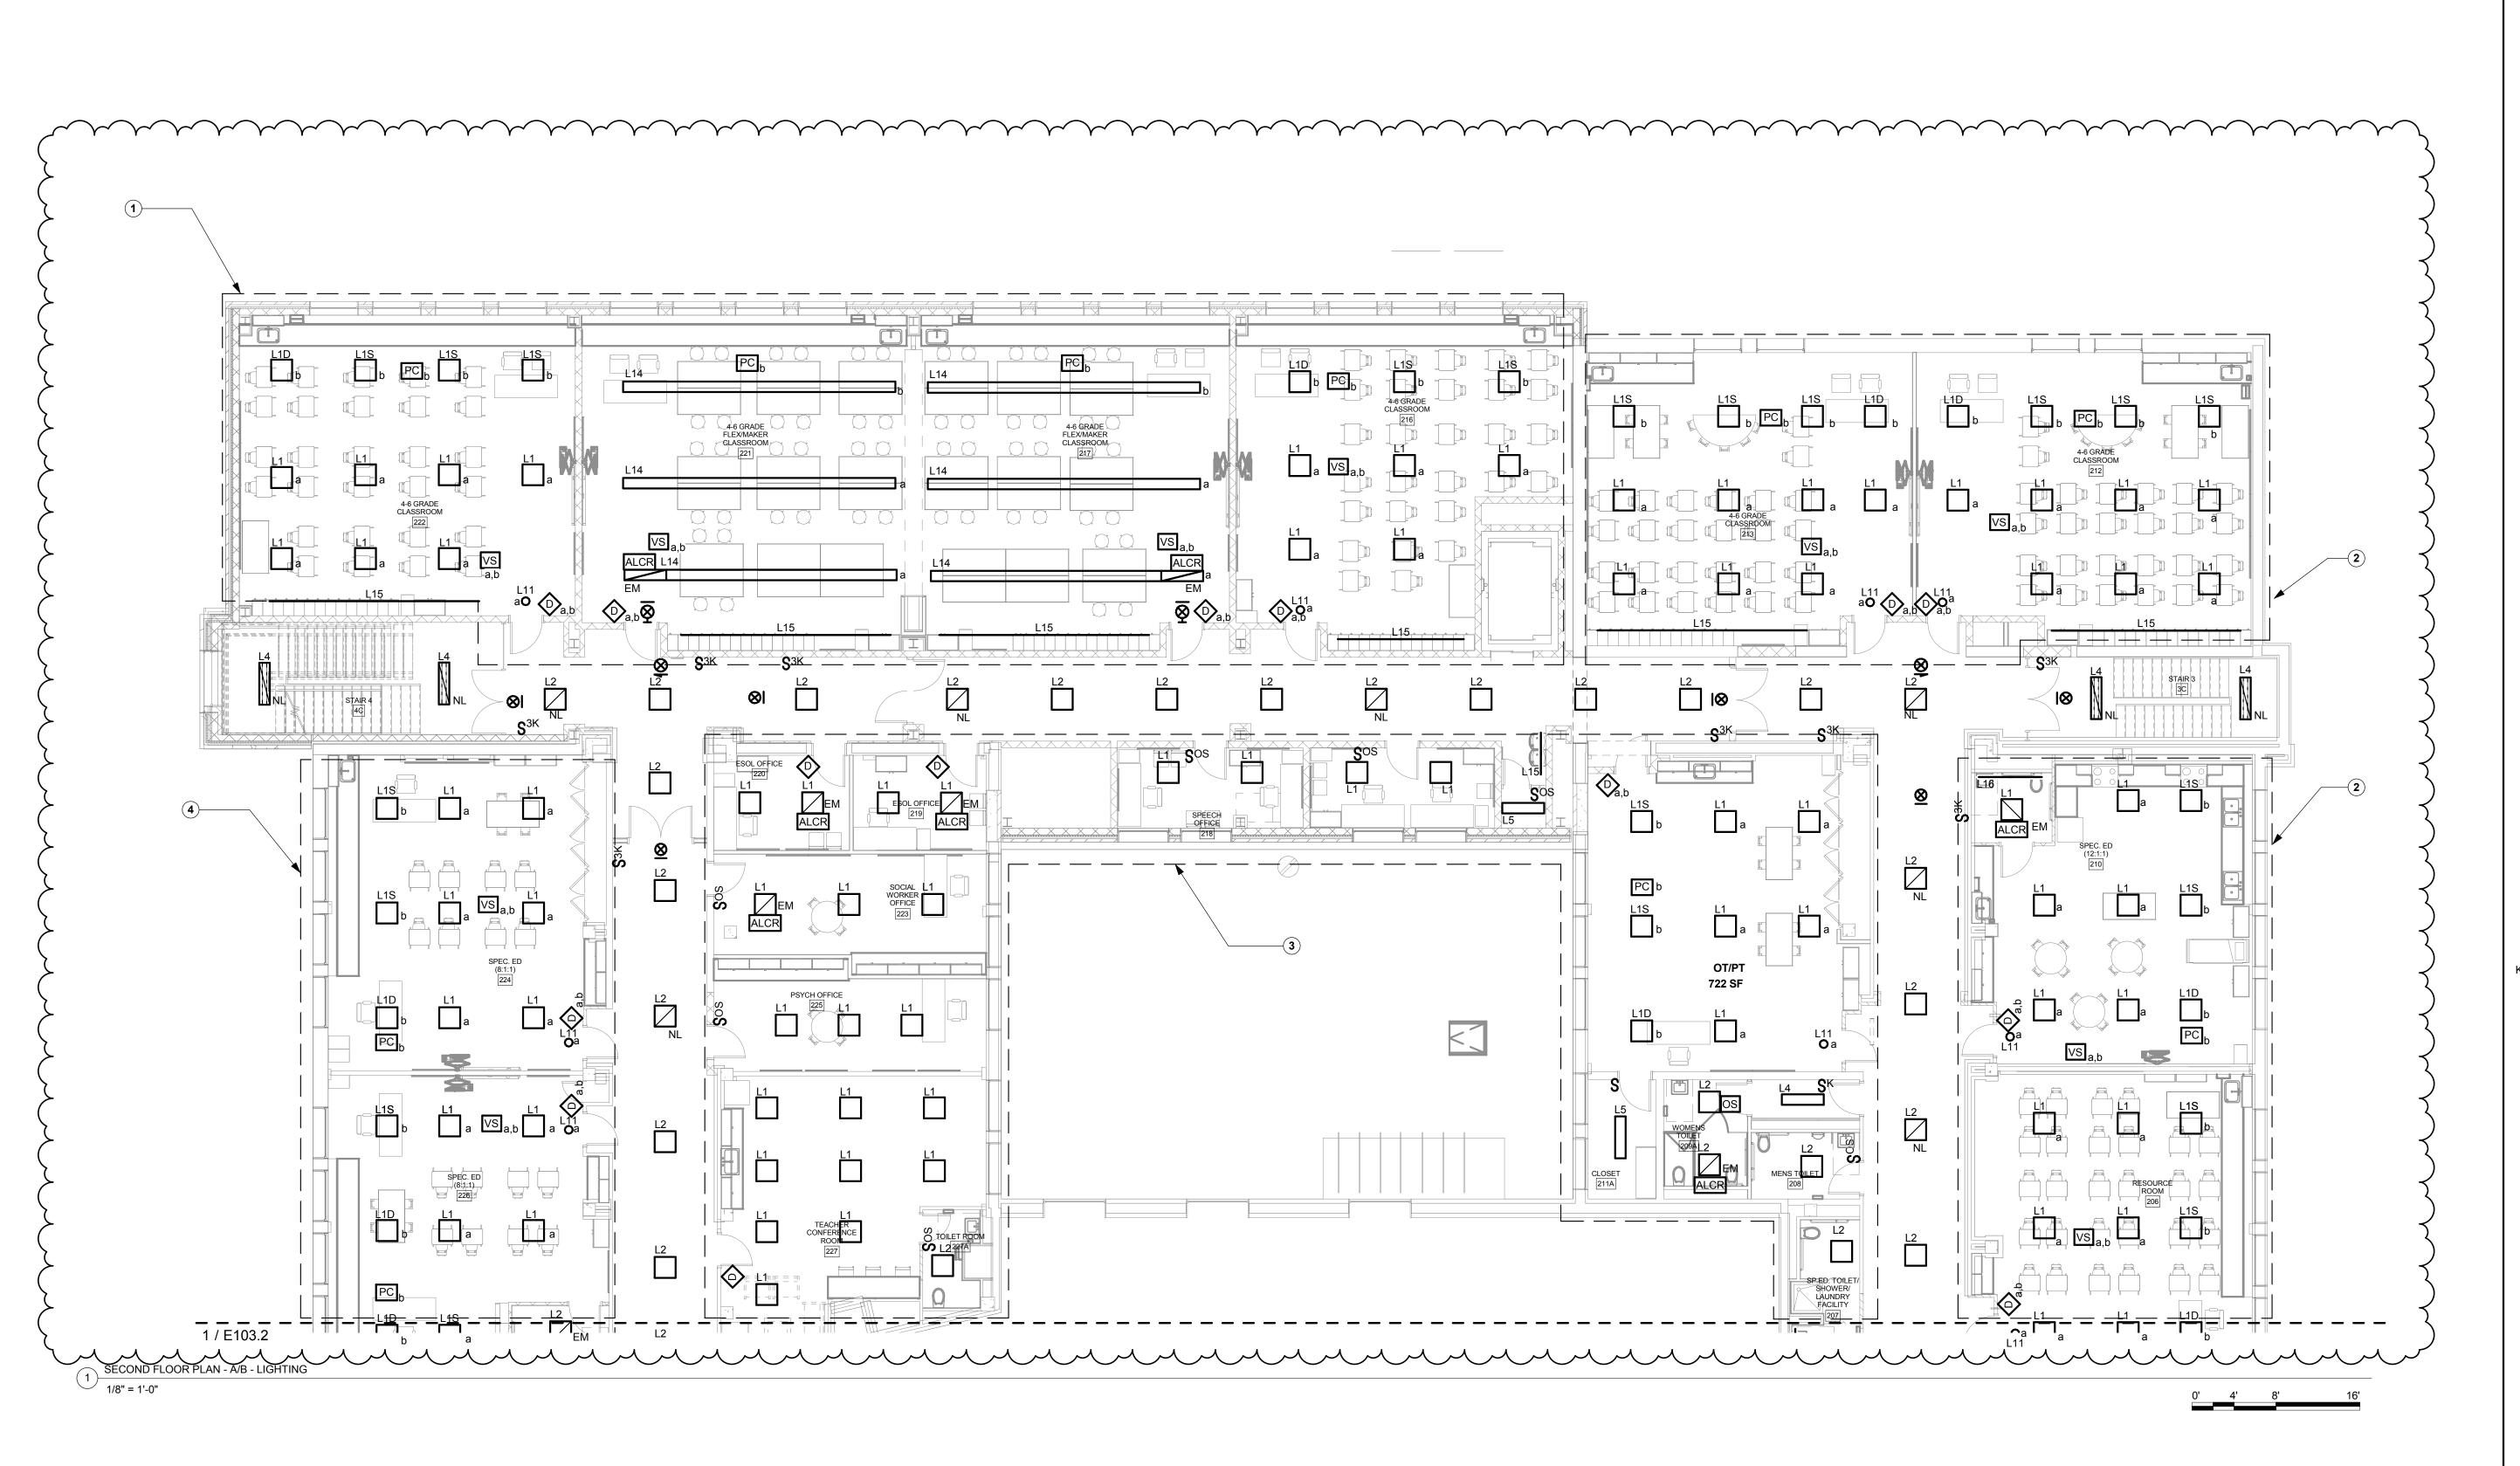

## **E103.1 GENERAL NOTES**

- REFER TO DRAWING E-000 FOR GENERAL NOTES THAT PERTAIN TO ALL
- **ELECTRICAL DRAWINGS.** PROVIDE 277V UNSWITCHED EMERGENCY LIGHTING BRANCH CIRCUIT(S) AND HOME
- RUNS FOR EXIT LIGHT FIXTURES ON THIS DRAWING FROM PANEL HELSPH-1 LOCATED IN PENTHOUSE UNLESS OTHERWISE NOTED. CIRCUIT NUMBER SHALL BE DESIGNATED AS #2. PROVIDE BRANCH CIRCUIT USING 2-#10, 1-#10EG, 3/4"C. PROVIDE 277V UNSWITCHED EMERGENCY LIGHTING BRANCH CIRCUIT(S) AND HOME
- RUNS FOR LIGHT FIXTURES DENOTED AS BEING CONNECTED TO AN EMERGENCY LIFE SAFETY CIRCUIT 'NL' ON THIS DRAWING FROM PANEL HELSPH-1 LOCATED IN PENTHOUSE UNLESS OTHERWISE NOTED. CIRCUIT NUMBER SHALL BE DESIGNATED AS #4. PROVIDE BRANCH CIRCUIT USING 2-#10, 1-#10EG, 3/4"C.
- PROVIDE 277V NORMAL LIGHTING BRANCH CIRCUIT(S) AND HOME RUNS FOR LIGHT FIXTURES IN CORRIDOR FROM PANEL HNL2-1 LOCATED IN ROOM 9C UNLESS OTHERWISE NOTED. CIRCUIT NUMBER SHALL BE DESIGNATED AS #1. PROVIDE **BRANCH CIRCUIT USING 2-#10, 1-#10EG, 3/4"C.**
- PROVIDE 277V UNSWITCHED EMERGENCY LIGHTING BRANCH CIRCUIT(S) AND HOME RUNS FOR LIGHT FIXTURES DENOTED AS BEING CONNECTED TO AN EMERGENCY LIFE SAFETY CIRCUIT 'EM' ON THIS DRAWING FROM PANEL HELSPH-1 LOCATED IN PENTHOUSE UNLESS OTHERWISE NOTED. CIRCUIT NUMBER SHALL BE DESIGNATED AS #6. PROVIDE BRANCH CIRCUIT USING 2-#10, 1-#10EG, 3/4"C.
- REFER TO POWER & SS DRAWINGS FOR PANELBOARD LOCATIONS.


## **E103.1 DRAWING NOTES**

- PROVIDE 277V NORMAL POWER LIGHTING BRANCH CIRCUIT(S) AND HOME RUNS FOR LIGHT FIXTURES IN THIS AREA FROM PANEL HNL2-1 LOCATED IN ELECTRICAL ROOM 9C UNLESS OTHERWISE NOTED. CIRCUIT NUMBER SHALL BE DESIGNATED AS
- #3. PROVIDE BRANCH CIRCUIT USING 2-#10, 1-#10EG, 3/4"C. PROVIDE 277V NORMAL POWER LIGHTING BRANCH CIRCUIT(S) AND HOME RUNS FOR LIGHT FIXTURES IN THIS AREA FROM PANEL HNL2-1 LOCATED IN ELECTRICAL ROOM 9C UNLESS OTHERWISE NOTED. CIRCUIT NUMBER SHALL BE DESIGNATED AS
- #5. PROVIDE BRANCH CIRCUIT USING 2-#10, 1-#10EG, 3/4"C. PROVIDE 277V NORMAL POWER LIGHTING BRANCH CIRCUIT(S) AND HOME RUNS FOR LIGHT FIXTURES IN THIS AREA FROM PANEL HNL2-1 LOCATED IN ELECTRICAL ROOM 9C UNLESS OTHERWISE NOTED. CIRCUIT NUMBER SHALL BE DESIGNATED AS #7. PROVIDE BRANCH CIRCUIT USING 2-#10, 1-#10EG, 3/4"C.
- PROVIDE 277V NORMAL POWER LIGHTING BRANCH CIRCUIT(S) AND HOME RUNS FOR LIGHT FIXTURES IN THIS AREA FROM PANEL HNL2-1 LOCATED IN ELECTRICAL ROOM 9C UNLESS OTHERWISE NOTED. CIRCUIT NUMBER SHALL BE DESIGNATED AS #9. PROVIDE BRANCH CIRCUIT USING 2-#10, 1-#10EG, 3/4"C.





Mechanical/Electrical Engineering Consultants

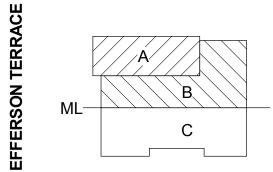

DR. SAMUEL MCCREE WAY

KEY PLAN SED # 26-16-00-01-0-004-024

26-16-00-01-7-999-020 Rochester Schools Modernization Program

DWT SED#

-Phase 2c George M. Forbes- Renovation, Alterations and Addition

> 198 Dr Samuel McCree Way, Rochester, NY 14611

REV.#	DESCRIPTION	DATE
1	ADDENDUM 1	04/25/18


JOB NO.	17′
SCALE	AS NOTE
ISSUE DATE	4/9/
DRAWN BY	Auth
CHECKED BY	Check

THIS IS A SINGLE SHEET OF A COHESIVE SET OF CONSTRUCTION DOCUMENTS (INCLUDING DRAWINGS AND SPECIFICATIONS). INTERPRETATION OF THE INFORMATION AS PRESENTED SHOULD BE BASED ON THE ENTIRE SET OF DOCUMENTS.

DRAWING TITLE

SECOND FLOOR PLAN - A/B -LIGHTING

E103.1

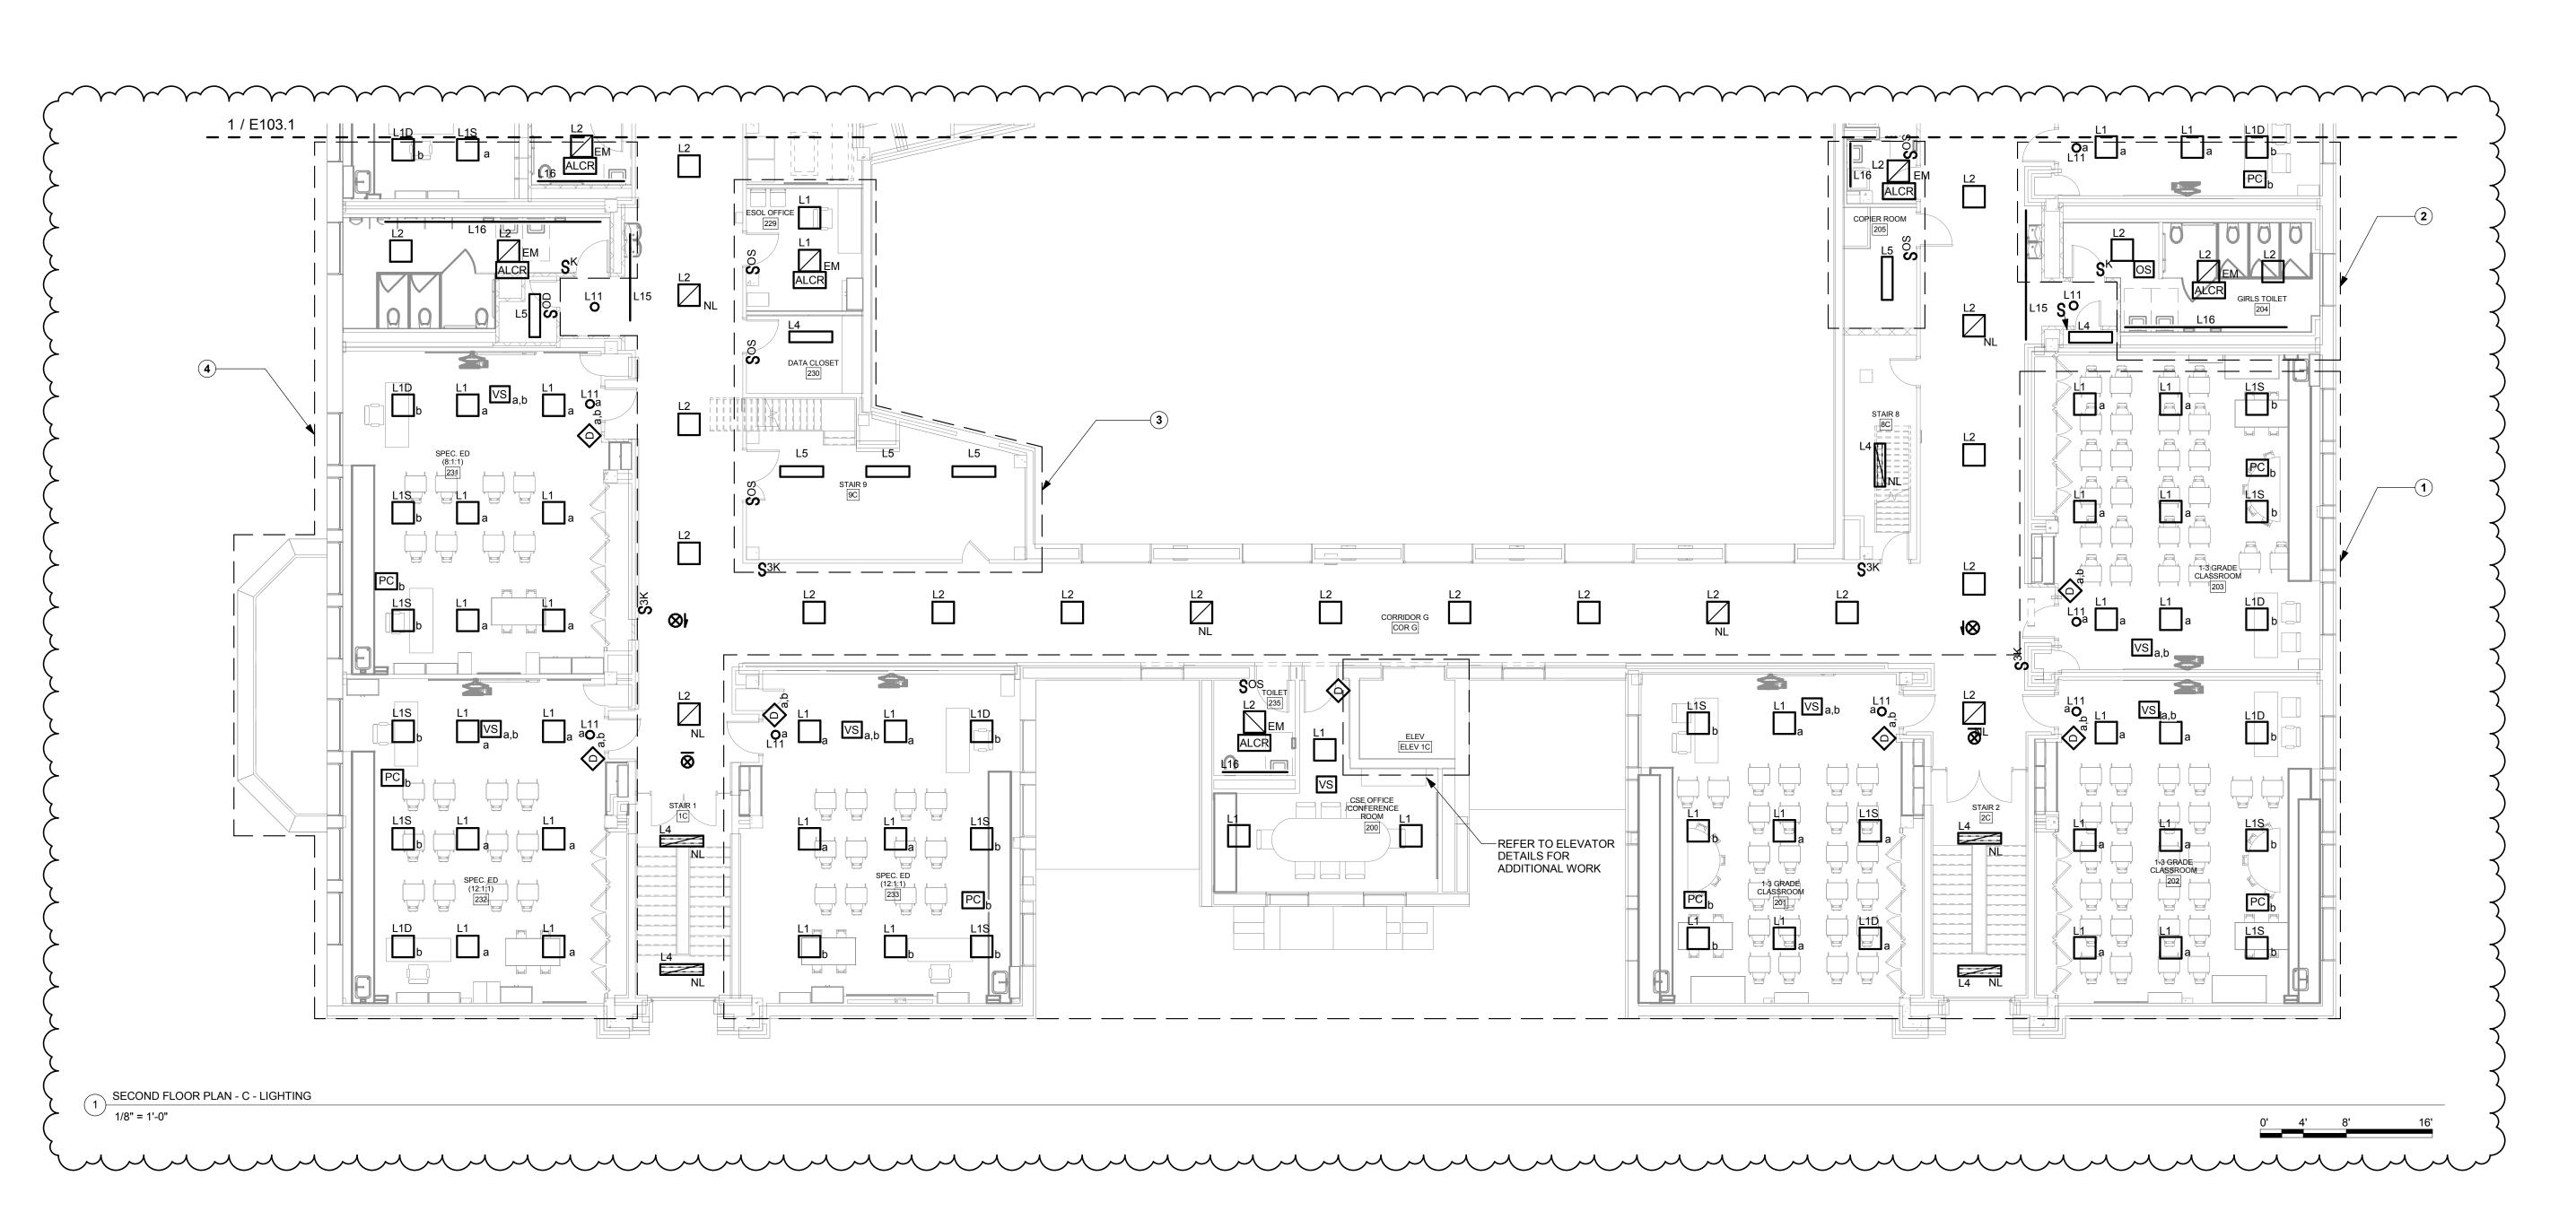

#### **E103.2 GENERAL NOTES**

- A. REFER TO DRAWING E-000 FOR GENERAL NOTES THAT PERTAIN TO ALL ELECTRICAL DRAWINGS.
- B. PROVIDE 277V UNSWITCHED EMERGENCY LIGHTING BRANCH CIRCUIT(S) AND HOME RUNS FOR EXIT LIGHT FIXTURES ON THIS DRAWING FROM PANEL HELSPH-1 LOCATED IN PENTHOUSE UNLESS OTHERWISE NOTED. CIRCUIT NUMBER SHALL BE DESIGNATED AS #8. PROVIDE BRANCH CIRCUIT USING 2-#10, 1-#10EG, 3/4"C.
- PROVIDE 277V UNSWITCHED EMERGENCY LIGHTING BRANCH CIRCUIT(S) AND HOME RUNS FOR LIGHT FIXTURES DENOTED AS BEING CONNECTED TO AN EMERGENCY LIFE SAFETY CIRCUIT 'NL' ON THIS DRAWING FROM PANEL HELSPH-1 LOCATED IN PENTHOUSE UNLESS OTHERWISE NOTED. CIRCUIT NUMBER SHALL BE DESIGNATED AS #10. PROVIDE BRANCH CIRCUIT USING 2-#10, 1-#10EG, 3/4"C.
- PROVIDE 277V NORMAL LIGHTING BRANCH CIRCUIT(S) AND HOME RUNS FOR LIGHT FIXTURES IN CORRIDOR FROM PANEL HNL2-1 LOCATED IN ROOM 9C UNLESS OTHERWISE NOTED. CIRCUIT NUMBER SHALL BE DESIGNATED AS #2. PROVIDE BRANCH CIRCUIT USING 2-#10, 1-#10EG, 3/4"C.
- PROVIDE 277V UNSWITCHED EMERGENCY LIGHTING BRANCH CIRCUIT(S) AND HOME RUNS FOR LIGHT FIXTURES DENOTED AS BEING CONNECTED TO AN EMERGENCY LIFE SAFETY CIRCUIT 'EM' ON THIS DRAWING FROM PANEL HELSPH-1 LOCATED IN PENTHOUSE UNLESS OTHERWISE NOTED. CIRCUIT NUMBER SHALL BE DESIGNATED AS #12. PROVIDE BRANCH CIRCUIT USING 2-#10, 1-#10EG, 3/4"C.
- F. REFER TO POWER & SS DRAWINGS FOR PANELBOARD LOCATIONS.


#### **E103.2 DRAWING NOTES**

- 1 PROVIDE 277V NORMAL POWER LIGHTING BRANCH CIRCUIT(S) AND HOME RUNS FOR LIGHT FIXTURES IN THIS AREA FROM PANEL HNL2-1 LOCATED IN ELECTRICAL ROOM 9C UNLESS OTHERWISE NOTED. CIRCUIT NUMBER SHALL BE DESIGNATED AS #4. PROVIDE BRANCH CIRCUIT USING 2-#10, 1-#10EG, 3/4"C.
- PROVIDE 277V NORMAL POWER LIGHTING BRANCH CIRCUIT(S) AND HOME RUNS FOR LIGHT FIXTURES IN THIS AREA FROM PANEL HNL2-1 LOCATED IN ELECTRICAL ROOM 9C UNLESS OTHERWISE NOTED. CIRCUIT NUMBER SHALL BE DESIGNATED AS #6. PROVIDE BRANCH CIRCUIT USING 2-#10, 1-#10EG, 3/4"C.
- PROVIDE BRANCH CIRCUIT USING 2-#10, 1-#10EG, 3/4 C.

  PROVIDE 277V NORMAL POWER LIGHTING BRANCH CIRCUIT(S) AND HOME RUNS
  FOR LIGHT FIXTURES IN THIS AREA FROM PANEL HNL2-1 LOCATED IN ELECTRICAL
  ROOM 9C UNLESS OTHERWISE NOTED. CIRCUIT NUMBER SHALL BE DESIGNATED AS
- #8. PROVIDE BRANCH CIRCUIT USING 2-#10, 1-#10EG, 3/4"C.

  PROVIDE 277V NORMAL POWER LIGHTING BRANCH CIRCUIT(S) AND HOME RUNS
  FOR LIGHT FIXTURES IN THIS AREA FROM PANEL HNL2-1 LOCATED IN ELECTRICAL
  ROOM 9C UNLESS OTHERWISE NOTED. CIRCUIT NUMBER SHALL BE DESIGNATED AS
  #10. PROVIDE BRANCH CIRCUIT USING 2-#10, 1-#10EG, 3/4"C.



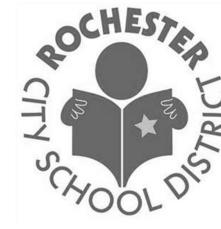

ENGINEERING


Mechanical/Electrical Engineering Consultants

Rochester | Buffalo | Syracuse | Schenectady

150 N. CHESTNUT ST.
ROCHESTER, NY 14604

S85,288,5590

www.meengineering.com

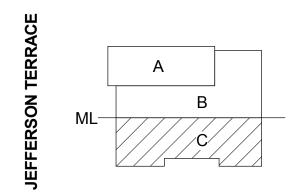

**KEY PLAN** 

DR. SAMUEL MCCREE WAY

SED # 26-16-00-01-0-004-024 DWT SED # 26-16-00-01-7-999-020

Rochester Schools Modernization Program
-Phase 2c
George M. Forbes- Renovation, Alterations

and Addition

198 Dr Samuel McCree Way, Rochester, NY 14611

REV.#	DESCRIPTION	DATE
1	ADDENDUM 1	04/25/1


JOB NO.	17
SCALE	AS NOTE
ISSUE DATE	4/9/
DRAWN BY	Auth
CHECKED BY	Check

THIS IS A SINGLE SHEET OF A COHESIVE SET OF CONSTRUCTION DOCUMENTS (INCLUDING DRAWINGS AND SPECIFICATIONS). INTERPRETATION OF THE INFORMATION AS PRESENTED SHOULD BE BASED ON THE ENTIRE SET OF DOCUMENTS.

DRAWING TITLE

SECOND FLOOR PLAN - C- LIGHTING

E103.2

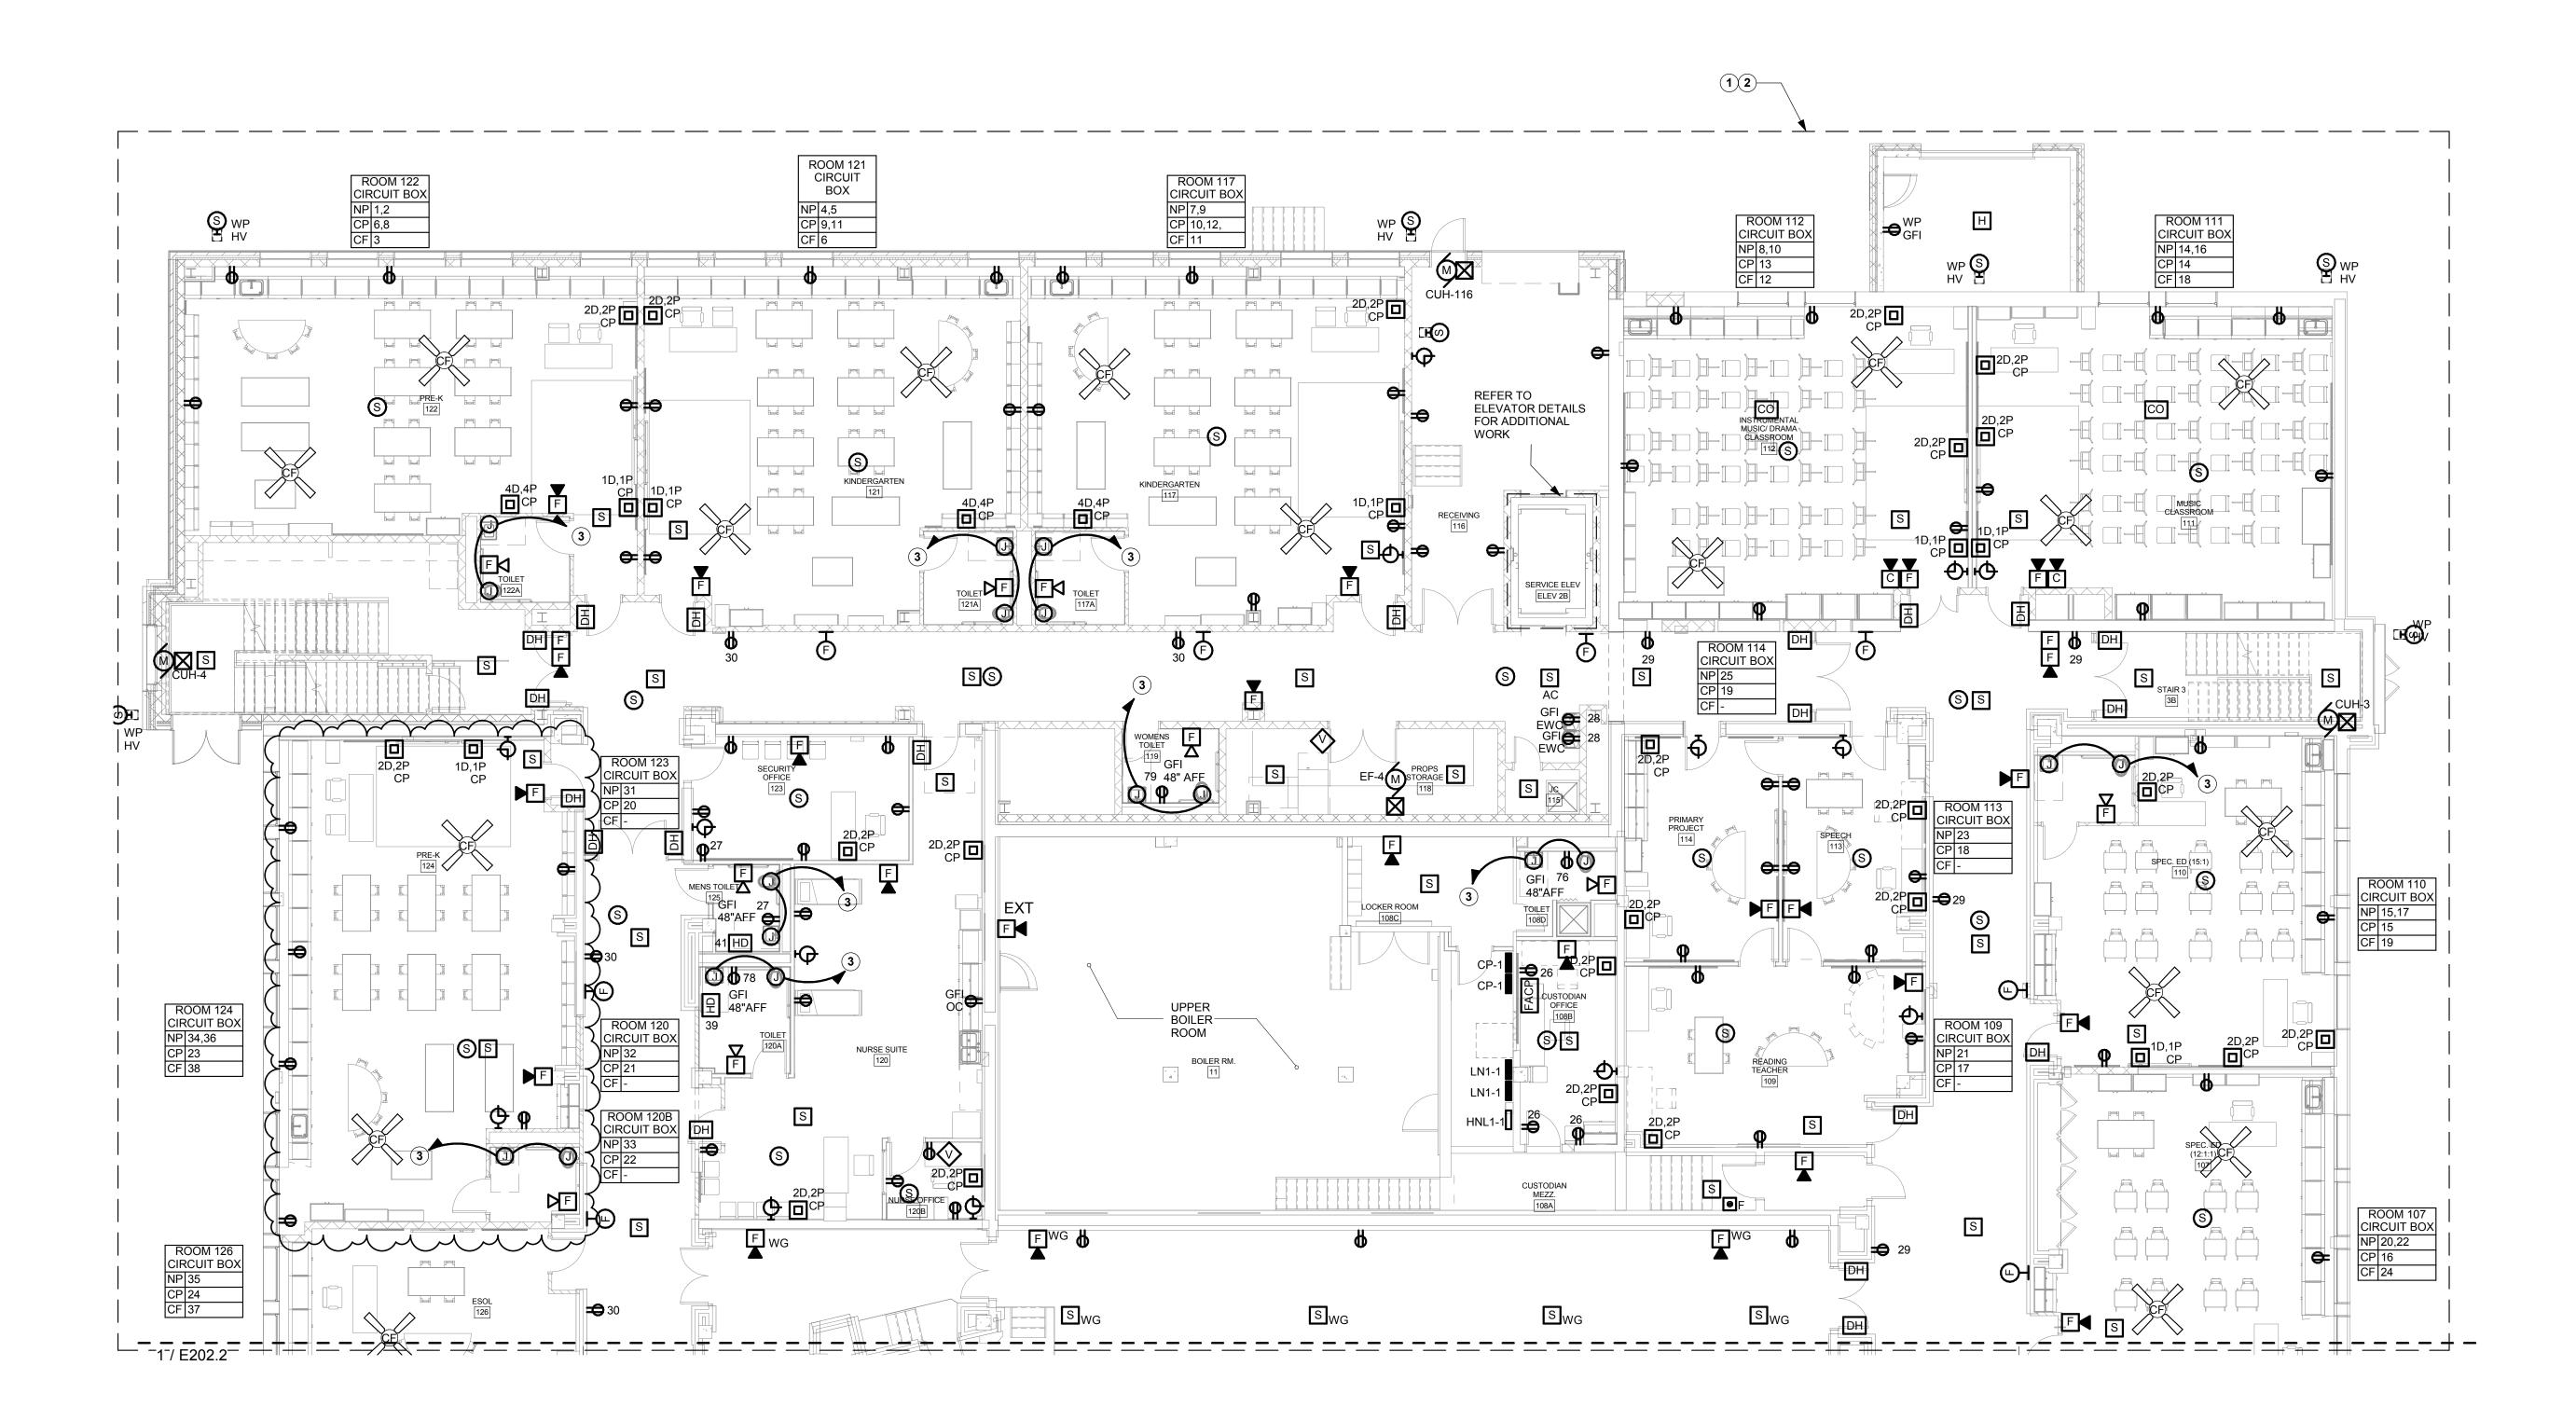

FIRST FLOOR PLAN - A/B - POWER AND SS

1/8" = 1'-0"

E202.1 DRAWING NOTES

- PROVIDE 120V NORMAL POWER (NP) BRANCH CIRCUITS AND HOME RUNS FOR GENERAL PURPOSE RECEPTACLES AND CEILING FANS (CF) SHOWN IN THIS AREA FROM PANEL LN1-1 IN MEZZ. 111 UNLESS OTHERWISE NOTED. CIRCUIT NUMBER SHALL BE INDICATED IN ROOM CIRCUIT BOX. MAXIMUM OF 4 RECEPTACLES PER
- CIRCUIT.

  PROVIDE 120V CLEAN POWER (CP) BRANCH CIRCUITS AND HOME RUNS FOR GENERAL PURPOSE CLEAN POWER RECPTACLES IN THIS AREA FROM PANEL CP-1 IN MEZZ. 111 UNLESS OTHERWISE NOTED. CIRCUIT NUMBER SHALL BE DESIGNATED AS 'CP' ADJACENT TO EACH WIRING DEVICE AND INDICATED IN ROOM CIRCUIT BOX. MAXIMUM OF 4 RECEPTACLES PER CIRCUIT.
- INSTALL LOW VOLTAGE TRANSFORMER ABOVE ACCESSIBLE CEILING SPACE IN TOILET ROOM. PROVIDE POWER CONNECTION TO THE TRANSFORMER USING A DEDICATED 120V, 20A NORMAL BRANCH CIRCUIT AND HOME RUN FROM PANEL LN1-1 UNLESS OTHERWISE NOTED. REFER TO PLUMBING DRAWINGS FOR ADDITIONAL INFORMATION AND QUANTITIES OF THE LOW VOLTAGE TRANSFORMERS

### **E202.1 GENERAL NOTES**

- A. REFER TO DRAWING E000 FOR GENERAL NOTES THAT PERTAIN TO ALL ELECTRICAL DRAWINGS.
- B. ALL CEILING FANS SHALL BE MOUNTED SUCH THAT THE BOTTOM OF THE CEILING FAN IS AT 7'-8" AFF.
   C. COORDINATE ALL WALL MOUNTED DEVICES IN GYM WITH WALL PADDING AND G.C. G.C. TO CUT AND PREPARE ALL PADDING TO ACCOMODATE DEVICES.
- D. FOR ROOMS THAT DO NOT HAVE A "CIRCUIT BOX" PROVIDE 120V NORMAL POWER (NP) BRANCH CIRCUITS AND HOME RUNS FOR GENERAL PURPOSE RECEPTACLES AND CEILING FANS (CF) INDICATED ON DRAWINGS FROM PANEL LN1-1 IN MEZZ. 111 UNLESS OTHERWISE INDICATED. CIRCUIT NUMBER SHALL BE DESIGNATED NEXT TO DEVICE
- FOR ROOMS THAT DO NOT HAVE A "CIRCUIT BOX" PROVIDE 120V CLEAN POWER (CP) BRANCH CIRCUITS AND HOME RUNS FOR GENERAL PURPOSE CLEAN POWER RECEPTACLES INDICATED ON DRAWING FROM PANEL CP-1 IN MEZZ. 111 UNLESS NOTED OTHERWISE. IN ADDITION TO 'CP' DESIGNATION, CIRCUIT NUMBER SHALL BE DESIGNATED NEXT TO DEVICE.






Mechanical/Electrical Engineering Consultants
Rochester | Buffalo | Syracuse | Schenectady

150 N. CHESTNUT ST.
ROCHESTER, NY 14604

ENGINEER | September | Septem

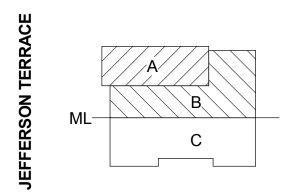

KEY PLAN

DR. SAMUEL MCCREE WAY

SED # 26-16-00-01-0-004-024 DWT SED # 26-16-00-01-7-999-020

Rochester Schools Modernization Program
-Phase 2c
George M. Forbes- Renovation, Alterations

orge M. Forbes- Renovation, Alteration and Addition

198 Dr Samuel McCree Way, Rochester, NY 14611

REV.#	DESCRIPTION	DATE
1	ADDENDUM 1	04/25/18


JOB NO.	17
SCALE	AS NOTE
ISSUE DATE	4/9/
DRAWN BY	Auth
CHECKED BY	Check

THIS IS A SINGLE SHEET OF A COHESIVE SET OF CONSTRUCTION DOCUMENTS (INCLUDING DRAWINGS AND SPECIFICATIONS). INTERPRETATION OF THE INFORMATION AS PRESENTED SHOULD BE BASED ON THE ENTIRE SET OF DOCUMENTS.

DRAWING TITLE

FIRST FLOOR PLAN -A/B - POWER AND SS

E202.1

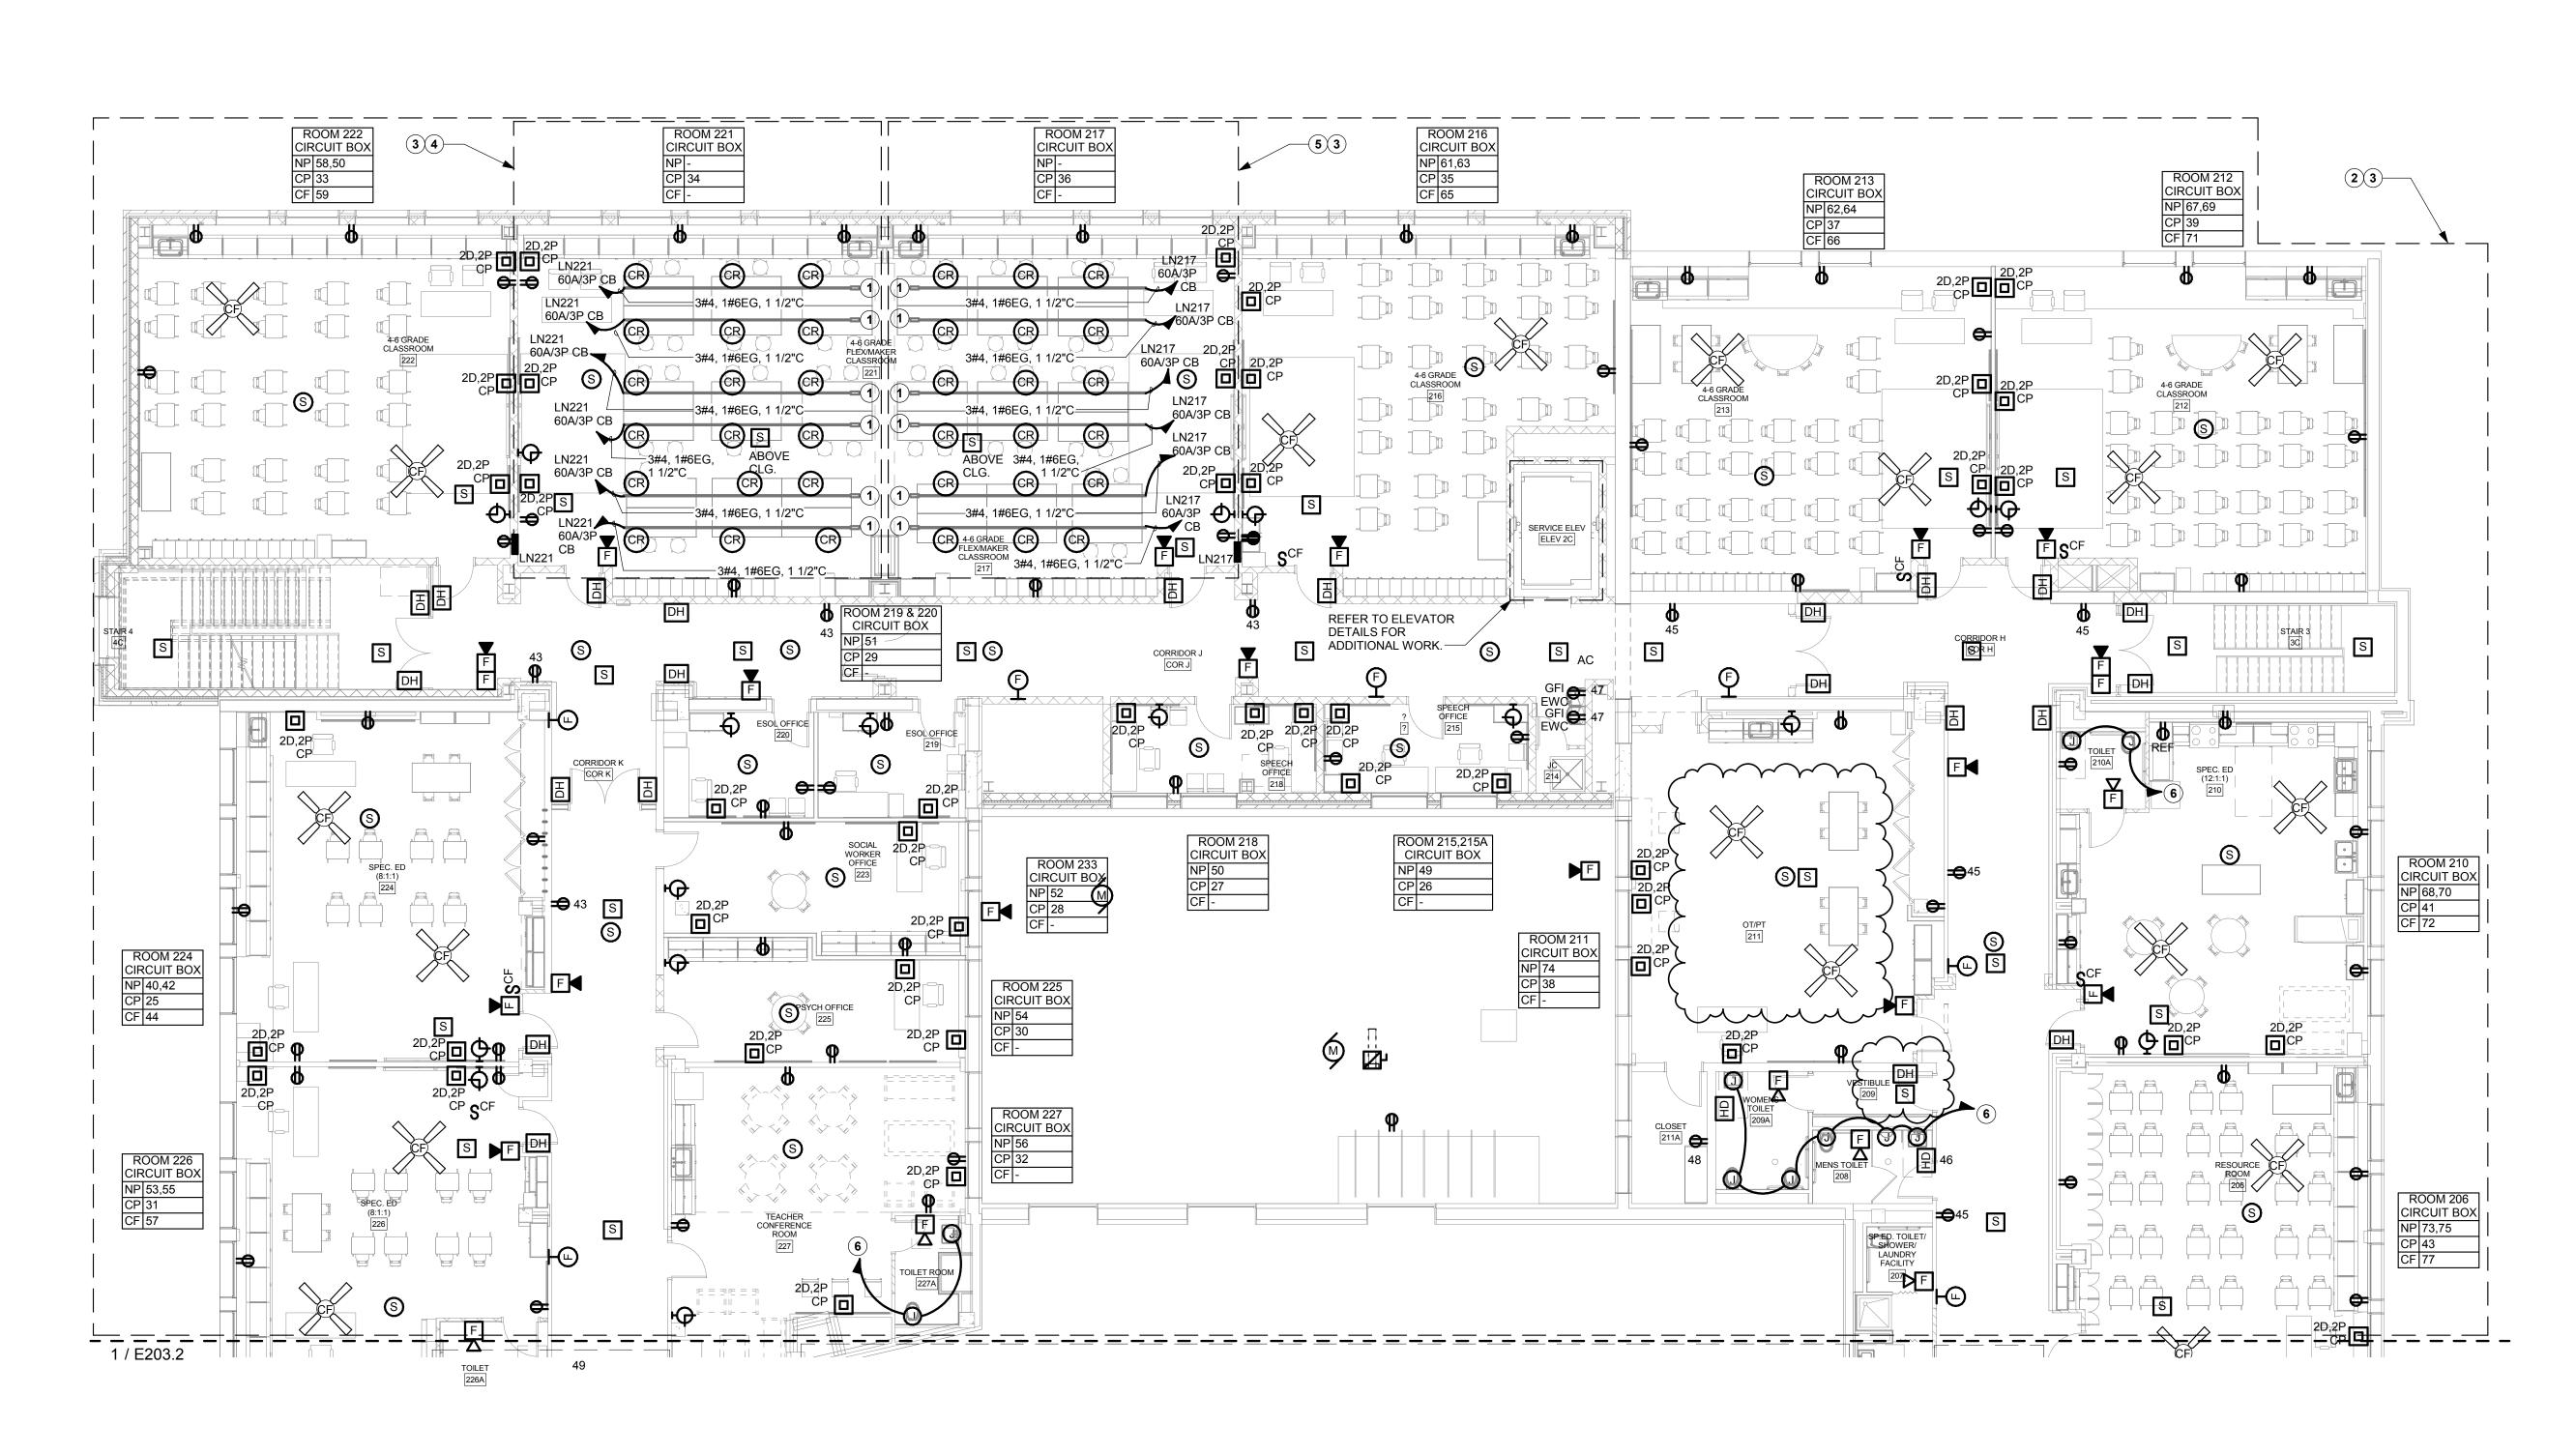

SECOND FLOOR PLAN - A/B - POWER AND SS

1/8" = 1'-0"

# E203.1 DRAWING NOTES

- PROVIDE BUSDUCT SYSTEM AS SHOWN. SHALL BE STARLING SERIES B60 TYPE.
- PROVIDE 120V NORMAL POWER (NP) BRANCH CIRCUITS AND HOME RUNS FOR GENERAL PURPOSE RECEPTACLES AND CEILING FANS (CF) SHOWN IN THIS AREA FROM PANEL LN1-1 IN MEZZ. 111 UNLESS OTHERWISE NOTED. CIRCUIT NUMBER SHALL BE INDICATED IN ROOM CIRCUIT BOX. MAXIMUM OF 4 RECEPTACLES PER CIRCUIT.
- PROVIDE 120V CLEAN POWER (CP) BRANCH CIRCUITS AND HOME RUNS FOR GENERAL PURPOSE CLEAN POWER RECPTACLES IN THIS AREA FROM PANEL CP-1 IN MEZZ. 111 UNLESS OTHERWISE NOTED. CIRCUIT NUMBER SHALL BE DESIGNATED AS 'CP' ADJACENT TO EACH WIRING DEVICE AND INDICATED IN ROOM CIRCUIT BOX. MAXIMUM OF 4
- PROVIDE 120V NORMAL POWER (NP) BRANCH CIRCUITS AND HOME RUNS FOR GENERAL PURPOSE RECEPTACLES AND CEILING FANS (CF) SHOWN IN THIS AREA FROM PANEL LN221 IN ROOM 221 UNLESS OTHERWISE NOTED. CIRCUIT NUMBER SHALL BE INDICATED IN ROOM CIRCUIT BOX. MAXIMUM OF 4 RECEPTACLES PER CIRCUIT.
- PROVIDE 120V NORMAL POWER (NP) BRANCH CIRCUITS AND HOME RUNS FOR GENERAL PURPOSE RECEPTACLES AND CEILING FANS (CF) SHOWN IN THIS AREA FROM PANEL LN217 IN ROOM 217 UNLESS OTHERWISE NOTED. CIRCUIT NUMBER SHALL BE INDICATED IN ROOM CIRCUIT BOX. MAXIMUM OF 4 RECEPTACLES PER CIRCUIT.
- SHALL BE INDICATED IN ROOM CIRCUIT BOX. MAXIMUM OF 4 RECEPTACLES PER CIRCUIT.

  INSTALL LOW VOLTAGE TRANSFORMER ABOVE ACCESSIBLE CEILING SPACE IN TOILET ROOM. PROVIDE POWER CONNECTION TO THE TRANSFORMER USING A DEDICATED 120V, 20A NORMAL BRANCH CIRCUIT AND HOME RUN FROM PANEL LN1-1 UNLESS OTHERWISE NOTED. REFER TO PLUMBING DRAWINGS FOR ADDITIONAL INFORMATION AND QUANTITIES OF THE LOW VOLTAGE TRANSFORMERS.

### **E203.1 GENERAL NOTES**

- A. REFER TO DRAWING E000 FOR GENERAL NOTES THAT PERTAIN TO ALL ELECTRICAL DRAWINGS.


  B. ALL CEILING FANS SHALL BE MOUNTED SUCH THAT THE BOTTOM OF THE CEILING FAN IS AT 7'-8"
- AFF.
- C. COORDINATE ALL WALL MOUNTED DEVICES IN GYM WITH WALL PADDING AND G.C. G.C. TO CUT AND PREPARE ALL PADDING TO ACCOMODATE DEVICES.
- D. FOR ROOMS THAT DO NOT HAVE A "CIRCUIT BOX" PROVIDE 120V NORMAL POWER (NP) BRANCH CIRCUITS AND HOME RUNS FOR GENERAL PURPOSE RECEPTACLES AND CEILING FANS (CF) INDICATED ON DRAWINGS FROM PANEL LN1-1 IN MEZZ. 111 UNLESS OTHERWISE INDICATED. CIRCUIT NUMBER SHALL BE DESIGNATED NEXT TO DEVICE.
  - FOR ROOMS THAT DO NOT HAVE A "CIRCUIT BOX" PROVIDE 120V CLEAN POWER (CP) BRANCH CIRCUITS AND HOME RUNS FOR GENERAL PURPOSE CLEAN POWER RECEPTACLES INDICATED ON DRAWING FROM PANEL CP-1 IN MEZZ. 111 UNLESS NOTED OTHERWISE. IN ADDITION TO 'CP' DESIGNATION, CIRCUIT NUMBER SHALL BE DESIGNATED NEXT TO DEVICE.





Mechanical/Electrical Engineering Consultants

Rochester | Buffalo | Syracuse | Schenectady

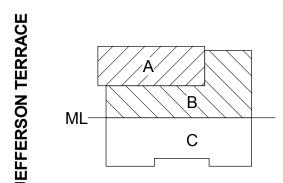

DR. SAMUEL MCCREE WAY

KEY PLAN

Rochester Schools Modernization Program

SED # 26-16-00-01-0-004-024 DWT SED #

26-16-00-01-7-999-020

-Phase 2c George M. Forbes- Renovation, Alterations and Addition

> 198 Dr Samuel McCree Way, Rochester, NY 14611

REV.#	DESCRIPTION	DATE
1	ADDENDUM 1	04/25/18


JOB NO.	17′
SCALE	AS NOTE
ISSUE DATE	4/9/
DRAWN BY	Auth
CHECKED BY	Check

THIS IS A SINGLE SHEET OF A COHESIVE SET OF CONSTRUCTION DOCUMENTS (INCLUDING DRAWINGS AND SPECIFICATIONS). INTERPRETATION OF THE INFORMATION AS PRESENTED SHOULD BE BASED ON THE ENTIRE SET OF DOCUMENTS.

DRAWING TITLE

SECOND FLOOR PLAN - A/B - POWER AND SS

E203.1

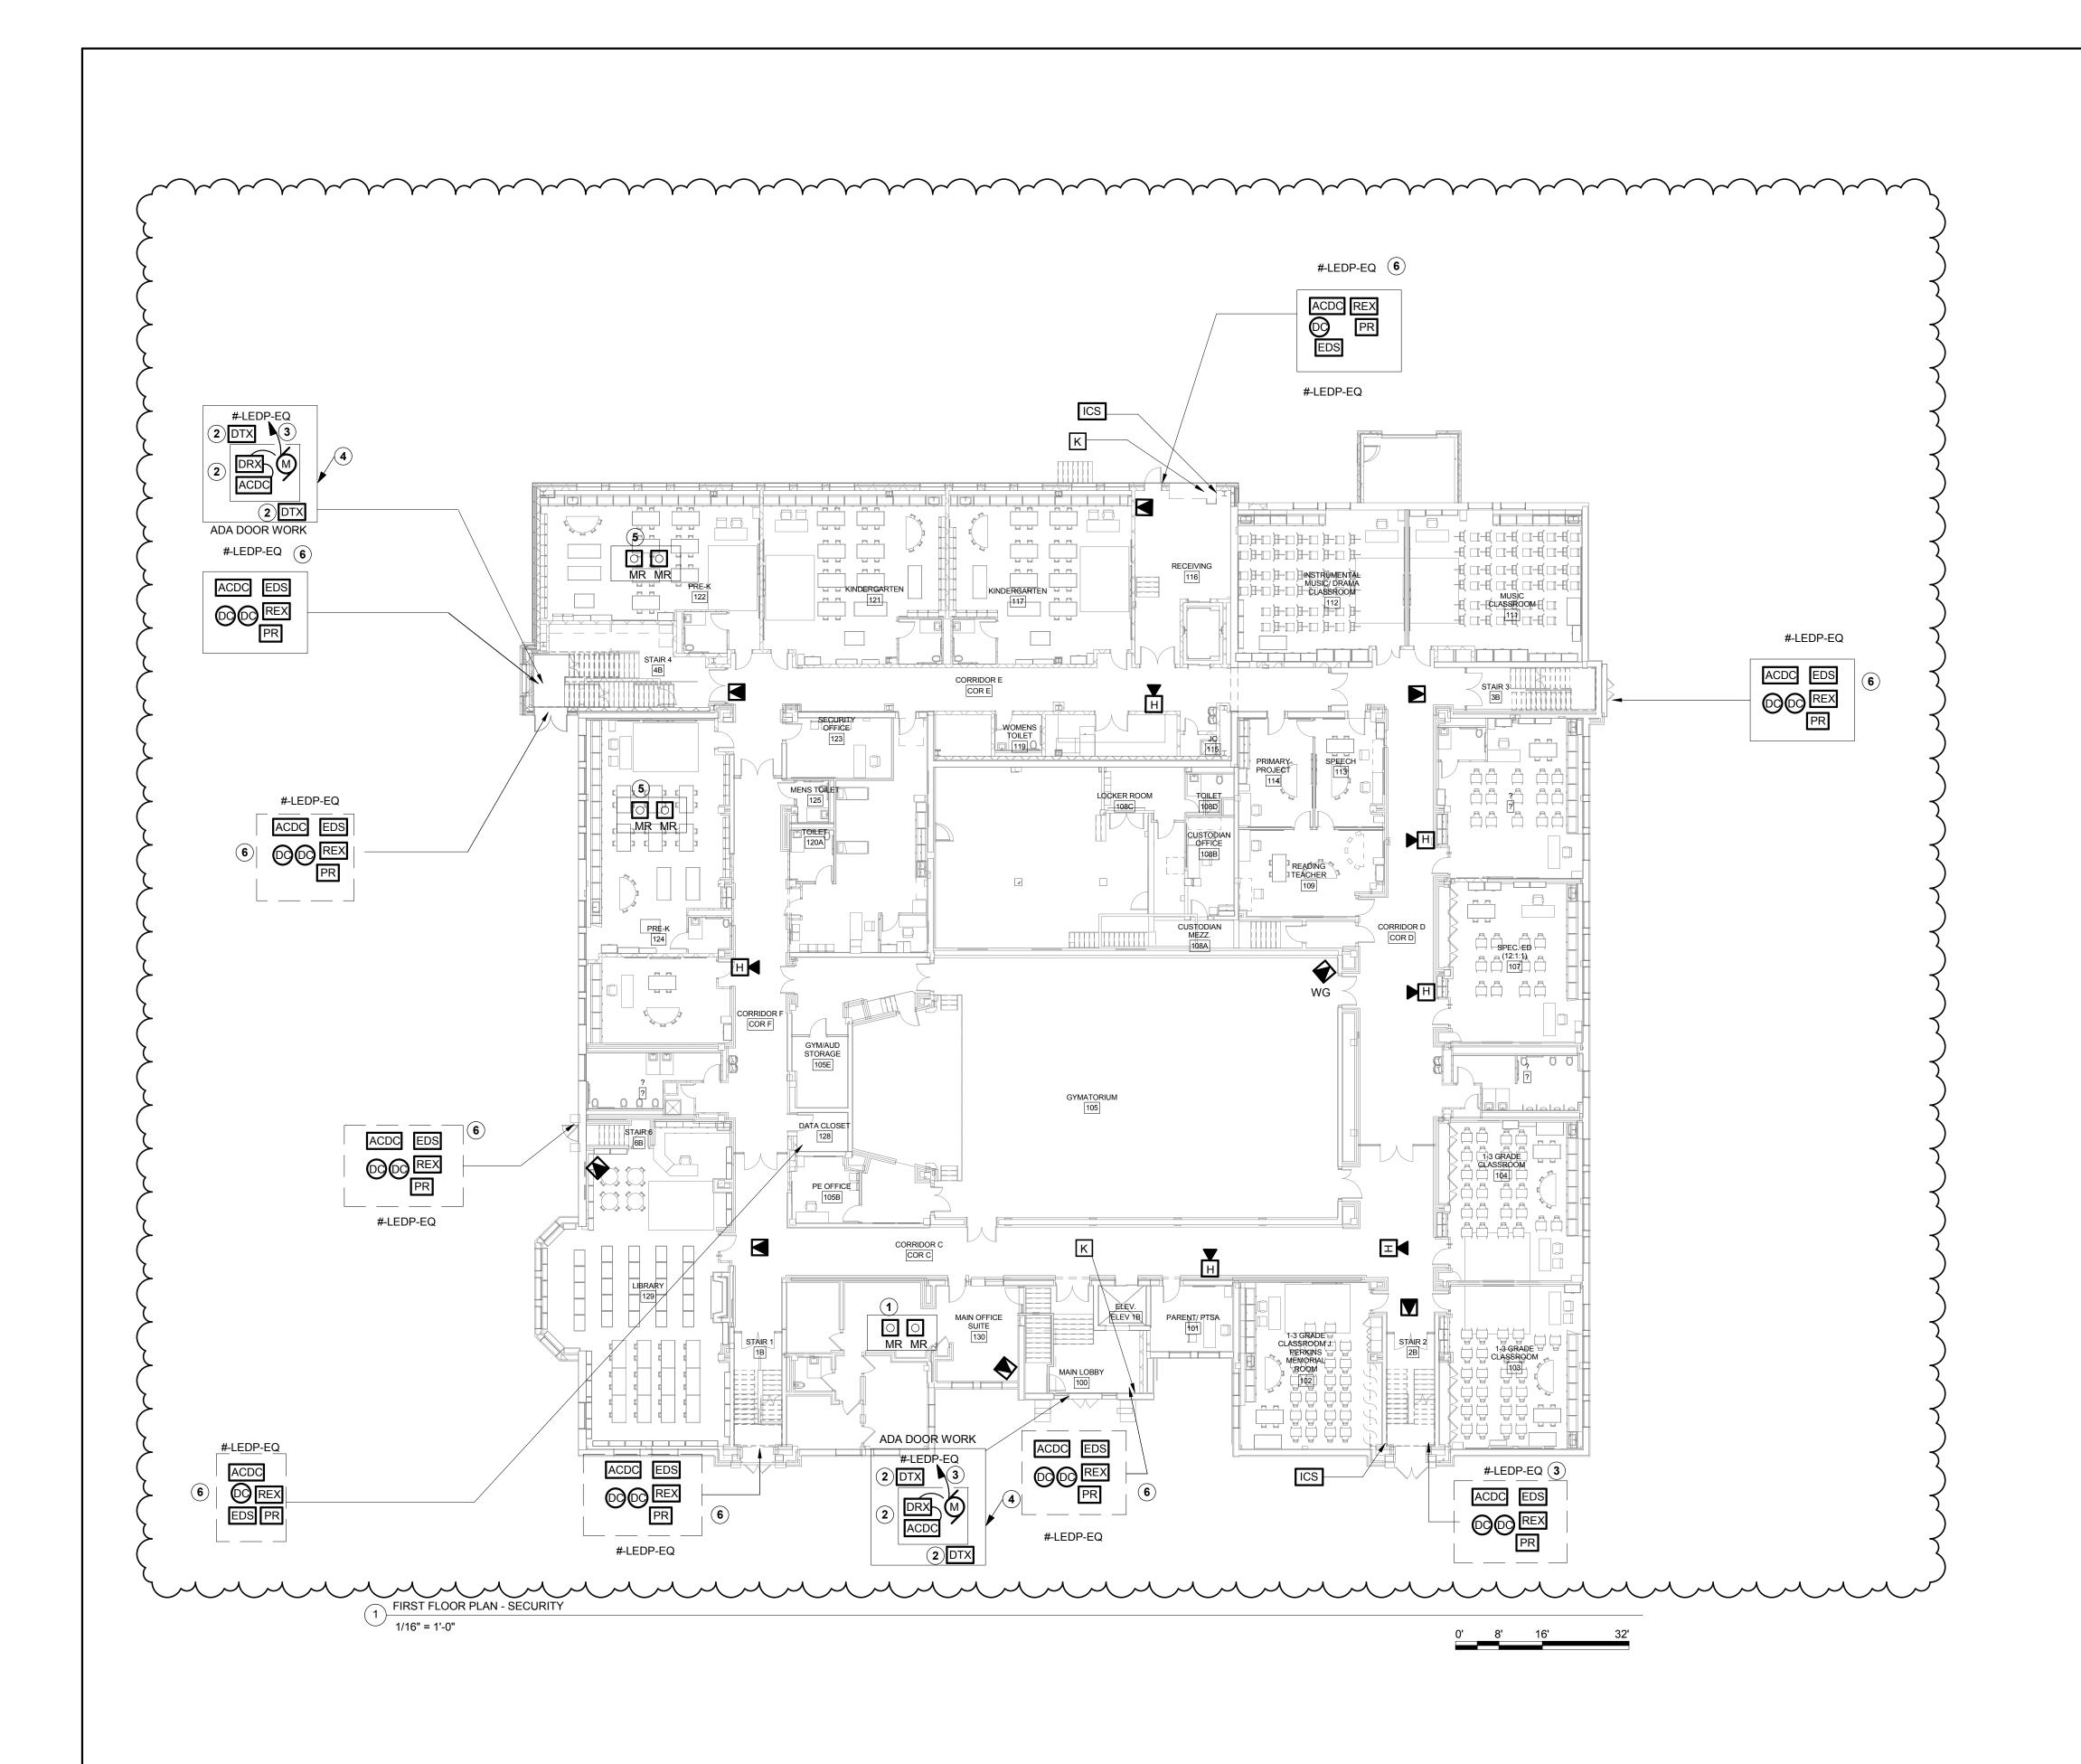

#### **E302 GENERAL NOTES**

- A. REFER TO DRAWING E000 FOR GENERAL NOTES THAT PERTAIN TO ALL ELECTRICAL DRAWINGS
- PER THE CONTRACT DOCUMENTS ALL BRANCH CIRCUITING AND HOME RUNS ARE TO BE CONCEALED WHERE POSSIBLE PER GENERAL NOTES AND SPECIFICATIONS.

  IF WALL ARE FISHABLE THEN THE BRANCH CIRCUITING AND HOMERUNS SHALL BE
- C. ALL TELECOMMUNICATIONS WORK TO BE DONE AS PART OF THE DWT CONTRACT.
  THIS INCLUDES BUT IS NOT LIMITED TO THE FOLLOWING:
  -DATA

CONCEALED. CONDUIT SHALL NOT BE USED IN FINISHED

-VOICE -IP CCTV

-AV CABLING AND EQUIPMENT
-MONITORS

-WIRELESS ACCESS POINTS

- D. PATHWAYS AND CONDUIT(S) REQUIREMENTS ARE PART OF THE E.C. SCOPE. POWER BY THE E.C. ALL POWER TO DATA CLOSETS TO BE CONNECTED TO EMERGENCY POWER. REFER TO DWT (T-SERIES DRAWINGS) FOR ADDITIONAL WORK.
- ACCESS CONTROL, AUDIO ENTRY AND INTRUSION DETECTION SCOPE IS BY THE E.C. REFER TO DRAWING T301 FOR IP CCTV CAMERA LOCATIONS AND QUANTITIES

**E302 DRAWING NOTES** 


- AT TWO (2) EXTERIOR DOORS NEAR MAIN OFFICE. PROVIDE MANUAL RELEASE BUTTONS, ALL WIRING AND CONNECTIONS TO ACCESS CONTROL SYSTM TO RELEASE DOORS IN THE EVENT THE PHONE IS BEING USED.
- EQUIPMENT TO BE FURNISHED BY G.C.
- PROVIDE ONE (1) 20A, 120V HOMERUN FOR BOTH AUTOMATIC DOOR OPERATOR MOTORS AND POWER SUPPLY. PROVIE CONTROL BRANCH CIRCUITING AND CONNECTIONS PER MANUFACTURERS RECOMMENDATIONS BETWEEN POWER SUPPLY, RECEIVER, AND DOOR OPERATORS
- PROVIDE ONE (1) 20A, 120V HOMERUN FOR POWER SUPPLY. PROVIDE CONTROL
  BRANCH CIRCUITING AND CONNECTIONS TO ACCESS CONTROL SYSTEM TO RELEASE
  DOORS FROM THE PREAK ROOMS.
- AT TWO (2) EXTERIOR DOORS NEAR STAIR 4. PROVIDE MANUAL RELEASE BUTTONS, ALL WIRING AND CONNECTIONS TO ACCESS CONTROL SYSTEM TO RELEASE DOORS FROM THE PRE-K ROOMS.
- PROVIDE ALL'ERANCH SIBOUTING AND CONTROL WIRING BETWEEN PROXIMITY
  READER, ELECTRIC DOOR STRIKE AND DOOR POWER SUPPLY. PROVIDE HOMERUN
  AND CONNECT TO PANEL INDICATED.



BUFFALO | ROCHESTER www.cjsarchitects.com



Mechanical/Electrical Engineering Consultants
Rochester | Buffalo | Syracuse | Schenectady

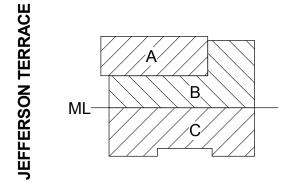

DR. SAMUEL MCCREE WAY

KEY PLAN

SED # 26-16-00-01-0-004-024 DWT SED # 26-16-00-01-7-999-020

Rochester Schools Modernization Program
-Phase 2c

George M. Forbes- Renovation, Alterations and Addition

198 Dr Samuel McCree Way, Rochester, NY 14611

REV.#	DESCRIPTION	DATE
1	ADDENDUM 1	04/25/18
		•


JOB NO.	17 <sup>-</sup>
SCALE	AS NOTE
ISSUE DATE	4/9/
DRAWN BY	Auth
CHECKED BY	Check

THIS IS A SINGLE SHEET OF A COHESIVE SET OF CONSTRUCTION DOCUMENTS (INCLUDING DRAWINGS AND SPECIFICATIONS). INTERPRETATION OF THE INFORMATION AS PRESENTED SHOULD BE BASED ON THE ENTIRE SET OF DOCUMENTS.

DRAWING TITLE

FIRST FLOOR PLAN -SECURITY

E302

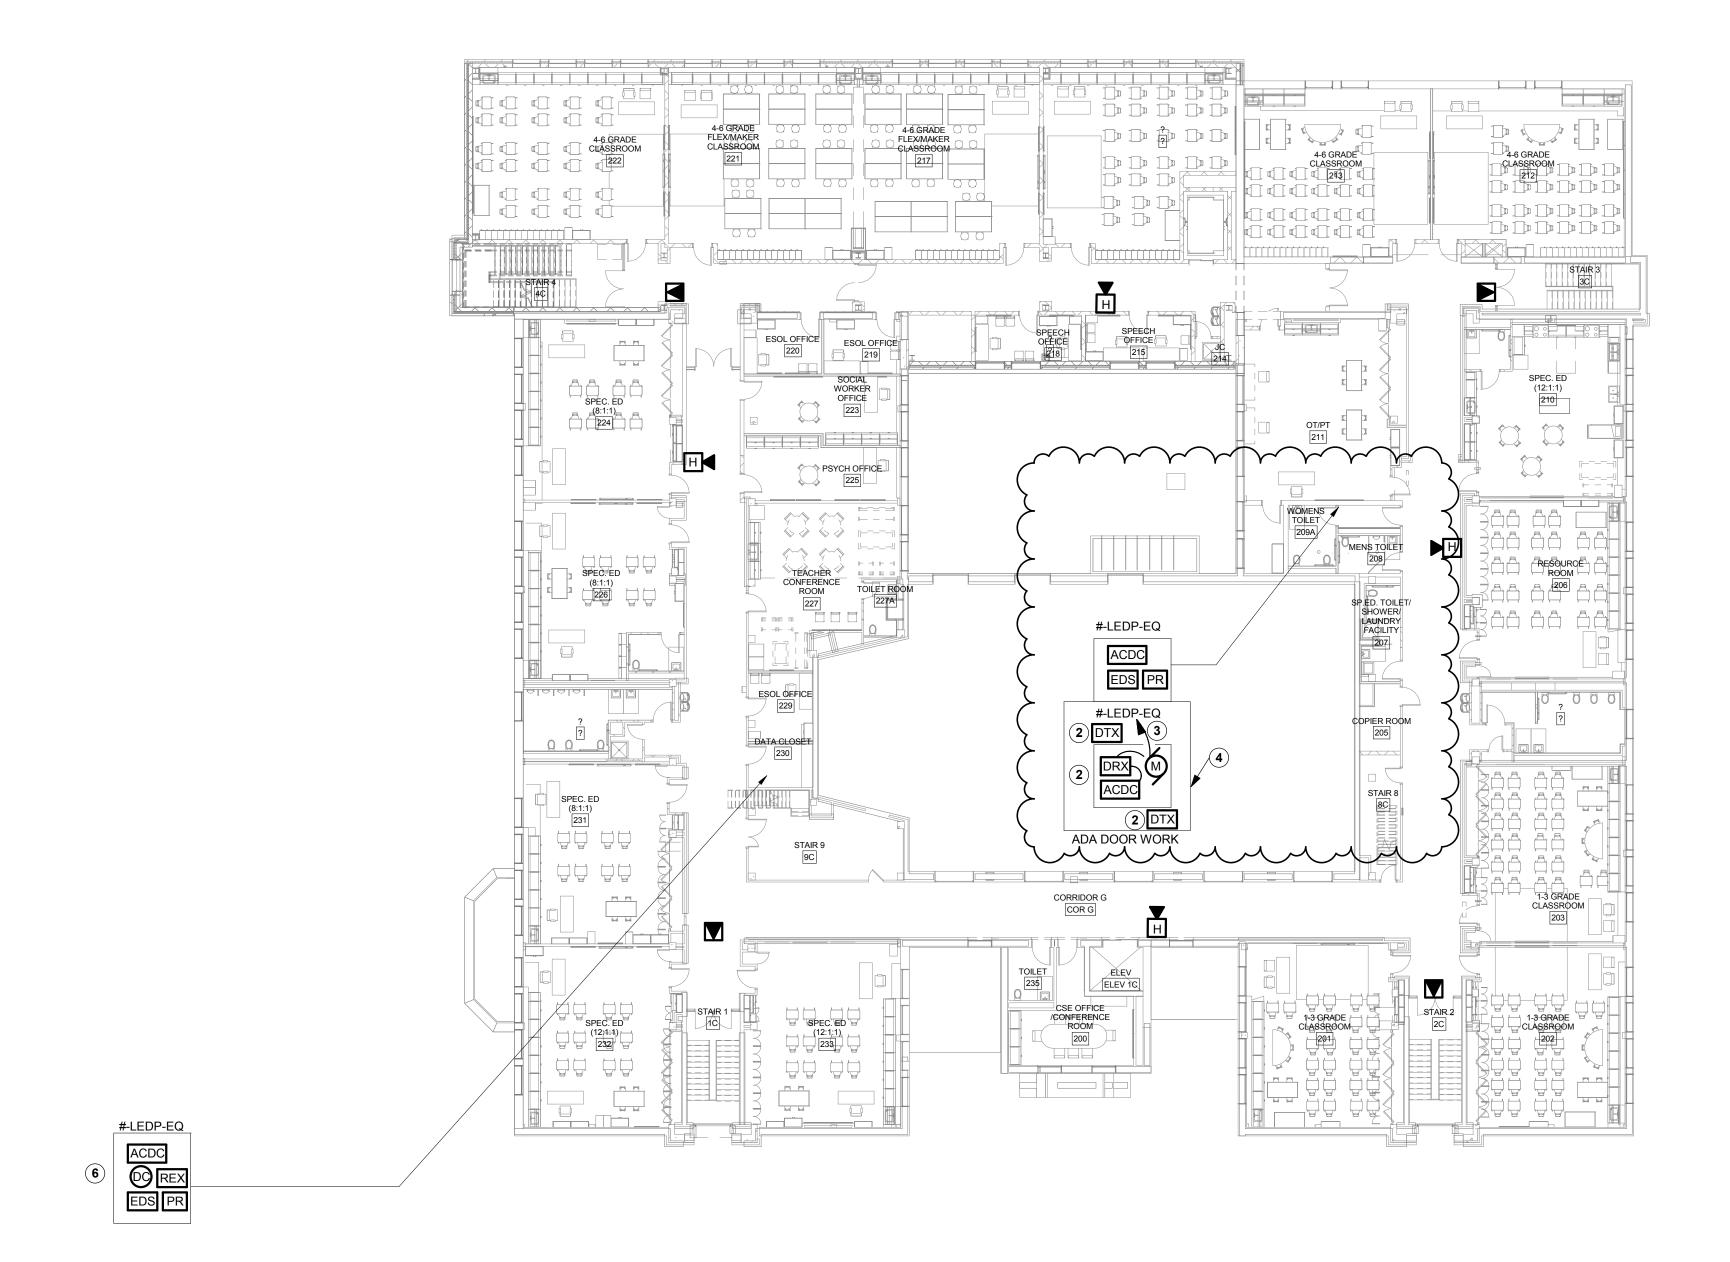

SECOND FLOOR PLAN - SECURITY

1/16" = 1'-0"

#### **E303 GENERAL NOTES**

- REFER TO DRAWING E000 FOR GENERAL NOTES THAT PERTAIN TO ALL ELECTRICAL
- PER THE CONTRACT DOCUMENTS ALL BRANCH CIRCUITING AND HOME RUNS ARE TO BE CONCEALED WHERE POSSIBLE PER GENERAL NOTES AND SPECIFICATIONS. IF WALL ARE FISHABLE THEN THE BRANCH CIRCUITING AND HOMERUNS SHALL BE CONCEALED. CONDUIT SHALL NOT BE USED IN FINISHED AREAS. ALL VERTICAL AND HORIZONTAL RACEWAYS INSTALLED IN FINISHED AREAS WHERE CONCEALMENT IS IMPOSSIBLE, ARE TO BE LOCATED AND INSTALLED IN AN INCONSPICUOUS FASHION AND APPROVED BY THE ARCHITECT AND ENGINEER PRIOR TO INSTALLATION. COORDINATE ALL SURFACE RACEWAY INSTALLATION AND LOCATIONS WITH ARCHITECT AND ENGINEER PRIOR TO INSTALLATION
- ALL TELECOMMUNICATIONS WORK TO BE DONE AS PART OF THE DWT CONTRACT. THIS INCLUDES BUT IS NOT LIMITED TO THE FOLLOWING: -VOICE

-IP CCTV -AV CABLING AN EQUIPMENT

-MONITORS

-WIRELESS ACCESS POINTS

- PATHWAYS AND CONDUIT(S) REQUIREMENTS ARE PART OF THE E.C. SCOPE. POWER BY THE E.C. ALL POWER TO DATA CLOSETS TO BE CONNECTED TO EMERGENCY POWER. REFER TO DWT (T-SERIES DRAWINGS) FOR ADDITIONAL WORK.
- ACCESS CONTROL, AUDIO ENTRY AND INTRUSION DETECTION SCOPE IS BY THE E.C. ALL HEAD END EQUIPMENT FOR ACCESS CONTROL. AUDIO ENTRY AND INTRUSION DETECTION SHALL BE LOCATED IN THE DATA CLOSETS.
- REFER TO DRAWING T301 FOR IP CCTV CAMERA LOCATIONS AND QUANTITIES

#### **E303 DRAWING NOTES**

- AT TWO (2) EXTERIOR DOORS NEAR MAIN OFFICE. PROVIDE MANUAL RELEASE BUTTONS, ALL WIRING AND CONNECTIONS TO ACCESS CONTROL SYSTM TO RELEASE DOORS IN THE EVENT THE PHONE IS BEING USED.
- **EQUIPMENT TO BE FURNISHED BY G.C.**
- PROVIDE ONE (1) 20A, 120V HOMERUN FOR BOTH AUTOMATIC DOOR OPERATOR MOTORS AND POWER SUPPLY. PROVIE CONTROL BRANCH CIRCUITING AND CONNECTIONS PER MANUFACTURERS RECOMMENDATIONS BETWEEN POWER SUPPLY, RECEIVER, AND DOOR OPERATORS
- PROVIDE ONE (1) 20A, 120V HOMERUN FOR POWER SUPPLY. PROVIDE CONTROL BRANCH CIRCUITING AND CONNECTIONS TO ACCESS CONTROL SYSTEM TO RELEASE DOORS FROM THE PRE-K ROOMS.
- AT TWO (2) EXTERIOR DOORS NEAR VESTIBULE C116. PROVIDE MANUAL RELEASE BUTTONS, ALL WIRING AND CONNECTIONS TO ACCESS CONTROL SYSTEM TO RELEASE DOORS FROM THE PRE-K ROOMS.
- PROVIDE ALL BRANCH CIRCUITING AND CONTROL WIRING BETWEEN PROXIMITY READER, ELECTRIC DOOR STRIKE AND DOOR POWER SUPPLY. PROVIDE HOMERUN AND CONNECT TO PANEL INDICATED.




BUFFALO | ROCHESTER www.cjsarchitects.com



**ENGINEERING** 

Mechanical/Electrical Engineering Consultants Rochester | Buffalo | Syracuse | Schenectady 150 N. CHESTNUT ST. ROCHESTER, NY 14604

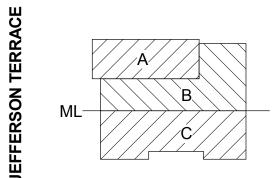

**KEY PLAN** 

DR. SAMUEL MCCREE WAY



SED # 26-16-00-01-0-004-024 DWT SED# 26-16-00-01-7-999-020

Rochester Schools Modernization Program -Phase 2c George M. Forbes- Renovation, Alterations and Addition

> 198 Dr Samuel McCree Way, Rochester, NY 14611

REV.#	DESCRIPTION	DATE
1	ADDENDUM 1	04/25/18


JOB NO.	171
SCALE	AS NOTE
ISSUE DATE	4/9/18
DRAWN BY	Autho
CHECKED BY	Checke

THIS IS A SINGLE SHEET OF A COHESIVE SET OF CONSTRUCTION DOCUMENTS (INCLUDING DRAWINGS AND SPECIFICATIONS). INTERPRETATION OF THE INFORMATION
AS PRESENTED SHOULD BE BASED ON
THE ENTIRE SET OF DOCUMENTS.

DRAWING TITLE

SECOND FLOOR PLAN - SECURITY

E303

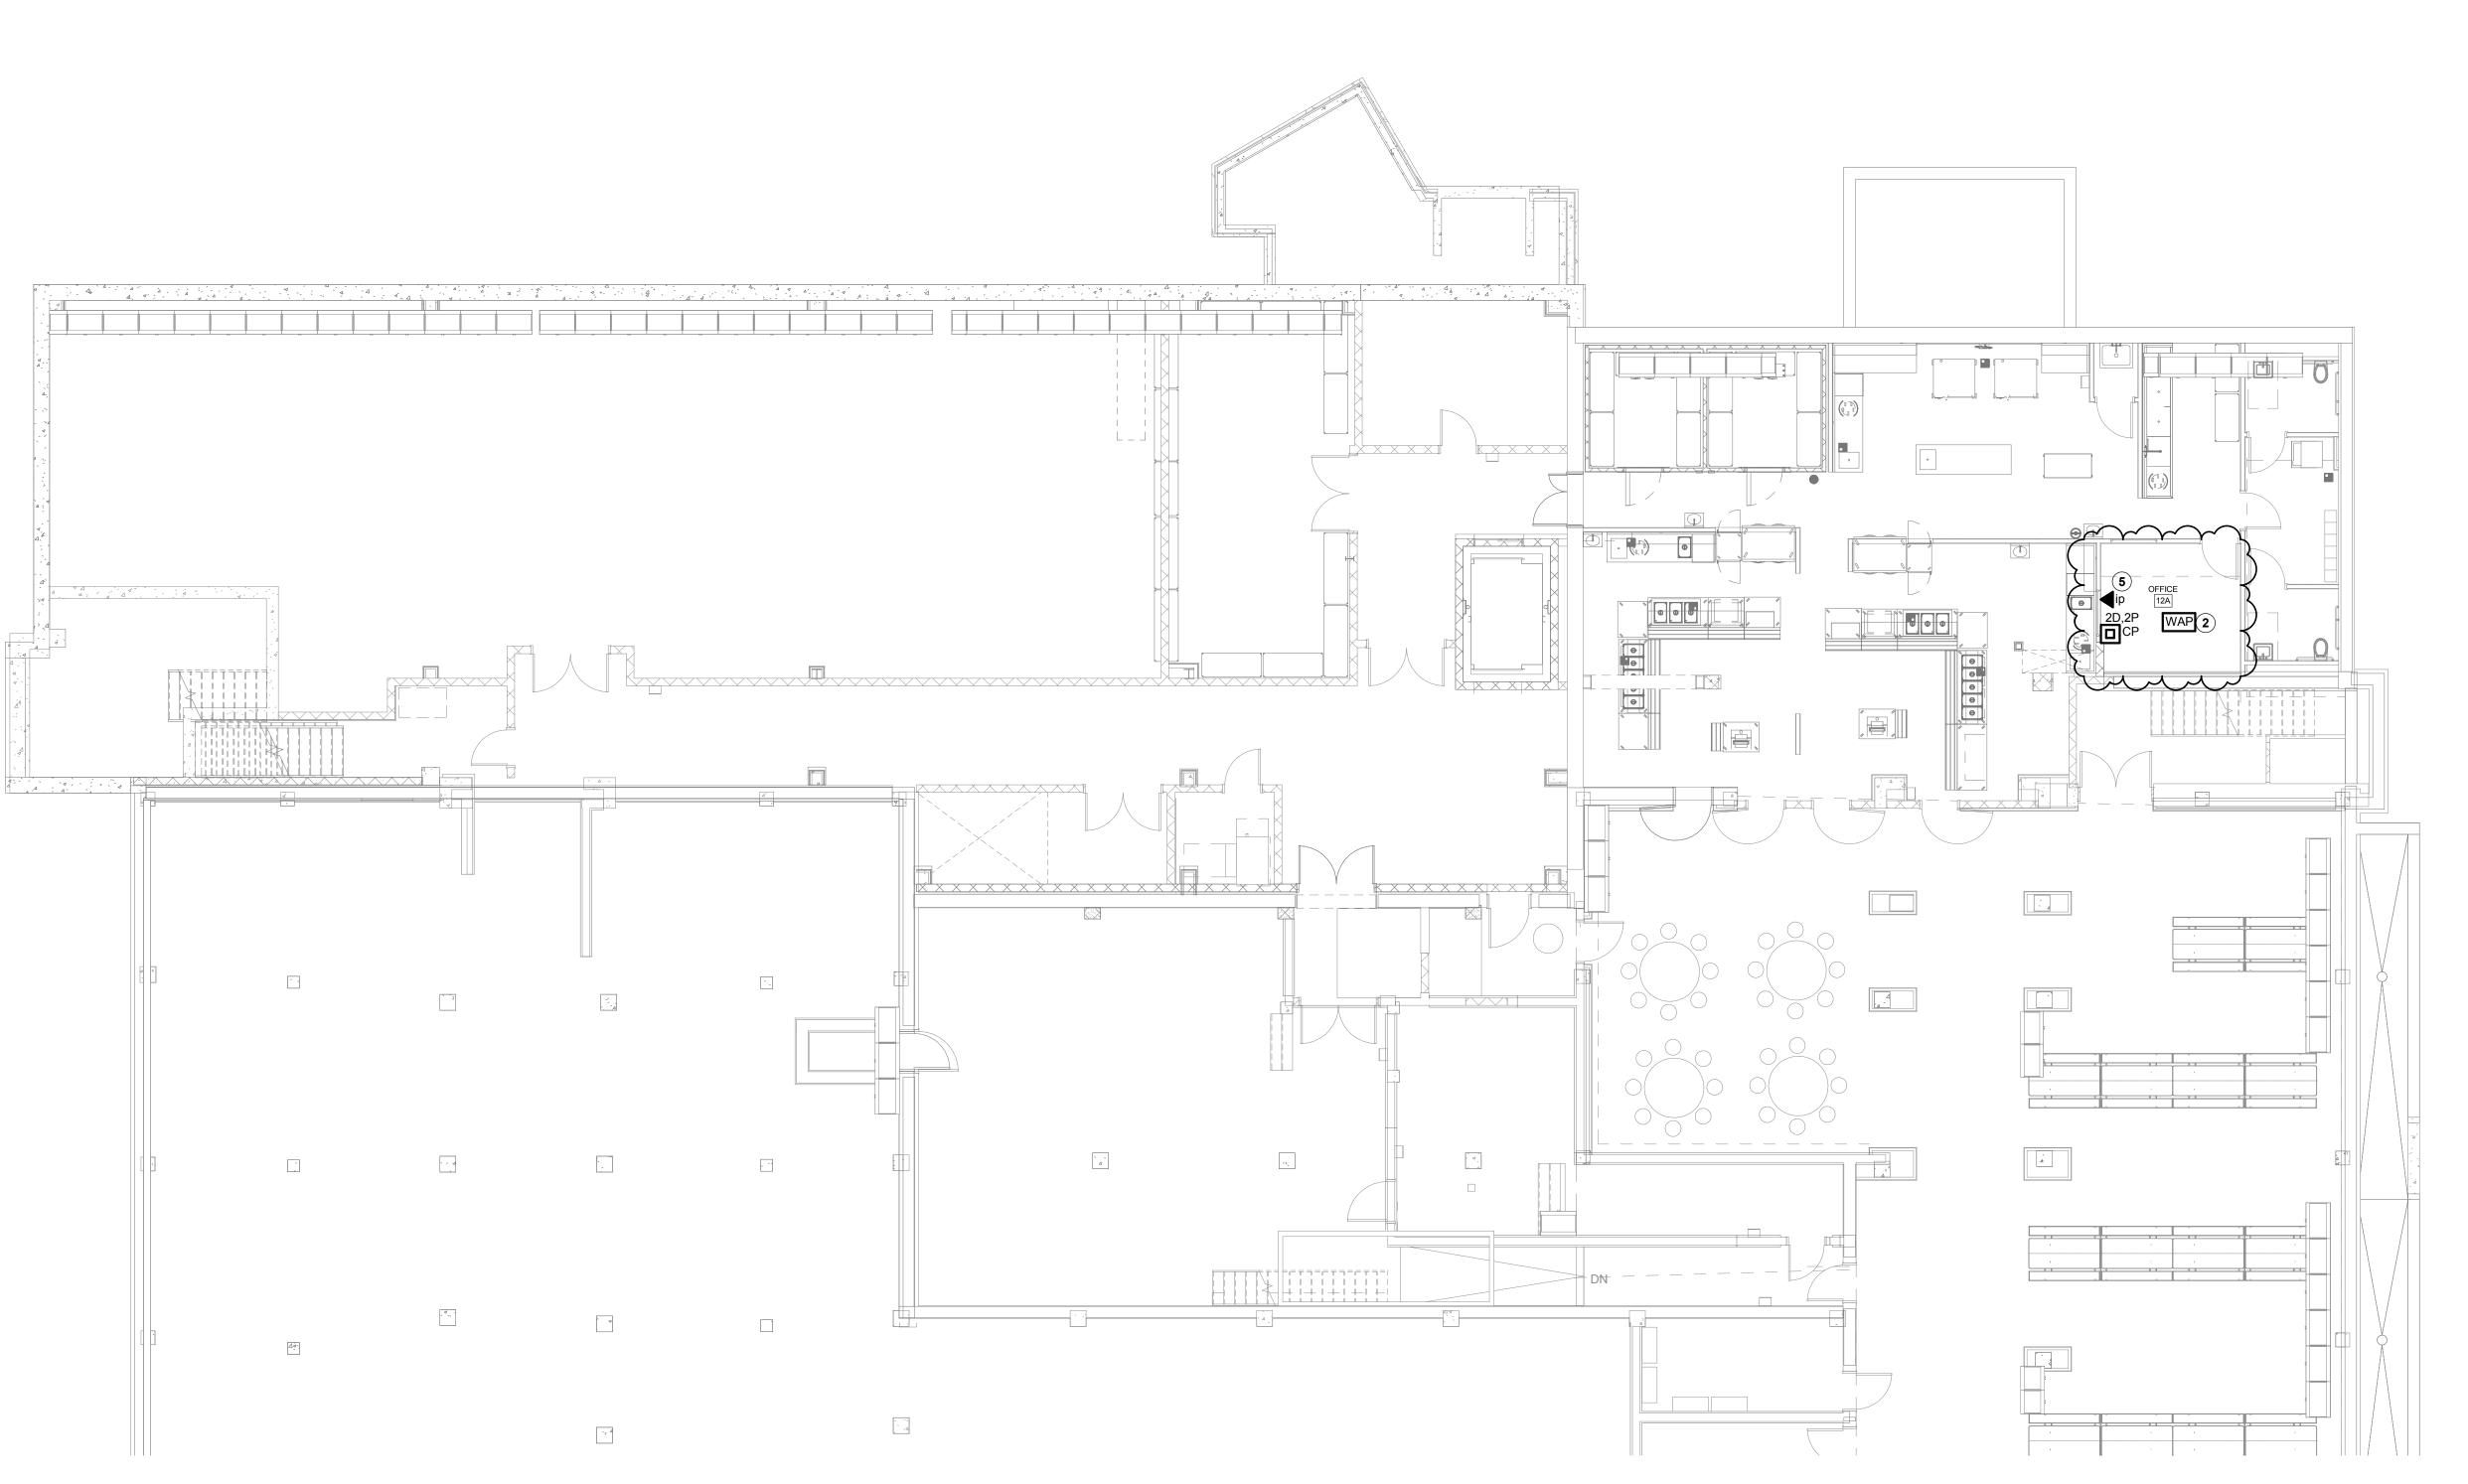

BASEMENT PLAN - A/B - DWT 1/8" = 1'-0"

### **T201.1 GENERAL NOTES**

- REFER TO DRAWING E000 FOR GENERAL NOTES THAT PERTAIN TO ALL ELECTRICAL
- PROVIDE, ROUTE, AND TERMINATE ALL UTP DATA CABLING ON THIS DRAWING TO IDF,
- COORDINATE LOCATION OF EQUIPMENT WITH ELECTRICAL/POWER DRAWINGS AND
- REFER TO ELECTRICAL DRAWINGS FOR NORMAL AND CLEAN DUPLEX RECEPTACLE LOCATIONS AND QUANTITIES.
- ROUTE ALL UTP CABLING ABOVE CEILINGS IN CLASSROOMS, COORDINATE ROUTING
- PATH WITH ALL CONTRACTORS PRIOR TO INSTALLATION.
- PER THE CONTRACT DOCUMENTS ALL BRANCH CIRCUITING AND HOME RUNS ARE TO BE CONCEALED WHERE POSSIBLE PER GENERAL NOTES AND SPECIFICATIONS. IF WALL ARE FISHABLE THEN THE BRANCH CIRCUITING AND HOMERUNS SHALL BE CONCEALED. CONDUIT SHALL NOT BE USED IN FINISHED AREAS. ALL VERTICAL AND HORIZONTAL RACEWAYS INSTALLED IN FINISHED AREAS WHERE CONCEALMENT IS IMPOSSIBLE, ARE TO BE LOCATED AND INSTALLED IN AN INCONSPICUOUS FASHION AND APPROVED BY THE ARCHITECT AND ENGINEER PRIOR TO INSTALLATION. COORDINATE ALL SURFACE RACEWAY INSTALLATION AND LOCATIONS WITH ARCHITECT AND ENGINEER PRIOR TO INSTALLATION

### **T201.1 DRAWING NOTES**

SOUND FIELD AMPLIFIER. PROVIDE COMPLETE SOUND FIELD SYSTEM. LOCATE IN CABINETRY. PROVIDE RCA LEFT AND RIGHT CABLES FROM SOUND

FIELD TO IWB. PROVIDE WIRELESS ACCESS POINT AND CAT 6A UTP CABLING.

PROVIDE NEW IWB WITH PROJECTOR AS INDICATED

PROVIDE NEW ALL IN ONE COMPONET/EQUIPMENT TO ALLOW FOR COMPLETE CONNECTIVITY IN ROOM THRU IWB.

PROVIDE NEW VOIP HANDSET PER SPECIFICATIONS PROVIDE MULTIMEDIA OUTLET AT TEACHER'S DESK WITH TWO (2) HDMI JACKS AND ONE (1) VGA JACK AND ASSOCIATED CABLES. AT TEACHER'S

DESK MULTIMEDIA OUTLET PROVIDE THE FOLLOWING: PROVIDÈ ONE (1) HDMI CABLE FROM TEACHER'S DESK TO IWB FOR TEACHER'S COMPUTER. PROVIDE ONE (1) HDMI CABLE FROM ALL IN ONE COMPUTER TO IWB. PROVIDE ONE (1) VGA FROM TEACHER'S DESK TO IWB

PROVIDE ALL ASSOCIATED IWB CABLES NOTED IN DRAWING NOTE 6 TO THIS MULTIMEDIA OUTLET LOCATION.


PROVIDE RCA L/R CABLES FROM IWB TO SOUNDFIELD AMPLIFIER. PROVIDE 3.5 MM CABLES FROM ALL IN ONE COMPUTER TO SOUND FIELD AMPLIFIER.

PROVIDE USB CABLE FROM ALL IN ONE COMPUTER TO IWB.

ARCHITECTS BUFFALO | ROCHESTER www.cjsarchitects.com



# Mechanical/Electrical Engineering Consultants Rochester | Buffalo | Syracuse | Schenectady 150 N. CHESTNUT ST. ROCHESTER, NY 14604

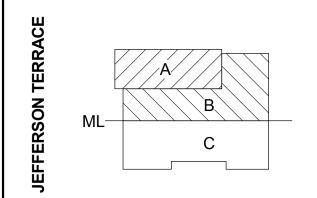

#### DR. SAMUEL MCCREE WAY **KEY PLAN**

SED # 26-16-00-01-0-004-024 DWT SED# 26-16-00-01-7-999-020

Rochester Schools Modernization Program -Phase 2c George M. Forbes- Renovation, Alterations

and Addition

198 Dr Samuel McCree Way,

Rochester, NY 14611

REV.#	DESCRIPTION	DATE
1	ADDENDUM 1	04/25/18
		•


	JOB NO.	17
	SCALE	AS NOTE
	ISSUE DATE	4/9/
	DRAWN BY	Auth
	CHECKED BY	Check
· '		

THIS IS A SINGLE SHEET OF A COHESIVE SET OF CONSTRUCTION DOCUMENTS (INCLUDING DRAWINGS AND SPECIFICATIONS). INTERPRETATION OF THE INFORMATION
AS PRESENTED SHOULD BE BASED ON
THE ENTIRE SET OF DOCUMENTS.

DRAWING TITLE

BASEMENT PLAN -A/B - DWT

T201.1

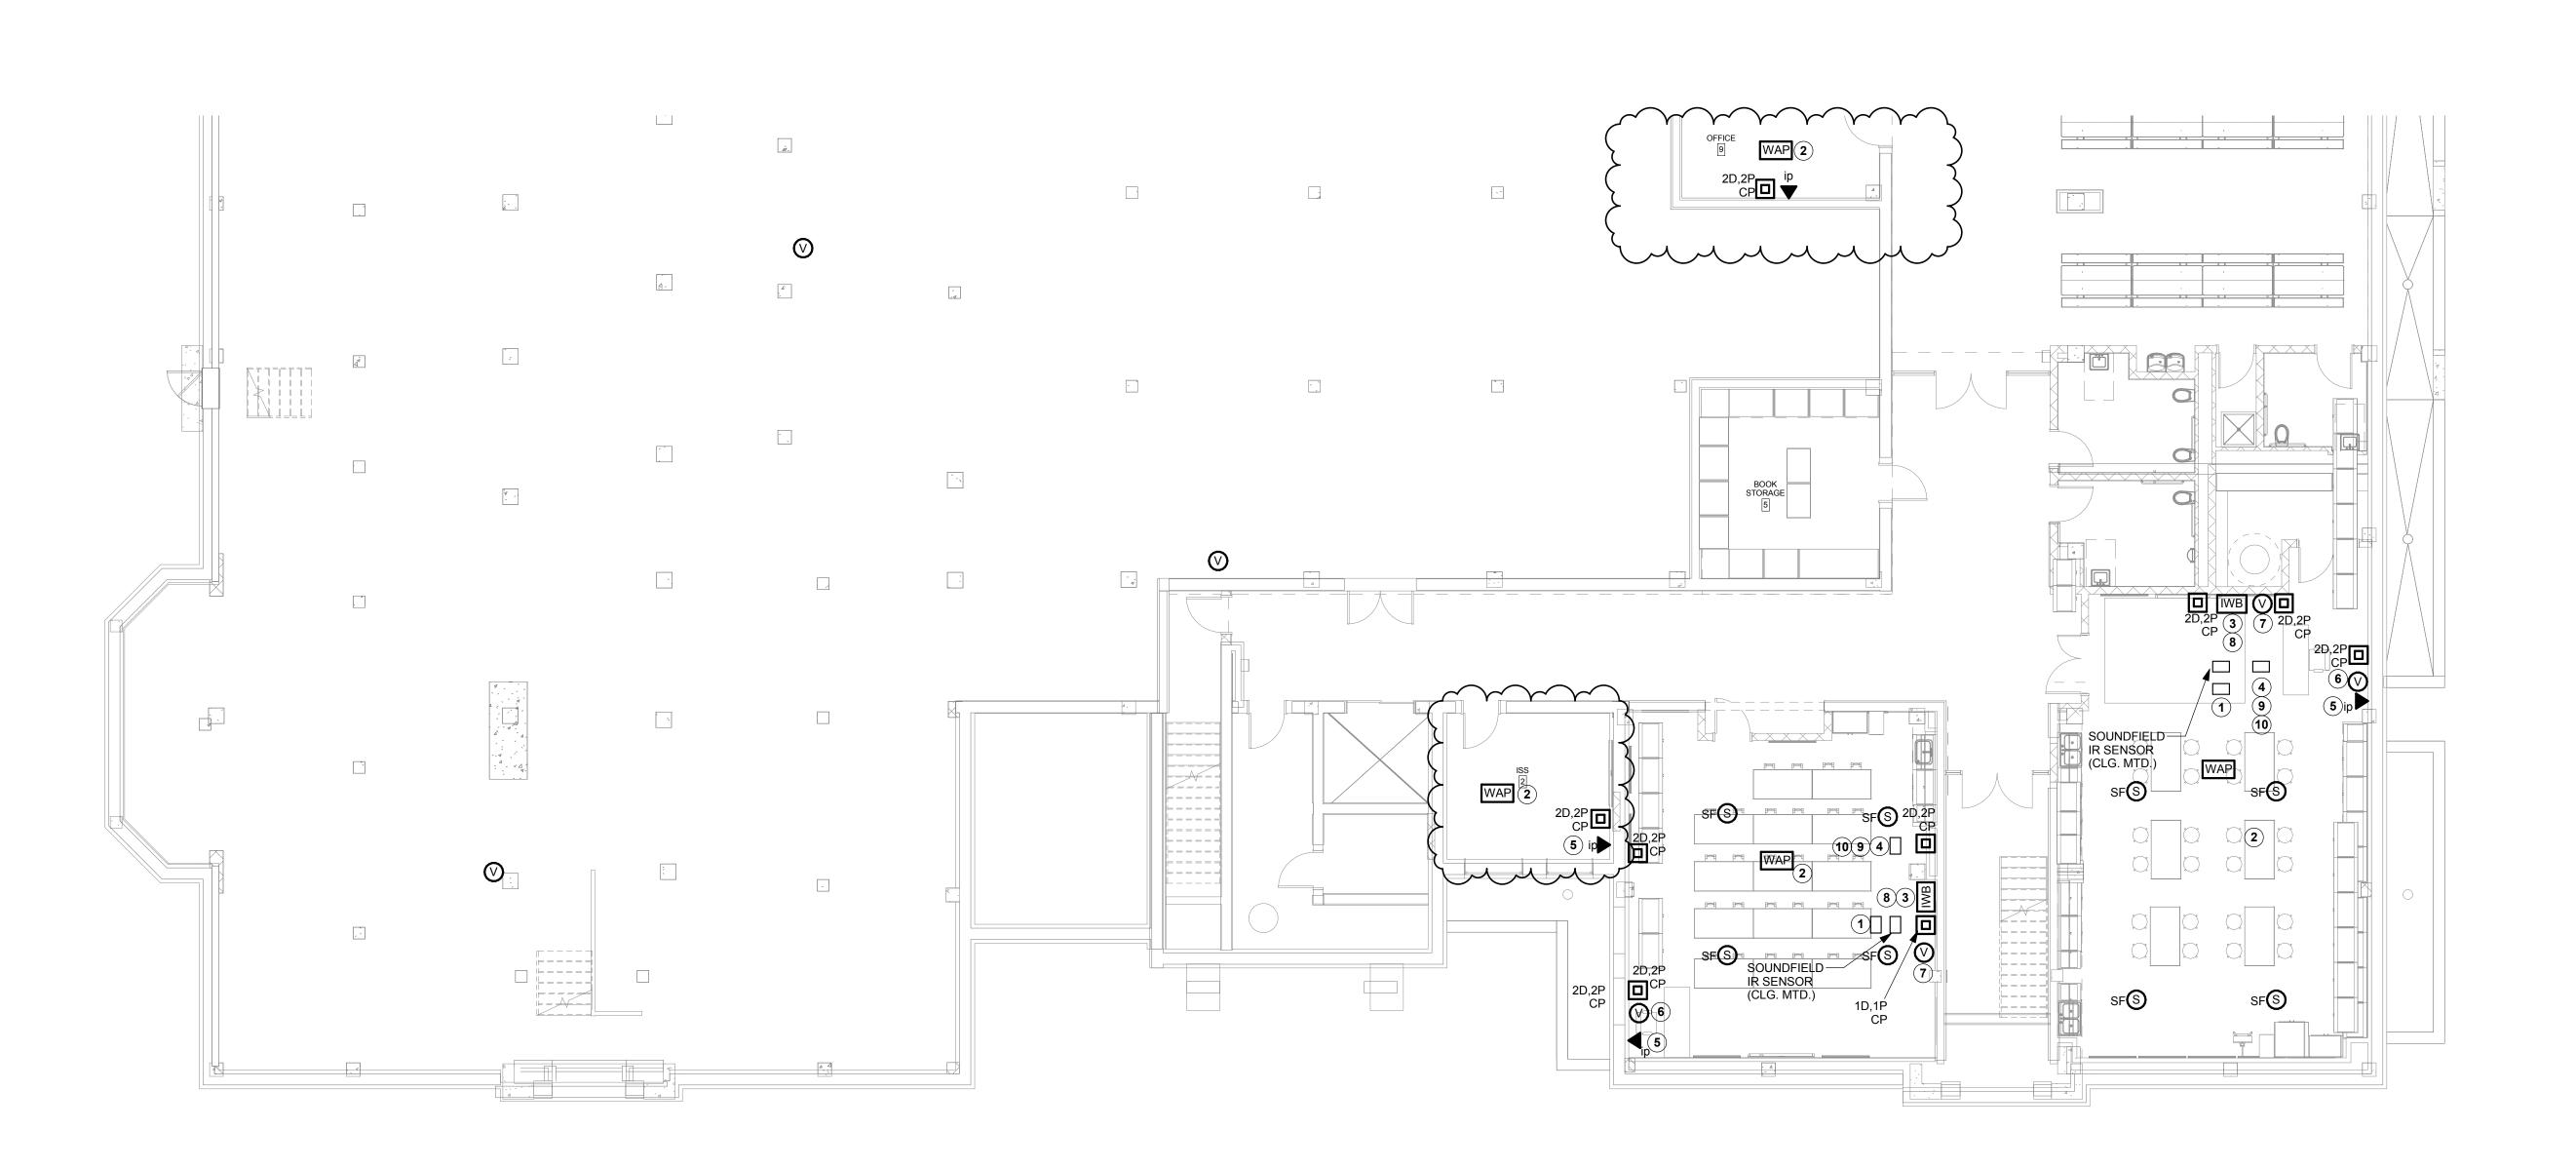

# **T201.2 DRAWING NOTES**

REFER TO DRAWING E000 FOR GENERAL NOTES THAT PERTAIN TO ALL ELECTRICAL

**T201.2 GENERAL NOTES** 

INSTALLATION

BASEMENT PLAN - C - DWT

1/8" = 1'-0"

- PROVIDE, ROUTE, AND TERMINATE ALL UTP DATA CABLING ON THIS DRAWING TO IDF, CER XX, ROOM XXXX
- COORDINATE LOCATION OF EQUIPMENT WITH ELECTRICAL/POWER DRAWINGS AND
- REFER TO ELECTRICAL DRAWINGS FOR NORMAL AND CLEAN DUPLEX RECEPTACLE LOCATIONS AND QUANTITIES.
- ROUTE ALL UTP CABLING ABOVE CEILINGS IN CLASSROOMS, COORDINATE ROUTING PATH WITH ALL CONTRACTORS PRIOR TO INSTALLATION.
- PER THE CONTRACT DOCUMENTS ALL BRANCH CIRCUITING AND HOME RUNS ARE TO BE CONCEALED WHERE POSSIBLE PER GENERAL NOTES AND SPECIFICATIONS. IF WALL ARE FISHABLE THEN THE BRANCH CIRCUITING AND HOMERUNS SHALL BE CONCEALED. CONDUIT SHALL NOT BE USED IN FINISHED AREAS. ALL VERTICAL AND HORIZONTAL RACEWAYS INSTALLED IN FINISHED AREAS WHERE CONCEALMENT IS IMPOSSIBLE, ARE TO BE LOCATED AND INSTALLED IN AN INCONSPICUOUS FASHION AND APPROVED BY THE ARCHITECT AND ENGINEER PRIOR TO INSTALLATION. COORDINATE ALL SURFACE RACEWAY INSTALLATION AND LOCATIONS WITH ARCHITECT AND ENGINEER PRIOR TO

SOUND FIELD AMPLIFIER. PROVIDE COMPLETE SOUND FIELD SYSTEM. LOCATE IN CABINETRY. PROVIDE RCA LEFT AND RIGHT CABLES FROM SOUND

PROVIDE WIRELESS ACCESS POINT AND CAT 6A UTP CABLING.

PROVIDE NEW IWB WITH PROJECTOR AS INDICATED

PROVIDE NEW ALL IN ONE COMPONET/EQUIPMENT TO ALLOW FOR COMPLETE CONNECTIVITY IN ROOM THRU IWB. PROVIDE NEW VOIP HANDSET PER SPECIFICATIONS

PROVIDE MULTIMEDIA OUTLET AT TEACHER'S DESK WITH TWO (2) HDMI JACKS AND ONE (1) VGA JACK AND ASSOCIATED CABLES. AT TEACHER'S DESK MULTIMEDIA OUTLET PROVIDE THE FOLLOWING: PROVIDE ONE (1) HDMI CABLE FROM TEACHER'S DESK TO IWB FOR TEACHER'S COMPUTER. PROVIDE ONE (1) HDMI CABLE FROM ALL IN ONE COMPUTER TO IWB. PROVIDE ONE (1) VGA FROM TEACHER'S DESK TO IWB

PROVIDE ALL ASSOCIATED IWB CABLES NOTED IN DRAWING NOTE 6 TO THIS MULTIMEDIA OUTLET LOCATION.


PROVIDE RCA L/R CABLES FROM IWB TO SOUNDFIELD AMPLIFIER.

PROVIDE 3.5 MM CABLES FROM ALL IN ONE COMPUTER TO AOUND FIELD AMPLIFIER. PROVIDE USB CABLE FROM ALL IN ONE COMPUTER TO IWB.

ARCHITECTS BUFFALO | ROCHESTER www.cjsarchitects.com



**ENGINEERING** Mechanical/Electrical Engineering Consultants Rochester | Buffalo | Syracuse | Schenectady 150 N. CHESTNUT ST. ROCHESTER, NY 14604

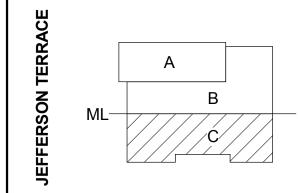

KEY PLAN

DR. SAMUEL MCCREE WAY

SED # 26-16-00-01-0-004-024 DWT SED# 26-16-00-01-7-999-020

Rochester Schools Modernization Program -Phase 2c

George M. Forbes- Renovation, Alterations and Addition

> 198 Dr Samuel McCree Way, Rochester, NY 14611

REV.#	DESCRIPTION	DATE
1	ADDENDUM 1	04/25/18


CHECKED BY	Check
DRAWN BY	Auth
ISSUE DATE	4/9/
SCALE	AS NOTE
JOB NO.	17

THIS IS A SINGLE SHEET OF A COHESIVE SET OF CONSTRUCTION DOCUMENTS (INCLUDING DRAWINGS AND SPECIFICATIONS). INTERPRETATION OF THE INFORMATION AS PRESENTED SHOULD BE BASED ON THE ENTIRE SET OF DOCUMENTS.

DRAWING TITLE

BASEMENT PLAN - C - DWT

T201.2

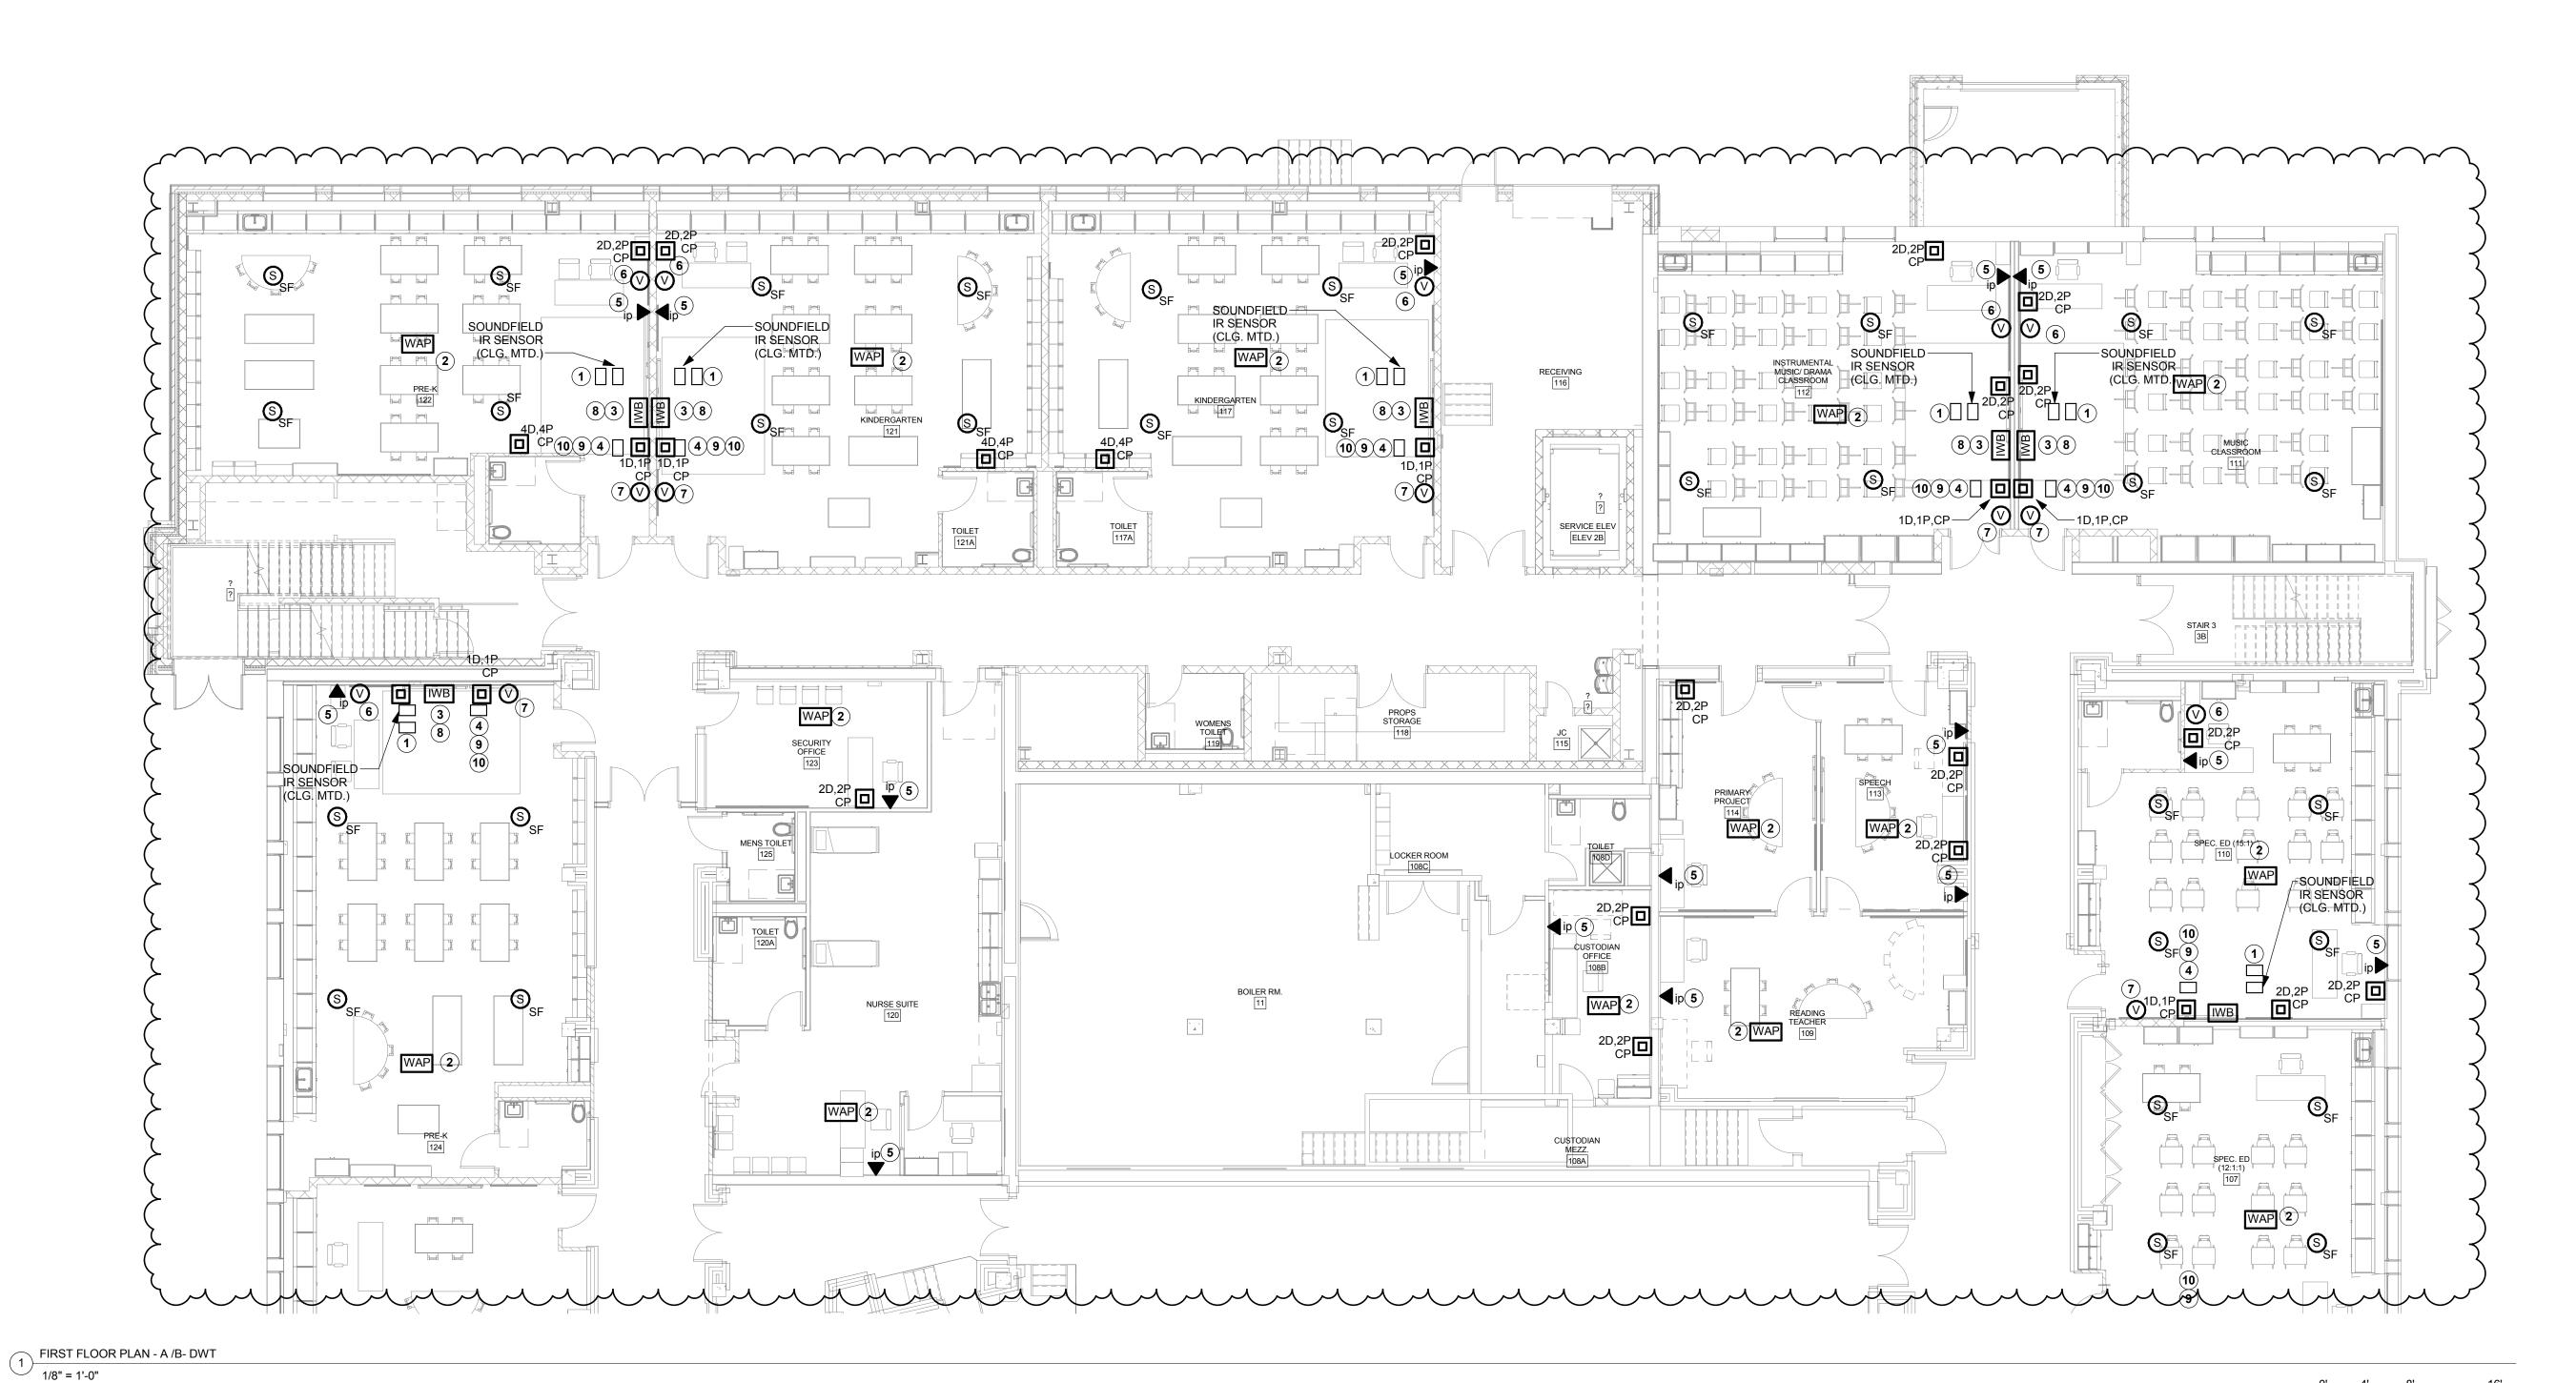

**T202.1 GENERAL NOTES** 

A. REFER TO DRAWING E000 FOR GENERAL NOTES THAT PERTAIN TO ALL ELECTRICAL

- PROVIDE, ROUTE, AND TERMINATE ALL UTP DATA CABLING ON THIS DRAWING TO IDF,
- COORDINATE LOCATION OF EQUIPMENT WITH ELECTRICAL/POWER DRAWINGS AND
- REFER TO ELECTRICAL DRAWINGS FOR NORMAL AND CLEAN DUPLEX RECEPTACLE LOCATIONS AND QUANTITIES.
- ROUTE ALL UTP CABLING ABOVE CEILINGS IN CLASSROOMS, COORDINATE ROUTING
- PATH WITH ALL CONTRACTORS PRIOR TO INSTALLATION. CONCEALED WHERE POSSIBLE PER GENERAL NOTES AND SPECIFICATIONS. IF WALL
- PER THE CONTRACT DOCUMENTS ALL BRANCH CIRCUITING AND HOME RUNS ARE TO BE ARE FISHABLE THEN THE BRANCH CIRCUITING AND HOMERUNS SHALL BE CONCEALED. CONDUIT SHALL NOT BE USED IN FINISHED AREAS. ALL VERTICAL AND HORIZONTAL RACEWAYS INSTALLED IN FINISHED AREAS WHERE CONCEALMENT IS IMPOSSIBLE, ARE TO BE LOCATED AND INSTALLED IN AN INCONSPICUOUS FASHION AND APPROVED BY THE ARCHITECT AND ENGINEER PRIOR TO INSTALLATION. COORDINATE ALL SURFACE RACEWAY INSTALLATION AND LOCATIONS WITH ARCHITECT AND ENGINEER PRIOR TO INSTALLATION

#### **T202.1 DRAWING NOTES**



PROVIDE WIRELESS ACCESS POINT AND CAT 6A UTP CABLING.

PROVIDE NEW IWB WITH PROJECTOR AS INDICATED

PROVIDE NEW ALL IN ONE COMPONET/EQUIPMENT TO ALLOW FOR COMPLETE CONNECTIVITY IN ROOM THRU IWB.

PROVIDE NEW VOIP HANDSET PER SPECIFICATIONS PROVIDE MULTIMEDIA OUTLET AT TEACHER'S DESK WITH TWO (2) HDMI JACKS AND ONE (1) VGA JACK AND ASSOCIATED CABLES. AT TEACHER'S

DESK MULTIMEDIA OUTLET PROVIDE THE FOLLOWING: PROVIDE ONE (1) HDMI CABLE FROM TEACHER'S DESK TO IWB FOR TEACHER'S COMPUTER. PROVIDE ONE (1) HDMI CABLE FROM ALL IN ONE COMPUTER TO IWB. PROVIDE ONE (1) VGA FROM TEACHER'S DESK TO IWB

PROVIDE ALL ASSOCIATED IWB CABLES NOTED IN DRAWING NOTE 6 TO THIS MULTIMEDIA OUTLET LOCATION.

PROVIDE RCA L/R CABLES FROM IWB TO SOUNDFIELD AMPLIFIER.


PROVIDE 3.5 MM CABLES FROM ALL IN ONE COMPUTER TO SOUND FIELD AMPLIFIER.

PROVIDE USB CABLE FROM ALL IN ONE COMPUTER TO IWB.

# ARCHITECTS BUFFALO | ROCHESTER www.cjsarchitects.com



Mechanical/Electrical Engineering Consultants Rochester | Buffalo | Syracuse | Schenectady 150 N. CHESTNUT ST. ROCHESTER, NY 14604

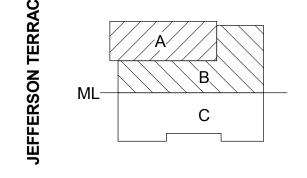

**KEY PLAN** 

DR. SAMUEL MCCREE WAY

SED # 26-16-00-01-0-004-024 DWT SED# 26-16-00-01-7-999-020

Rochester Schools Modernization Program -Phase 2c George M. Forbes- Renovation, Alterations and Addition

> 198 Dr Samuel McCree Way, Rochester, NY 14611

REV.#	DESCRIPTION	DATE
1	ADDENDUM 1	04/25/18
		•


JOB NO.	171
SCALE	AS NOTE
ISSUE DATE	4/9/1
DRAWN BY	Autho
CHECKED BY	Checke
THIS IS A SINGLE SHEET OF A COHESIVE	

SET OF CONSTRUCTION DOCUMENTS
(INCLUDING DRAWINGS AND SPECIFICATIONS). INTERPRETATION OF THE INFORMATION
AS PRESENTED SHOULD BE BASED ON
THE ENTIRE SET OF DOCUMENTS.

DRAWING TITLE

FIRST FLOOR PLAN -A/B - DWT

T202.1

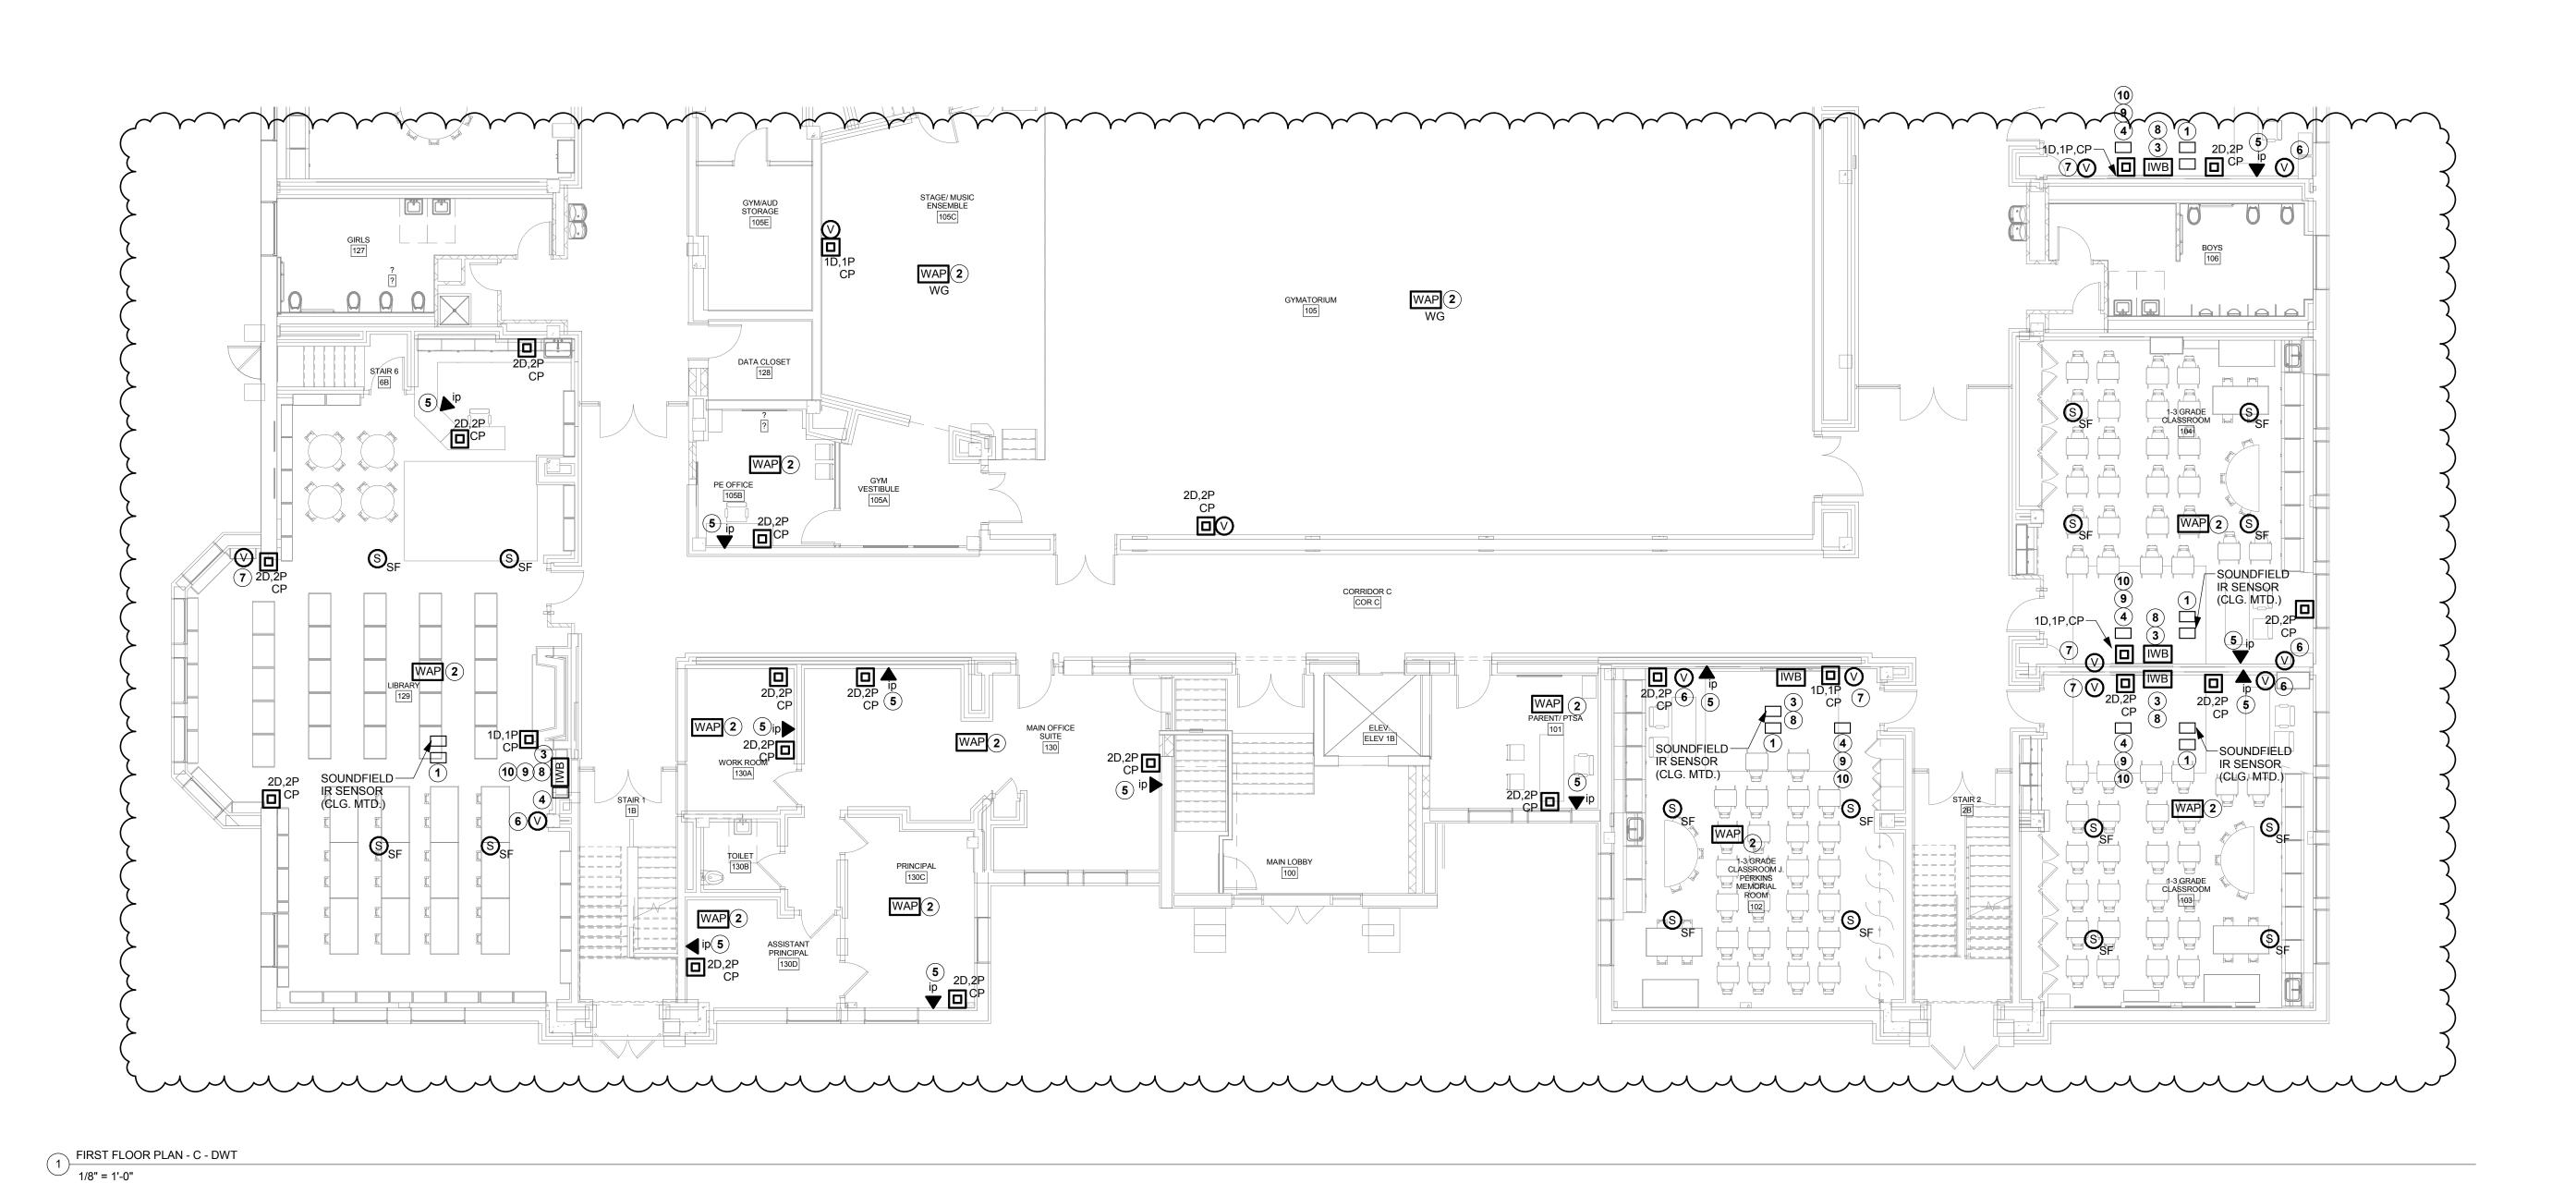

# **T202.2 DRAWING NOTES**

REFER TO DRAWING E000 FOR GENERAL NOTES THAT PERTAIN TO ALL ELECTRICAL

**T202.2 GENERAL NOTES** 

INSTALLATION

- PROVIDE, ROUTE, AND TERMINATE ALL UTP DATA CABLING ON THIS DRAWING TO IDF, CER XX, ROOM XXXX
- COORDINATE LOCATION OF EQUIPMENT WITH ELECTRICAL/POWER DRAWINGS AND
- REFER TO ELECTRICAL DRAWINGS FOR NORMAL AND CLEAN DUPLEX RECEPTACLE
- LOCATIONS AND QUANTITIES. ROUTE ALL UTP CABLING ABOVE CEILINGS IN CLASSROOMS, COORDINATE ROUTING

PATH WITH ALL CONTRACTORS PRIOR TO INSTALLATION.

PER THE CONTRACT DOCUMENTS ALL BRANCH CIRCUITING AND HOME RUNS ARE TO BE CONCEALED WHERE POSSIBLE PER GENERAL NOTES AND SPECIFICATIONS. IF WALL ARE FISHABLE THEN THE BRANCH CIRCUITING AND HOMERUNS SHALL BE CONCEALED. CONDUIT SHALL NOT BE USED IN FINISHED AREAS. ALL VERTICAL AND HORIZONTAL RACEWAYS INSTALLED IN FINISHED AREAS WHERE CONCEALMENT IS IMPOSSIBLE, ARE TO BE LOCATED AND INSTALLED IN AN INCONSPICUOUS FASHION AND APPROVED BY THE ARCHITECT AND ENGINEER PRIOR TO INSTALLATION. COORDINATE ALL SURFACE


RACEWAY INSTALLATION AND LOCATIONS WITH ARCHITECT AND ENGINEER PRIOR TO

- SOUND FIELD AMPLIFIER. PROVIDE COMPLETE SOUND FIELD SYSTEM. LOCATE IN CABINETRY. PROVIDE RCA LEFT AND RIGHT CABLES FROM SOUND
- PROVIDE WIRELESS ACCESS POINT AND CAT 6A UTP CABLING. PROVIDE NEW IWB WITH PROJECTOR AS INDICATED
  - PROVIDE NEW ALL IN ONE COMPONET/EQUIPMENT TO ALLOW FOR COMPLETE CONNECTIVITY IN ROOM THRU IWB. PROVIDE NEW VOIP HANDSET PER SPECIFICATIONS
  - PROVIDE MULTIMEDIA OUTLET AT TEACHER'S DESK WITH TWO (2) HDMI JACKS AND ONE (1) VGA JACK AND ASSOCIATED CABLES. AT TEACHER'S
- DESK MULTIMEDIA OUTLET PROVIDE THE FOLLOWING: PROVIDÈ ÓNE (1) HDMI CABLE FRÒM TEACHER'S DESK TO IWB FOR TEACHER'S COMPUTER. PROVIDE ONE (1) HDMI CABLE FROM ALL IN ONE COMPUTER TO IWB. PROVIDE ONE (1) VGA FROM TEACHER'S DESK TO IWB
- PROVIDE ALL ASSOCIATED IWB CABLES NOTED IN DRAWING NOTE 6 TO THIS MULTIMEDIA OUTLET LOCATION.
- PROVIDE RCA L/R CABLES FROM IWB TO SOUNDFIELD AMPLIFIER.
- PROVIDE 3.5 MM CABLES FROM ALL IN ONE COMPUTER TO SOUND FIELD AMPLIFIER.
  - PROVIDE USB CABLE FROM ALL IN ONE COMPUTER TO IWB.

# ARCHITECTS BUFFALO | ROCHESTER www.cjsarchitects.com



Mechanical/Electrical Engineering Consultants Rochester | Buffalo | Syracuse | Schenectady

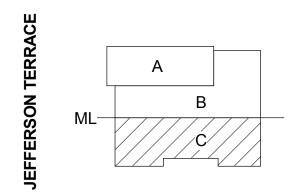

**KEY PLAN** 

DR. SAMUEL MCCREE WAY

SED # 26-16-00-01-0-004-024 DWT SED# 26-16-00-01-7-999-020

Rochester Schools Modernization Program -Phase 2c George M. Forbes- Renovation, Alterations

and Addition

198 Dr Samuel McCree Way, Rochester, NY 14611

REV.#	DESCRIPTION	DATE
1	ADDENDUM 1	04/25/18


JOB NO.	171
SCALE	AS NOTE
ISSUE DATE	4/9/1
DRAWN BY	Autho
CHECKED BY	Checke

THIS IS A SINGLE SHEET OF A COHESIVE SET OF CONSTRUCTION DOCUMENTS (INCLUDING DRAWINGS AND SPECIFICATIONS). INTERPRETATION OF THE INFORMATION AS PRESENTED SHOULD BE BASED ON THE ENTIRE SET OF DOCUMENTS.

DRAWING TITLE

FIRST FLOOR PLAN -C - DWT

T202.2

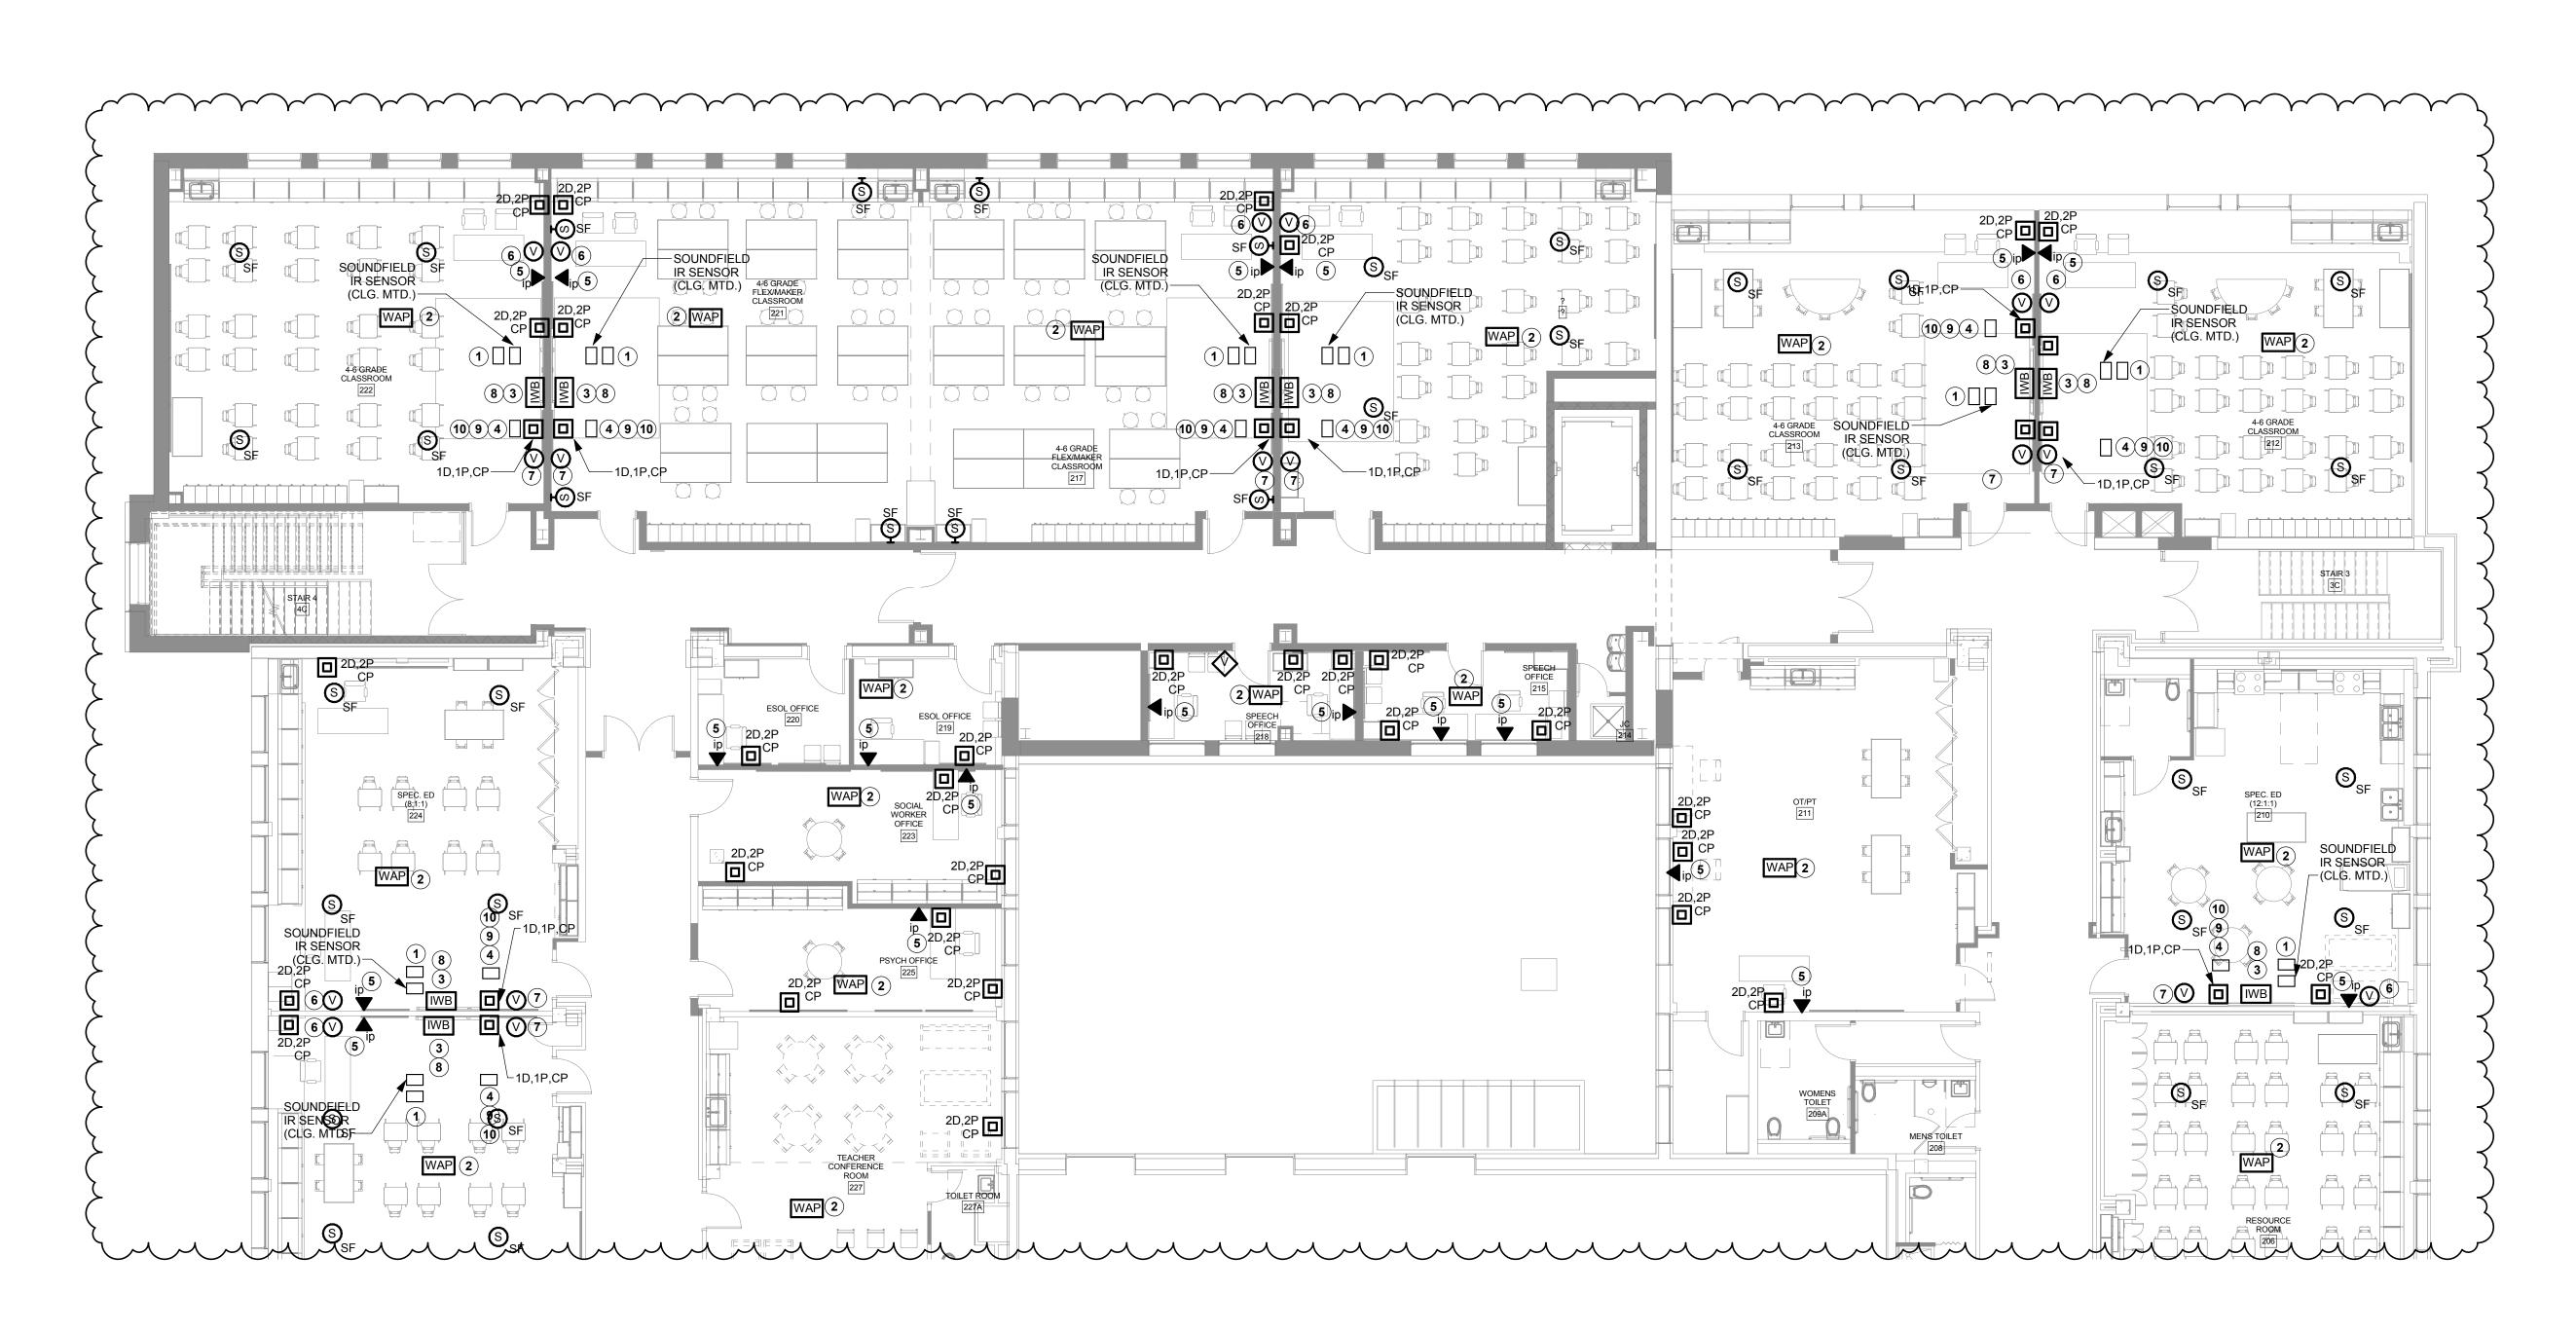

SECOND FLOOR PLAN - A/B - DWT ·/ 1/8" = 1'-0"

#### **T203.1 GENERAL NOTES**

- REFER TO DRAWING E000 FOR GENERAL NOTES THAT PERTAIN TO ALL ELECTRICAL
- PROVIDE, ROUTE, AND TERMINATE ALL UTP DATA CABLING ON THIS DRAWING TO IDF, CER XX, ROOM XXXX
- COORDINATE LOCATION OF EQUIPMENT WITH ELECTRICAL/POWER DRAWINGS AND
- REFER TO ELECTRICAL DRAWINGS FOR NORMAL AND CLEAN DUPLEX RECEPTACLE
- LOCATIONS AND QUANTITIES. ROUTE ALL UTP CABLING ABOVE CEILINGS IN CLASSROOMS, COORDINATE ROUTING
- PATH WITH ALL CONTRACTORS PRIOR TO INSTALLATION. PER THE CONTRACT DOCUMENTS ALL BRANCH CIRCUITING AND HOME RUNS ARE TO BE CONCEALED WHERE POSSIBLE PER GENERAL NOTES AND SPECIFICATIONS. IF WALL
- ARE FISHABLE THEN THE BRANCH CIRCUITING AND HOMERUNS SHALL BE CONCEALED. CONDUIT SHALL NOT BE USED IN FINISHED AREAS. ALL VERTICAL AND HORIZONTAL RACEWAYS INSTALLED IN FINISHED AREAS WHERE CONCEALMENT IS IMPOSSIBLE, ARE TO BE LOCATED AND INSTALLED IN AN INCONSPICUOUS FASHION AND APPROVED BY THE ARCHITECT AND ENGINEER PRIOR TO INSTALLATION. COORDINATE ALL SURFACE RACEWAY INSTALLATION AND LOCATIONS WITH ARCHITECT AND ENGINEER PRIOR TO INSTALLATION


#### **T203.1 DRAWING NOTES**

- SOUND FIELD AMPLIFIER. PROVIDE COMPLETE SOUND FIELD SYSTEM. LOCATE IN CABINETRY. PROVIDE RCA LEFT AND RIGHT CABLES FROM SOUND
- FIELD TO IWB. PROVIDE WIRELESS ACCESS POINT AND CAT 6A UTP CABLING.
- PROVIDE NEW IWB WITH PROJECTOR AS INDICATED
- PROVIDE NEW ALL IN ONE COMPONET/EQUIPMENT TO ALLOW FOR COMPLETE CONNECTIVITY IN ROOM THRU IWB. PROVIDE NEW VOIP HANDSET PER SPECIFICATIONS
- PROVIDE MULTIMEDIA OUTLET AT TEACHER'S DESK WITH TWO (2) HDMI JACKS AND ONE (1) VGA JACK AND ASSOCIATED CABLES. AT TEACHER'S DESK MULTIMEDIA OUTLET PROVIDE THE FOLLOWING: PROVIDE ONE (1) HDMI CABLE FROM TEACHER'S DESK TO IWB FOR TEACHER'S COMPUTER.
- PROVIDE ONE (1) HDMI CABLE FROM ALL IN ONE COMPUTER TO IWB. PROVIDE ONE (1) VGA FROM TEACHER'S DESK TO IWB
- PROVIDE ALL ASSOCIATED IWB CABLES NOTED IN DRAWING NOTE 6 TO THIS MULTIMEDIA OUTLET LOCATION.
- PROVIDE RCA L/R CABLES FROM IWB TO SOUNDFIELD AMPLIFIER.
- PROVIDE 3.5 MM CABLES FROM ALL IN ONE COMPUTER TO SOUND FIELD AMPLIFIER. PROVIDE USB CABLE FROM ALL IN ONE COMPUTER TO IWB.

ARCHITECTS BUFFALO | ROCHESTER www.cjsarchitects.com



Mechanical/Electrical Engineering Consultants Rochester | Buffalo | Syracuse | Schenectady

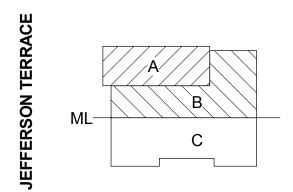

**KEY PLAN** 

DR. SAMUEL MCCREE WAY

SED # 26-16-00-01-0-004-024 DWT SED# 26-16-00-01-7-999-020

Rochester Schools Modernization Program -Phase 2c George M. Forbes- Renovation, Alterations and Addition

> 198 Dr Samuel McCree Way, Rochester, NY 14611

REV.#	DESCRIPTION	DATE
1	ADDENDUM 1	04/25/18


JOB NO.	1711
SCALE	AS NOTED
ISSUE DATE	4/9/18
DRAWN BY	Author
CHECKED BY	Checker

THIS IS A SINGLE SHEET OF A COHESIVE SET OF CONSTRUCTION DOCUMENTS (INCLUDING DRAWINGS AND SPECIFICATIONS). INTERPRETATION OF THE INFORMATION AS PRESENTED SHOULD BE BASED ON THE ENTIRE SET OF DOCUMENTS.

DRAWING TITLE

SECOND FLOOR PLAN - A/B - DWT

T203.1

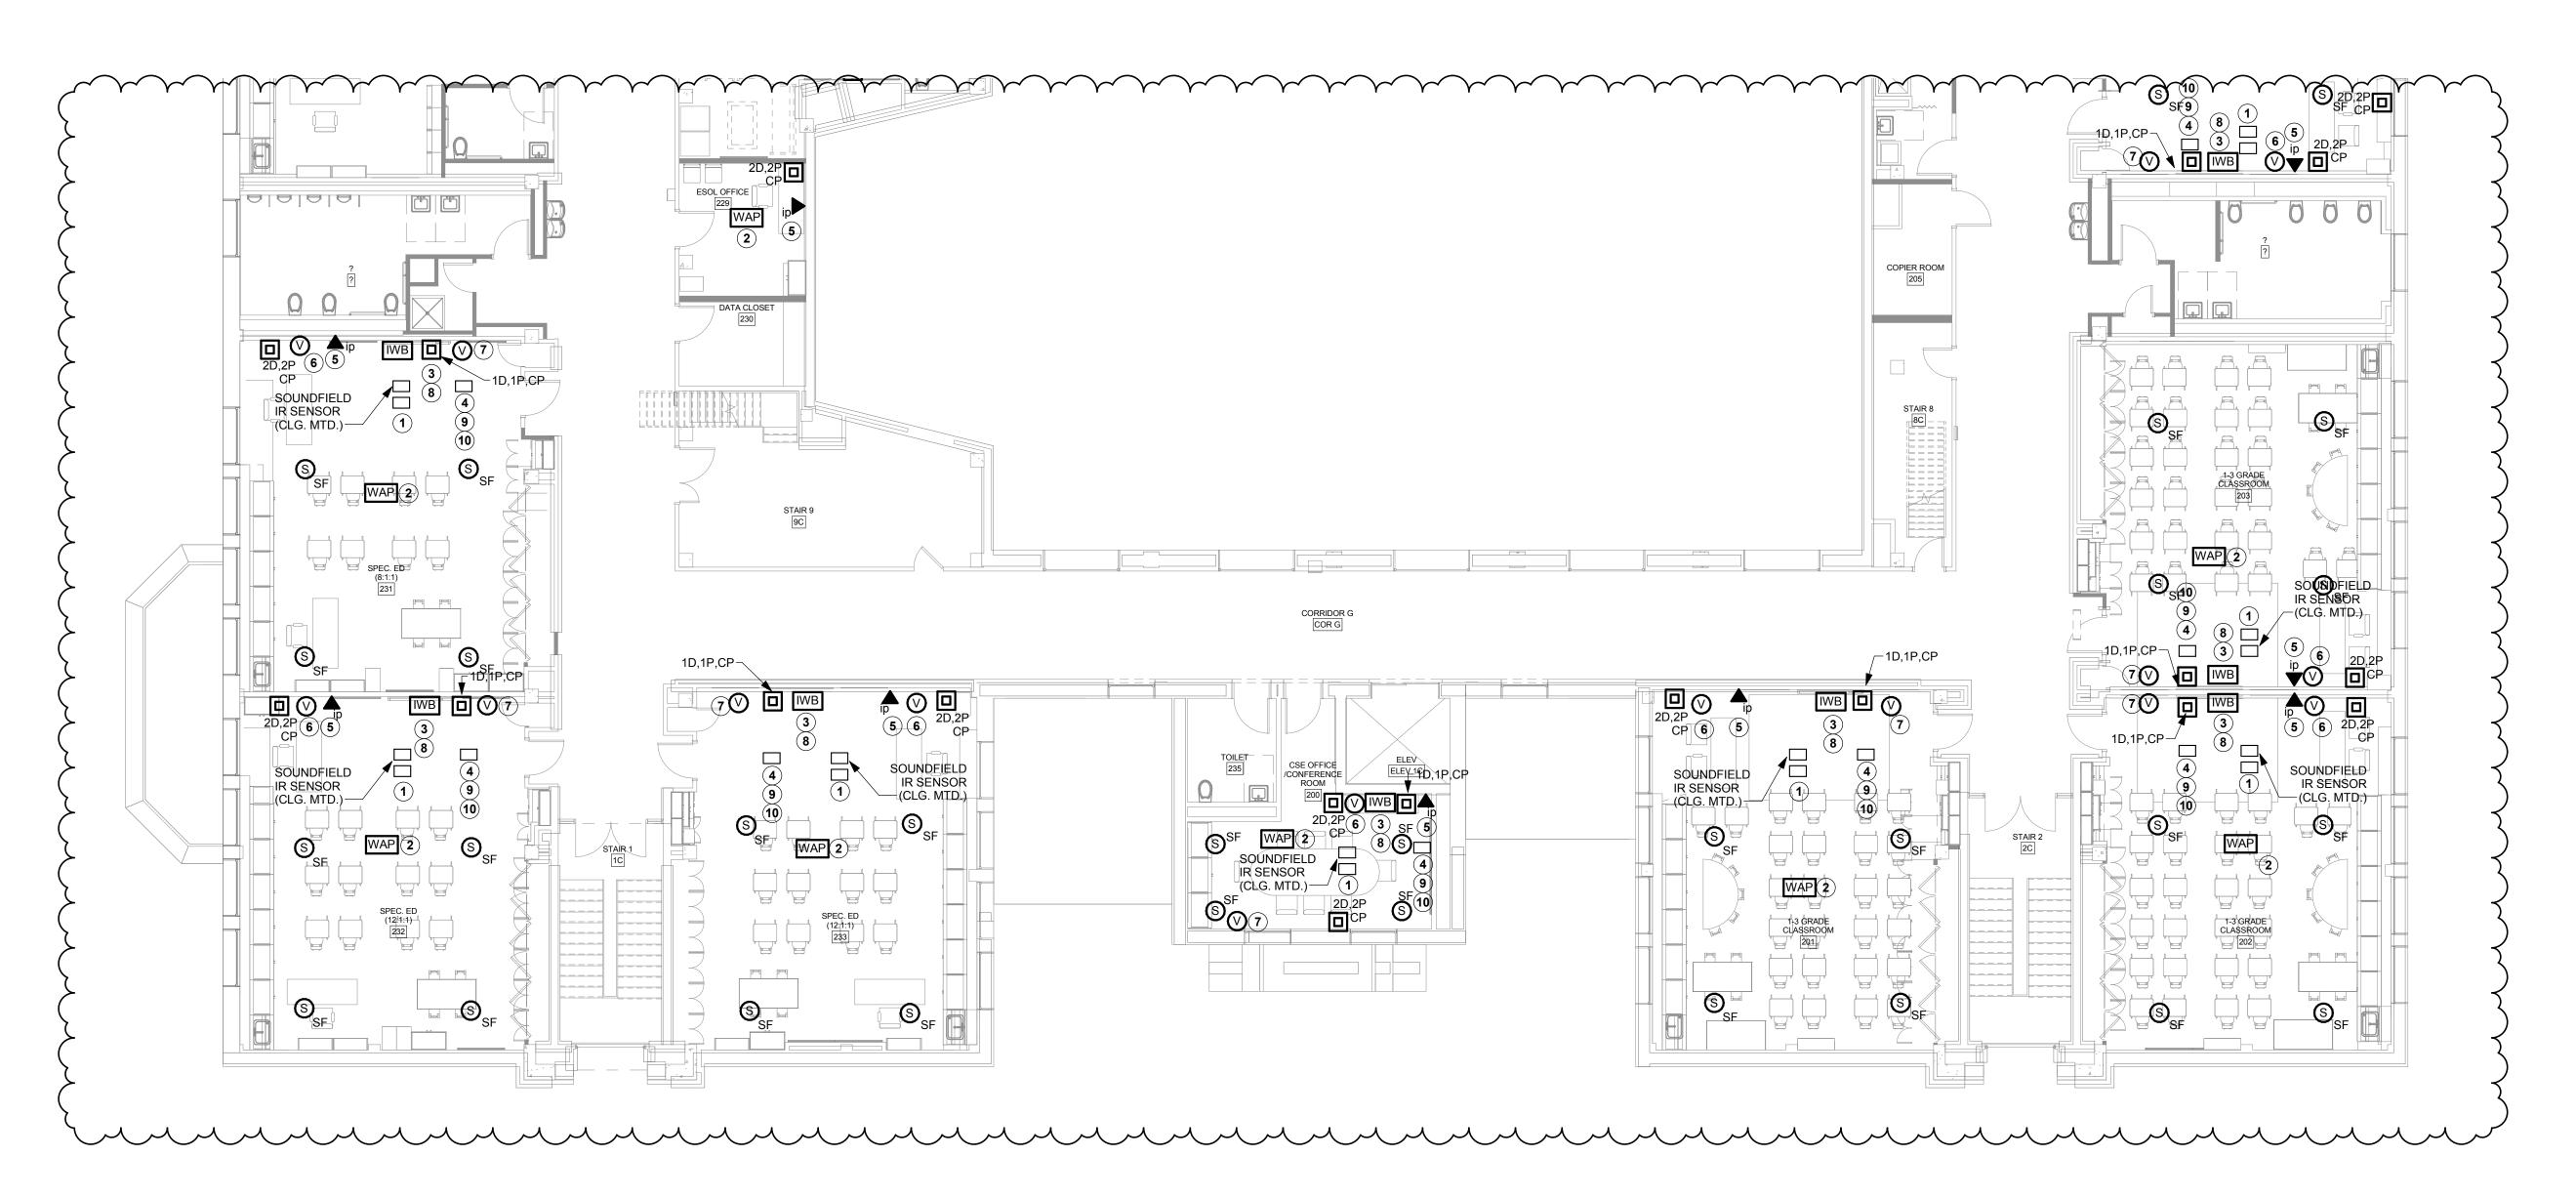

SECOND FLOOR PLAN - C - DWT

1/8" = 1'-0"

#### **T203.2 GENERAL NOTES**

- REFER TO DRAWING E000 FOR GENERAL NOTES THAT PERTAIN TO ALL ELECTRICAL
- PROVIDE, ROUTE, AND TERMINATE ALL UTP DATA CABLING ON THIS DRAWING TO IDF,
- COORDINATE LOCATION OF EQUIPMENT WITH ELECTRICAL/POWER DRAWINGS AND
- REFER TO ELECTRICAL DRAWINGS FOR NORMAL AND CLEAN DUPLEX RECEPTACLE
- LOCATIONS AND QUANTITIES.
- ROUTE ALL UTP CABLING ABOVE CEILINGS IN CLASSROOMS, COORDINATE ROUTING PATH WITH ALL CONTRACTORS PRIOR TO INSTALLATION.
- PER THE CONTRACT DOCUMENTS ALL BRANCH CIRCUITING AND HOME RUNS ARE TO BE CONCEALED WHERE POSSIBLE PER GENERAL NOTES AND SPECIFICATIONS. IF WALL ARE FISHABLE THEN THE BRANCH CIRCUITING AND HOMERUNS SHALL BE CONCEALED. CONDUIT SHALL NOT BE USED IN FINISHED AREAS. ALL VERTICAL AND HORIZONTAL RACEWAYS INSTALLED IN FINISHED AREAS WHERE CONCEALMENT IS IMPOSSIBLE, ARE TO BE LOCATED AND INSTALLED IN AN INCONSPICUOUS FASHION AND APPROVED BY THE ARCHITECT AND ENGINEER PRIOR TO INSTALLATION. COORDINATE ALL SURFACE RACEWAY INSTALLATION AND LOCATIONS WITH ARCHITECT AND ENGINEER PRIOR TO INSTALLATION


#### **T203.2 DRAWING NOTES**

- SOUND FIELD AMPLIFIER. PROVIDE COMPLETE SOUND FIELD SYSTEM. LOCATE IN CABINETRY. PROVIDE RCA LEFT AND RIGHT CABLES FROM SOUND FIELD TO IWB.
- PROVIDE WIRELESS ACCESS POINT AND CAT 6A UTP CABLING.
- PROVIDE NEW IWB WITH PROJECTOR AS INDICATED
- PROVIDE NEW ALL IN ONE COMPONET/EQUIPMENT TO ALLOW FOR COMPLETE CONNECTIVITY IN ROOM THRU IWB.
- PROVIDE NEW VOIP HANDSET PER SPECIFICATIONS
  - PROVIDE MULTIMEDIA OUTLET AT TEACHER'S DESK WITH TWO (2) HDMI JACKS AND ONE (1) VGA JACK AND ASSOCIATED CABLES. AT TEACHER'S DESK MULTIMEDIA OUTLET PROVIDE THE FOLLOWING: PROVIDÈ ONE (1) HDMI CABLE FROM TEACHER'S DESK TO IWB FOR TEACHER'S COMPUTER. PROVIDE ONE (1) HDMI CABLE FROM ALL IN ONE COMPUTER TO IWB. PROVIDE ONE (1) VGA FROM TEACHER'S DESK TO IWB
- PROVIDE ALL ASSOCIATED IWB CABLES NOTED IN DRAWING NOTE 6 TO THIS MULTIMEDIA OUTLET LOCATION.
- PROVIDE RCA L/R CABLES FROM IWB TO SOUNDFIELD AMPLIFIER.
- PROVIDE 3.5 MM CABLES FROM ALL IN ONE COMPUTER TO SOUND FIELD AMPLIFIER. PROVIDE USB CABLE FROM ALL IN ONE COMPUTER TO IWB.





Mechanical/Electrical Engineering Consultants Rochester | Buffalo | Syracuse | Schenectady 150 N. CHESTNUT ST. ROCHESTER, NY 14604

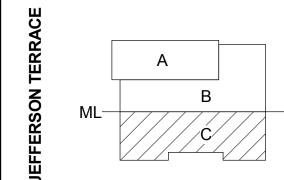

DR. SAMUEL MCCREE WAY

**KEY PLAN** 

DWT SED# 26-16-00-01-7-999-020

SED # 26-16-00-01-0-004-024

Rochester Schools Modernization Program -Phase 2c

George M. Forbes- Renovation, Alterations and Addition

> 198 Dr Samuel McCree Way, Rochester, NY 14611

REV.#	DESCRIPTION	DATE
1	ADDENDUM 1	04/25/18

JOB NO.	171
SCALE	AS NOTE
ISSUE DATE	4/9/1
DRAWN BY	Autho
CHECKED BY	Checke

THIS IS A SINGLE SHEET OF A COHESIVE SET OF CONSTRUCTION DOCUMENTS (INCLUDING DRAWINGS AND SPECIFICATIONS). INTERPRETATION OF THE INFORMATION AS PRESENTED SHOULD BE BASED ON THE ENTIRE SET OF DOCUMENTS.

DRAWING TITLE

SECOND FLOOR PLAN - C - DWT

T203.2